

24



500-27-7-1912.

Form No. 1.

Karachi, 10th December 1913.

NOTICE UNDER SECTION 96 OF ACT III OF 1901.

To

THE CHIEF OFFICER AND CHIEF ENGINEER,
KARACHI MUNICIPALITY.

SIR,

I beg to inform you that I intend building Compound Walls and
on some portion ground floor on plot No. files me in exchange
by the Municipality in lieu of my plot Nos: 10, 11, 17, 78, 53, 53A, 27A, 27B
Survey Sheet No. E-1 Situate in Alimnchi Road +27C
Street Machi Mirani Quarter.

As required by the rules of the Municipality, I beg to submit herewith
a plan of the same for your approval.

I beg to remain,

Sir,

Your most obedient Servant,

Solam. Miss Kooni
Signature of the applicant.

No. G. of 132821913.

MUNICIPAL CHIEF OFFICER AND

CHIEF ENGINEER'S OFFICE.

Karachi, 26/10/12 1913.

Forwarded to the Municipal Engineer for favour of disposal.

A. M. INST. C. E.,

for Chief Officer and Chief Engineer,
Karachi Municipality.

3128
P 15/12/13
Mr. Beyan
from O & O.
15-12
T3



No. E. 836 of 1913.

MUNICIPAL ENGINEER'S OFFICE.

Karachi, 11th December 1913.

MEMO.

The above application is forwarded to the Municipal Health Officer for
favour of report.

Thru J. Surve
J. Cecil L. Verley
A. M. I. C. E.,

Engineer,
Karachi Municipality.

MUNICIPAL HEALTH OFFICER'S REPORT.

Returned to the Engineer, Karachi Municipality, with the following
remarks—

no objection

D. P. H. (London)

Health Officer,

Date 17-12-1913.

Karachi Municipality.

No. E. 835 of 1913

MUNICIPAL ENGINEER'S OFFICE.

Date 17th December 1913.

Forwarded to the Enquiry Officer for report.

J. Cecil L. Verley
A. M. I. C. E.,

Engineer,
Karachi Municipality.

Through

The Land Surveyor,
Karachi Municipality.

ENQUIRY OFFICER'S REPORT.

Applicant's name M. Sultan Hussain Khan

Whether he is the owner of the plot on which it is proposed to build

The work proposed to build compound wall & house

Enquiry Officer's report There is no objection to

granting pass to go into the above

plot to erect a house

Date 20 Dec 1913

Enquiry Officer.

Submitted through the Land Surveyor.

LAND SURVEYOR'S REPORT.

Does the plot come under Alignment no

Area of plot —

Area under Alignment —

Remarks Sir, I beg to submit herewith a

report that there is no objection

to permission to erect a house

Date 23-12-1913

Land Surveyor.

ORDERS OF THE ENGINEERS.

Issue Pass

F. A. I. C. E.,

Engineer,

Karachi Municipality.



4

No. E. 255 of 1914

MUNICIPAL ENGINEER'S OFFICE.

Karachi,

13th January 1914

Submitted to the Managing Committee with a recommendation that the plan be approved.

*Forwarded**A. M. I. C. E.,*

A. M. I. C. E.,

Engineer,

Karachi Municipality.

*M. J. & Co.**Chief Officer, Karachi Municipality*
Through

THE CHIEF OFFICER AND CHIEF ENGINEER,

KARACHI MUNICIPALITY.

RESOLUTION OF THE MANAGING COMMITTEE.

Resolution No. _____ Date _____



Heritage
FOUNDATION

KMR.CDD.MmQ.1913-1914.02

(500—14-9-13.)

Form No. 5.

No. E. 187 of 1913

MUNICIPAL ENGINEER'S OFFICE,

Karachi,

1913.

MEMO.

Building Inspector _____ is informed

that Mr. Govind Narain Kaur has been permitted

to Build his house

on plot No. 41 Street Mr. J. S. Caw

Quarter. Report should be made to the undersigned when the house is completed.

A. M. INST. C. E.,

Engineer,

Karachi Municipality.

200-16-7-13.

Form No. 2.

ORDERS UNDER SECTION 96 (2) OF ACT III OF 1910.

No. E/

188

OF 191 4

MUNICIPAL ENGINEER'S OFFICE,
Karachi,

12 January 1914.

MEMO:

With reference to his application dated 12/1/14 1914.
Mr. M. A. Hossain is informed
that the plan submitted by him for building a house & room
on plot No. _____ Survey Sheet C1
situate in _____ Street W. M. Road
Quarter, is approved, and permission to build in accordance therewith is
granted. The building to be erected subject to the Byelaws and Rules of the
Municipality.

A. M. INST., C. E.,
Engineer,
Karachi Municipality.

NOTE 1.—This pass does not give permission to occupy Municipal land with building materials. This can only be allowed when the street is wide enough to permit building materials being deposited on it without it being a source of danger to the public, and only then on a hoarding being placed round the land to be occupied, and on payment in advance of fees for occupation of Municipal land, at the following rates:—

	Rs.	A.	P.
(1) For the first three months, per square yard, per diem ..	0	0	$\frac{1}{2}$
(2) For the next three months	0	0	1
(3) For any subsequent time	0	0	2

NOTICE 2:—Windows and doors of the building will not be permitted to project on or overhang any public street or Municipal land.

Notice No. 3. Plinths will only be allowed to project 2" on any public street for ornamental purposes.



Heritage

KMR.CDD.MmQ.1913-1914.02

(500-25-11-13.)

Form No. 5.

No. E. 190 of 1914

MUNICIPAL ENGINEER'S OFFICE,

Karachi,

1914

MEMO.





Quarter. Report should be made to the undersigned when the house is completed.

A. M. INST. C. E.,

Engineer,

Karachi Municipality.

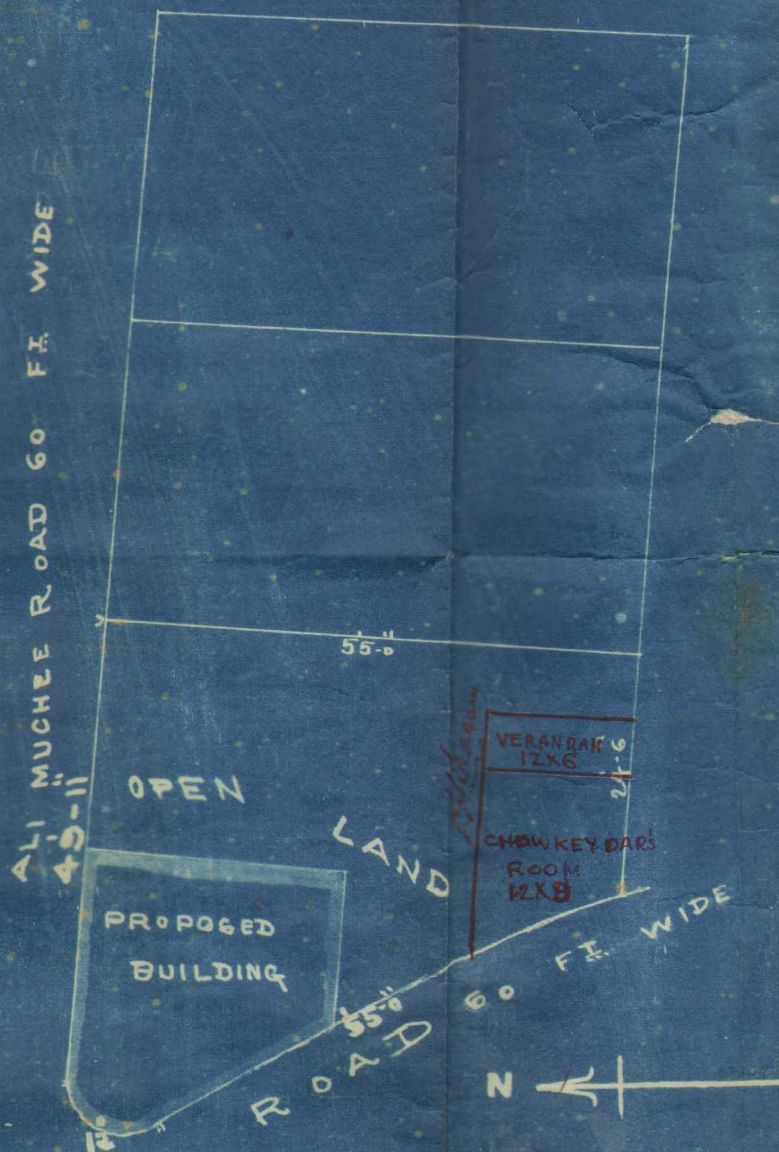
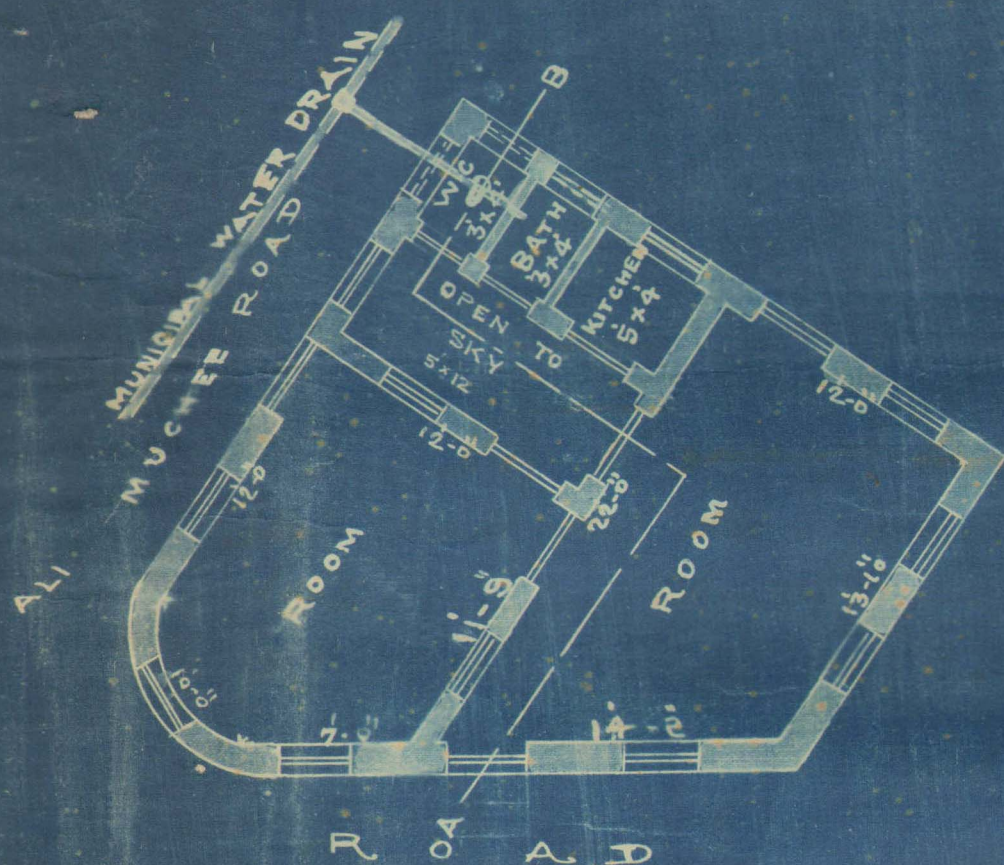
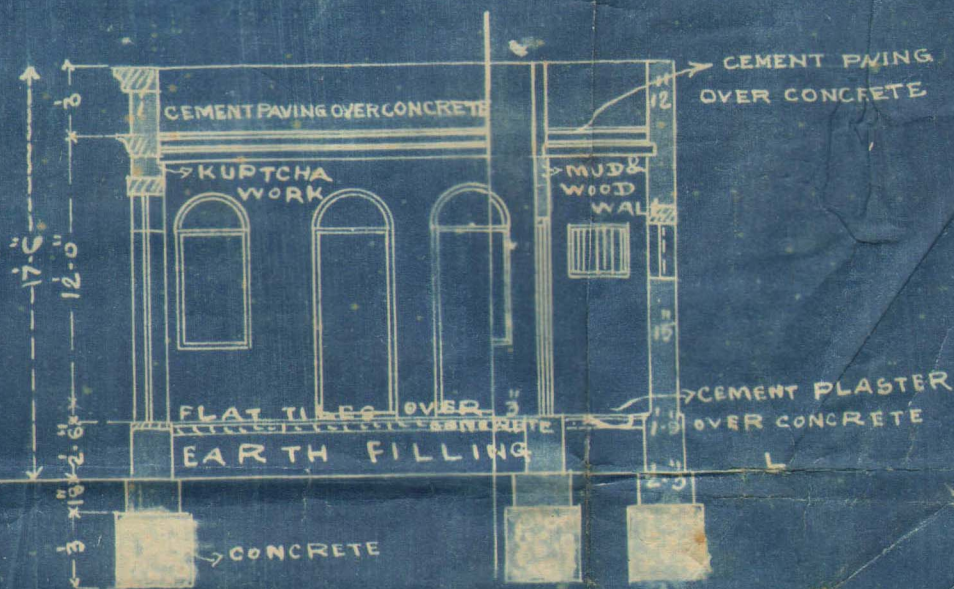
Through the Health Officer, Karachi Municipality.

Note—The plot is held as a temporary occupation lease and the owner agrees to remove the building at any time on receiving a month's notice to do so.

MUCHEE MEANEE Q.R.—PLAN—SHEWING PROPOSED BUILDING TO BE BUILT ON PLOT C1—SCALE 8"=1"—

Sam Husein
10.12.13.

Sam Husein
A. M. Inst., C. E.
Engineer,
Karachi Municipality.

—SITE PLAN——SCALE 20"=1"——GROUND PLAN——ELEVATION——SECTION ON A.B.—

Navalabha S. S.
Surveyor