

(B)

7.67	11.665	11.665	11.665
9.08			
6.58	7.67	9.08	6.58

2 | 23.33

$\sqrt{11.665 \times 3.995 \times 2.585 \times 5.085} = 24.8$

(C)

3.92	10.915	10.915	10.915
9.08			
8.83	3.92	9.08	8.83

2 | 21.83

$\sqrt{10.915 \times 6.995 \times 1.835 \times 2.085} = 17.1$

(D)

6.67	12.415	12.415	12.415
8.83	6.67	8.83	9.33
9.33			

2 | 24.83

$\sqrt{12.415 \times 5.745 \times 2.585 \times 2.085} = 28.04$

(E)

9.33	11.58	11.58	11.58
4.00	9.33	4	9.83
9.83			

2 | 23.16

$\sqrt{11.58 \times 2.25 \times 7.58 \times 1.75} = 18.6$

(F)

9.83	11.29	11.29	11.29
5.25	9.83	5.25	7.50
7.50			

2 | 22.58

$\sqrt{11.29 \times 1.46 \times 6.04 \times 3.79} = 19.4$

1-2

7.50	18.415	18.415	18.415
13.25	7.50	13.25	16.08
16.08			
2 36.83			

$$\sqrt{18.415 \times 10.915 \times 5.165 \times 2.335} = 49.25$$

13.92	25.79	25.79	25.79
16.08	13.92	16.08	21.58
21.58			
2 51.58			

$$\sqrt{25.79 \times 11.87 \times 9.71 \times 4.21} = 112$$

21.58	28.245	28.245	28.245
7.33	21.58	7.33	27.58
27.58			
2 56.49			

$$\sqrt{28.245 \times 6.665 \times 20.915 \times 0.665} = 51.2$$

27.58	40.50	40.50	40.50
14.75	27.58	14.75	38.67
38.67			
2 81.00			

$$\sqrt{40.50 \times 12.92 \times 25.75 \times 1.83} = 157$$

38.67	47.875	47.875	47.875
10.33	38.67	10.33	46.75
46.75			
2 95.75			

$$\sqrt{47.875 \times 9.205 \times 37.545 \times 1.125} = 136.1$$

5.17	8.755	8.755	8.755
4.17	5.17	4.17	8.17
8.17			
2 17.51			

$$\sqrt{8.755 \times 3.585 \times 4.585 \times 0.585} = 9.18$$

8.17	14.75	14.75	14.75
7.83	8.17	7.83	13.50
13.50			
2 29.50			

$$\sqrt{14.75 \times 6.58 \times 6.92 \times 1.25} = 29$$

New Block

2

A) Platform

$$\textcircled{1} \quad 53 \times 2.75 = 145.75$$

$$\textcircled{2} \quad \frac{12.75 + 16.67 \times 3}{2} = 44.10$$

$$\textcircled{3} \quad 39 \times 2.75 = 107.25$$

$$\textcircled{4} \quad \frac{12.5 + 16.25 \times 2.83}{2} = 40.66$$

$$\textcircled{5} \quad 57.75 \times 3 = 173.25$$

$$= 511.01$$

$$\textcircled{B} \quad \Delta (7-8, 9-1, 6-7) =$$

$$\textcircled{C} \quad \Delta (3-$$



(N)

13.50 3.83 10.50	16.415 13.50	16.415 3.83	16.415 15.50
------------------------	-----------------	----------------	-----------------

$$2 \overline{) 32.83}$$

$$\sqrt{16.415 \times 2.915 \times 12.585 \times 0.915 = 23.45}$$

(O)

5.5 15.5 14.75	17.875 5.5	17.875 15.5	17.875 14.75
----------------------	---------------	----------------	-----------------

$$2 \overline{) 35.75}$$

$$\sqrt{17.875 \times 12.375 \times 2.375 \times 3.125 = 40.05}$$

(P)

10.33 6.83 3.83	10.495 10.33	10.495 6.83	10.495 3.83
-----------------------	-----------------	----------------	----------------

$$2 \overline{) 20.99}$$

$$\sqrt{10.495 \times 0.165 \times 3.665 \times 6.665 = 6.49}$$

(Q)

2.75 3.43 3.42	5.00 2.75	5.00 3.83	5.00 3.42
----------------------	--------------	--------------	--------------

$$2 \overline{) 10.00}$$

$$\sqrt{5.00 \times 2.25 \times 1.17 \times 1.58 = 4.58}$$

+ (R) Deduction from open $\frac{1}{2} \times .33 \times .58 = .0956$

(S)

6.75 12.50 11.75	15.50 6.75	15.50 12.50	15.50 11.75
------------------------	---------------	----------------	----------------

$$2 \overline{) 31.00}$$

$$\sqrt{15.50 \times 8.75 \times 3.00 \times 3.75 = 39.2}$$

(T)

12.50 12.25 7.00	15.875 12.50	15.875 12.25	15.875 7.00
------------------------	-----------------	-----------------	----------------

$$2 \overline{) 31.75}$$

$$\sqrt{15.875 \times 3.375 \times 3.625 \times 8.875 = 41.75}$$

(U) Deduction from open $.5 \times \frac{(1.33 + .33)}{2} = .42$

(V) $2 \times .5 \times 1.5 = 1.5$

155.5

①

25.83	72.205	3-2	Old Block
58.75	25.83	70.205	70.205
55.83		58.75	55.83
140.44			

$$\sqrt{70.205 \times 44.375 \times 11.455 \times 14.375} = 716$$

②

55.83 ✓	55.92 ✓	55.92	55.92
13.92 ✓		13.92	42.08
42.08 ✓	✓ 55.83		
2 111.83 ✓			

$$\sqrt{55.92 \times .09 \times 42 \times 13.84}$$

$$= \sqrt{2925.46}$$

$$= 54.1$$

③

13.92	25.335	25.335	25.335
14.17	13.92	14.17	22.58
22.58			
2 50.67			

$$\sqrt{25.335 \times 11.415 \times 11.165 \times 2.755} = 94.3$$

④

22.58	27.165	27.165	27.165
14.00	22.58	14.00	17.75
17.75			
2 54.33			

$$\sqrt{27.165 \times 4.585 \times 13.165 \times 9.415} = 124.1$$

⑤ + ⑥

$$\frac{13' - 10'' + 14' - 2''}{2} \times 13.92 = 194.88$$

⑦

$$\frac{63.67 + 63.58}{2} \times 12.04 = 766.05$$

Total = (716 + 54.1 + 94.3 + 124.1 + 194.88 + 766.05) 1944

$$= 1949.43$$

$$= 216.6 \text{ sq ft.}$$

Office Telephone Nos. 2805, 2806 &
2807

KUMBERALI BHALEDINO,

L. C. E.

LAND MANAGER & ARCHITECT.



Heritage

KMR.CDD.MmQ.1938-1939.01

**MUNICIPAL CORPORATION
KARACHI.**

FEB 22 1938

Reference. No. L. C. P. 52573

(10 GK7)

MEMO:

Re: Plot No. 10 1117

Sheet Machi Qr.

Plan for

on the above plot submitted by Mr. Lakhminder wadhmal

have been approved by the Karachi Municipal Corporation.

Lambaree Bhaleeno
Land Manager & Architect.

21 FEB 1938

Copy forwarded to —

1. Health Officer,
2. Supdt of Machinery,
3. Assessor,
- ✓ 4. Building Surveyor, with plan.
5. Land Surveyor,
6. Enquiry Officer,

for information and necessary action.

1000-23-12-37.

c.B wall for up.

27/11/38

*As to report if the
owner has built the
walls in his own
land.*

*S.L.S.
This is for you pl:*

*Y. M. S. 22/11/38
P.T.O*



B. S.

The set back is
as per land acquired &
the final sketch No K. L. 286
of 17.6.39, sent by S. L. H.
Officer. Hence no objection.

Bill.

19/12/31

G.D.

Sheet

No: Plot No

Profile in complete

Plan for

in volume
for.

C

Land Manager & Architect

Copy forwarded to —


1. Health Officer.
2. Super of Machinery.
3. Assessor.
4. Building Surveyor, with plan.
5. Land Surveyor.
6. Deputy Officer.

for information and necessary action.

1938-39-12-31


align 11/10

PLAN NO 1056

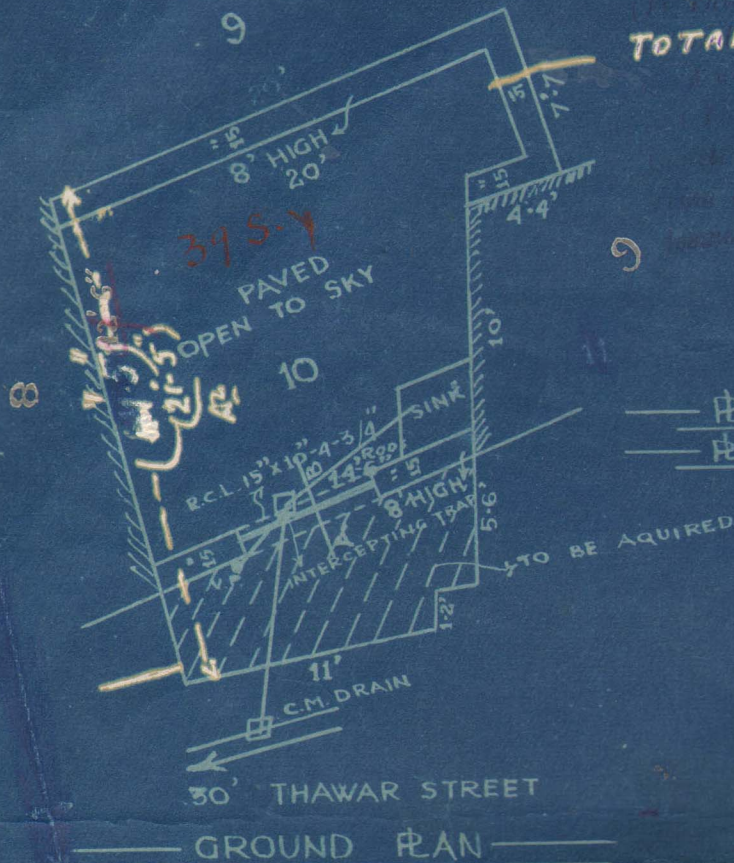

Note:
This is approved subject to the following conditions:
1. This sanction does not entitle the owner to build
TOTAL AREA = 39.87.
2. The compound wall to be built by the Govt. or

PLAN OF PROPOSED COMPOUND WALL ON
PLOT NO. 10. SHEET NO. M.M.7, MUCHHIMIANI Q.R.
SCALE 8 FT. TO AN INCH

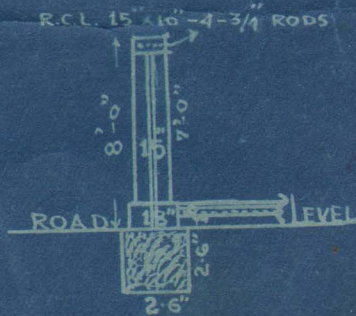

SECTION ON A.B.

APPROVED:

Lunacee Arlestin
21 FEB 1938

Engineer and Architect.

OWNER

L. LAKSHMIDAS WADHVAL

ARCHITECT

Deutscher
15-16-37

DI 17-5-39

TOWN PLANNING & VALUATION DEPARTMENT

CASE No. 31 OF 1938-39

ACQUISITION OF LAND FROM PLOT NO. 10, M.M.7
MACHI MIANI QUARTER.


SCALE 40 FEET TO 1 INCH

NOTE:-

TOTAL AREA 39 Sq.yds

AREA OF EXISTING BUILDING, 31 Sq. Yds.

AREA ACQUIRED SHOWN RED, 8 Sq. yds.

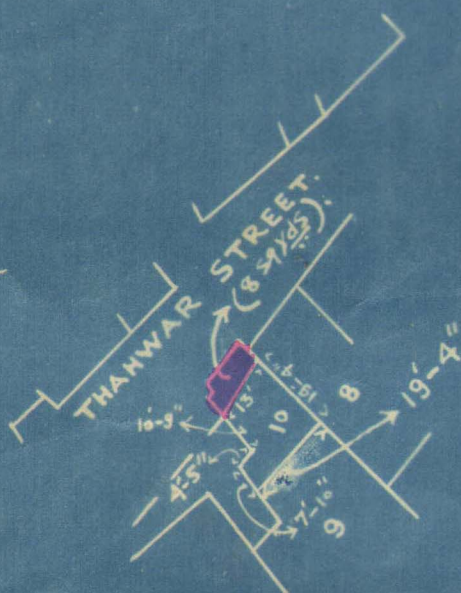

(SD). H. KHAN.
SPECIAL LAND ACQUISITION
OFFICER KARACHI.
DI. 24-5-39.

(TRUE COPY).

PREPARED BY. Satham. G. J.
31.5.39

CHECKED BY. *J. A. [unclear]*
1761-7

*Land Manager & Architect,
Karachi Municipal Corporation.*