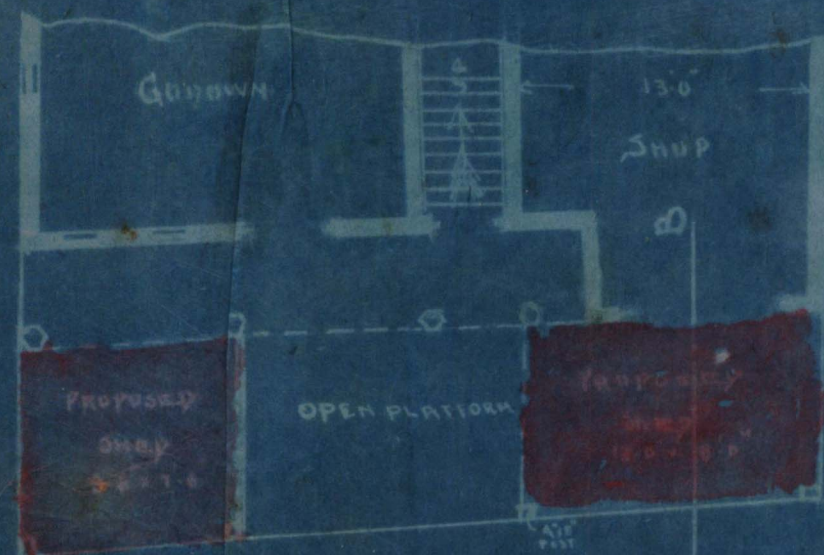


TO BE BUILT ON THE
PLAN OF THE 59 SHEET A-12
PLAT MIANEE Q²



PLAN

SITE PLAN

SCALE 1" = 100'



Rampart Row
30.0' WIDE



Goolamali Fadoo Rahemoo,
MERCHANT.

Telephone No. 2469

BOMBAY BAZAR,

Karachi, 1st July 1919

Telegraphic Address:—"FUDDOOANI."

To
The Chief Officer & Chief Engineer,
Karachi Municipality.

Dear Sir,

With reference to the Engineer's No L.S. 3128 with regard to my plot No 59 A-12 Machhi Meani Quarter stated as not standing in the Municipal Land Register, I beg to state that I own the plot as per sanad and sale-deed passed in my favour while bill for Municipal Taxes are invariably issued in my name. I should therefore like to know as to how the Municipal register does not show my name as owning the said plot.

Yours faithfully

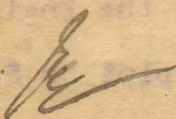
Goolamali Fadoo Rahemoo

598

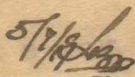
Land Surveyor
for information
report

2-2

for Vasuwan, attach
I.C. & report

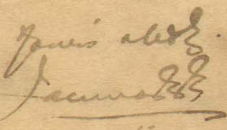
4/2/49 

Returned with report that
after producing sale.
deeds the plan has
been dealt in the
applicants' name. The
memo in reply to plan
has been sent for typing
in I.C. office. This is
attached with it.

5/1/49 

Self

I.C. is herewith
attached.

7/2/49 
Jaswanth