



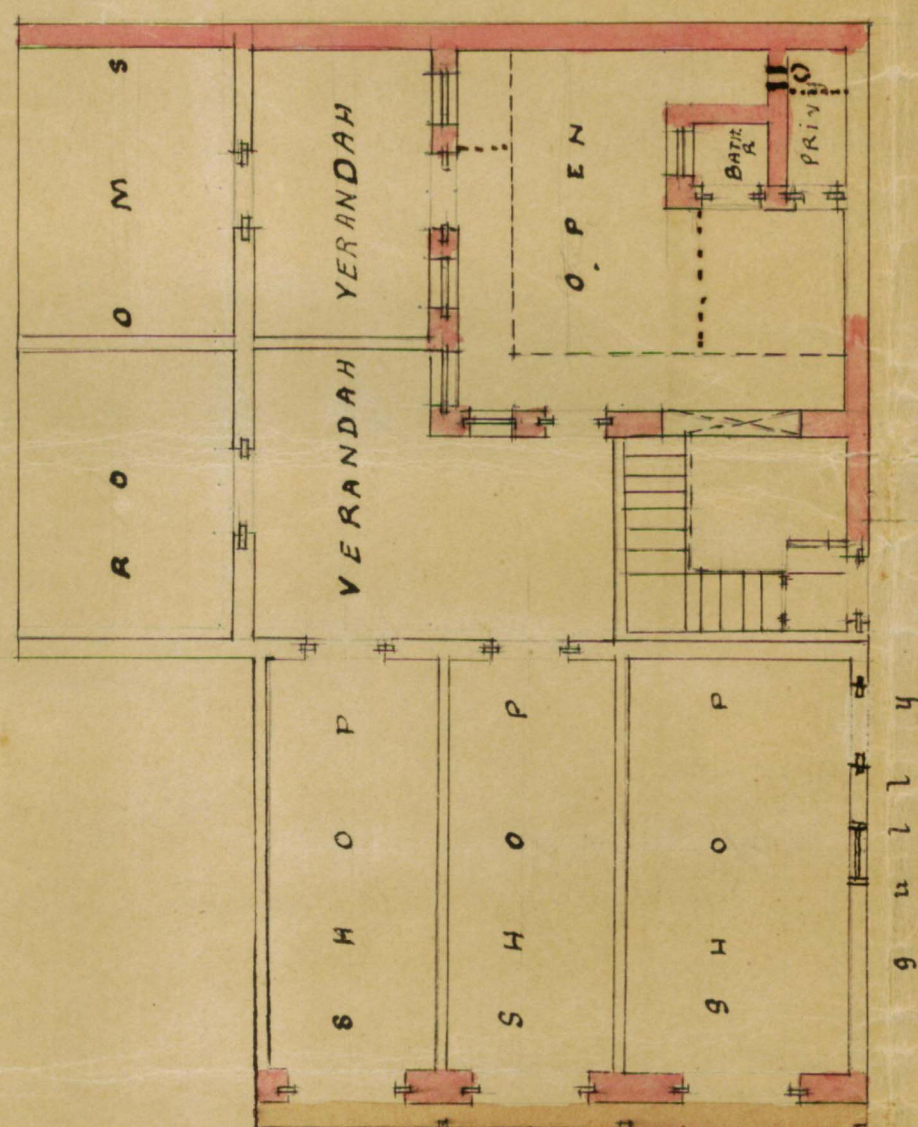


Ground plan

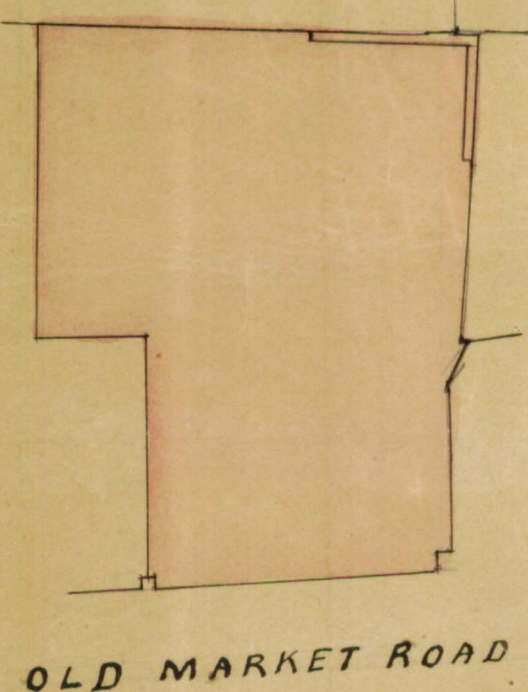

BLOCK PLAN
scale 20' = 1"



with 1/2" = 1' scale

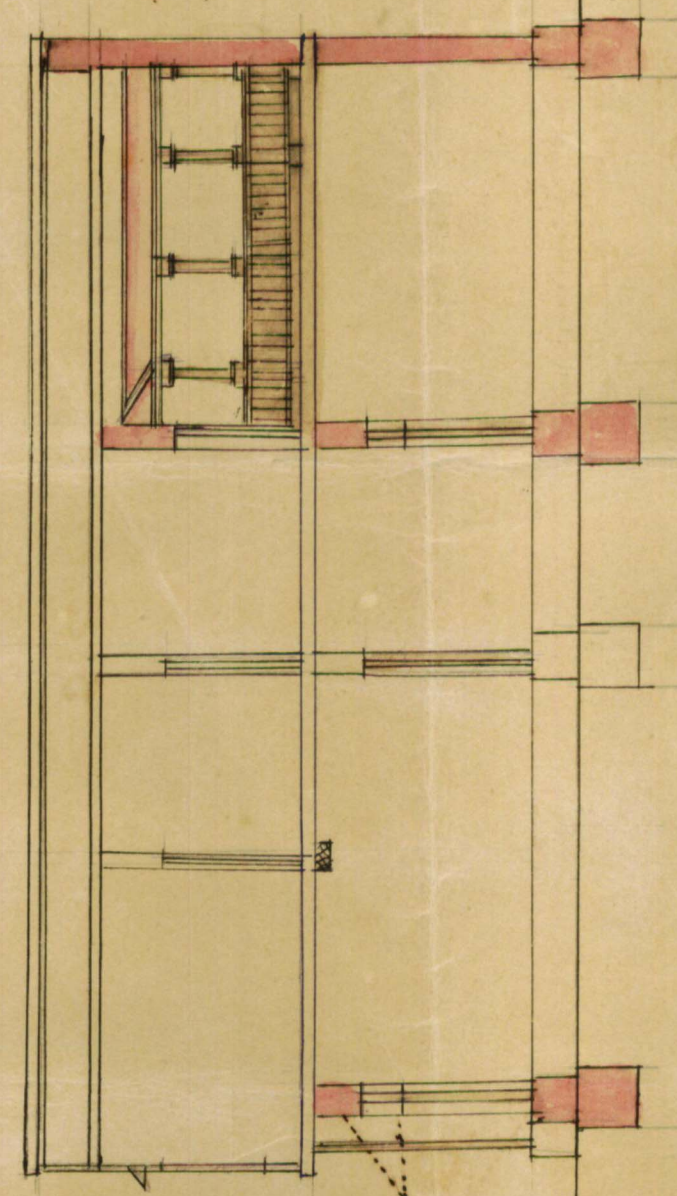

Section

Plan showing the addition & alteration to be made

in the house on plot no 51 ARS


NAPIER QUARTER

scale 10 feet = 1 inch.


1/2" = 1'
18/5/03

NOTE

:- RED shows the new work

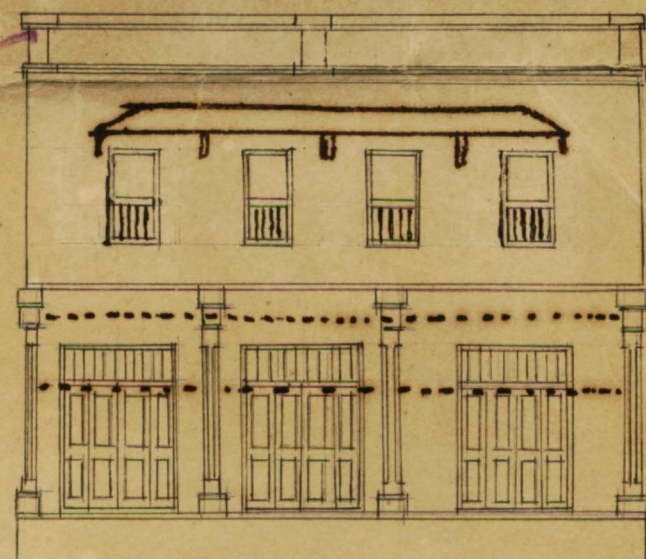

ELEVATION

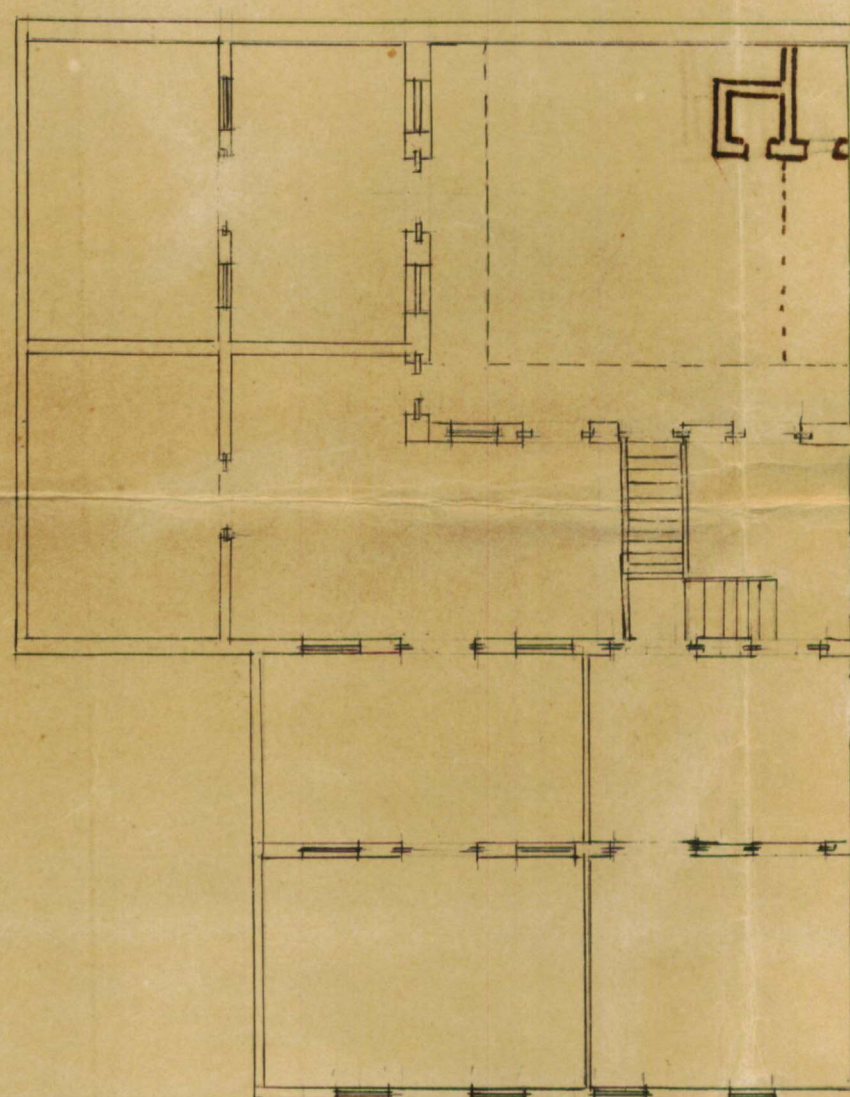

Upper plan

M. Inst. C. E.
Chief Engineer
Karachi Municipality.