



reference to his application dated 18th
received on 19th February M with plans for the
ing on Plot Nos: 42, 43 and 44 - C 6 Market quarte
amji Murarji and others are informed that one storey
be deleted from the plan. The return walls from the south
boundary to the verandah walls must be made pucca on the upper
floors. The plots must be amalgamated. The plans are returned
herewith for amendment.

J. A. H. Kerby

A. M. Inst., C. E.,

E n g i n e e r

Pr Karachi Municipality.

187

So

This may be filed

2/11/20

Qud

200--14-8-17.

Form No. 1.

Karachi, 18 - 2 - 1918.

NOTICE UNDER SECTION 96 OF ACT III OF 1901.

To

THE CHIEF OFFICER AND CHIEF ENGINEER,
KARACHI MUNICIPALITY.

SIR,

I beg to inform you that I intend building Tenements
on plot No. 42, 43 & 44

Survey Sheet No. 26 situate in _____

Street, Market — Quarter.

As required by the rules of the Municipality, I beg to submit herewith a plan of the same for your approval.

I beg to remain,

Sir,

Address :—

Your most obedient servant,

Signature of the applicant.

No. G. 1944 of 191

MUNICIPAL CHIEF OFFICER AND
CHIEF ENGINEER'S OFFICE,

Karachi, 19-2-1918

Forwarded to the Municipal Engineer for favour of disposal.

4198
20.2.18.

M. INST. C. E.

Chief Officer and Chief Engineer,
Karachi Municipality.

Mr. Benjamin
show to the Chief
Sanitary Inspectors

 $20 \frac{2}{8}$



2-2

No. E. ²1746 of 1918

MUNICIPAL ENGINEER'S OFFICE,
Karachi, 19th February 1918

MEMO.

The above application is forwarded to the Municipal Health Officer for
favour of report.

S. M. I. C. E.
S. M. I. C. E.

A.M.I.C.E.,
Engineer,
Karachi Municipality.

MUNICIPAL HEALTH OFFICER'S REPORT.

Returned to the Engineer, Karachi Municipality, with the following
remarks:— *No objection*

D. P. H. (London)
per Health Officer,
Karachi Municipality.

Date 22. 2. 1918

No. E. 1746 of 1918

MUNICIPAL ENGINEER'S OFFICE,
Date 22. 2. 1918

Forwarded to the Building Surveyor for report.

W. L. M. I. C. E.
W. L. M. I. C. E.
A.M.I.C.E.,
Engineer,
Karachi Municipality.

Through

THE LAND SURVEYOR,
Karachi Municipality.



BUILDING SURVEYOR'S REPORT.

Applicant's name Trickamji monaryj soltes
 Whether he is the owner of the plot on which it is proposed to build yes
 Plot under whose control Government
 Whether it is permanent or temporary Permanent
 The work proposed Bonib alima

Building Surveyor's report Sir,

Request that the plots require to be amalgamated.
The width of the street does not permit 4 stories
building as proposed.

Date 26/2 1918.

W. S. G. G. G.
Building Surveyor.

Submitted through the Land Surveyor.

LAND SURVEYOR'S REPORT.

Does the plot come under Alignment No

Area of plot —

Area under Alignment —

Remarks Sir,

I beg to report that the width of the
street does not allow 4 stories building
on these plots. Plots should be amalgamated
before any building is built. Request made

Transacted

W. S. G. G. G.
Land Surveyor.

ORDERS OF THE ENGINEER.

My trust be deleted from the plan
walls from the South boundary to the
the walls must be amalgamated
on the upper floor &
must be amalgamated.



No. E. of 191 .

MUNICIPAL ENGINEER'S OFFICE,

Karachi, _____ 191

Submitted to the Managing Committee with a recommendation that
the plan be approved.

A.M.I.C.E.,

Engineer,

Karachi Municipality.

Through

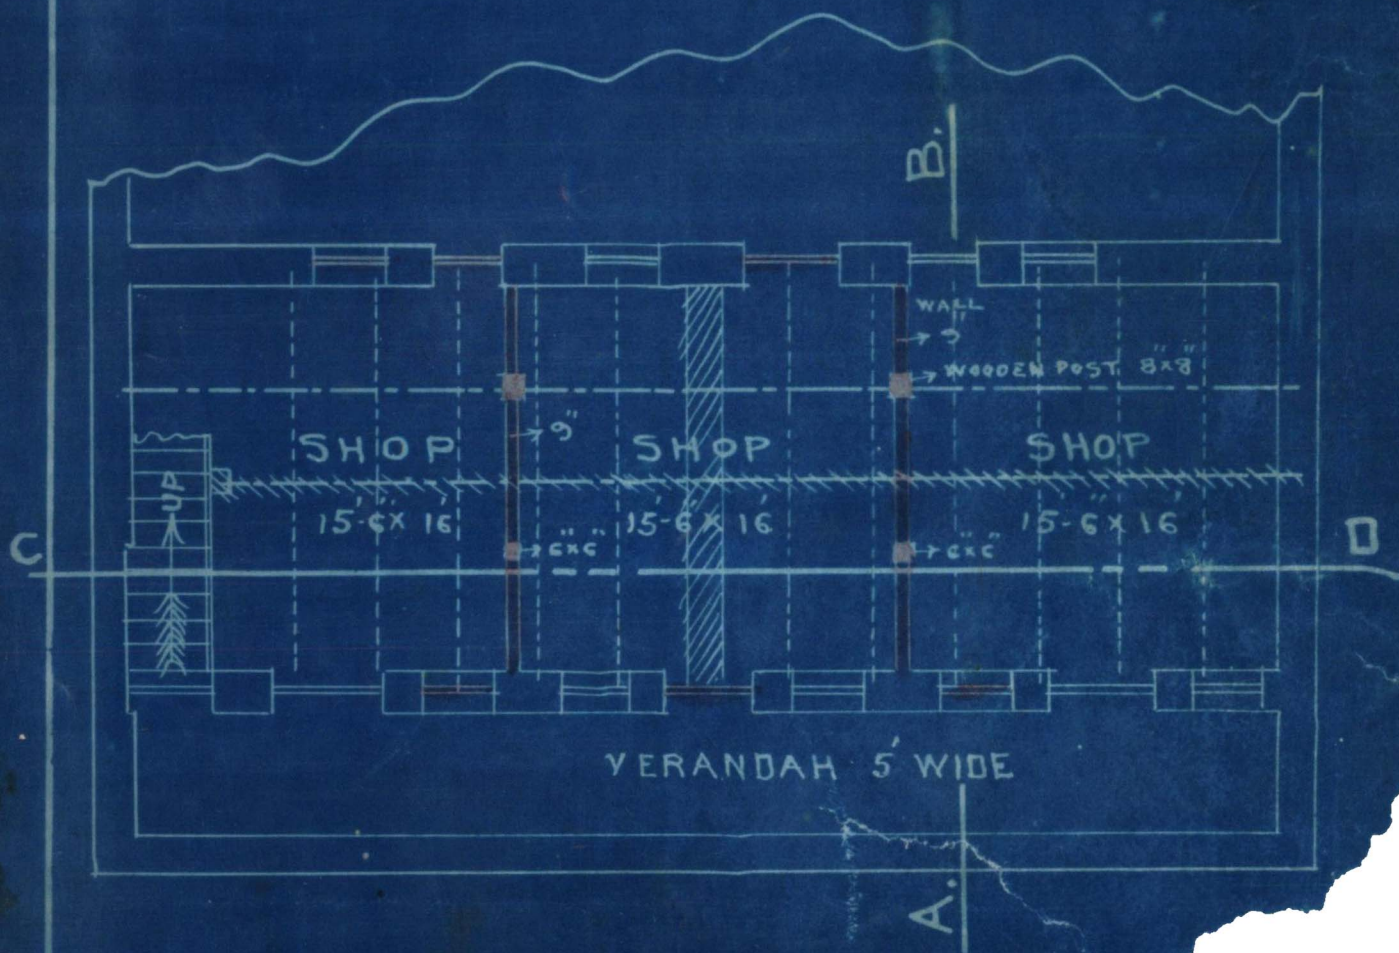
THE CHIEF OFFICER & CHIEF ENGINEER,

KARACHI MUNICIPALITY.

RESOLUTION OF THE MANAGING COMMITTEE.

Resolution No. _____ dated _____

SECTION

PLAN



DRAWING NO: 173

IRATION

WET QR:

SECTION ON C.D



Assam N. A.
ARCHITECT & SURVEYOR