



75.

BUILDING COMPLETION REPORT.

LAND MANAGER AND ARCHITECT'S OFFICE,

Karachi, _____ 193

To

THE LAND MANAGER AND ARCHITECT,
KARACHI MUNICIPALITY.

Sir,

I beg to report that the building work on plot No. 2 Sheet C.L.6
Civilian's Quarter owned by Mr. The Sind Club

has been completed according to plans approved by the Municipality. Orders
are requested to file the correspondence.

Your obediently,

Building Surveyor "A" Section
Karachi Municipality. 8/4/30.

No. L.M.A. 157 133.C.13 of 1930
Karachi 10th April 1930

Copy to the Assessor & Collector for information.

9/4/30

B. Sc. A. M. Inst. C. E.
Land Manager and Architect,
Karachi Municipality.

U.S.
874



268

2

N. J. MODI.
B. Sc. Engineering (London).
A. M. INST., C. E., L. C. E.
A. M. I. S. E., M. R. San. I.
Land Manager & Architect.

No. L. M. A./BS. 4801 of 1929.

MUNICIPAL OFFICE,

Karachi, 23/8 1929.

MEMO;

Building Surveyor Section A in informed

that Mr. The Secretary Sind Club, Karachi has been permitted
to build bathing places
his house

on plot No. 2, Ch-6 Street

Caril hme's Quarter, report should be made to the
undersigned when house is completed.

N. J. Modi.

9/11

B. SC., A. M. INST. C. E. 22/12/29
Land Manager & Architect.

*Sind Club.
an explanation of
on this 300 of
Hall.*

*cl. comp Refn L
5/4/29*




Heritage


KMR.CDD.CiQ.1930.01

SIND CLUB KARACHI
PROPOSED BATHING PLACES
SCALE 4' = 1"

PLAN

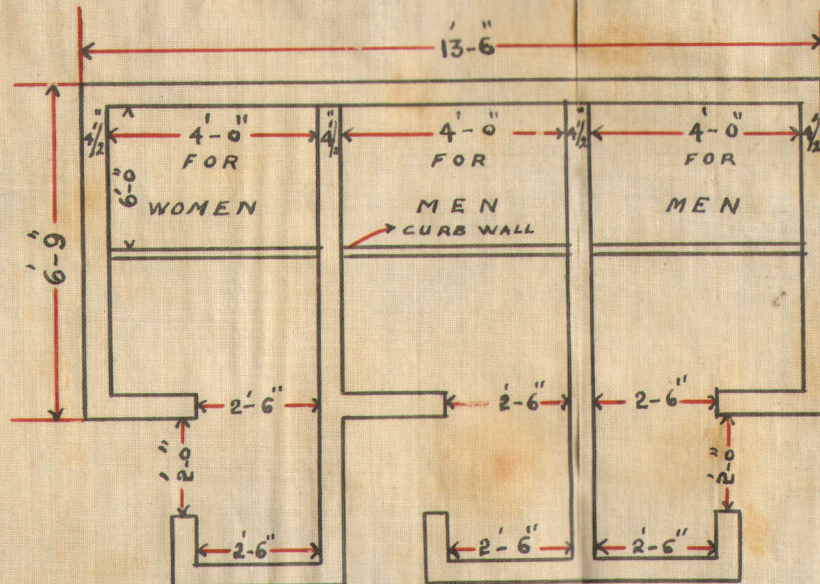

SECTION ON A.B.

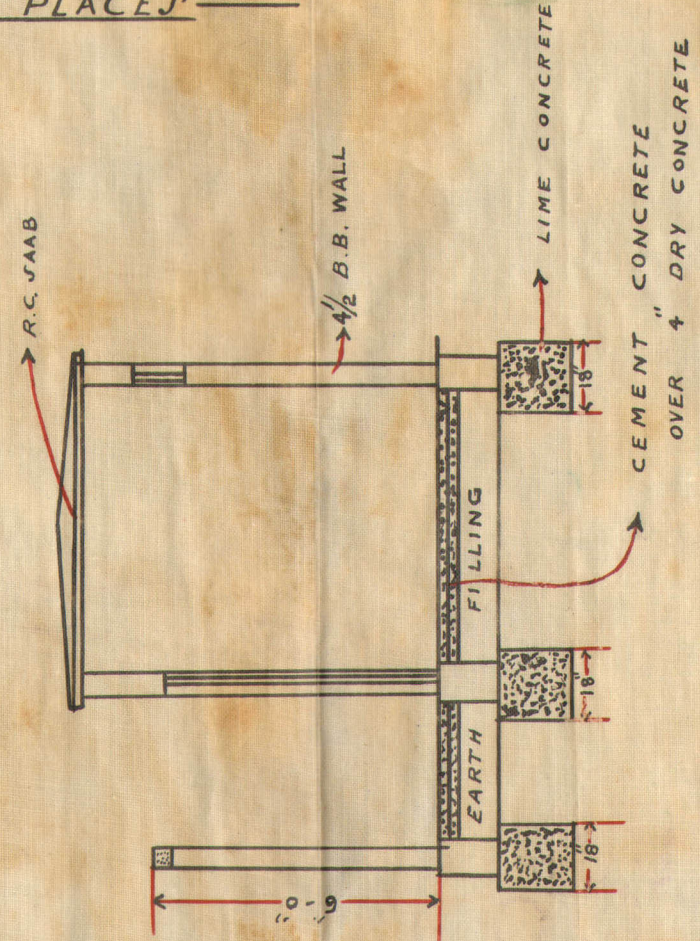

APPROVED.


R. J. Motilal
8/8

B. Sc., A. M. Inst. C. E.,
Land Manager & Architect.

Note:
Plan is approved subject to the following conditions:-
1. This sanction does not entitle the owner to build on land not conveyed to him either by the Govt. or the Municipality by a sanad or entry in a sanad.



—SIND CLUB KARACHI—
—PROPOSED BATHING PLACES—
—SITE PLAN—
—SCALE 20' = 1" INCH—

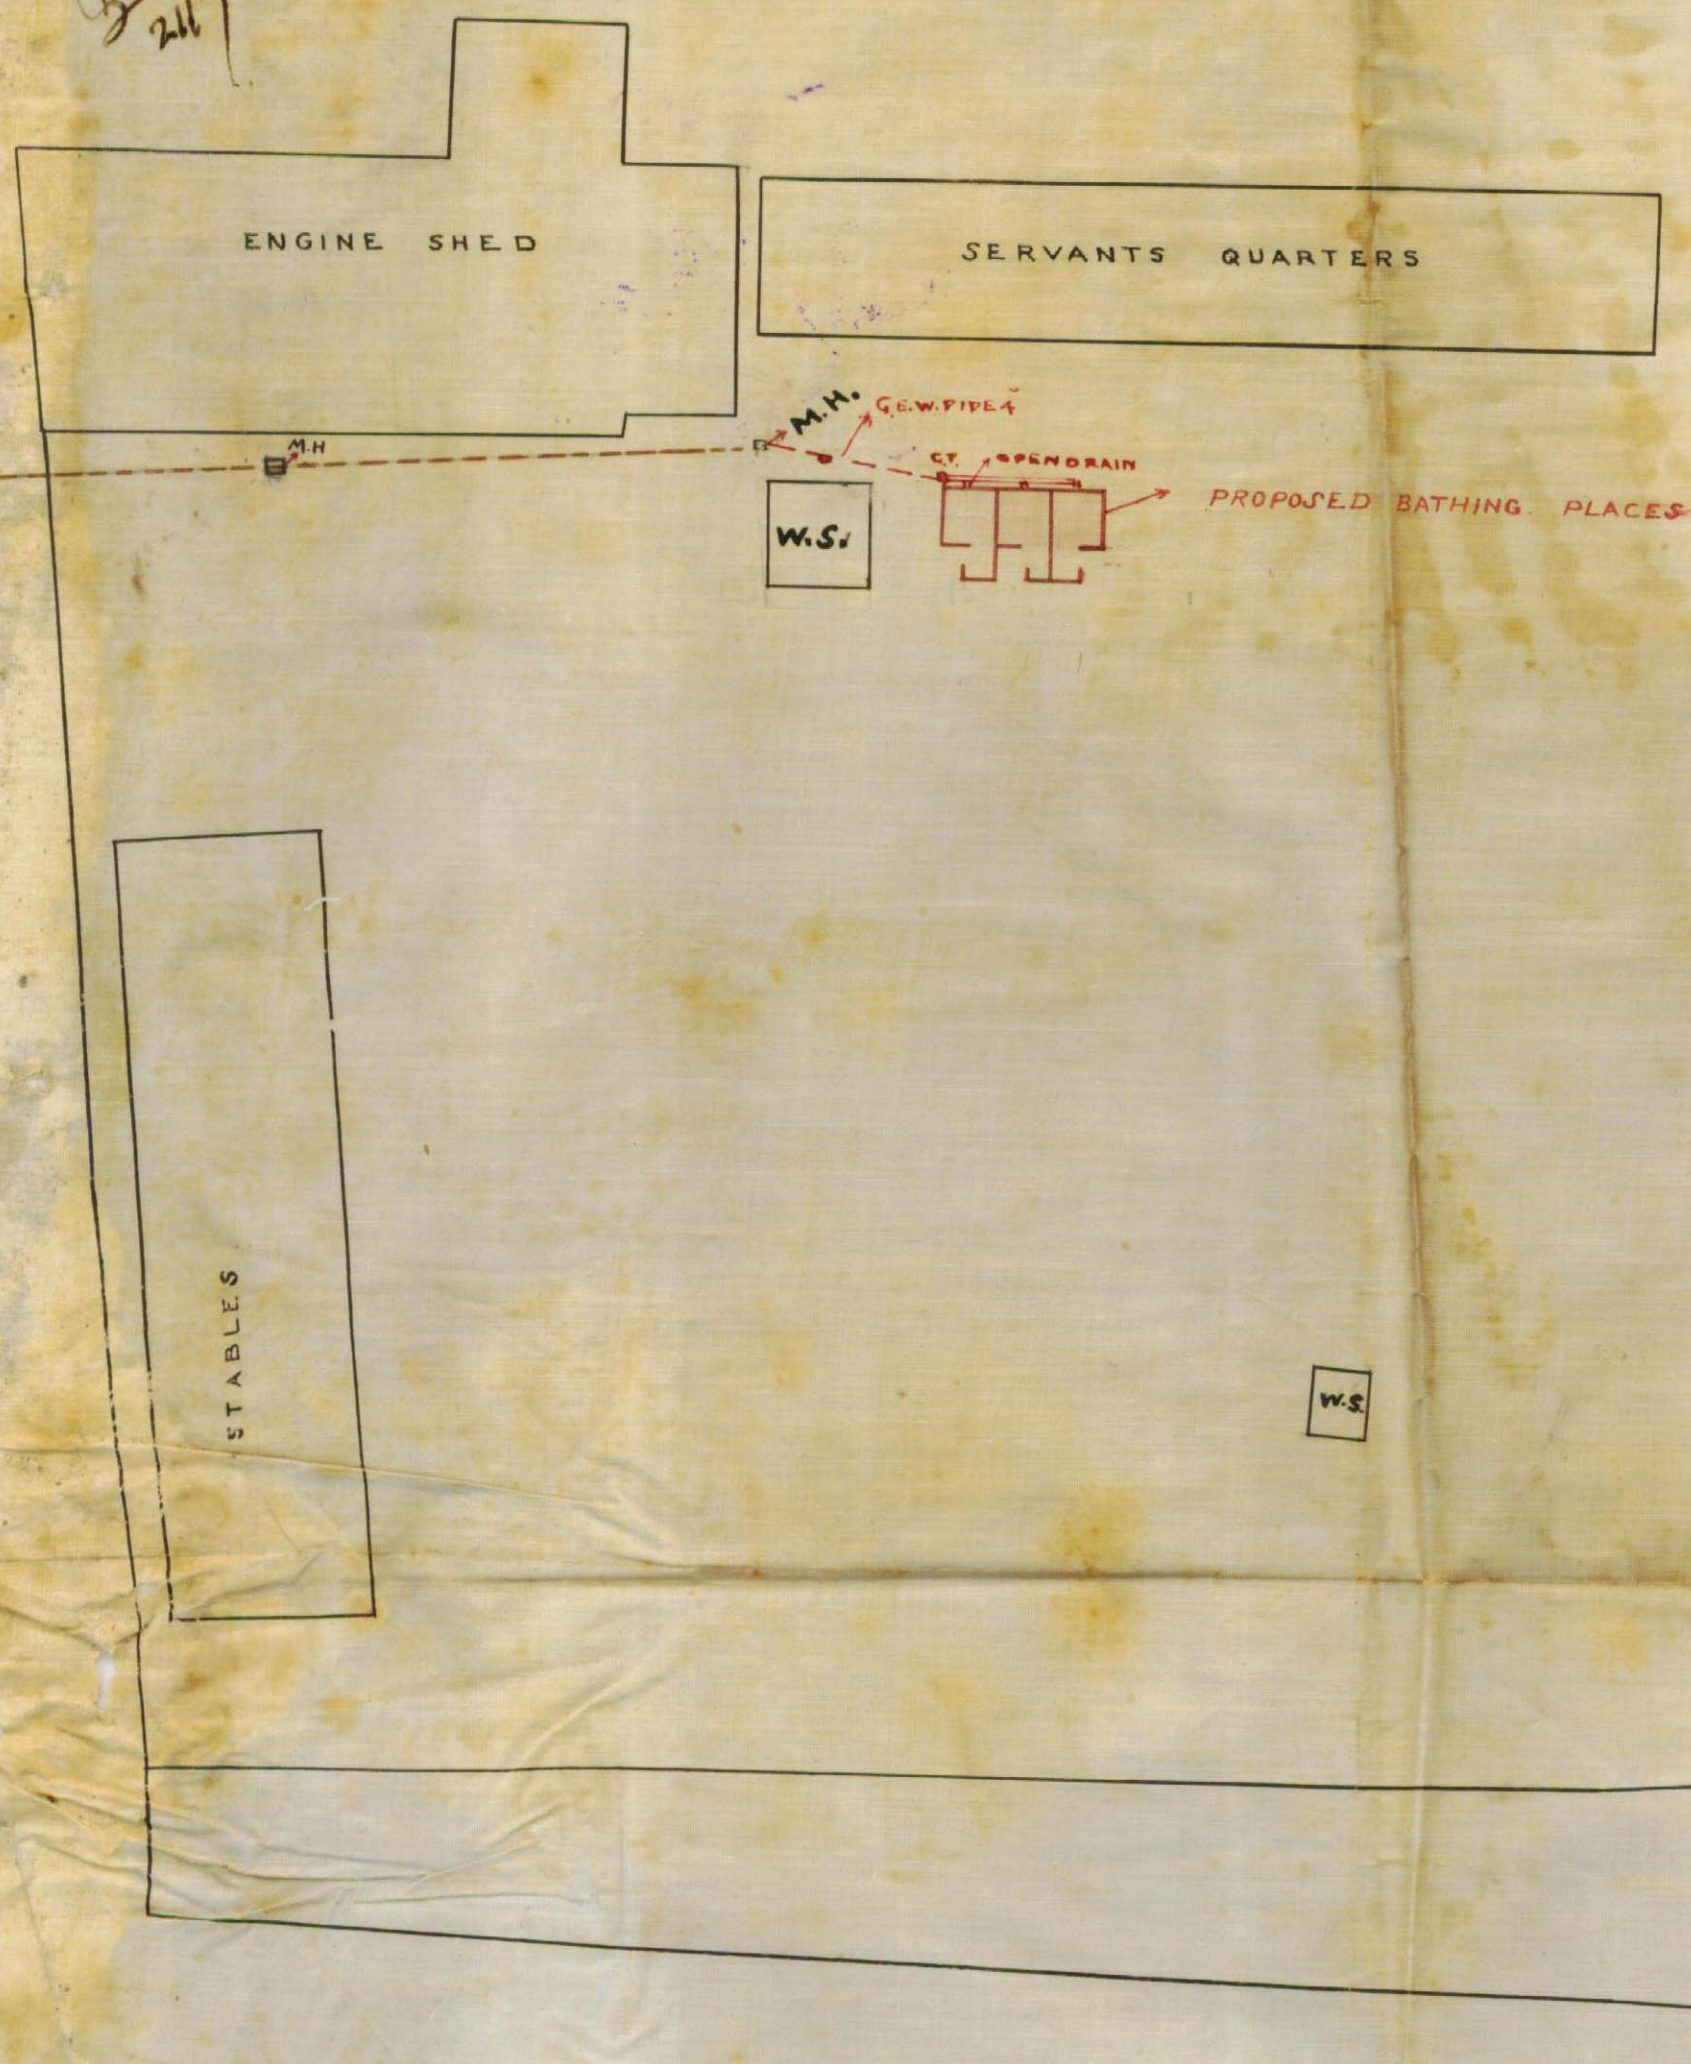

APPROVED.

A. J. Prothi
B. Sc., A. M. Inst. C. E.,
Land Manager & Architect.

Note:
This is approved subject to the following conditions:-
1. This sanction does not entitle the applicant to build on land not conveyed to him either by the Govt. or the Municipality by a sanad or entry in a sanad.