



(13)

200-16-1-14.

Form No. 2.

ORDERS UNDER SECTION 96 (2) OF ACT III OF 1910.

No. E/ 441 OF 1914.

MUNICIPAL ENGINEER'S OFFICE,
Karachi, 19th June 1914.

MEMO:

With reference to his application dated 5th June 1914.,
Quarter, is approved, and permission to build in accordance therewith is
granted. The building to be erected subject to the Byelaws and Rules of the
Municipality.

J. Cecil L. Bailey
A. M. INST. C. E.,
Engineer,
Karachi Municipality.

NOTE 1.—This pass does not give permission to occupy Municipal land with building materials. This can only be allowed when the street is wide enough to permit building materials being deposited on it without it being a source of danger to the public, and only then on a hoarding being placed round the land to be occupied, and on payment in advance of fees for occupation of Municipal land, at the following rates:—

	RS.	A.	P.
(1) For the first three months, per square yard, per diem	...	0	0 $\frac{1}{2}$
(2) For the next three months „ „ „	...	0	0 1
(3) For any subsequent time „ „ „	...	0	0 2

NOTICE 2.—Windows, steps and doors of the building will not be permitted to project on or overhang any public street or Municipal land.

NOTICE 3.—Plinths will not be allowed to project more than 2" on any public street for ornamental purposes.

No. E. 442 of 1913

MUNICIPAL ENGINEER'S OFFICE,

Karachi, 19 January 1914

MEMO.

Inspector Turk Quarter is informedthat The returned Journal has been permittedto Shah his houseon plot No. 442 Street Turk

Quarter. Report should be made to the undersigned when the house is completed.

J. Cecil L. Verley

A. M. INST. C. E.,

Engineer,

Karachi Municipality.

Through the Health Officer, Karachi Municipality.

Note—The plot is held as a temporary occupation lease and the owner agrees to remove the building at any time on receiving a month's notice to do so.



(500-14-9-13.)

Form No. 5.

No. E. 443 of 1913

MUNICIPAL ENGINEER'S OFFICE,

Karachi, 19th January 1914

MEMO.

Building Inspector _____ is informed


Quarter. Report should be made to the undersigned when the house is

completed.

J. Cecil L. Verley

A. M. INST. C. E.,

Engineer,

Karachi Municipality.

Ar. / 27



To
 Lat Sumner
 for report
 15/10
 Sir
 The Engineer
 Karachi Municipality

Sir-

Referring to your no E8349 dated 18th December 1913. I beg to return the plan of House proposed to be built on plot no. 41-A19, market quarter, duly amended as desired & to request that you will pass the same early.

Karachi
 19.12.1913
 3.1.1914

I beg to remain
 Sir

Your most obedient servant

30/12/13
 i.e. Uloomal Gownmal

52
Sir,
Ref. to this, I beg
to report that there is
no objection now to grant
permission as per amended
plan submitted by the
Appl. showing alignment
to be set back.

Respectfully,
Yours obedt

[Signature]

7/1/14

Submitted to the Commr.
for order. There is now
no objection to grant permission
as the applicant is willing
to set back the alignment.


[Signature]

8/14


L. Swamy is up with this

19/1/14


After applicant date will be

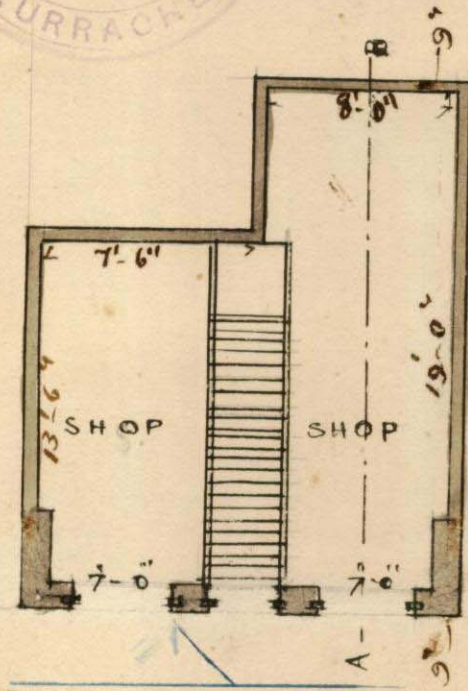


GROUND FLOOR

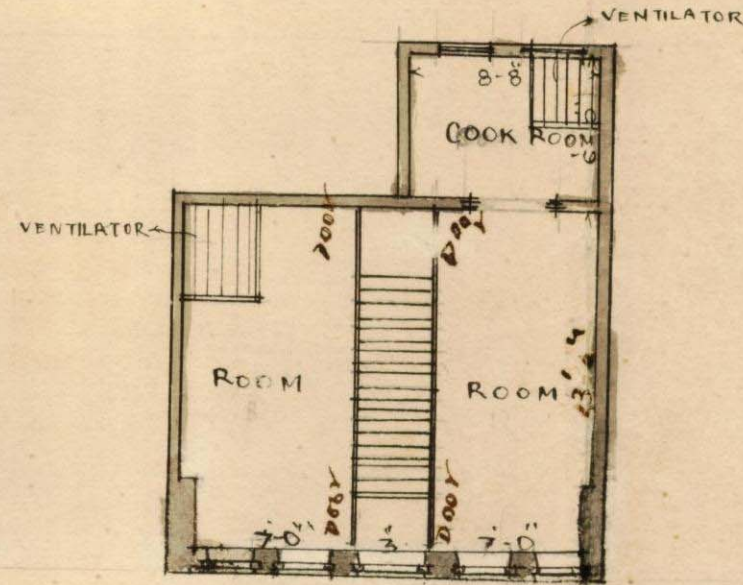


1ST FLOOR

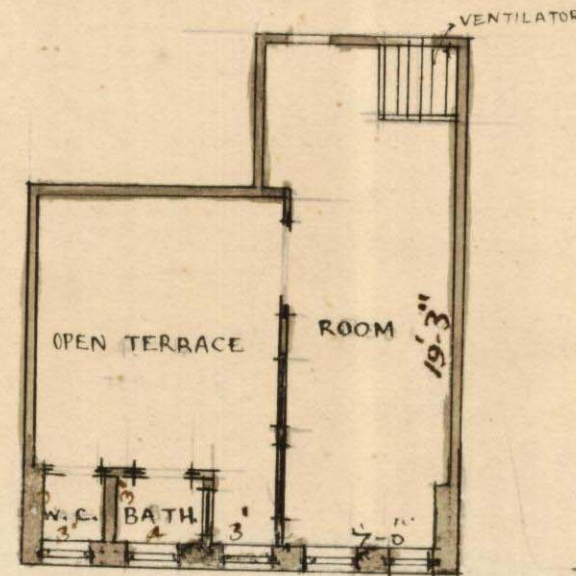

2ND FLOOR

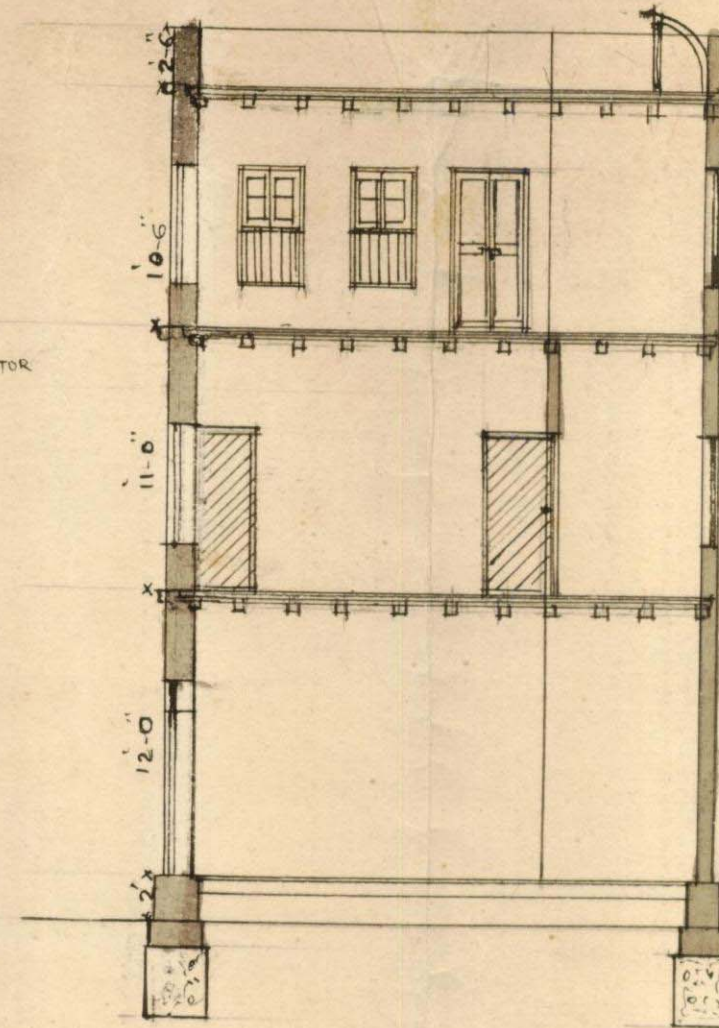

SECTION ON AB

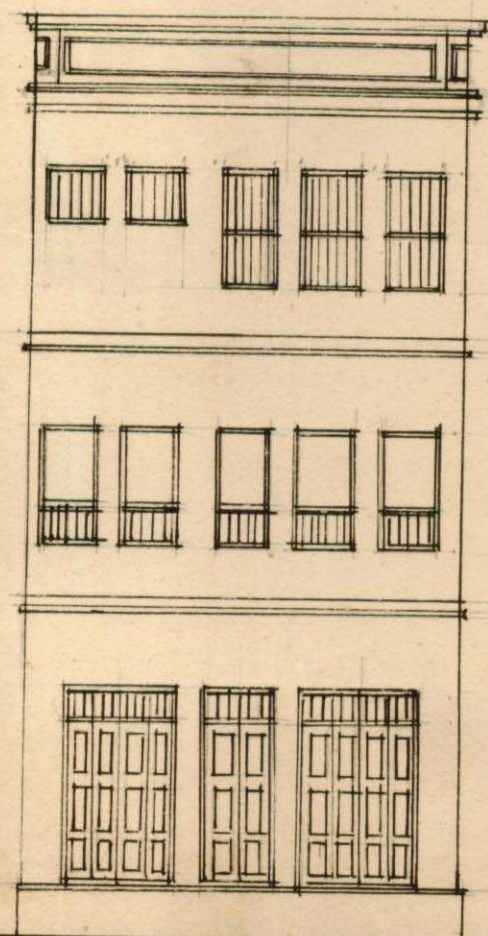


ELEVATION

J. Gail. Verley
A. M. Inst., C. E.,
Engineer,
Karachi Municipality

Plan showing the house to be built on
plot No. 41-A, 19, Market Quarter
Scale 8 feet to 1 inch.

BLOCK PLAN
SCALE 20' = 1"

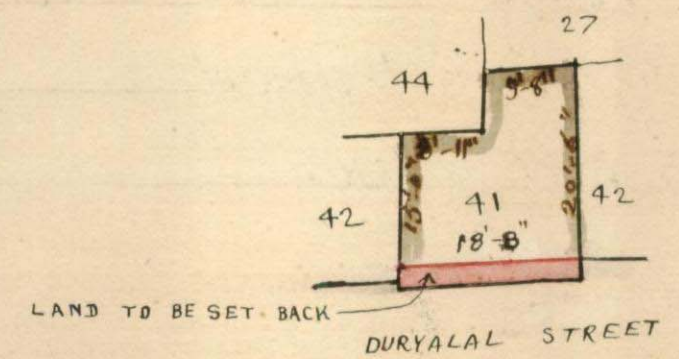

સઈ કુતુમલ ગોકુમલ
i.e. *Uloom al Gokoomal*
12. 11. 1903

Kharshid "Kharshid"
11-11-1903

Municipal Office.

Karachi, 18th December 1913.

M E M O / -

With reference to his application dated 12th ultimo received in this office on 5th inst, with a plan of building shops with upper stories on plot No.41, A-19, Market quarter, Mr. Utoomal Gowoomal is informed that (4½) four and a half square yards from the above plot came under aquisition. He is therefore requested to set back the line as shown on the attached tracing and submit his plan duly amended accordingly.

The plan is also returned for amendment.

J. Cecil L. Verley

A. M. Inst. C. E.,

E n g i n e e r ,

Karachi Municipality.

J.K.V.

Memorandum
 Sir J. P. of this
 appl. of 12th & returned received
 in this office on 5th inst.
 with a plan for building
 shops with appurtenances
 on plot no 41, High Walk,
 & as Mr. Woodhouse
 is informed that (4 1/2)
 four & a half square
 yards from the above
 plot come under
 acquisition. He is
 therefore requested to
 set back the line
 as shown on the
 attached tracing &
 submit his plan
 duly amended
 accordingly -

The plan is also
returned for amendments

V.

Engin
4th *Ken*



500-13.8.13.

Form No. 1.

Karachi, 12 " 1913.

NOTICE UNDER SECTION 96 OF ACT III OF 1901.

To

THE CHIEF OFFICER AND CHIEF ENGINEER,

KARACHI MUNICIPALITY.

SIR,

I beg to inform you that I intend building 3 Nooid House

on plot No. 41

Survey Sheet No. A 19 Situate in Dargah

Street Market Quarter.

As required by the rules of the Municipality. I beg to submit herewith
a plan of the same for your approval.

I beg to remain,

Sir,

Your most obedient Servant,

सरि कउमल गोउमल

c.e. Moimal Gowomal.

Signature of the applicant.



No. G. of 13064 1913

MUNICIPAL CHIEF OFFICER AND

CHIEF ENGINEER'S OFFICE.

Karachi, 12 December 1913

Forwarded to the Municipal Engineer for favour of disposal.

3055
8/12/13A. M. INST. C. E.,
Chief Officer and Chief Engineer,
Karachi Municipality.

Mr. Benjamin - done to H.O.

8/12/13



2

No. E. 7896 of 1913.

MUNICIPAL ENGINEER'S OFFICE.

Karachi 5th December 1913.

MEMO.

The above application is forwarded to the Municipal Health Officer for
favour of report.

A. M. I. C. E.

Engineer,
Karachi Municipality.

MUNICIPAL HEALTH OFFICER'S REPORT.

Returned to the Engineer, Karachi Municipality, with the following
remarks.—

No objection

D. P. H. (London.)

Health Officer,

Karachi Municipality.

Date 10-12-1913.

No. E. 8048 of 1913.

MUNICIPAL ENGINEER'S OFFICE.

Date 11th December 1913.

Forwarded to the Enquiry Officer for report.

A. M. I. C. E.,

Engineer.

Karachi Municipality.

Through.

The Land Surveyor,

Karachi Municipality.



ENQUIRY OFFICER'S REPORT.

Applicant's name

The internal Sewer

Whether he is the owner of the plot on which it is proposed to build

The work proposed

To put into a house

Enquiry Officer's report

*if there is no objection
in paying for to put into a house
there is no objection to putting in
the sewer*

Date

12 Dec 1913.

Enquiry Officer.

Submitted through the Land Surveyor.

LAND SURVEYOR'S REPORT.

Does the plot come under Alignment

no

Area of plot

Area under Alignment

Remarks

*Sir, With reference to this I beg to report
that there is no objection to permission to
build the sewer**Consolidated
rate*

Date

8-1 1914.

Land Surveyor.

ORDERS OF THE ENGINEERS.

*Issue Pass**J. Cecil L. Verley*

A. M. I. C. E.,

Engineer,

Karachi Municipality

4

No. E. 555 of 1914

MUNICIPAL ENGINEER'S OFFICE.

Karachi, 22nd January 1914.

Submitted to the Managing Committee with a recommendation that the plan be approved.

In witness

A. M. I. C. E.,

A. M. I. C. E.,

Engineer,

Karachi Municipality.

Through

THE CHIEF OFFICER AND CHIEF ENGINEER,

KARACHI MUNICIPALITY.

RESOLUTION OF THE MANAGING COMMITTEE.

Resolution No. _____ Date _____

