

1924

1-1

$$\begin{array}{r} 2087 \\ \hline 15 \end{array}$$

17c 5 M.R

ANNUAL REPAIRS TO S.M.H. SOCIETY SHOPPING CENTRE.

.....
ESTIMATE COST:-Rs.7700.00

S.NO.	Description of work	Quantity	Rate	Per.
1.	White wash 2 coats.	79100 Sft.	-/94	43sft.
2.	Colour wash 2 coats.	40700 Sft.	1/2	43sft.
3.	Distemring 2 coats oil bount over a primery coat.	36848 Sft.	7/-	43sft.
4.	Scraping old colour and white wash	156700 Sft.	-/50	43sft.
5.	Scraping old oil paint	14328 Sf.t	2/-	43sft.
6.	Oil paint 2 coats.	14328 Sft.	9/-	43sft.
7.	S/I glass paints 2403	354 Sft.	1/25	43sft.
8.	1" patch repairs 1:3 including removing old drainage.	250 Sft.	23/-	43sft
9.	2" C.C. flooring 1:2:4 over 3" 1:4:8.	200 Sft.	56/-	43sft.
10.	Repairs to doors & windows.	18 Nos.	10/-	Each

I/We hereby quote

% above/below the schedule of rates.

Time limit

Signature of tenderer.....

Penalty Rs..... per day.

Full Address.....
.....

CHIEF ENGINEER. K.M.C.

Mahmood.
16-10-62.

ORDER UNDER SECTION 96 (2) OF ACT, III OF 1901

No. L. M. A.

4401

OF 1924

MUNICIPAL ENGINEER'S OFFICE,

Karachi, 27 7 1924
6 8

MEMO.

With reference to his application, dated _____ 192 .
theirMr. Sayabali Abdullmussemi Maudhumi is informed
Messrs. arethat the plan submitted by him for building a house
them_____ on plot No 17 Survey Sheet C-5
situate in _____ Street, Market
Road

Quarter, is approved, and permission to build in accordance therewith is granted. The building must be erected, in accordance with the By-laws and Rules of the Municipality.

27 PM 4/8
Ex Engineer,
Karachi Municipality.

NOTICE 1.—This pass does not give permission to occupy Municipal land with building materials. This can only be allowed when the street is wide enough to permit building materials being deposited on it without it being a source of danger to the public, and only then on a hoarding being placed round the land to be occupied and on payment, in advance, of fees for occupation of Municipal land, at the following rates:—

	Rs. A. P.
(1) For the first three months, per square yard per diem	... 0 0 $\frac{1}{2}$
(2) For the next three months " " "	... 0 0 0
(3) For any subsequent time " " "	... 0 0 2

NOTICE 2.—Windows, steps and doors of the building will not be permitted to project on or overhang any public street or Municipal land.

NOTICE 3.—Plinths will not be allowed to project more than 2 inches on any Public street for ornamental purposes.

Copy to the B. S. B. 4402 for information & report.

Copy to the Inspector 4403 for information & report.

Copy to the Supr. of Mach. 4404 for information & report.

Karachi, 2nd July 1924.

NOTICE UNDER SECTION 96 OF ACT III OF 1901.

THE CHIEF OFFICER AND CHIEF ENGINEER,
KARACHI MUNICIPALITY.

SIR,

I beg to inform you that I intend building a house & shop

on plot No. 17

Survey Sheet No. C5 situate in Marrut

Street, Mankel Quarter.

As required by the Rules of the Municipality I beg to submit herewith a plan of the same for your approval.

I beg to remain,

Sir,

Your most obedient Servant,

Address:—

July 24: 1924
cl. A.K. Mandiwala.

Signature of the Applicant.

Insp. Ismail
Show to the
97

No. G. 11305 OF 192

MUNICIPAL CHIEF OFFICER AND
CHIEF ENGINEER'S OFFICE,

Karachi, 317/24 192

Forwarded to the Municipal Engineer for favour of disposal.

Bhagwan

for Chief Officer and Chief Engineer,
Karachi Municipality.



Form No. 1 A-500-6-4-24.

No. G. _____ of 192 _____

MUNICIPAL CHIEF OFFICER'S OFFICE,

Karachi, _____ 192 _____

MEMO :

The above application is forwarded to the Municipal Health Officer
for favour of report.

Chief Officer.

MUNICIPAL HEALTH OFFICER'S REPORT.

Returned to the Land Manager and Architect, Karachi Municipality
with the following Remarks:—

Date of receipt _____

Date of disposal _____

Date 8-7- 192 4

Health Officer



No. L. M. 192 .

Date of receipt:

LAND MANAGER AND ARCHITECT'S OFFICE,

Karachi, 192 .

Forwarded to the Building Surveyor and Land Surveyor for report.

Land Manager and Architect.

BUILDING SURVEYOR'S REPORT.

Applicant's Name

Lysali Afidagkhar
*H. R. Mandawala*Whether he is the owner of the plot on which it is proposed to build 22

Plot under whose control

Govt.

Whether it is permanent or temporary

permanent.

The work proposed

house

Building Surveyor's Report

- 1. Kitchen + nohani are not shown in section*
- 2. Beam should be provided below the p. wall*
+ gallery

Date

*14/7**A. W. Q.*

Building Surveyor.



4-3

3

LAND SURVEYOR'S REPORT.

Does the plot come under Alignment -Area of plot -Area under Alignment -

Remarks

*no objection to the site plan*Date 192*Signature*
Land Surveyor.

Remarks of.

LAND MANAGER AND ARCHITECT.

*The girders for 24' span must be Rolled Steel beam
 16" x 6", the front joints should be 7" x 4" three feet apart,
 the rear joints ought to be 9" x 4" 3' apart.
 Below the P. Wall 13" x 7" beam should be provided.*

*The plans may be
 passed.
 July
 21/7*

*July
 19/7*

E/o

*P. isan pass.**After
 22/7*Date of disposal 1924.01.22

Submitted to Ex. Engineer :

Land Manager and Architect.

No E. 21071 of 192

MUNICIPAL ENGINEER'S OFFICE,

Karachi, 192

Ex. Engineer's orders

Returned to Land Manager and Architect for necessary action and submission to Managing Committee.

Ex. Engineer,
Karachi Municipality.

12896
15/7.
13/8
No. L.M. 4504 of 1924.

Submitted to the Managing Committee through the Chief Officer.

13.8.24.

Land Manager and Architect.



RESOLUTION OF THE MANAGING COMMITTEE

Resolution No. dated


E/o. ...
...

① 6


170

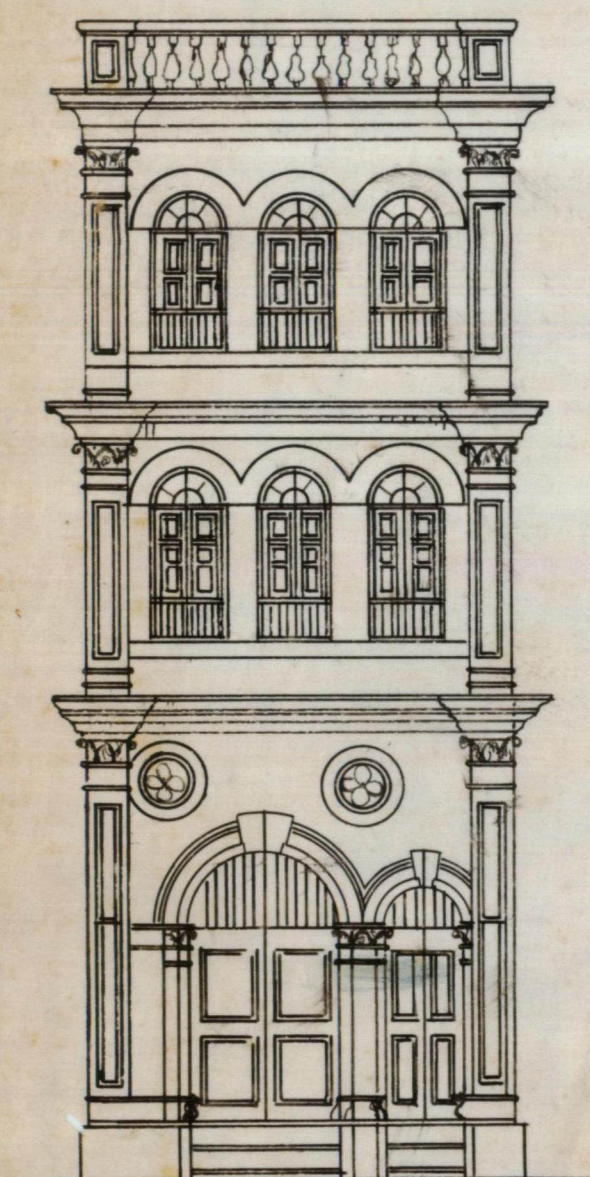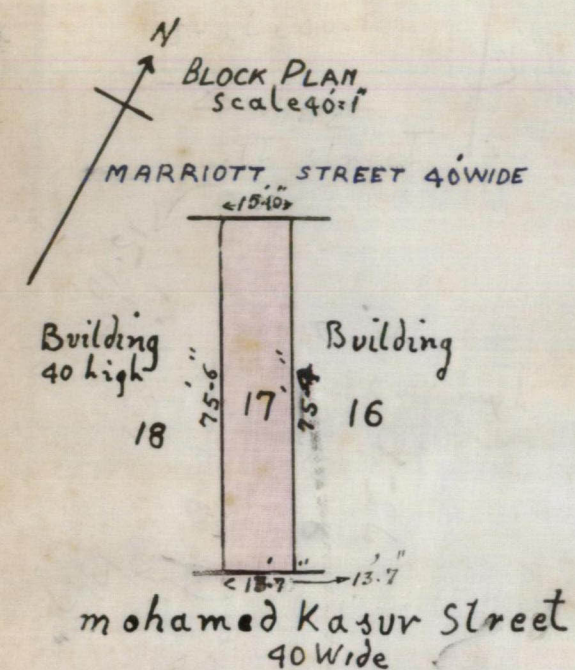

ELEVATION

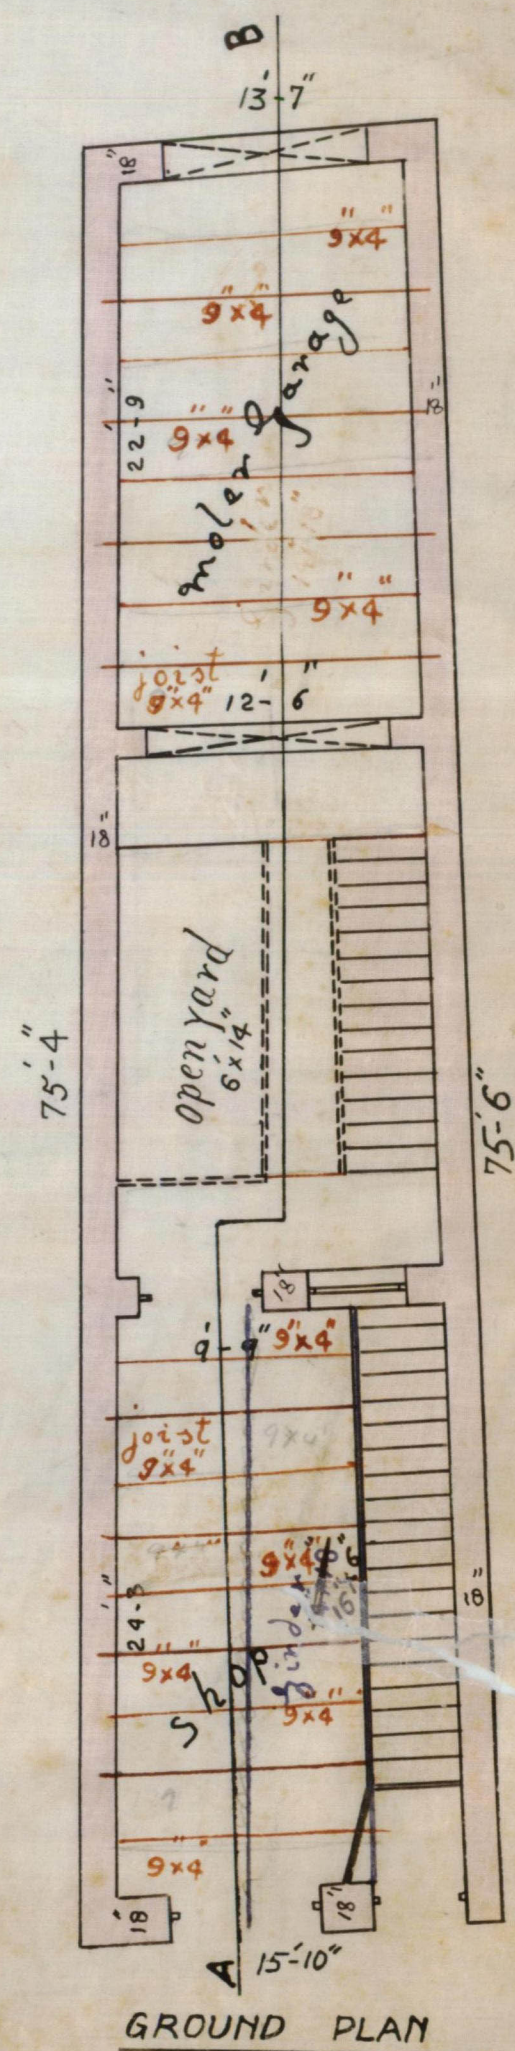

GROUND PLAN

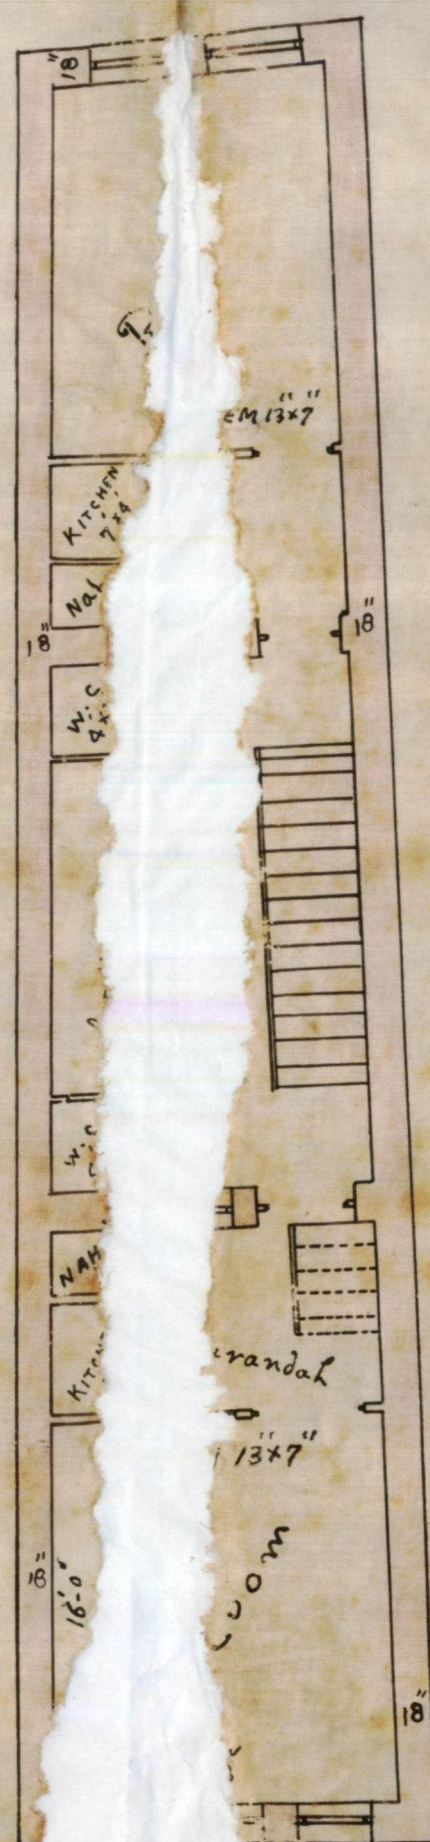

7DR PLAN

APPROVED

Executive Engineer,
Karachi Municipality.

APPROVED

Executive Engineer,
Karachi

- THE PLAN SHOWING THE SHOP TO BE REBUILT -

ON PLOT № 17 SHEET № C, 5.


MARKET QUARTER

scale 8-1

Telymen. M. ex. n. n.
i.e. Teyballi Abulhussein Mauniri

To A. K. Mandavala
Karachi city.

Nathaniel al an
architect. $\frac{1}{7}$ re

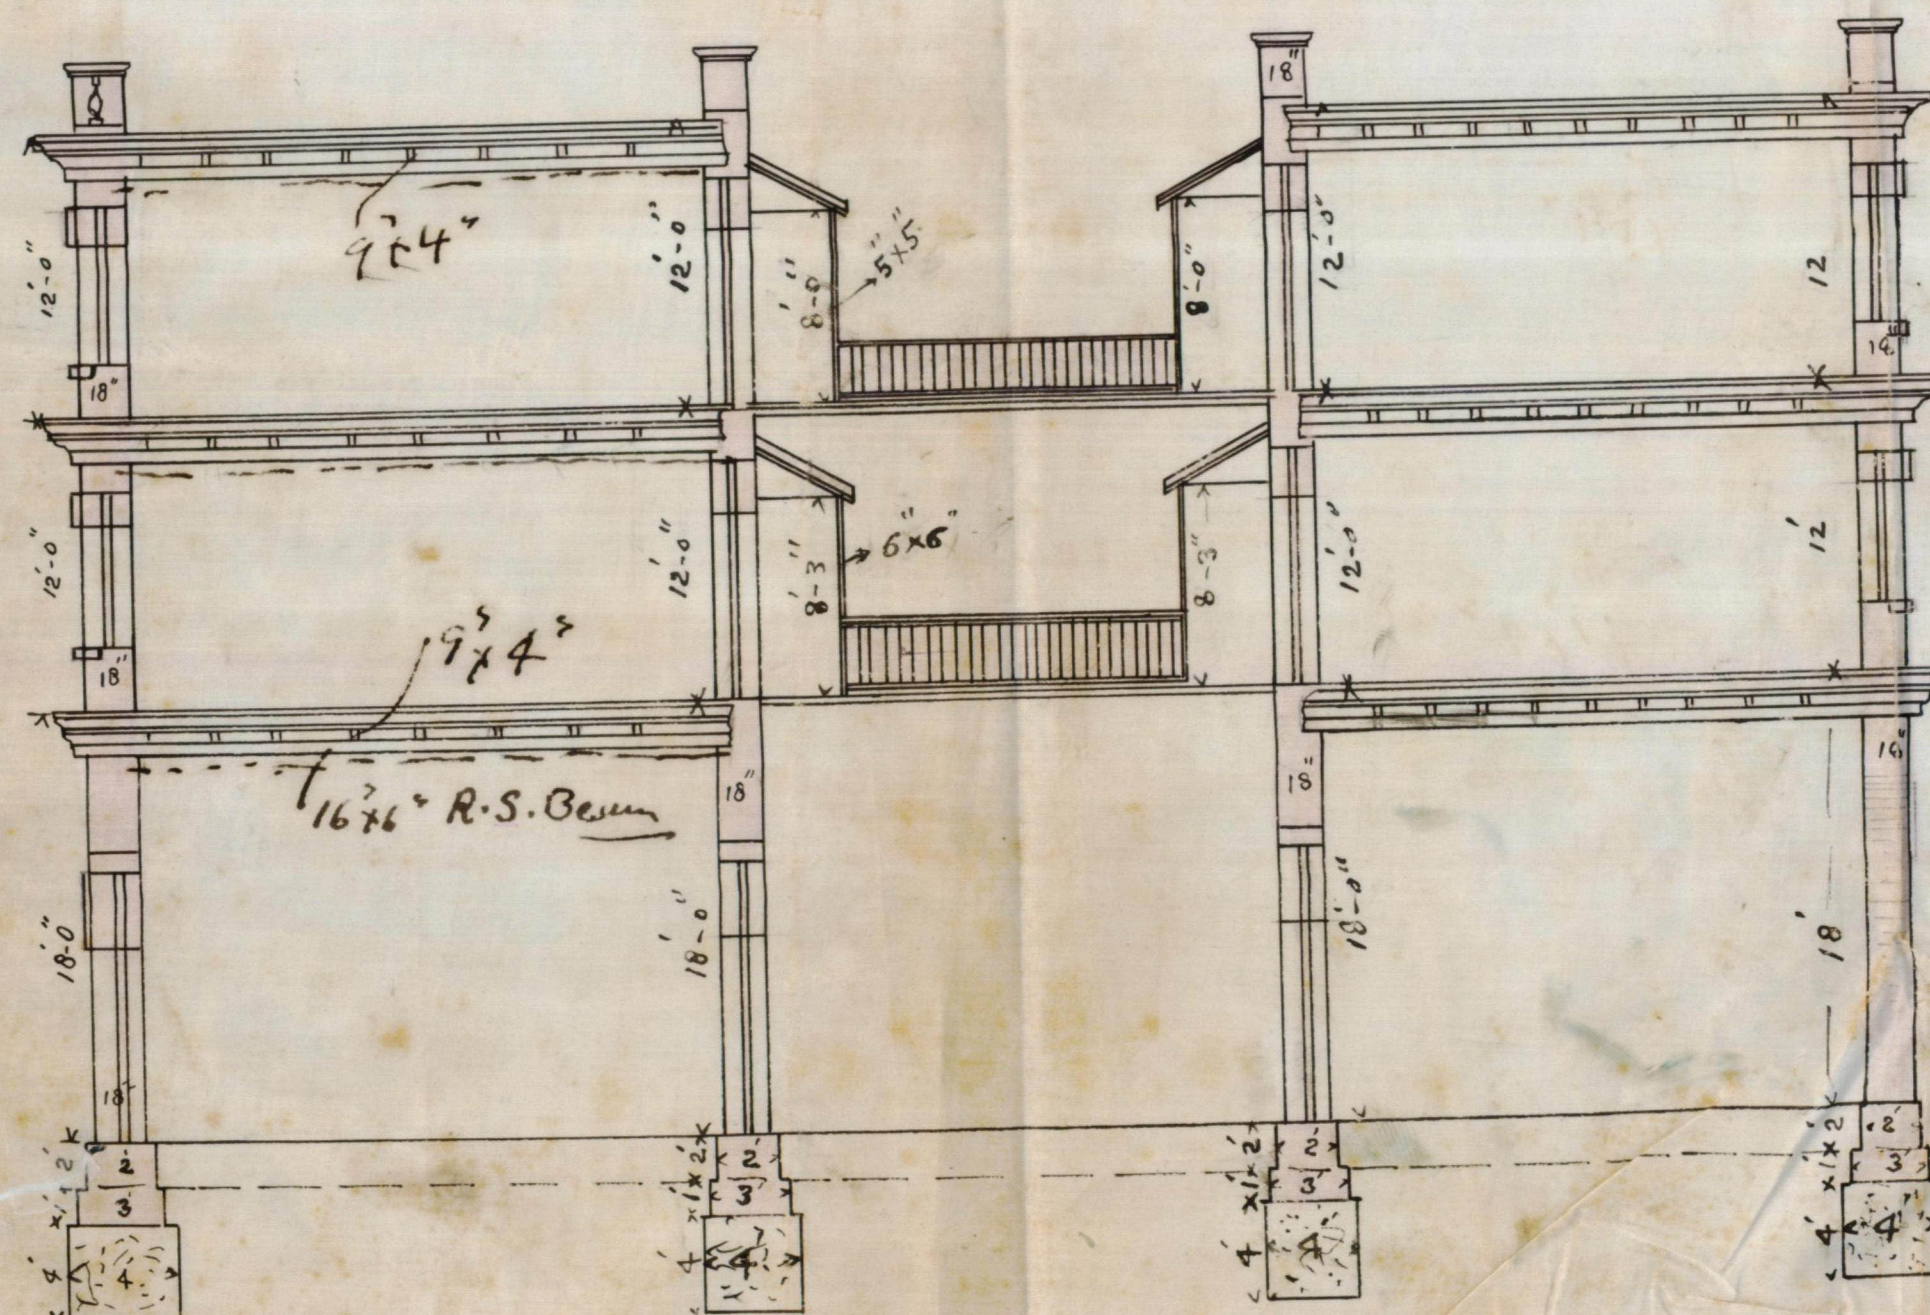

SECTION ON. A. B