



Heritage

KMR.CDD.MmQ.1916.03

111



Heritage

KMR.CDD.MmQ.1916.03

1-2

M. INST. C. E., M.I.M.E.,

Chief Officer,

Karachi Municipality.

(200-4-4-16.)

Form No. 2.

ORDERS UNDER SECTION 96 (2) OF ACT, III OF 1901

No. E/

5257 OF 1916

MUNICIPAL ENGINEER'S OFFICE,

Karachi, 3rd July 1916

MEMO :

With reference to his application, dated 2nd May 1916.
 Messrs Nance & Kanyo sons of Kaji is informed
 that the plan submitted by him for building rooms on 3rd floor
 of building on plot No. 85, Survey Sheet C1,
 situate in Kasim Street, Machi Meani
 Quarter, is approved, and permission to build in accordance therewith is
 Granted. The building to be erected subject to the Bye-laws and Rules of the
 Municipality.

J. A. I. Verley
 A. M. INST. C. E.,

Engineer,

Karachi Municipality.

NOTICE 1.—This pass does not give permission to occupy Municipal land with building materials. This can only be allowed when the street is wide enough to permit building materials being deposited on it without it being a source of danger to the public, and only then on a hoarding being placed round the land to be occupied, and on payment in advance of fees for occupation of Municipal land, at the following rates :—

					Rs.	A.	P.
(1)	For the first three months, per square yard, per diem	...	...	...	0	0	$\frac{1}{2}$
(2)	For the next three months	"	"	"	0	0	1
(3)	For any subsequent time	"	"	"	0	0	2

NOTICE 2.—Windows, steps and doors of the building will not be permitted to project on or overhang any public street or Municipal Land.

NOTICE 3.—Plinths will not be allowed to Project more than 2" on any public street for ornamental purposes.

5258 Copy to the Building Inspector
 5259 Inspector the K.O.
 5260 Repdt of Machinery

NO: 1906 of 1916.

Revenue Department.

Collector's Office.

Karachi 22nd June 1916.

Letter NO: 1671 dated the 15th June 1916 from the

City Deputy Collector -----
Application by occupants of
Survey NO: 85 (Sheet C-1) Machi-- Karachi on the subject noted on
Miani Quarter to build a third -- the margin.
floor over the existing buildings.

Reply of the Collector of Karachi.



SANCTIONED.

S/- Sd/- A.S.A. Westropp.
Collector of Karachi.

To,

The City Deputy Collector, Karachi (with the plan).

*Land Surveyor
attach &c.
report*
AM

NO: 1783 of 1916.

Revenue Department.

City Deputy Collector's Office.

Karachi, 24th June 1916.

Copy forwarded for information to the Engineer Karachi --
Municipality with reference to his endorsement NO: E/ 4536 dated, ---
8th June 1916.

Freemanning

City Deputy Collector,
Karachi.

Sir,

With reference to this

I beg to report that there
is no objection to grant
pass to Comdr.

Yours truly

Nathal

30/6/16

3553

4

No. E. 4526 of 1916,
Municipal Office,
Karachi 7th June 1916.

8th

M R M/O:-

With reference to his application dated 30th May 1916 with amended plans to build rooms on 3rd floor of -- building on plot No: 35, C-1 Machi Meani quarter, Messrs Kanoo & Hanji sons of Haji are requested to apply for permission to the City Deputy Collector with two copies of plan sent herewith duly signed and approved.

They must not start any building operation until they hear further from this Office.

J. Cecil L. Parley

A.M.Inst.C.E.

E n g i n e e r,
Karachi Municipality.

M
in

No. E. 4536 of 1916,
Municipal Office,

Karachi 7th June 1916.

8th

Copy forwarded to the City Deputy Collector for information with reference to his No: 536 dated 27th February 1914.

J. Cecil L. Parley

A.M.Inst.C.E.

B

Engineer
KRL

30/5/16

Lund

30th

May 1916.

Chief Officer Chief Engineer

Karachi Municipality

Sir,

With reference to your No E. 4117 of $\frac{22}{23}$ rd
May 1916. I beg to resubmit the plans
for building 3rd floor to house on plot No 85
Sheet C. 1, Muchi Meance Quarter duly
amended as shown personally.

I beg to remain,

Sir

your most obedient servant,

21/5/16
21/5/16

Sir,

With reference
to this they report that
there seems now no
objection to grant pass.
as the person has been
amended accordingly.

Yours obed

Nathl

6/6

2927

Grant permission

6/6

Engg's office

Nathl

5/6

No. E. 4117 of 1916,

Municipal Office,

Karachi 22nd May 1916.

Memo:

With reference to their application dated 2nd current with plans for building 3rd floor on Plot No: 85-C-1 Machi Meahi Quarter Messrs Nanco & Kanji sons of Haji are informed that the plan as submitted cannot be approved.

If he will call at this Office a suggested alteration will be pointed out to him and if the plans are so amended they will receive further consideration.


M. Inst. C. E.

Chief Officer & Chief Engineer,

Karachi Municipality.

Returned 4 plans re plot no. 85-C-1 to her: ^{Nagerth} ~~Amended~~ for amendment:

M. Nagerth

24/5/16

17th May 1916

Memo

With ref: to their application of 2nd current with plans for Building 3rd floor a plot no 85 C-1 Mach Mean. On Mem. Nanoo + Kanyee S/o Itaji are informed that he has shown a room 20' x 15' To the West which should be equal made 15' x 15' so as to be in the same line with the one to the East as shown in red pencil on the plan herewith returned for amendment accordingly.






27/5/16

M. Inst. C. E.
Chief Officer & Chief E.
Karachi Municipality

PLAN SHOWING PROPOSED ROOMS ON 3RD FLOOR ON HOUSE
ON PLOT NO 85 SHEET C.1 MUCHEE MEANEE QR
SCALE: 8FT=1"

NOTE PROPOSED WORK SHOWN IN RED





APPROVED.
A. G. H. Verby
Karachi Municipal
MAY - 1916
KURRAOHEE

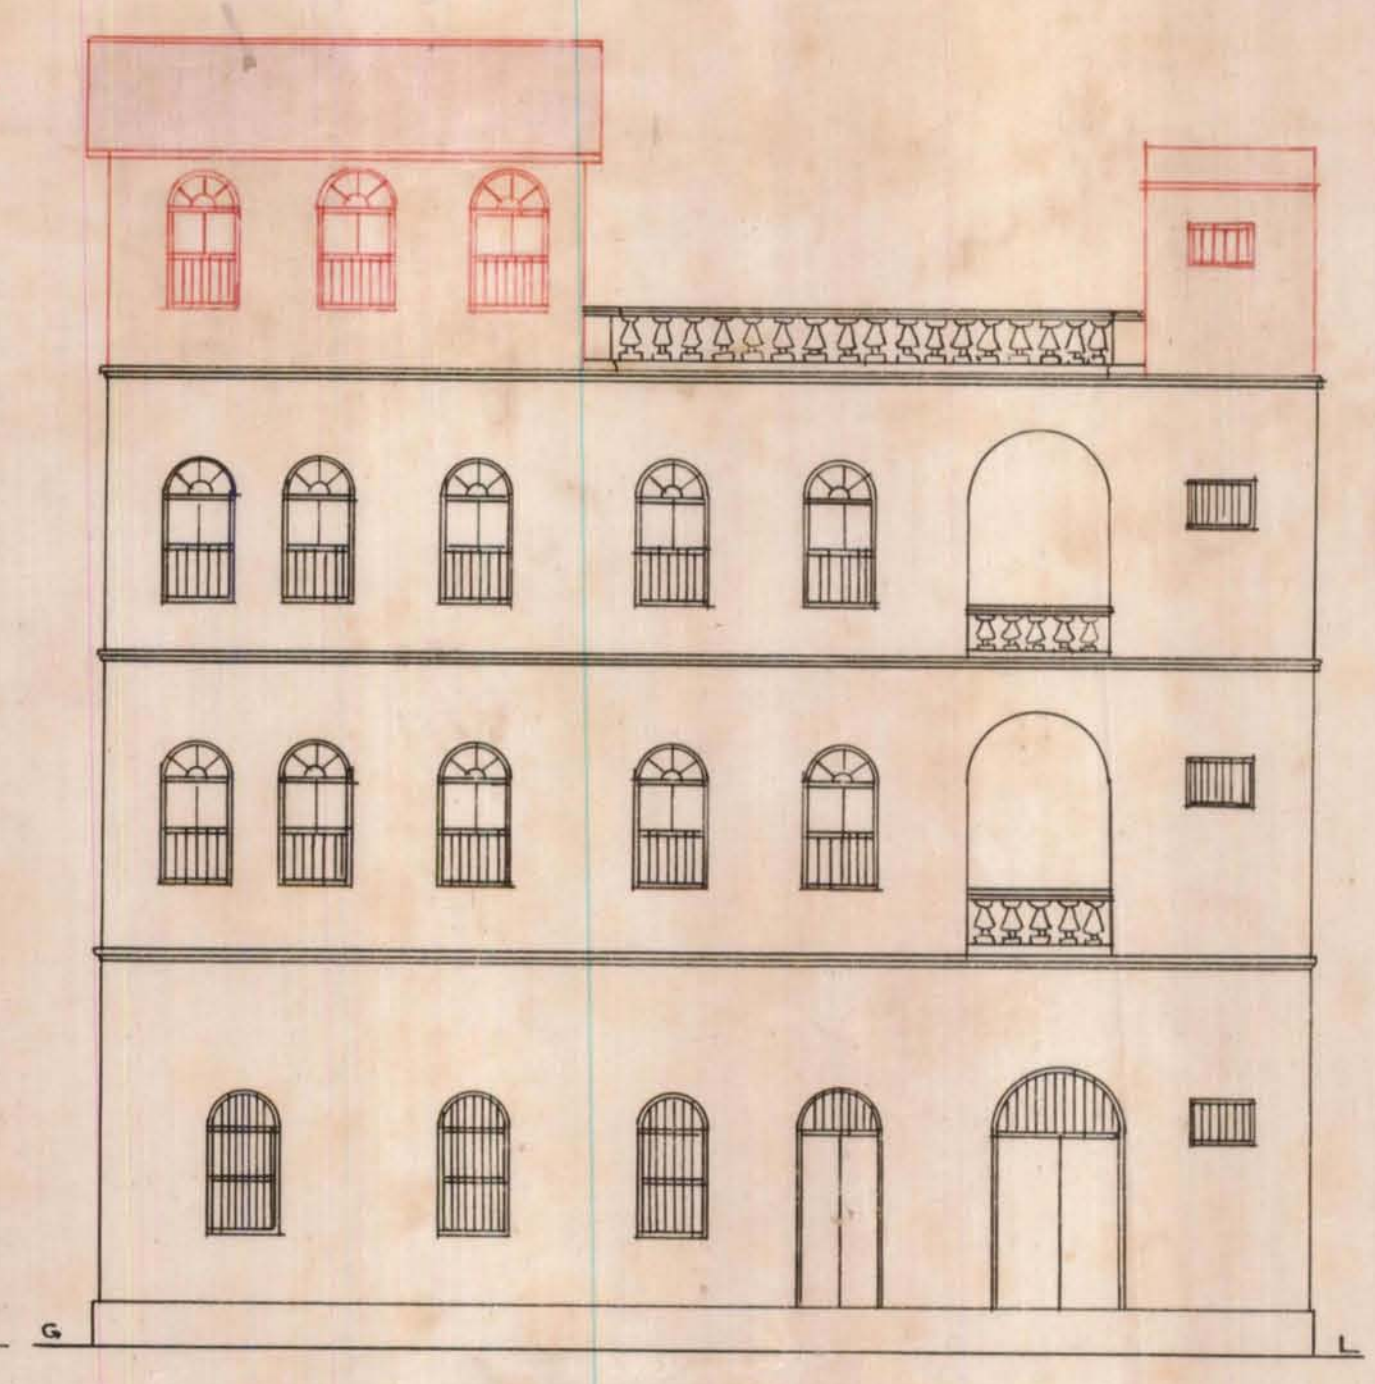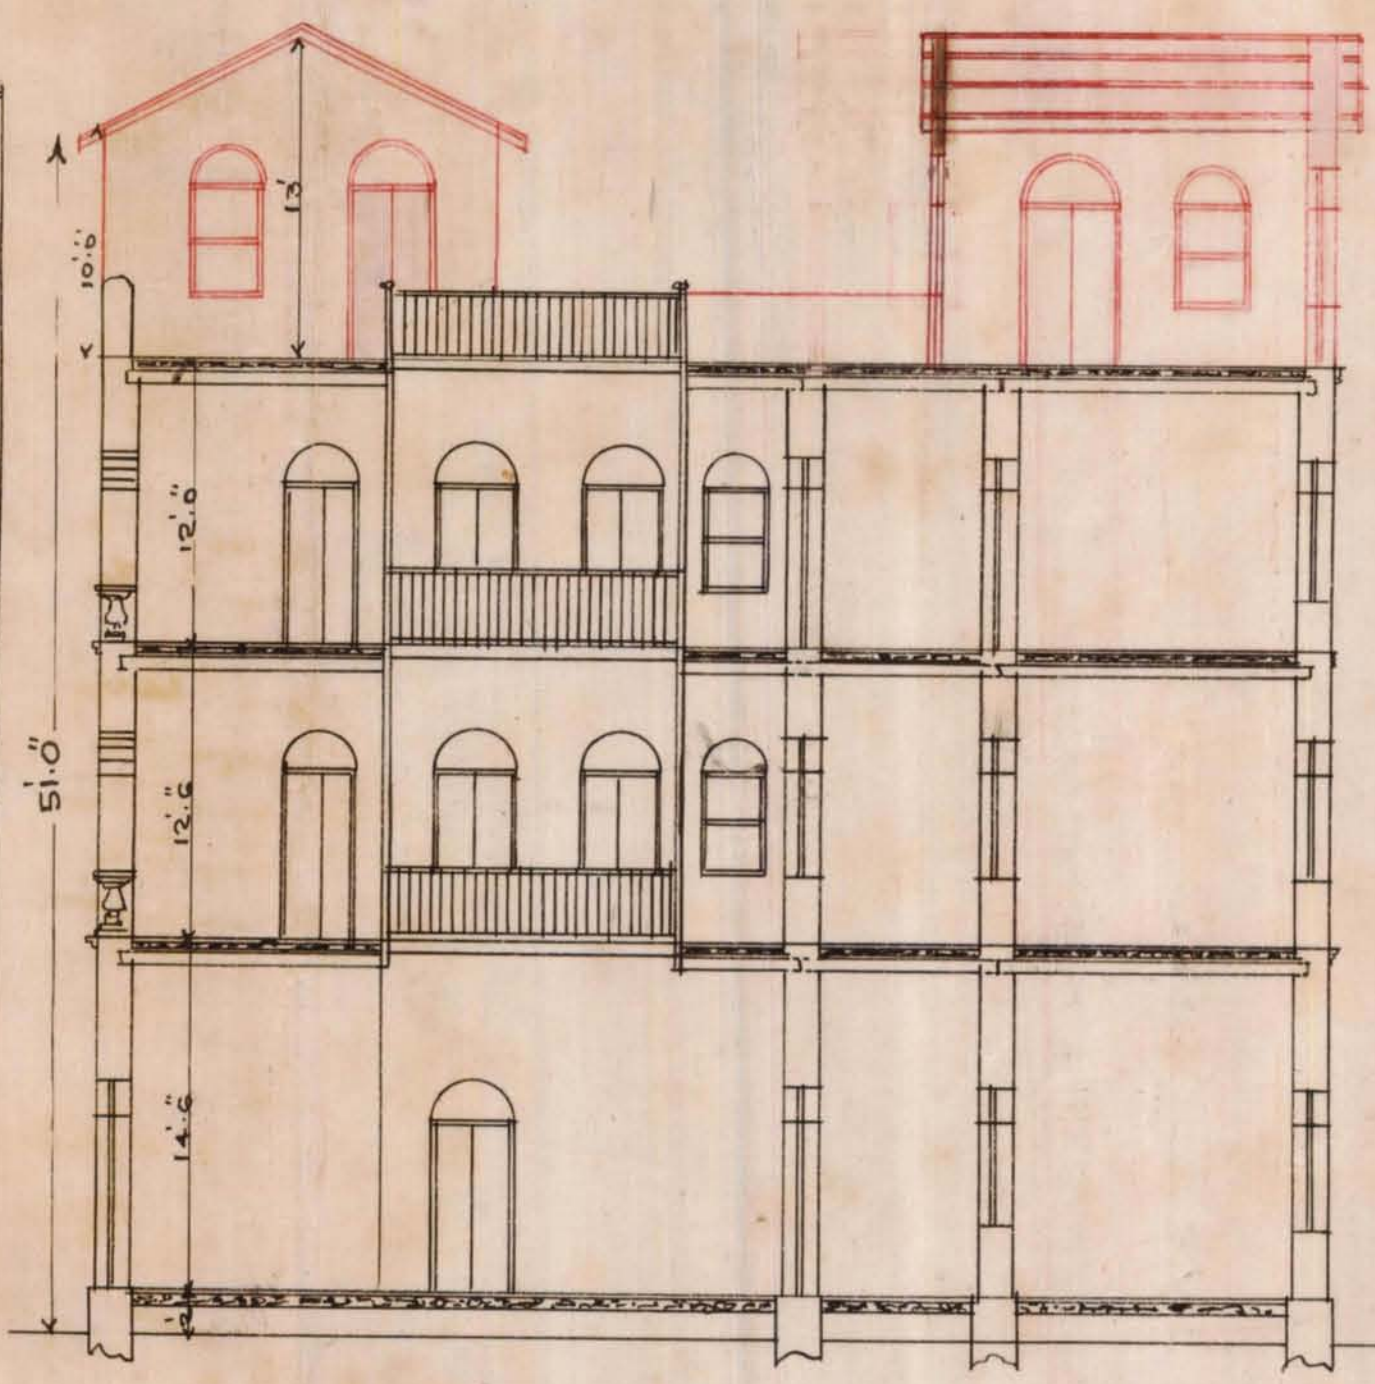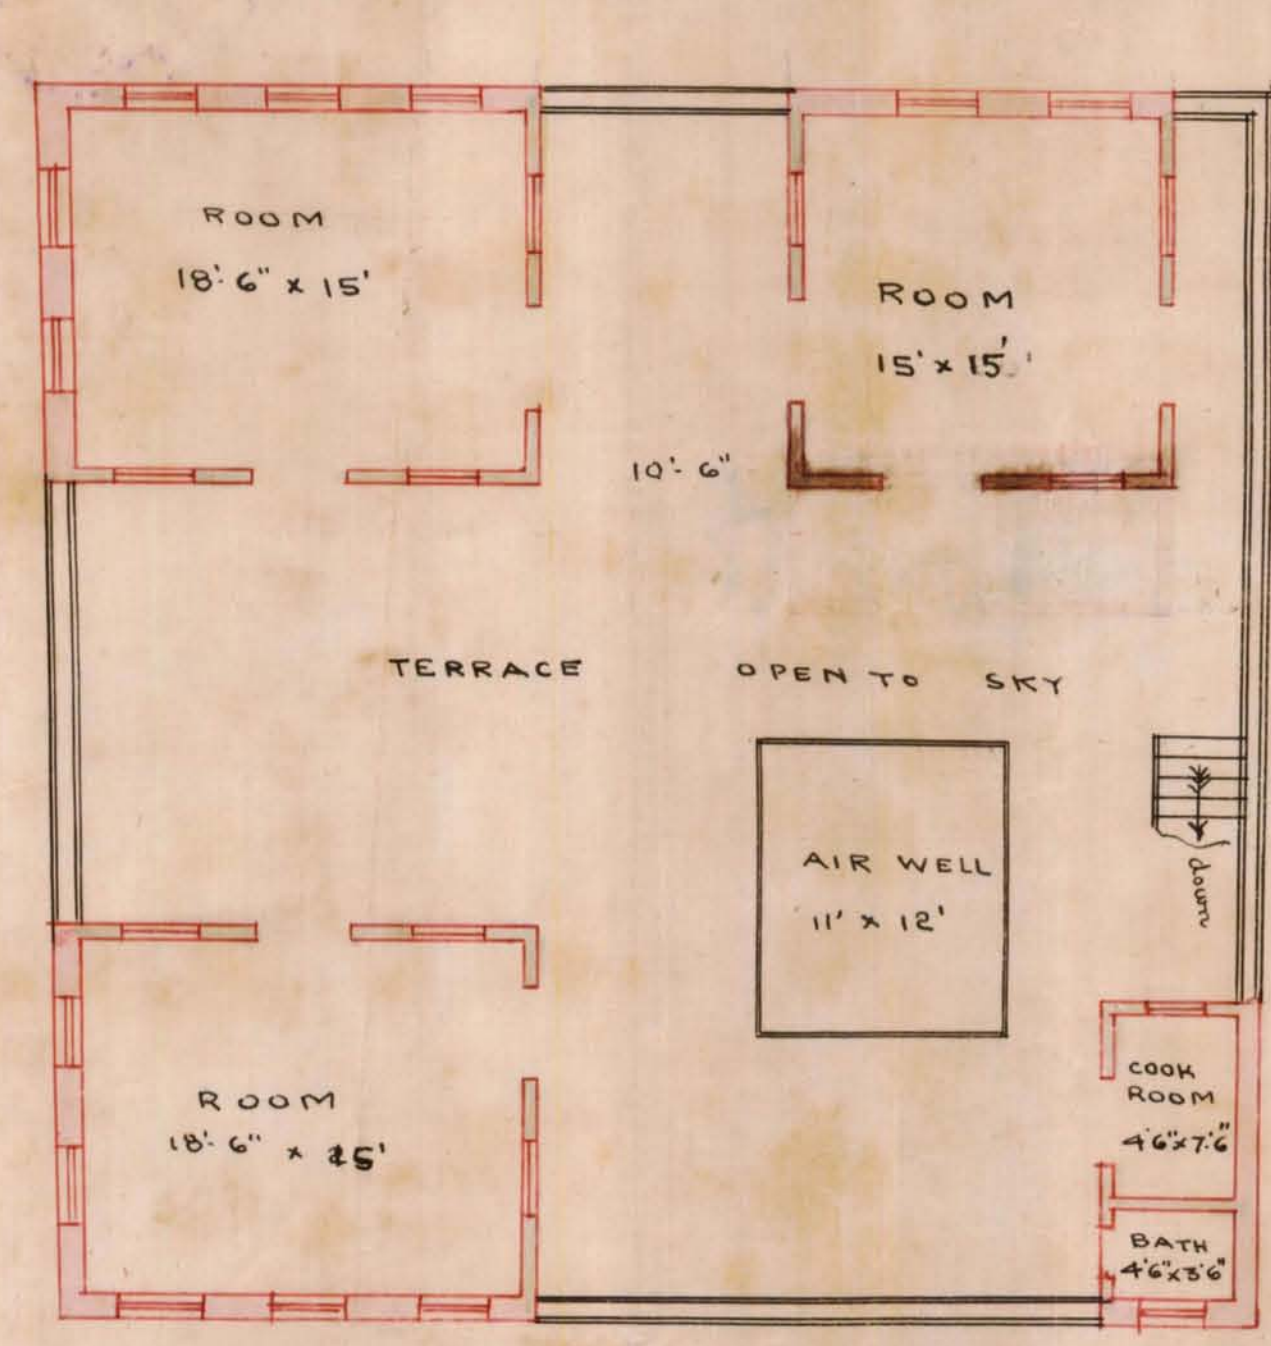

PLAN OF 3RD FLOOR
(PROPOSED)

SECTION ON A.B.

NORTH ELEVATION

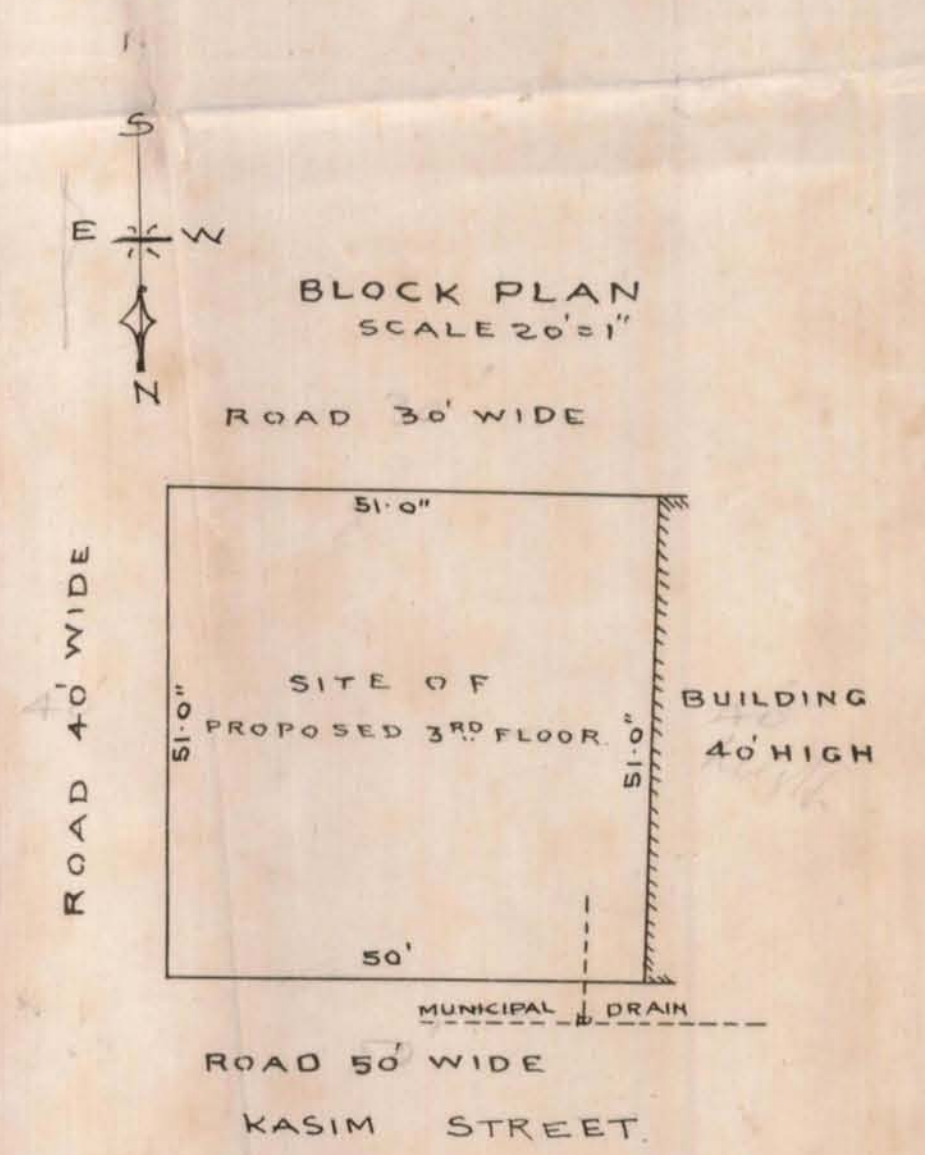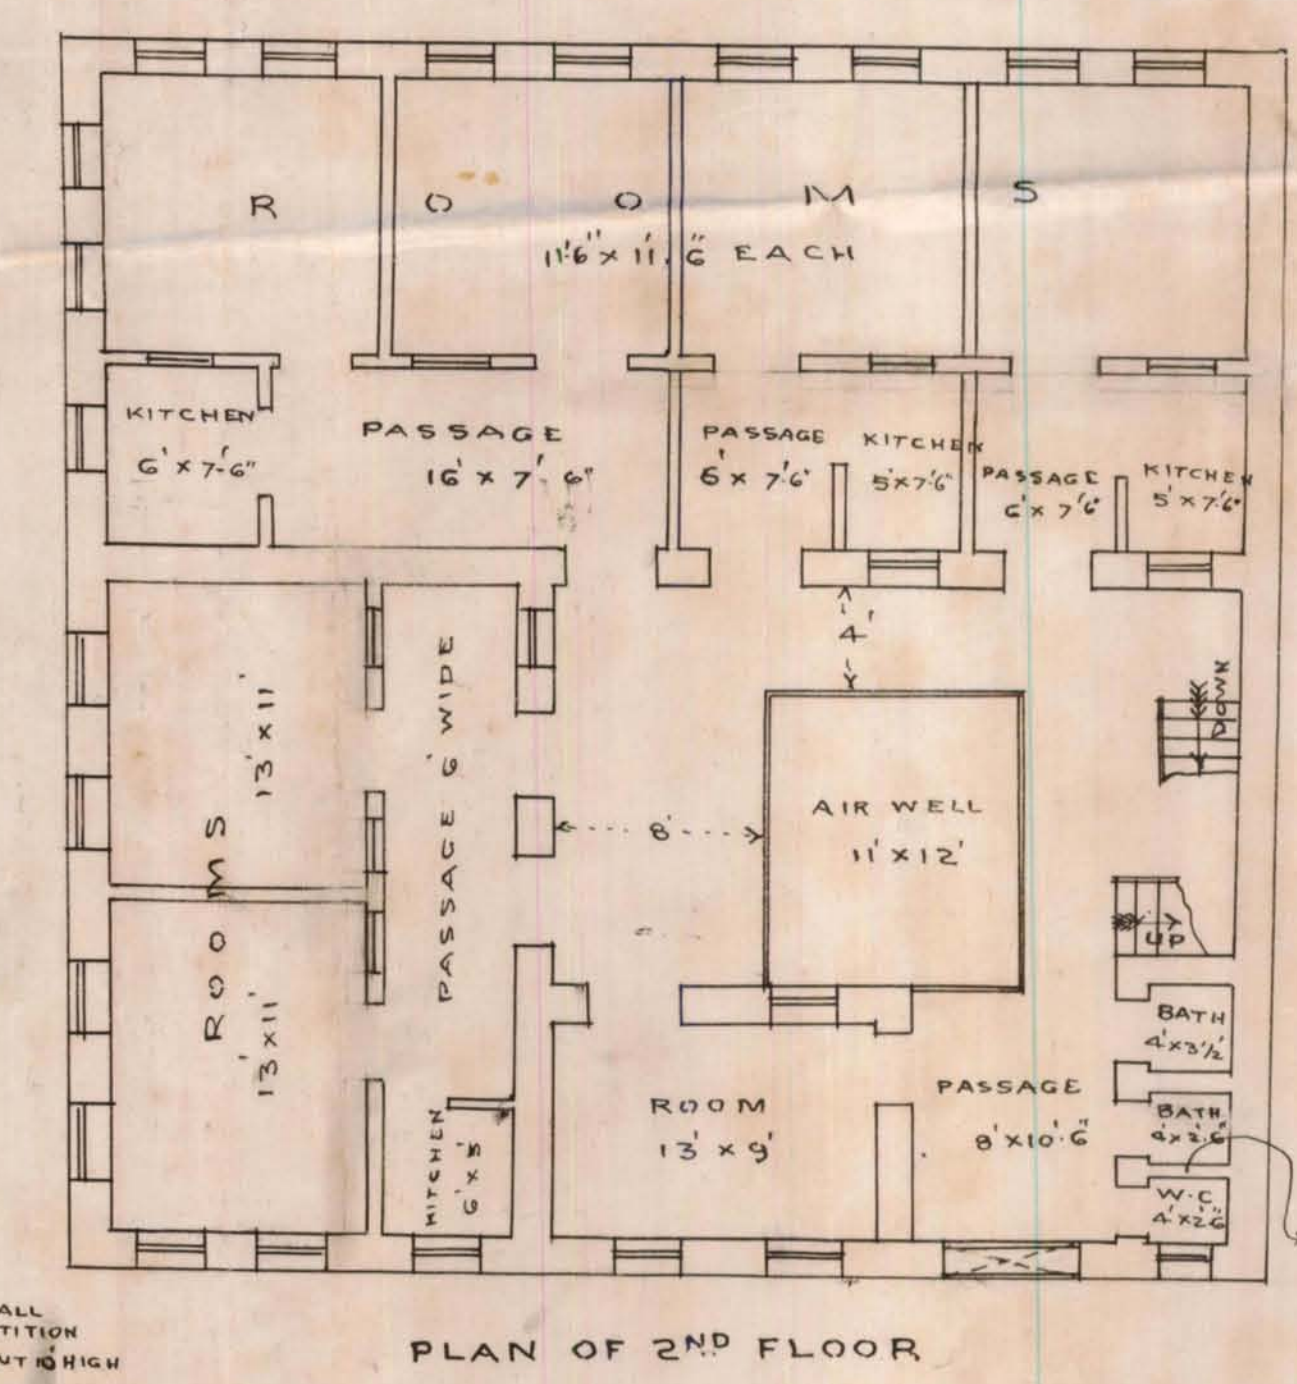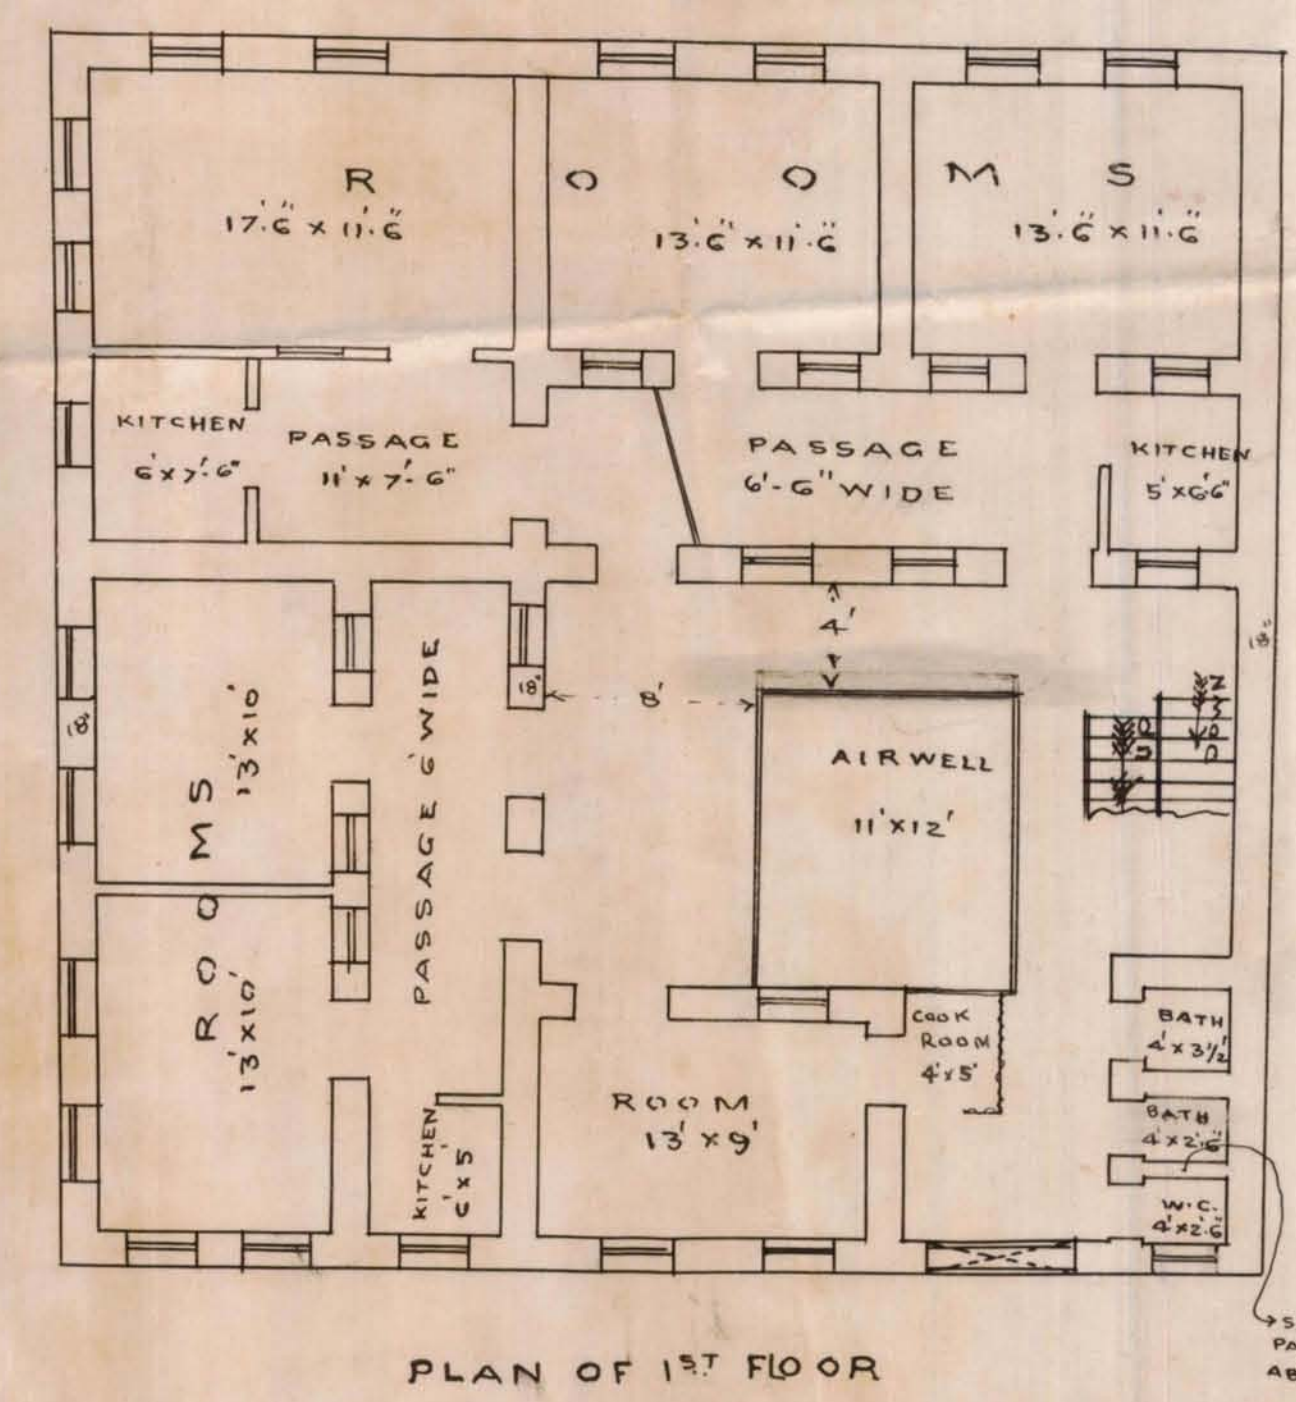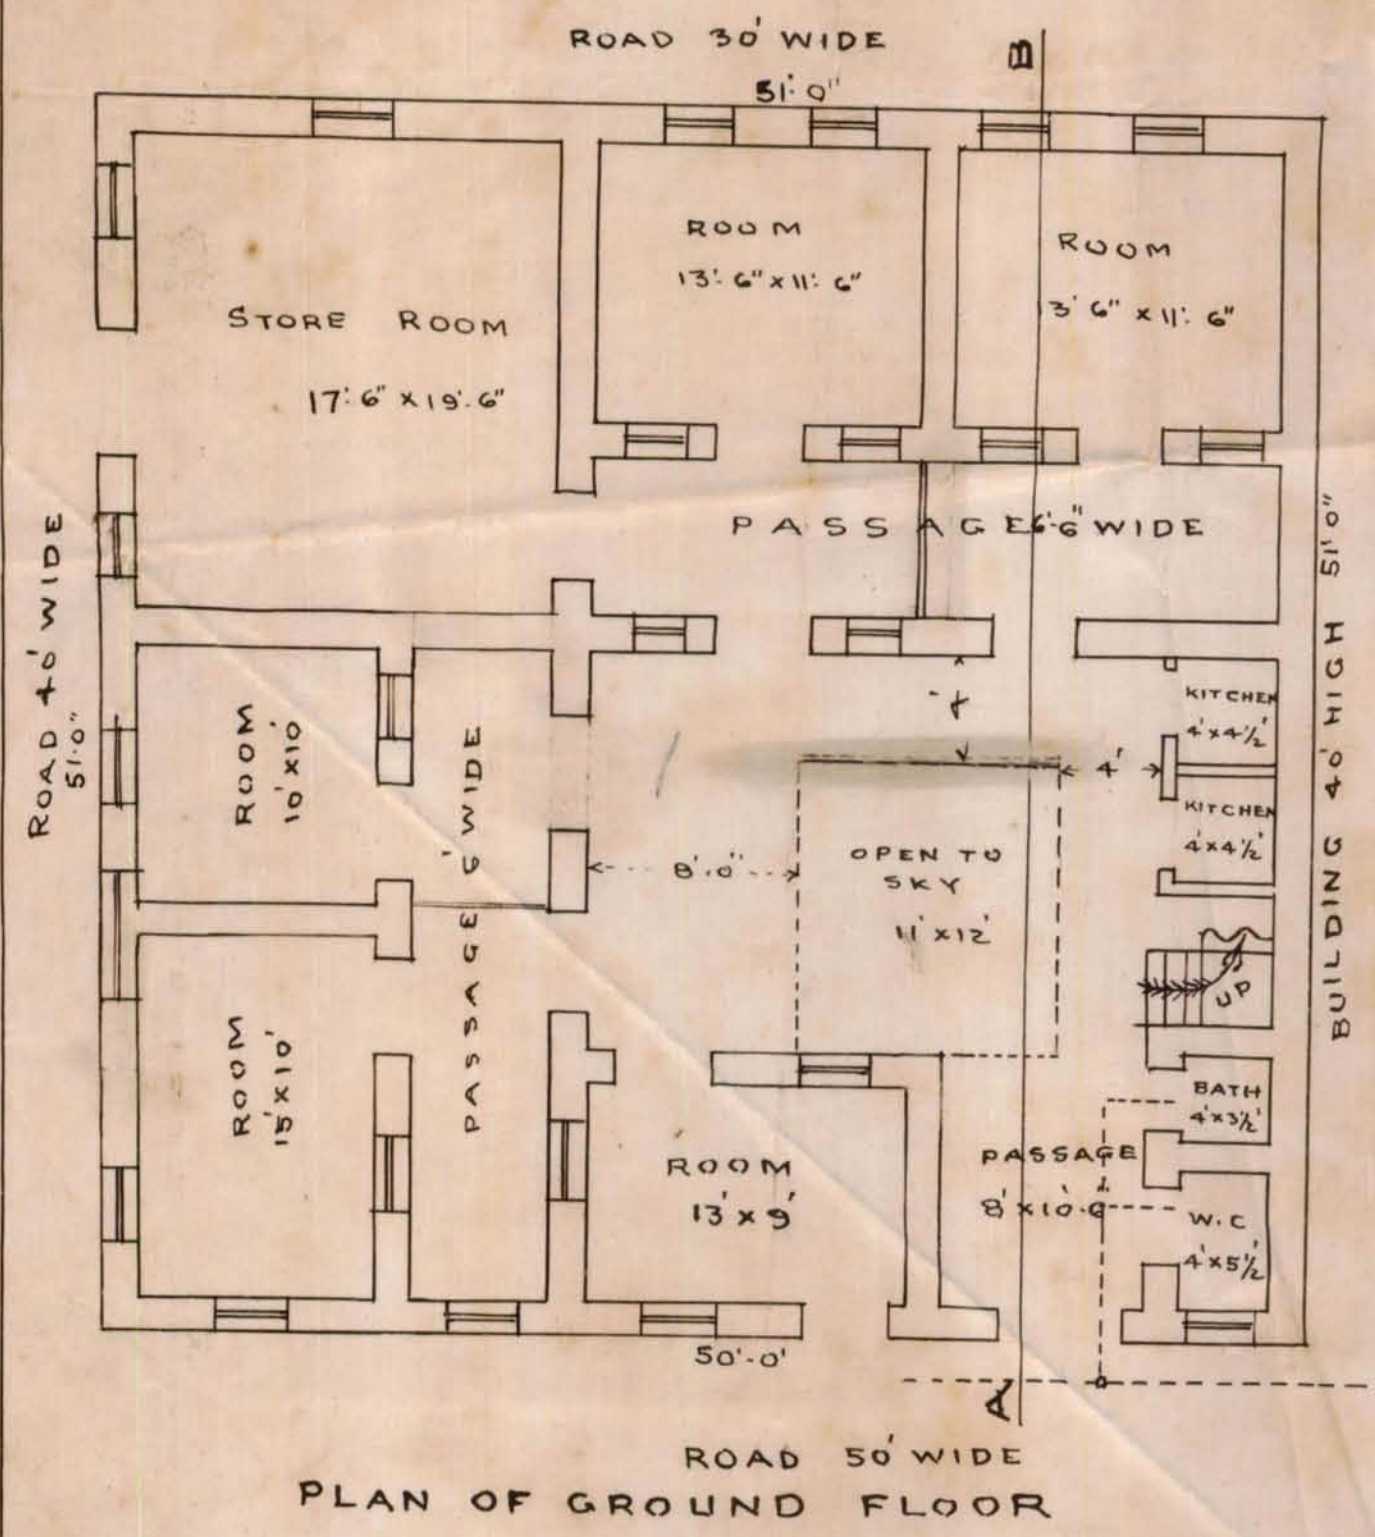

PLAN OF 1ST FLOOR

PLAN OF 2ND FLOOR

M. Nazaretti
2nd May 16
ARCHITECT & ENGINEER
OPPOSITE PARS Theatre

100-5-4-16

Form No. 1.

Karachi, 2nd May 1916.

NOTICE UNDER SECTION 96 OF ACT III OF 1901.

To

THE CHIEF OFFICER & CHIEF ENGINEER,

KARACHI MUNICIPALITY.

SIR,

I beg to inform you that I intend building rooms on 3rd
floor of building on plot No. 85
Survey Sheet No. C 1 situate in Kasim
Street, Muchee Meene Quarter.

As required by the rules of the Municipality, I beg to submit herewith a plan of the same for your approval.

I beg to remain,
Sir,

Your most obedient servant,

Signature of the applicant
Signature of the applicant.



No. G. 5793 of 1916 .
MUNICIPAL CHIEF OFFICER AND

CHIEF ENGINEER'S OFFICE,

Karachi, 4th May 1916.

Forwarded to the Municipal Engineer for favour of disposal.

Benjamin
show
5/16

Signature
M. INST. C. E.
Chief Officer and Chief Engineer,
Karachi Municipality.

2524



No. E. 36²⁵ of 1916.

MUNICIPAL ENGINEER'S OFFICE.

Karachi, 5th May 1917

MEMO.

The above application is forwarded to the Municipal Health Officer for favour of report.

S. A. M. I. C. E.
A. M. I. C. E.,
In Engineer,

Karachi Municipality.

MUNICIPAL HEALTH OFFICER'S REPORT.

Returned to the Engineer, Karachi Municipality, with the following remarks:—

No objection

D. P. H. (London)
D. P. H. (London),

Health Officer,
Karachi Municipality.

Date 8-5-1916.

No. E. 36²⁵ of 1916.

MUNICIPAL ENGINEER'S OFFICE.

Date 8th May 1916.

Forwarded to the Building Surveyor for report

S. A. M. I. C. E.
A. M. I. C. E.,

In Engineer,
Karachi Municipality.

Through

THE LAND SURVEYOR,

Karachi Municipality.



9-3

3

BUILDING SURVEYOR'S REPORT.

Applicant's name

Nanov + Kamji Sons & Haj.

Whether he is the owner of the plot on which it is proposed to build

Is

The work proposed

Build additional upper story

Building Surveyor's report

Sir,

With ref. to this I beg to report that there

being no objection to approve the plans of the

with the C.D.'s consent. On the east side where the road is shown

40 ft wide on the plan where as the same is only 30 ft in the S. Street. Respect

Yr. obediently

M. B. N. N.

Date 9/5 1916.

Building Surveyor.

Submitted through the Land Surveyor

LAND SURVEYOR'S REPORT.

Does the plot come under Alignment

No

Area of plot

Area under Alignment

Remarks

Sir, With reference to this I beg to

report that there is no objection to the additional story to be built, but there is already too much on the plot. Request your order

Yours obediently

N. Adil

Land Surveyor.

Date 11-5 1916.

ORDERS OF THE ENGINEER.

L. Surveyor
Shah Survey
Street.Shah Survey
13/5/16

I grant permission

J. Cecil L. Varley

A. M. I. C. E.,

Engineer,

Karachi Municipality.

No. E. 5261 of 1916.

MUNICIPAL ENGINEER'S OFFICE.

Karachi. 24th / 1916

Submitted to the Managing Committee with a recommendation that the plan be approved.

Forwarded

Measham Lea
M. Inst. C. E.

Chief Officer & Chief Engineer,
Karachi Municipality.

Frederic L. Verby
A. M. I. C.

A. M. I. C. E.,

Engineer,

Karachi Municipality.

Through

The CHIEF OFFICER & CHIEF ENGINEER.

KARACHI MUNICIPALITY.

RESOLUTION OF THE MANAGING COMMITTEE.

Resolution No. _____ dated _____

[Faint, illegible handwriting on lined paper]