



KARACHI MUNICIPAL CORPORATION

BUILDING SECTION.

REVIEW FORM.

Case No. *PC B8C. 208400.*RE:—Plot No *266*, sheet no. *Gr. Sander Canal. Qr.*
(na 456)A copy of plan is forwarded with compliments to the Health Officer
for favour of remarks and to pass on directly to the Engineer for favour of
his remarks *It is attached to*

FOR LAND MANAGER ARCHITECT.

HEALTH OFFICER'S REMARKS.

*No objection*Date *27/12*for *Prof. W. S. Smith*
HEALTH OFFICER.

Forwarded with compliments to the Engineer for favour of disposal

FOR HEALTH OFFICER.

ENGINEER'S REMARKS.

No objection

Date _____

FOR ENGINEER.

Returned with Compliments to the Land Manager & Architect.

FOR ENGINEER.



Immediate

REVIEW FORM

Passed on 17/2/41
S.L.S. for clearance
H.L.

S. L. S.

As per

11/1/41

S. L. S.

The site plan tallies with
the approved plans of 16/3/39
No objection

Noted

11/1/41

16/1

(1) Appptl. be kept with B.S. to
inspect the site

11/1/41

B.S.'s objection

16/1

17/1



Office Telephone Nos. 2805, 2806
& 2807

F. M. I. KURESHI
B. Sc. Engineering (Edin.)
LAND MANAGER & ARCHITECT



MUNICIPAL CORPORATION,
KARACHI.

1000-10 40

Reference No. B. S. B. 203/40.

7 JUL 1941 1941

To, Mr. Mulchand B. Tala, Architect for owner.

Dear Sir,

With reference to your application dated 17th December 1940
with a plan for the proposed buildings/additions and alterations on plot
No 266 Survey Sheet No. G.W. Garden Quarter.
I have to request you to comply with the following requirements—

B.S.'s objections.

- (1) Appointment be kept with the Building Surveyor
to inspect the site.

The plans are returned herewith rejected.

Yours faithfully,

[Signature]
for Land Manager & Architect



FINAL
PLAN SHOWING


PROPOSED ADD: & ALTERATION

ON PLOT NO 266 G.W. (NEW NO 456)


GARDEN WEST

SCALE = 8" = 1'


GROUND FLOOR

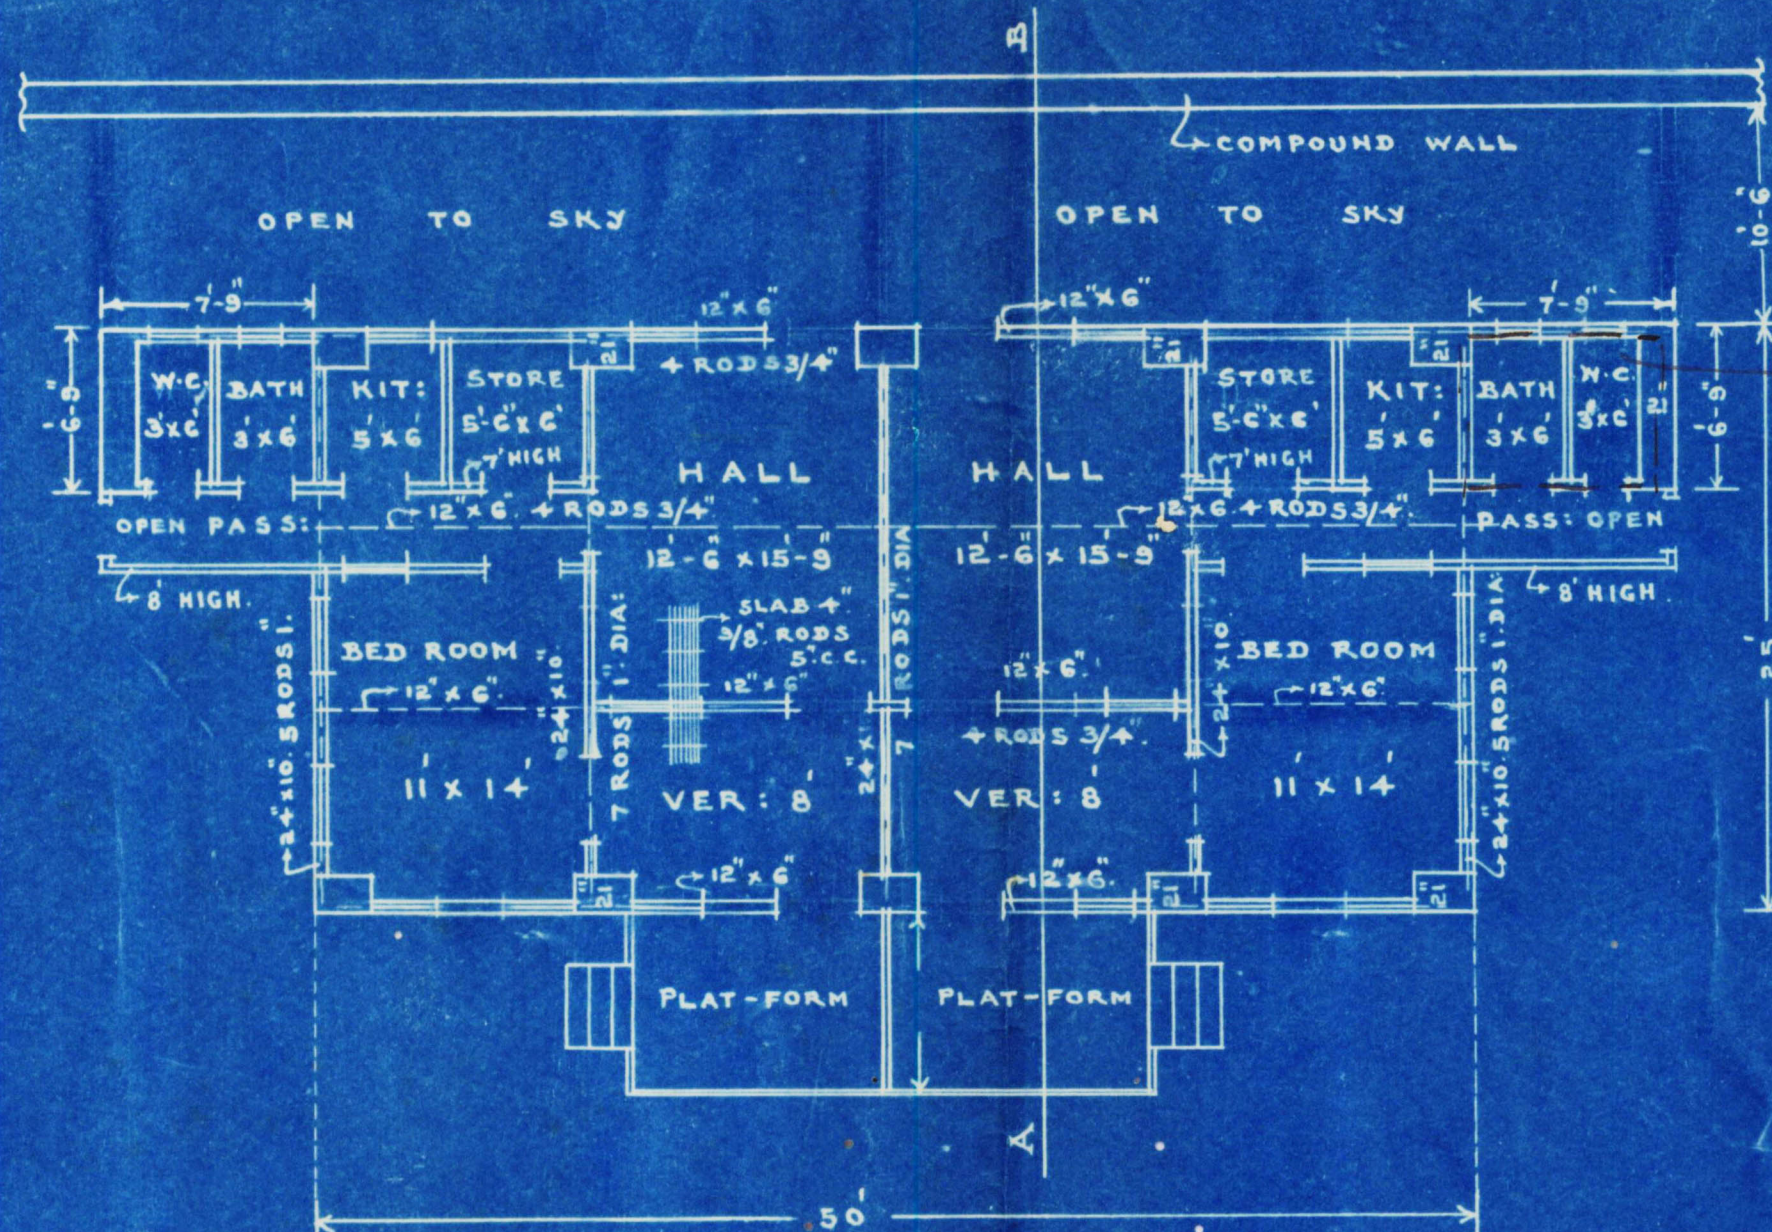

FRONT ELEVATION

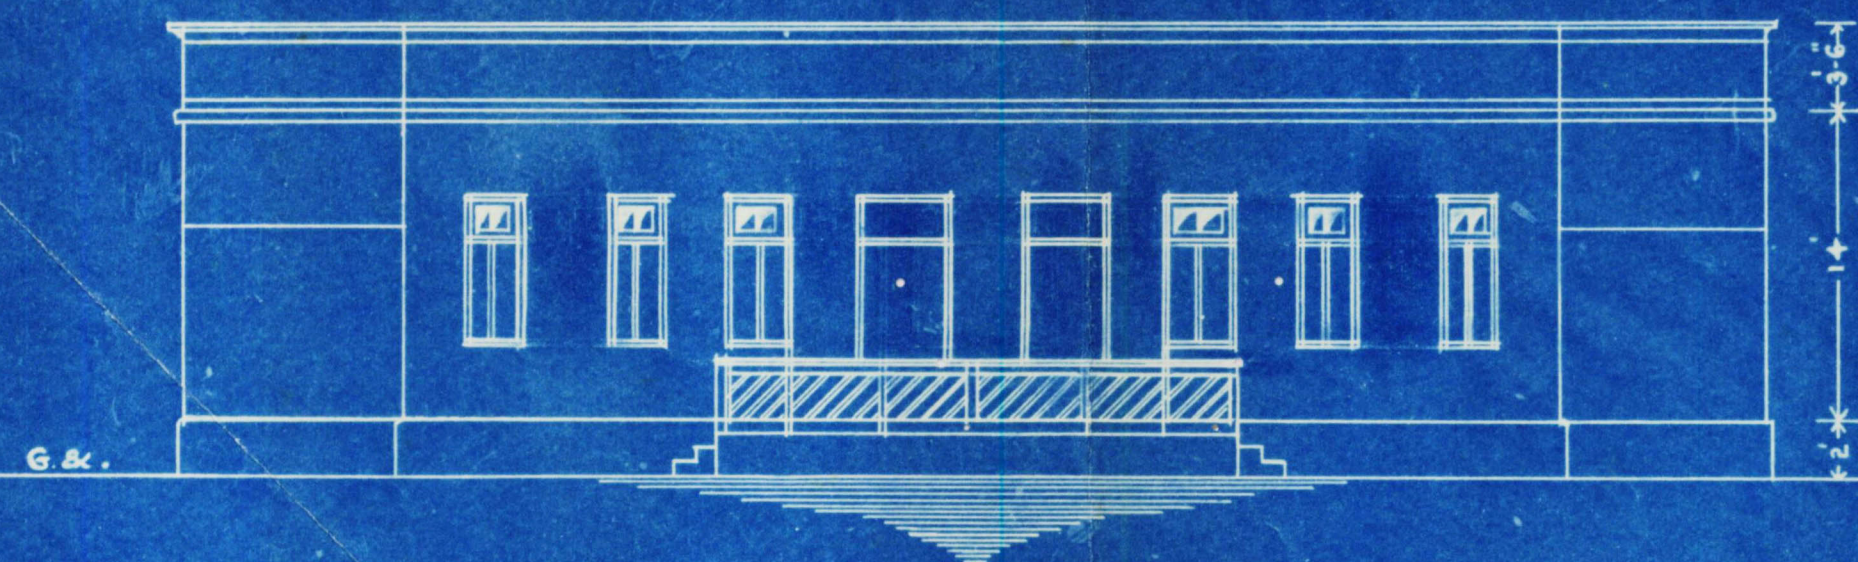

SECTION ON A.B.

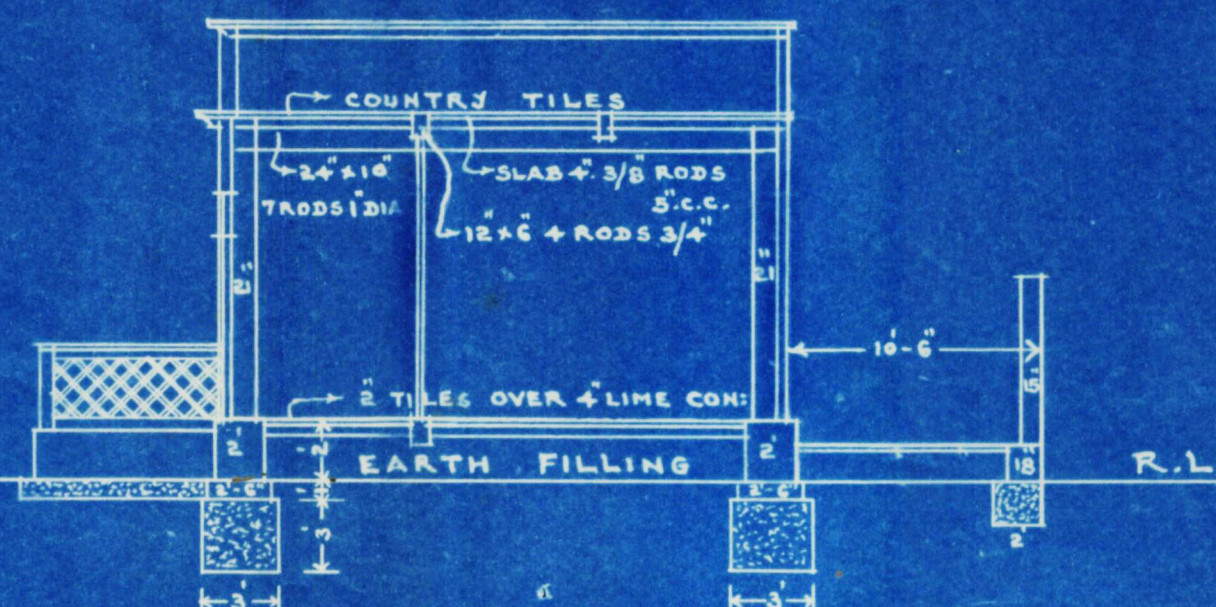

TOTAL AREA OF PLOT = 1878.0 SQ.YDS
COVERED AREA OF PLOT = 150.5 " "
OPEN AREA OF PLOT = 1727.5 " "

686


DT/ 29-10-38

DETAIL OF COVERED AREA

B = 1 x 50.0 x 25.0 = 1250.0 SQ.FTS
C = 2 x 7.75 x 6.75 = 104.62 " "
TOTAL = 1354.62 " "
= 150.5 SQ.YDS

SITE PLAN

SCALE = 20" = 1'

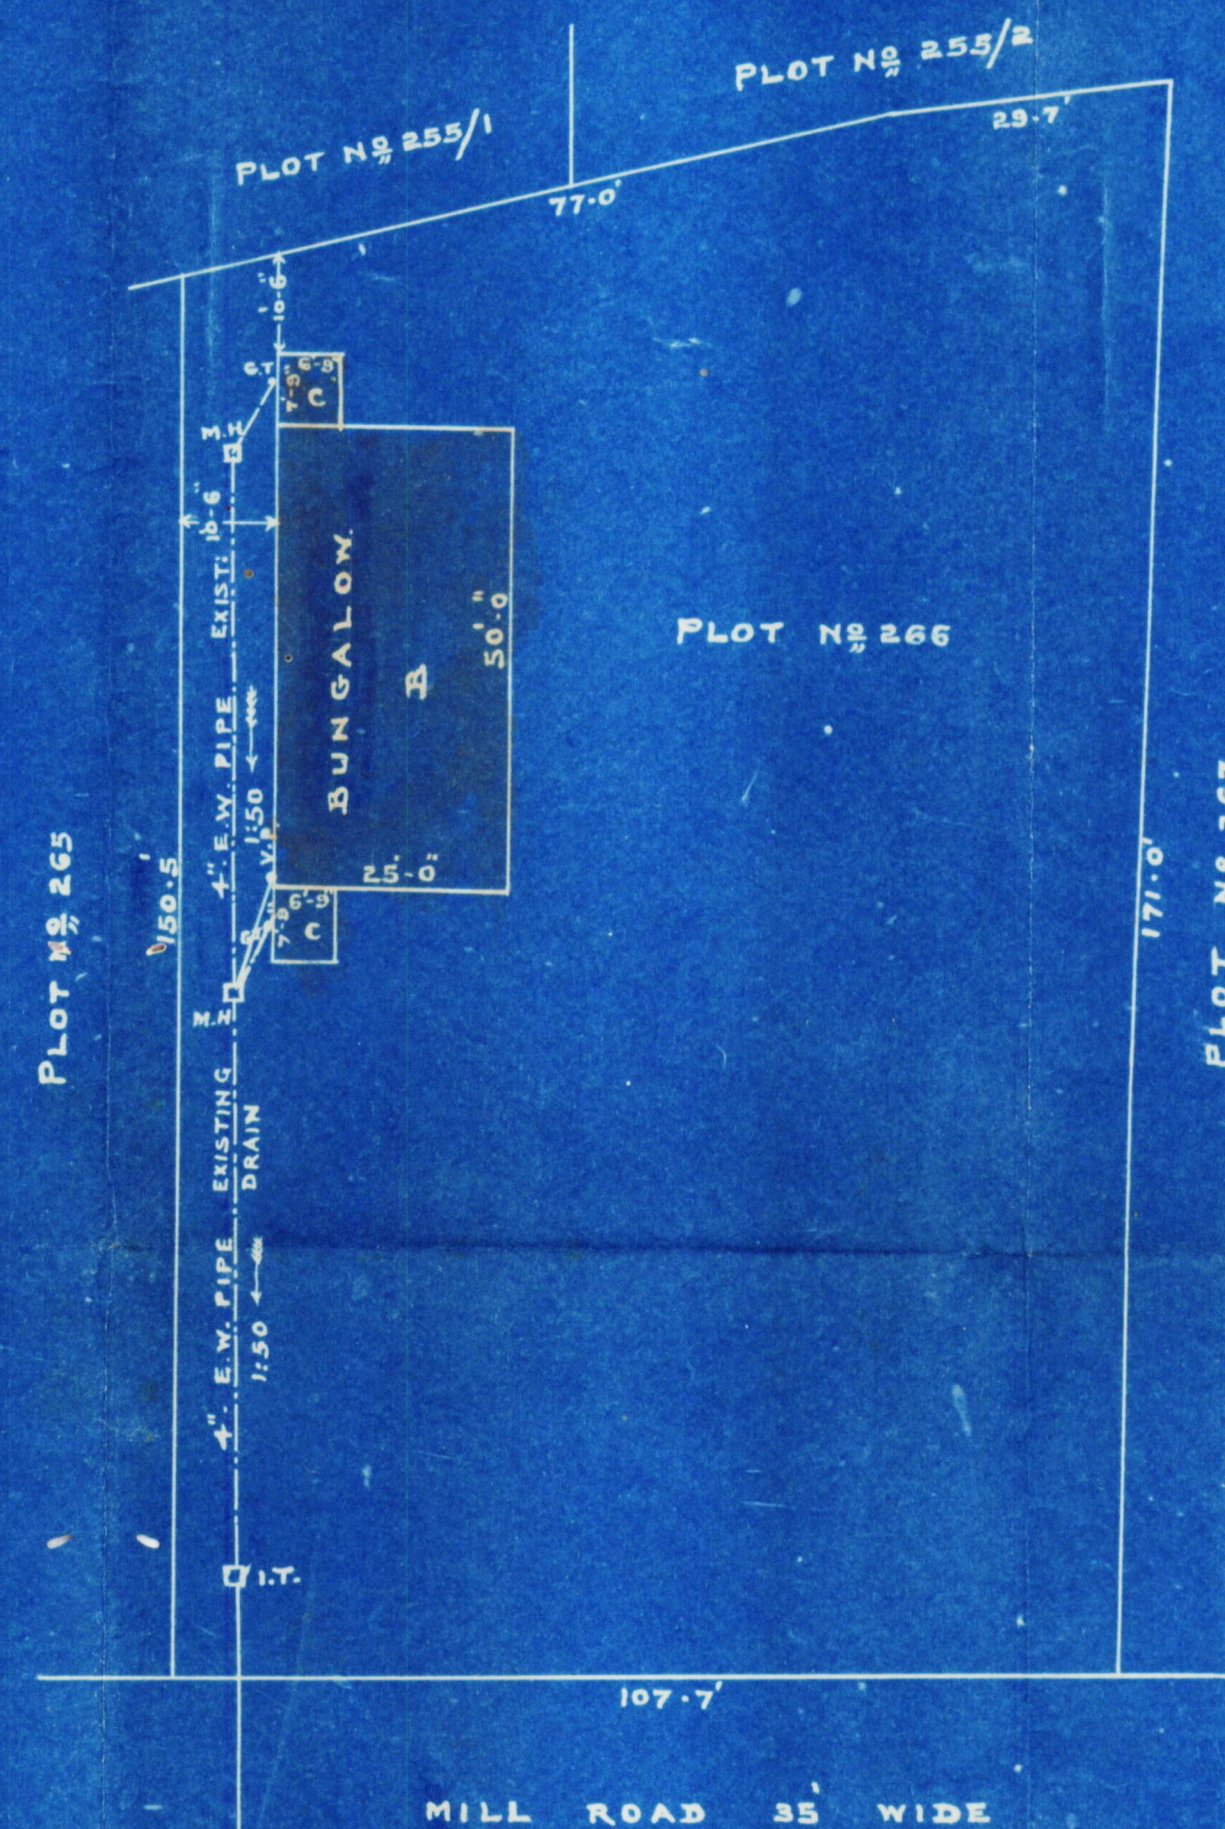

Mangabhai Harbanshall

Proprietor

OWNER

Sub Chandra

M. K. M. & Co.

ARCHITECTS