

ORDER UNDER SECTION 96 (2) OF ACT, III OF 1901.

No. L. S. 5331 OF 1922.

MUNICIPAL ENGINEER'S OFFICE.

Karachi, 21st July 1922.
3125-

MEMO.

With reference to ^{his}~~their~~ application, dated 23rd June 1922

Mr. Shewapram. Siromal is informed
Messrs. _____ are _____

that the plan submitted by ^{him}~~them~~ for building making additions
and alterations in his house

_____ on plot No. 230 A. Survey Sheet E-1
situate in Hari. Budhani Lane ~~Street~~ Jail.
~~Road~~

Quarter, is approved, and permission to build in accordance therewith is granted. The building must be erected, in accordance with the By-laws and Rules of the Municipality.

Mell

Engineer,
Karachi Municipality.

NOTICE 1.—This pass does not give permission to occupy Municipal land with building materials. This can only be allowed when the street is wide enough to permit building materials being deposited on it without it being a source of danger to the public, and only then on a hoarding being placed round the land to be occupied and on payment, in advance, of fees for occupation of Municipal land, at the following rates:—

				Rs.	A.	P.
(1)	For the first three months, per square yard per diem	...	0	0	1	2
(2)	For the next three months	"	0	0	1	2
(3)	For any subsequent time	"	0	0	2	2

NOTICE 2.—Windows, steps and doors of the building will not be permittel to project on or overhang any public street or Municipal land.

NOTICE 3.—Plinths will not be allowed to project more than 2 inches on any Public street for ornamental purposes.

Copy to the B.S. Section "B" for information & report.

Copy to the Suppt of Machinery for information & report.

Copy to the Inspector through for information & report



No. L. S. 4973 of 1922.

MUNICIPAL ENGINEER'S OFFICE,

Karachi, 30.6.1922

4.7.22.

MEMO ;

Undersigned has the honour to forward to the Chief Officer and Chief Engineer the accompanying plan for the proposed building on plot No. 230A Sheet E1. Jail Quarter submitted by Mr. Shewaram Divomal the registered occupant of the plot.

There being no objection from either a Municipal or Sanitary point of view, undersigned recommends permission to build may be accorded, with the sanction of the Managing Committee, under the *Land Sale Rules*, the plot being under the control of the Municipality.

M.C., A.M. I.M.E.,

Engineer,
Karachi Municipality.

note.

Sanctioned vide M.C.R. No. 724
dated 15th July, 1922

6/7/22



No. L. S. 4942 of 1922

Municipal Office,

KARACHI 30.6.1922

4.7.22.

MEMO:—

With reference to his application dated 3rd June 1922~~their~~with plans for the proposed add. & alterations to his house
on plot No. 230. A. Sheet, E1 Dail Quarter,
Nos.Mr. Shewasram Simmal is informed that the
Messrs. areplan, having been approved by the undersigned, has been forwarded to the
Chief Officer and Chief Engineer for the approval of the Managing
Committee, as the plot is under Municipal Control.He must not start any building operations until he hears further from
They they hear
this Office.M. H. Smith

M.E., A.M.I.E.,

Engineer,

Karachi Municipality.

P.S.



Heritage

KMR.CDD.JaQ.1922.01

4

NO: L. S. 4732 of 1922.

Municipal Office.

Karachi 20th JUNE 1922.

MEMO: -

Re: Plot No. 230A, Sheet E-1 Jail Quarter.

With reference to his application dated 3rd Instant Mr. Shewaram Sirumal is informed, the side measurements of the plot given on the plan are incorrect. The copies of plans are therefore returned herewith for amendment. Correct measurements can be obtained from this office on application.

Ls

Pm

Measurements Corrected
and returned. Yours
it is to your
remains now. POK

M.C., A. M. I. C. E.

ENGINEER.

24-6-22

P.L.V.
19.6.22

Plan corrected
no objection
to approve
19.6.22

KARACHI MUNICIPALITY.

Memo

Re 230A sheet E1 Jail A

In reference to his application of 3rd inst. Mr. Shewale and Simab is in power, the side measurements of the plot given on the plan are incorrect. The copies of plans are therefore returned herewith for amendment. Correct measurements can be obtained from the office on application.

M. C. A. M. I. C. E.

Engineer.

Karachi Municipality

RM
14-6-22
15

400-14-5-212

No. SE 10 171 of 1922

MUNICIPAL ENGINEER'S OFFICE.

Karachi.

1922

MEMO:

The above application is forwarded to the Municipal Health Officer
for favour of report.

M. C. A. M. I. C. E.,

Engineer,

Karachi Municipality.

MUNICIPAL HEALTH OFFICER'S REPORT.

Returned to the Engineer, Karachi Municipality, with the following

Remarks:—

No objection

D. P. H. (London),
Health Officer,
Karachi Municipality.

Date _____

9. 60

192 6.

No. E. 1771 of 1922.

MUNICIPAL ENGINEER'S OFFICE,

Karachi, 6. 6. 1922.

Forwarded to the Building Surveyor and Land Surveyor for report.

[Signature]
M. C. A. M. I. C. E.
Engineer,
Karachi Municipality.

BUILDING SURVEYOR'S REPORT.

Applicant's Name Mr. Shewak ram PirimalWhether he is the owner of the plot on which it is proposed to build YesPlot under whose control MunicipalWhether it is permanent or temporary PermanentThe work proposed Additions and alterations

Building Surveyor's Report

In, Adjoining building on plot no.

230 has windows opening on
this plot. It is reported that they
are existing since the year 1914.

The arrangements of the proposed
kitchens do not suit with the
convenience of the existing tenement.

Date 13. 6. 22

[Signature]
B. H. Joodhal

ag. Building Surveyor.



6-3

3

LAND SURVEYOR'S REPORT.

Does the plot come under Alignment

No

Area of plot

Area under Alignment

Nil

Remarks

See

The measurements given on Block plan do not agree with those maintained in this office and the objections raised by Building surveyors must be complied with

[Signature]
Land Surveyor. 13/6

Date

192

ORDER OF THE ENGINEER.

D.S. objection ① - this is a private matter

" " ② - this is a question for the owner & architect

L.S. " - inform correct measurements

See

Block plan has been corrected

14/6

There appears no objection to

[Signature]
20/6

M. C., A. M. INST. C. E.,

Engineer,

Karachi Municipality.



6-4

4

No. L. S. 5799 of 1922

MUNICIPAL ENGINEER'S OFFICE,

Karachi, 29th aug 1922

Submitted to the Managing Committee for information.

M. E. C. E.
Chief Officer & Chief Engineer,
Karachi Municipality.

M. E. C. E.
M. E. C. E.,
Engineer,
Karachi Municipality

Through

THE CHIEF OFFICER & CHIEF ENGINEER,

Karachi Municipality.

RESOLUTION OF THE MANAGING COMMITTEE.

Resolution No. _____ dated _____

31/8



Form No. 1-500-24-12-21.

Karachi, 3rd June 1922.

Notice under Section 96 of Act III of 1901.

THE CHIEF OFFICER & CHIEF ENGINEER,
KARACHI MUNICIPALITY.

Sir,

I beg to inform you that I intend building additions &
alterations to the built on plot No. 230-A.
Survey Sheet No. E-1 situate in Huri udhavi Lane
Street, Jail Quarter.

As required by the Rules of the Municipality, I beg to submit herewith a
plan of the same for your approval.

I beg to remain,

Sir,

Your most obedient Servant,

Address:— c/o

DEVKISHINDAS & CO.
ARCHITECTS & SURVEYORS.
KARACHI,

Signature of the Applicant.

No. G. 5749

of 192

(i.e.) Shewakram Suroomal
MUNICIPAL CHIEF OFFICER AND

CHIEF ENGINEER'S OFFICE,

Karachi, 7th June 1922.

Forwarded to the Municipal Engineer for favour of disposal.

Car. him alth

For Chief Officer and Chief Engineer,
Karachi Municipality.

Heritage

KMR.CDD.JaQ.1922.01

3

23rd June 1912

70




Sir,

Re Pln no 230A sheet E-1 JAIL Q

56-90

In Compliance with your
memo no 4432 dated 20th inst^l
I have the honour to inform you
that I have corrected the side
measurement of plan plot no 230A
sheet E-1 I did Quarles after paying
B2/1. forgetting the measurement from your
office. I would therefore request you
to approve my plans at an early
date.


Lacmain

John most Thaddeus Lane

12
 17. 18. 19. 

B.S. for
 25/6
 23/6

Drawing No. 201.

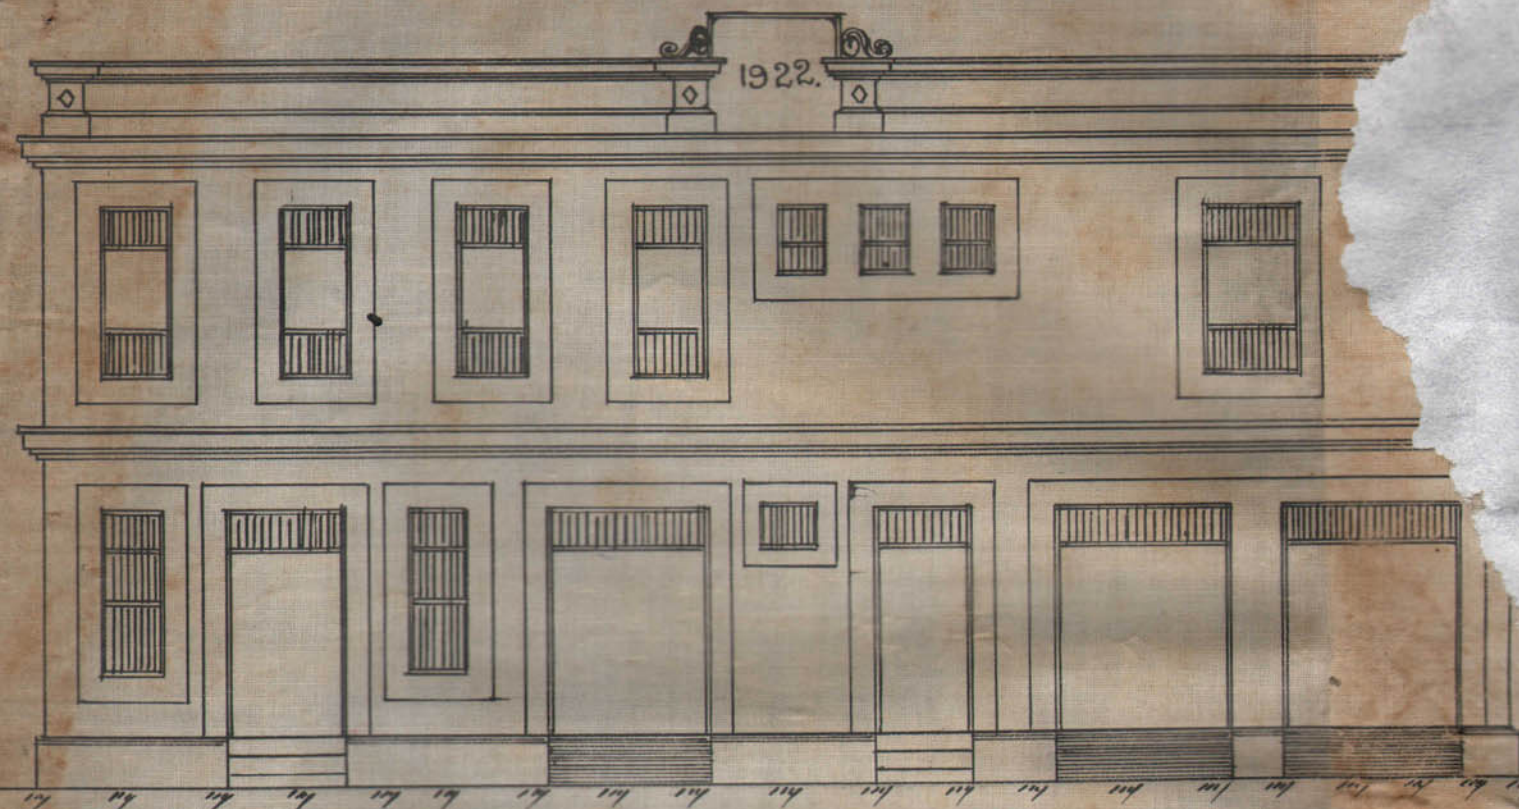

PLAN SHOWING ADDITIONS AND ALTERATIONS TO BE BUILT
EXISTING BUILDING STANDING ON PLOT NO. 230-A SHEET NO. E-1.

JAIL QUARTER.
Scale 8 ft. To Inch.

APPROVED
J. A. Shiveshanker Mudaliar.
ARCHITECTS & SURVEYORS.
17/4/22.


BLOCK PLAN.
Scale 20 ft. To Inch.



PLAN OF GROUND FLOOR.



PLAN OF FIRST FLOOR.

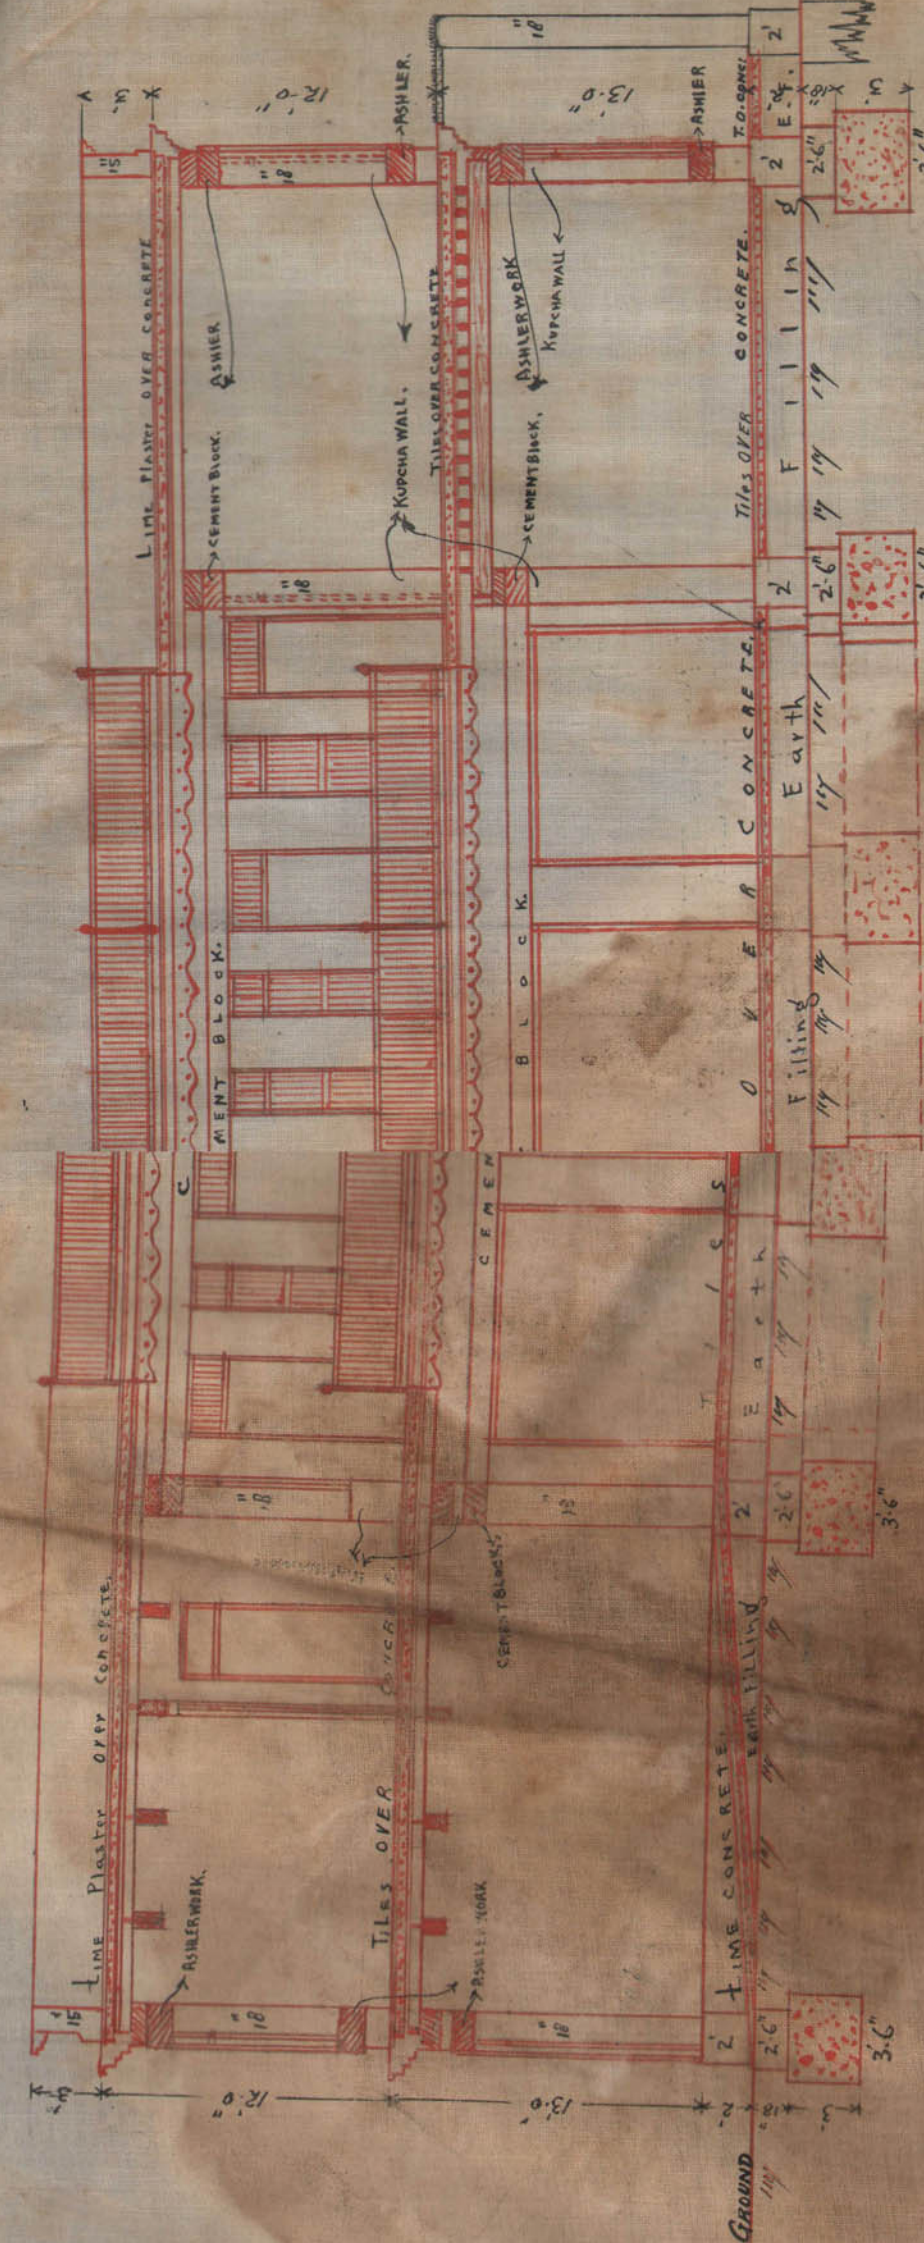

SECTION ON LINE A-B

189