



200-16-7-13.

Form No. 2.

ORDERS UNDER SECTION 96 (2) OF ACT III OF 1910.

No. E/

317

OF 1914.

MUNICIPAL ENGINEER'S OFFICE,

Karachi,

1914.

MEMO:

With reference to his application dated 15th Feb 1914,
 Mr. Mushtaq Ahmad is informed
 that the plan submitted by him for building a house
 on plot No. 194 Survey Sheet 61
 situate in _____ Street pl
 Quarter, is approved, and permission to build in accordance therewith is
 granted. The building to be erected subject to the Byelaws and Rules of the
 Municipality.

A. M. INST., C. E.,

Engineer,

Karachi Municipality.

NOTE 1.—This pass does not give permission to occupy Municipal land with building materials. This can only be allowed when the street is wide enough to permit building materials being deposited on it without it being a source of danger to the public, and only then on a hoarding being placed round the land to be occupied, and on payment in advance of fees for occupation of Municipal land, at the following rates:—

	Rs.	A.	P.
(1) For the first three months, per square yard, per diem ..	0	0	$\frac{1}{2}$
(2) For the next three months ..	0	0	1
(3) For any subsequent time ..	0	0	2

NOTICE 2:—Windows and doors of the building will not be permitted to project on or overhang any public street or Municipal land.

Notice No. 3. Plinths will only be allowed to project 2" on any public street for ornamental purposes.



No. E. 359 of 1913

MUNICIPAL ENGINEER'S OFFICE,

Karachi, 14 January 1913.

MEMO.

Inspector Quarter is informed

that Mr. Mr. Lewis V. Brown has been permitted

to Live his house

on plot No. 194 E. Street

Quarter. Report should be made to the undersigned when the house is

completed.

A. M. INST, C. E.,

Engineer,

Karachi Municipality.

Through the Health Officer, Karachi Municipality.

Note--The plot is held as a temporary occupation lease and the owner agrees to remove the building at any time on receiving a month's notice to do so.



(500-14-9-13.)

Form No. 5.

No. E. 358 of 1913

MUNICIPAL ENGINEER'S OFFICE,

Karachi,

1913

MEMO.

Building Inspector _____ is informed

that Mr. Abdul Latif Khan has been permittedto build his houseon plot No. 194 E1 Street 1st

Quarter. Report should be made to the undersigned when the house is
completed.

A. M. INST. C. E.,

Engineer,

Karachi Municipality.

4-1



To

*Land Surveyor
attach to report
H. J. [Signature]
6/1/14
7/1/14*

*Karachi
6 Jan 1913*

*The Engineer
Karachi Municipality*

Sir,

*With reference to your letter
No. E 7193 dated 6th November 1913 I beg
to say that I have made the application
as Secretary of the Brahmo Samaj in
my representative capacity and that
my name can not therefore appear in
the Land Records.*

*yours faithfully
Rathawdes Shivwade
Secretary N. D. Brahmo Samaj
Karachi*

*13.
7.1.14*



42

Sir,

Let me report
i.e., I beg to report
that there is no
objection now to grant
pass as the Appl.
being a Honorary Secretary
of the Samaj.

Respectfully
orders.

Yours truly
W. S. S. S.
8/1/14

Submitted to the Engineer
for order. There seems no
objection to grant pass as
the applicant is the Honorary
Secretary of the Samaj.

N. S. S.
8/1/14

Issue Pass

8/1/14



No. E.

7193

of 1913.

Municipal Office,

Karachi,

4th November 1913.6th

MEMO:—

With reference to his application dated their15th Dec Mr. Madhows Shrivats is
Messrs. areinformed that plot No. 194 & 1 field quarterdoes not stand in the Land Register in his name. He is
their They are thereforerequested to produce any documentary evidence to prove his
their ownership,when his
their request for a pass will be considered.J. A. C. L. P. S.

A. M. INST. C. E.,

Engineer,

Karachi Municipality.



Memorandum.

6

From

Daryanomal R. Mirchandani,

L. C. E.,

ARCHITECT.

To

The Chief Officer & Chief Engineer

Karachi Municipality



Karachi 10.10.1913

Sir No

I have the honour to submit herewith plans & application signed by me for proposed ashram in the Brahmo Mandir compound on plot No: 194 sheet E 1, Jail Quarter, for favour of early permission to build.

I have the honour to be

sir,

your most obedient servant

Daryanomal R.
Mirchandani
L. C. E.
Architect

Approved & forwarded
Mun. Engineer




Heritage

KMR.CDD.JaQ.1913-1914.01

500—27.7.1912.

Form No. 1.

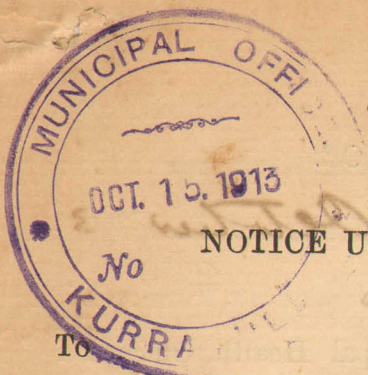Karachi, 15 — 10 — 191 3

NOTICE UNDER SECTION 96 OF ACT III OF 1901.

To

THE CHIEF OFFICER AND CHIEF ENGINEER,
KARACHI MUNICIPALITY.

SIR,

I beg to inform you that I intend building tenements
on plot No. 194Survey Sheet No. E/1 Situate in _____Street Jail Quarter. _____As required by the rules of the Municipality, I beg to submit herewith
a plan of the same for your approval.

I beg to remain,

Sir,

Your most obedient Servant,

Madhuxdas Shiwandas

Signature of the applicant.



No. G. of // 305.1913.

MUNICIPAL CHIEF OFFICER AND

CHIEF ENGINEER'S OFFICE.

Karachi, 15th October 1913.

Forwarded to the Municipal Engineer for favour of disposal.

2009
21/10/13
Mr. Bay
20 10 13

Geo. Whens
A. M. INST. C. E.,
Chief Officer and Chief Engineer,
Karachi Municipality.

shw to Ho.
EO



No. E. ²6738 of 1913.

MUNICIPAL ENGINEER'S OFFICE.

Karachi, 15th October 1913.

MEMO.

The above application is forwarded to the Municipal Health Officer for favour of report.

Thos. L. Surveyor

A. M. I. C. E.,

Engineer,

Karachi Municipality.

MUNICIPAL HEALTH OFFICER'S REPORT.

Returned to the Engineer, Karachi Municipality, with the following remarks—

No objection


D. P. H.

D. P. H. (London)

Health Officer,

Karachi Municipality.

Date 23-10-1913.

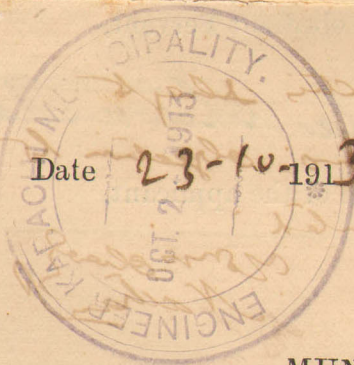

No. E. 6980 of 1913.

MUNICIPAL ENGINEER'S OFFICE.

Date 24th October 1913.

Forwarded to the Enquiry Officer for report.

A. M. I. C. E.,

Engineer,

Karachi Municipality.

Through

The Land Surveyor,

Karachi Municipality.



ENQUIRY OFFICER'S REPORT.

Applicant's name M. Karim-ud-Din

Whether he is the owner of the plot on which it is proposed to build _____

The work proposed to build a houseEnquiry Officer's report to say so report that theplot can be used to build on alone & that
there is no objection in granting passDate 27 Dec 1913.

Enquiry Officer.

Submitted through the Land Surveyor.

LAND SURVEYOR'S REPORT.

Does the plot come under Alignment no

Area of plot _____

Area under Alignment _____

Remarks for. With reference to this sheet
report that there seems no objection to
permission to build as granted.Date 1-11 1913

Land Surveyor.

ORDERS OF THE ENGINEERS.

Issue PassHaril L. Verley
A. M. I. C. E.,

Engineer,

Karachi Municipality.



4

No. E. 38th of 1914.

MUNICIPAL ENGINEER'S OFFICE.

Karachi, 20th January 1914.
21

Submitted to the Managing Committee with a recommendation that the plan be approved.

Forwarded

*Specimen to
M. J. & E.*

Chief Officer, Karachi Municipality
Through

J. A. I. C. E.

A. M. I. C. E.,

Engineer,

Karachi Municipality.

THE CHIEF OFFICER AND CHIEF ENGINEER,

KARACHI MUNICIPALITY.

RESOLUTION OF THE MANAGING COMMITTEE.

Resolution No. _____ Date _____

J. A. I. C. E.

NOTE

IN CONSTRUCTION THE PROPOSED
VERANDAS WILL BE 10' INSTEAD OF
8 FT SHOWN BY SCALE IN THE PLAN

PLAN

- FOR -

PROPOSED ASHRAM

IN THE BRAHMO MANDIR COMPOUND

MISSION ROAD

SCALE 8 TO ONE INCH

PLOT NO 194 SHEET E1

JAIL QUARTER

Harold L. Verley


A. M. Inst., C. E.

Engineer.


Kerachi Municipality

ELEVATION


— GROUND FLOOR PLAN —

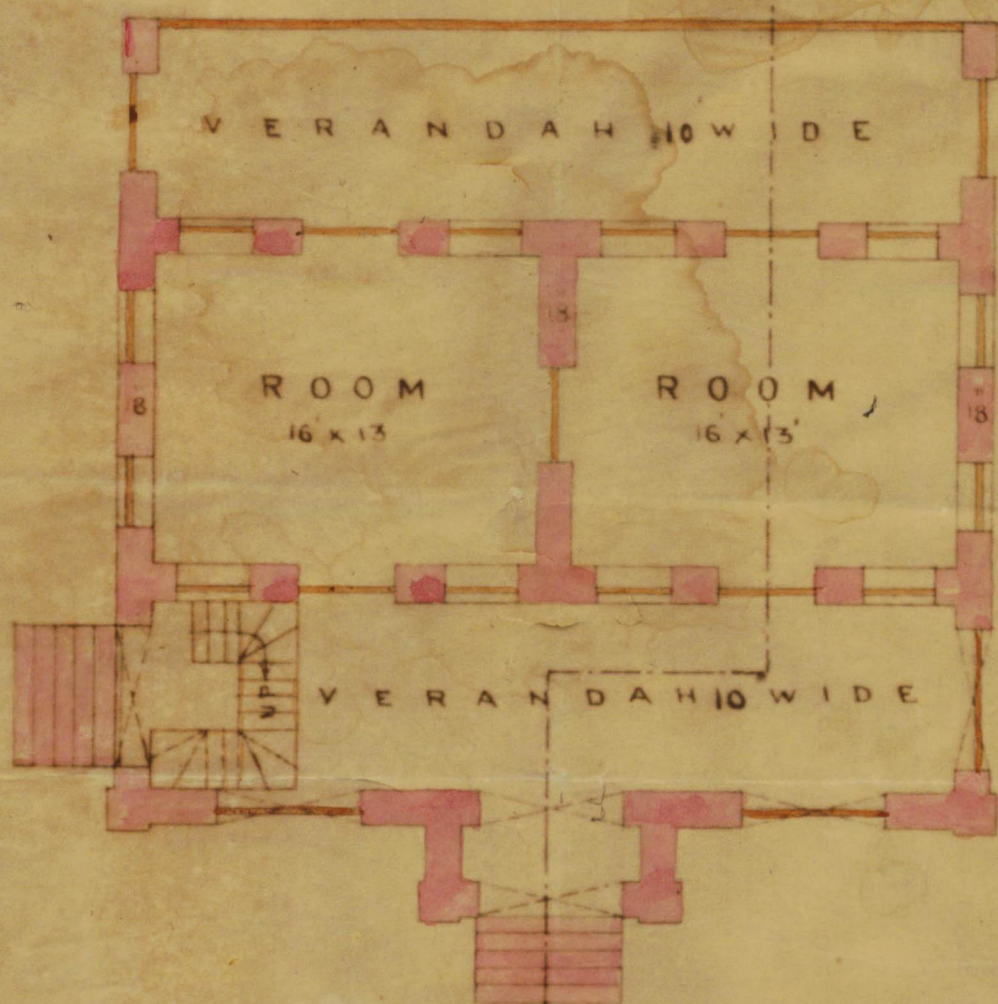

— FIRST FLOOR PLAN —

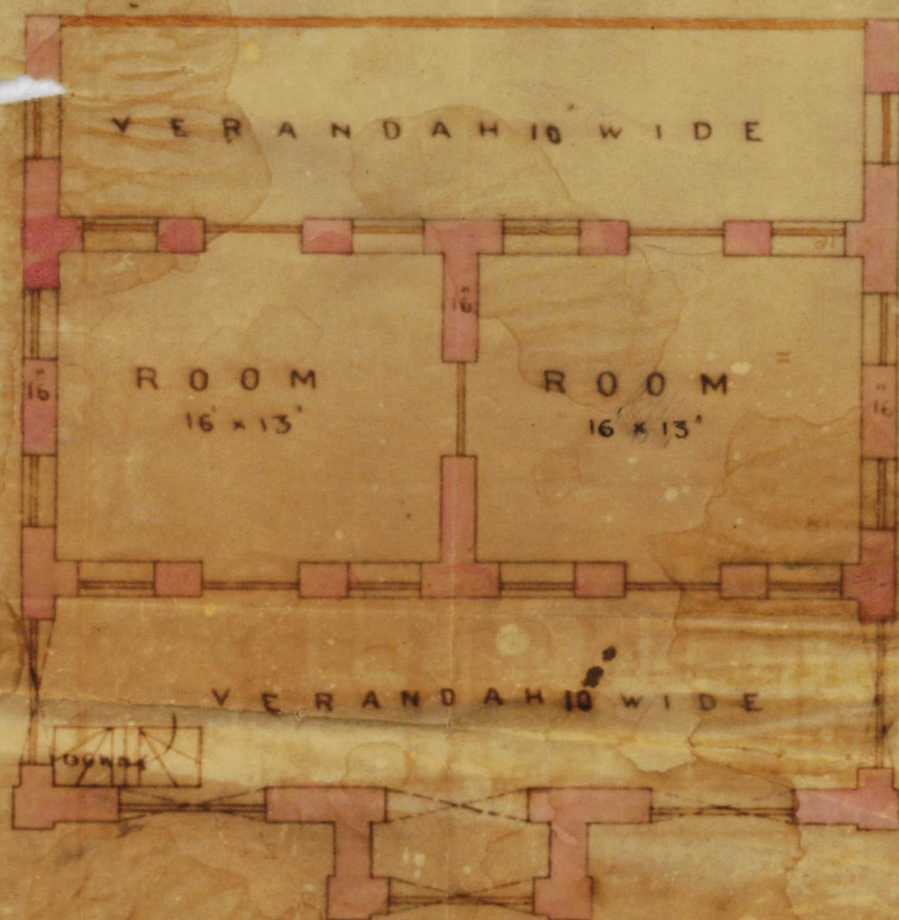

SECTION ON A.B.

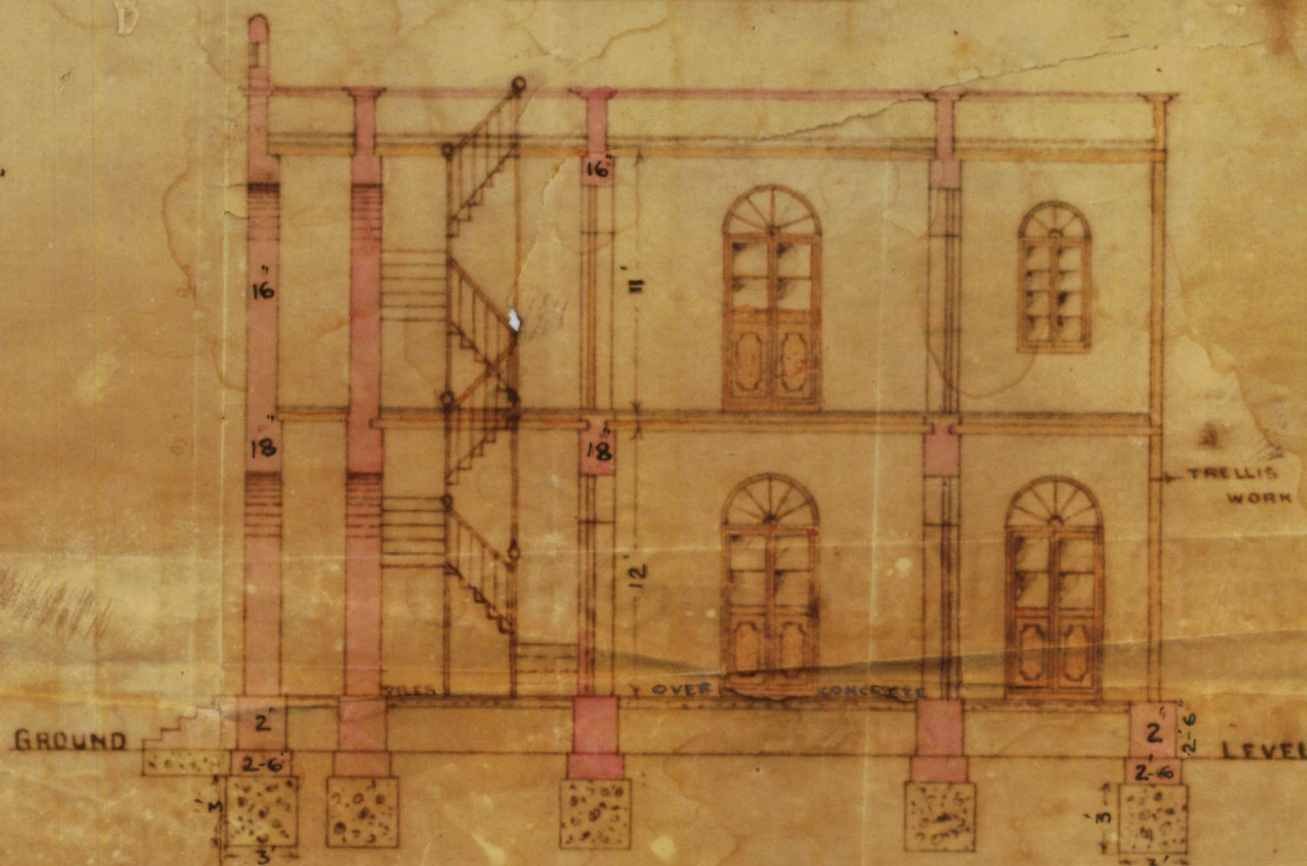

ARCHITECT

785 BUNDER ROAD
KARACHI



— SITE PLAN —

Scale 20' = 1 inch

W. L. Verley

A. M. Inst., C. E.

Engineer,

Karachi, India



N

