



Heritage

KMR.CDD.JmQ.1925.01

39..



## BUILDING COMPLETION REPORT.

LAND MANAGER AND ARCHITECT'S OFFICE,

Karachi, \_\_\_\_\_ 19

To

THE LAND MANAGER AND ARCHITECT,  
KARACHI MUNICIPALITY.

SIR

I beg to report that the building work on plot No. 4 Sheet Jm. 1Jamshah Quarter owned by Mr. T. C. Butten

has been completed according to plans approved by the Municipality. Orders are requested to file the correspondence.

Your obediently,

Building Surveyor " " Section  
Karachi Municipality.

No. L. M. A. \_\_\_\_\_ of 19

Karachi, \_\_\_\_\_ 19

Copy to the Assessor &amp; Collector for information.

*Amended file must have been**P. J.**6/11/25**6/11/25*B. Sc A. M. Inst C. E.  
Land Manager and Architect,  
Karachi Municipality.



Heritage

KMR.CDD.JmQ.1925.01

## BUILDING COMPLETION REPORT.

LAND MANAGER AND ARCHITECT'S OFFICE,

Karachi, \_\_\_\_\_ 19

To

THE LAND MANAGER AND ARCHITECT,  
KARACHI MUNICIPALITY.

SIR

I beg to report that the building work on plot No. 4 Sheet Jm. 1,  

has been completed according to plans approved by the Municipality. Orders are requested to file the correspondence.

Your obediently,

Building Surveyor" "Section  
Karachi Municipality.

No. L. M. A. \_\_\_\_\_ of 19

Karachi, \_\_\_\_\_ 19

Copy to the Assessor & Collector for information.

B. Sc A. M. Inst C. E.  
Land Manager and Architect,  
Karachi Municipality.

*Handwritten signature*



Form No. 6-200-13-7-24.

No. L. M. A.

5618

OF 1925.

MUNICIPAL ENGINEER'S OFFICE,

Karachi,

12.6.

1925.

MEMO.

Building Surveyor Section A is informedthat Mr. J. E. Batani has been permittedfor a building

his house



on plot No. 4, g- m- 1 StreetJamshed Quarter, report should be made to the  
undersigned when house is completed.Building Surveyor  
CDDExecutive Engineer,  
Karachi Municipality.




Nº 210  
SHEET Nº 3

PROPOSE BUNGALOW ON PLOT Nº 4  
JAMSHED QUARTER  
SCALE 8'-1"

SECTION ON EF

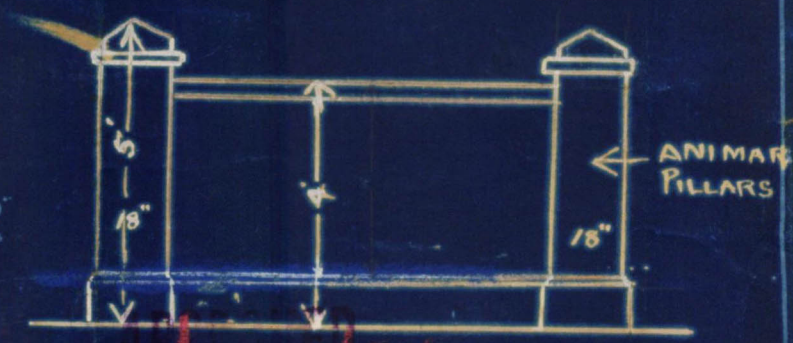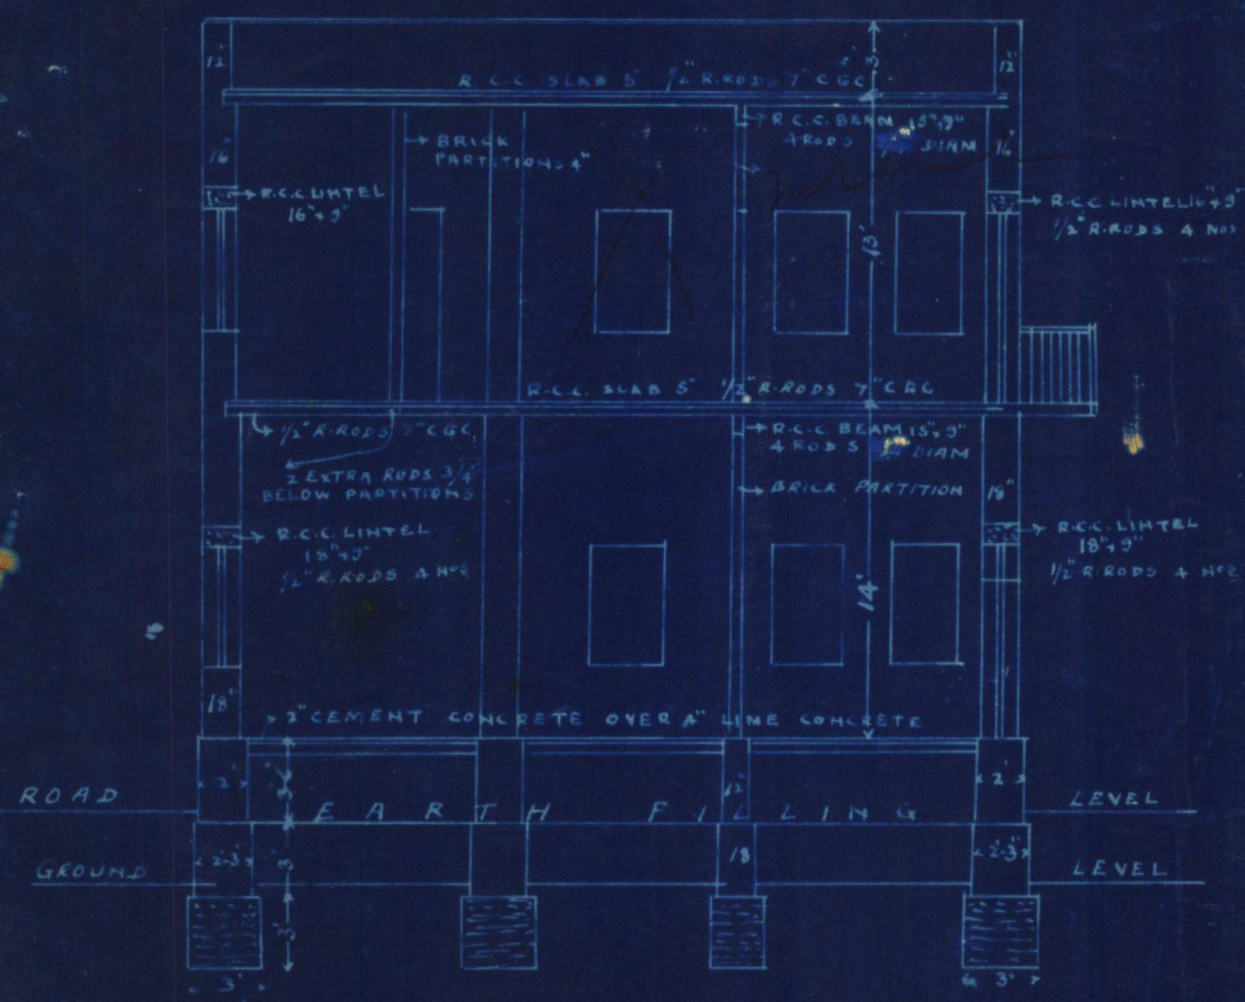

SECTION OF COMPOUND WALL

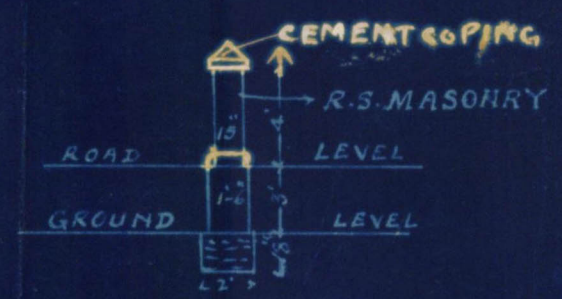

T.C. Bud...

Harsh H. Arora  
ARCHITECT & ENGINEER  
BUNDER ROAD




PROPOSED BUNGALOW ON PLOT No 4.

JAMSMED QUARTER

No 210  
SHEET No 2


FRONT ELEVATION

SCALE 6"=1"

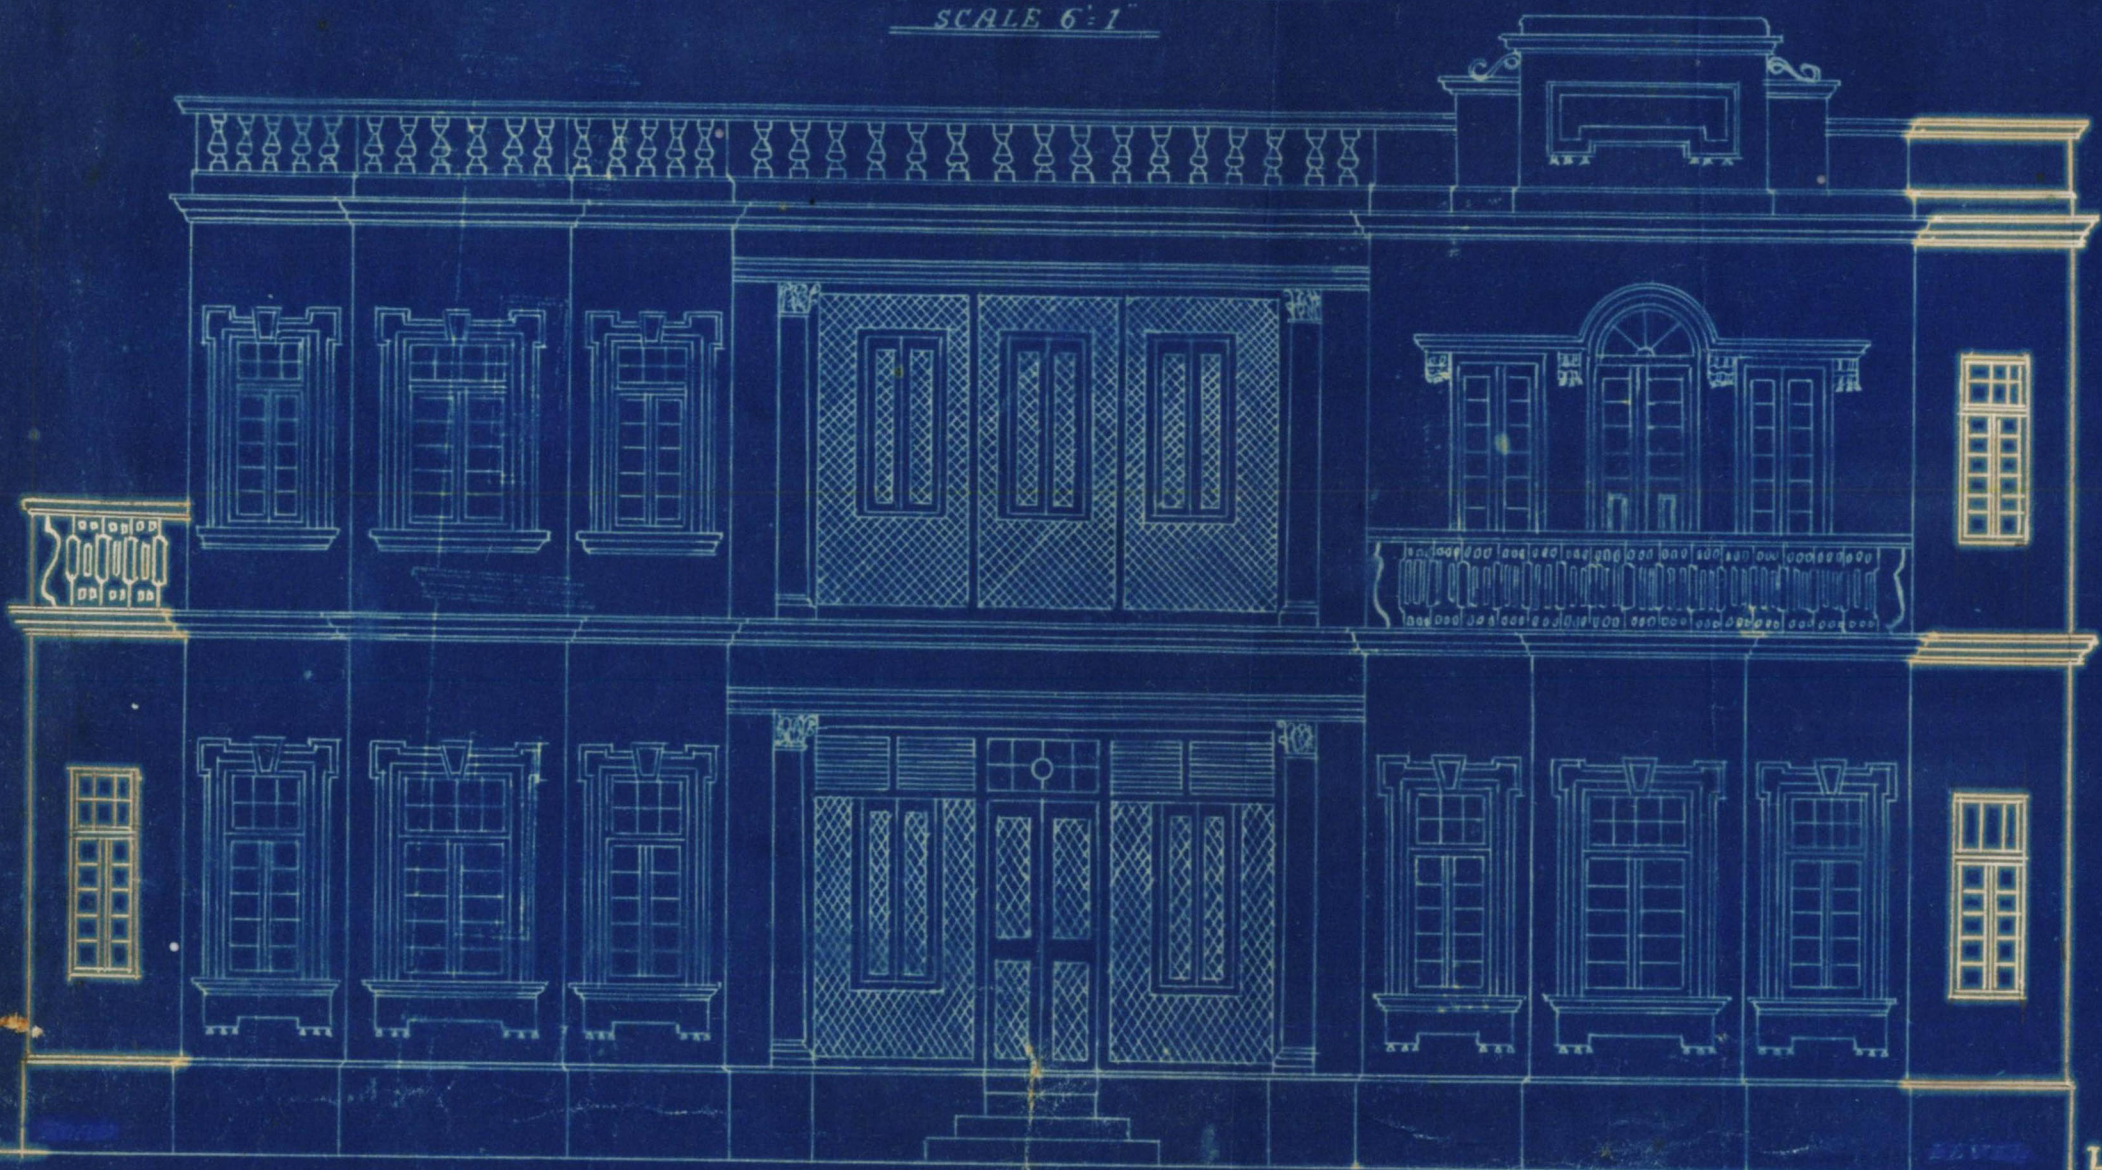

SECTION ON A.B.


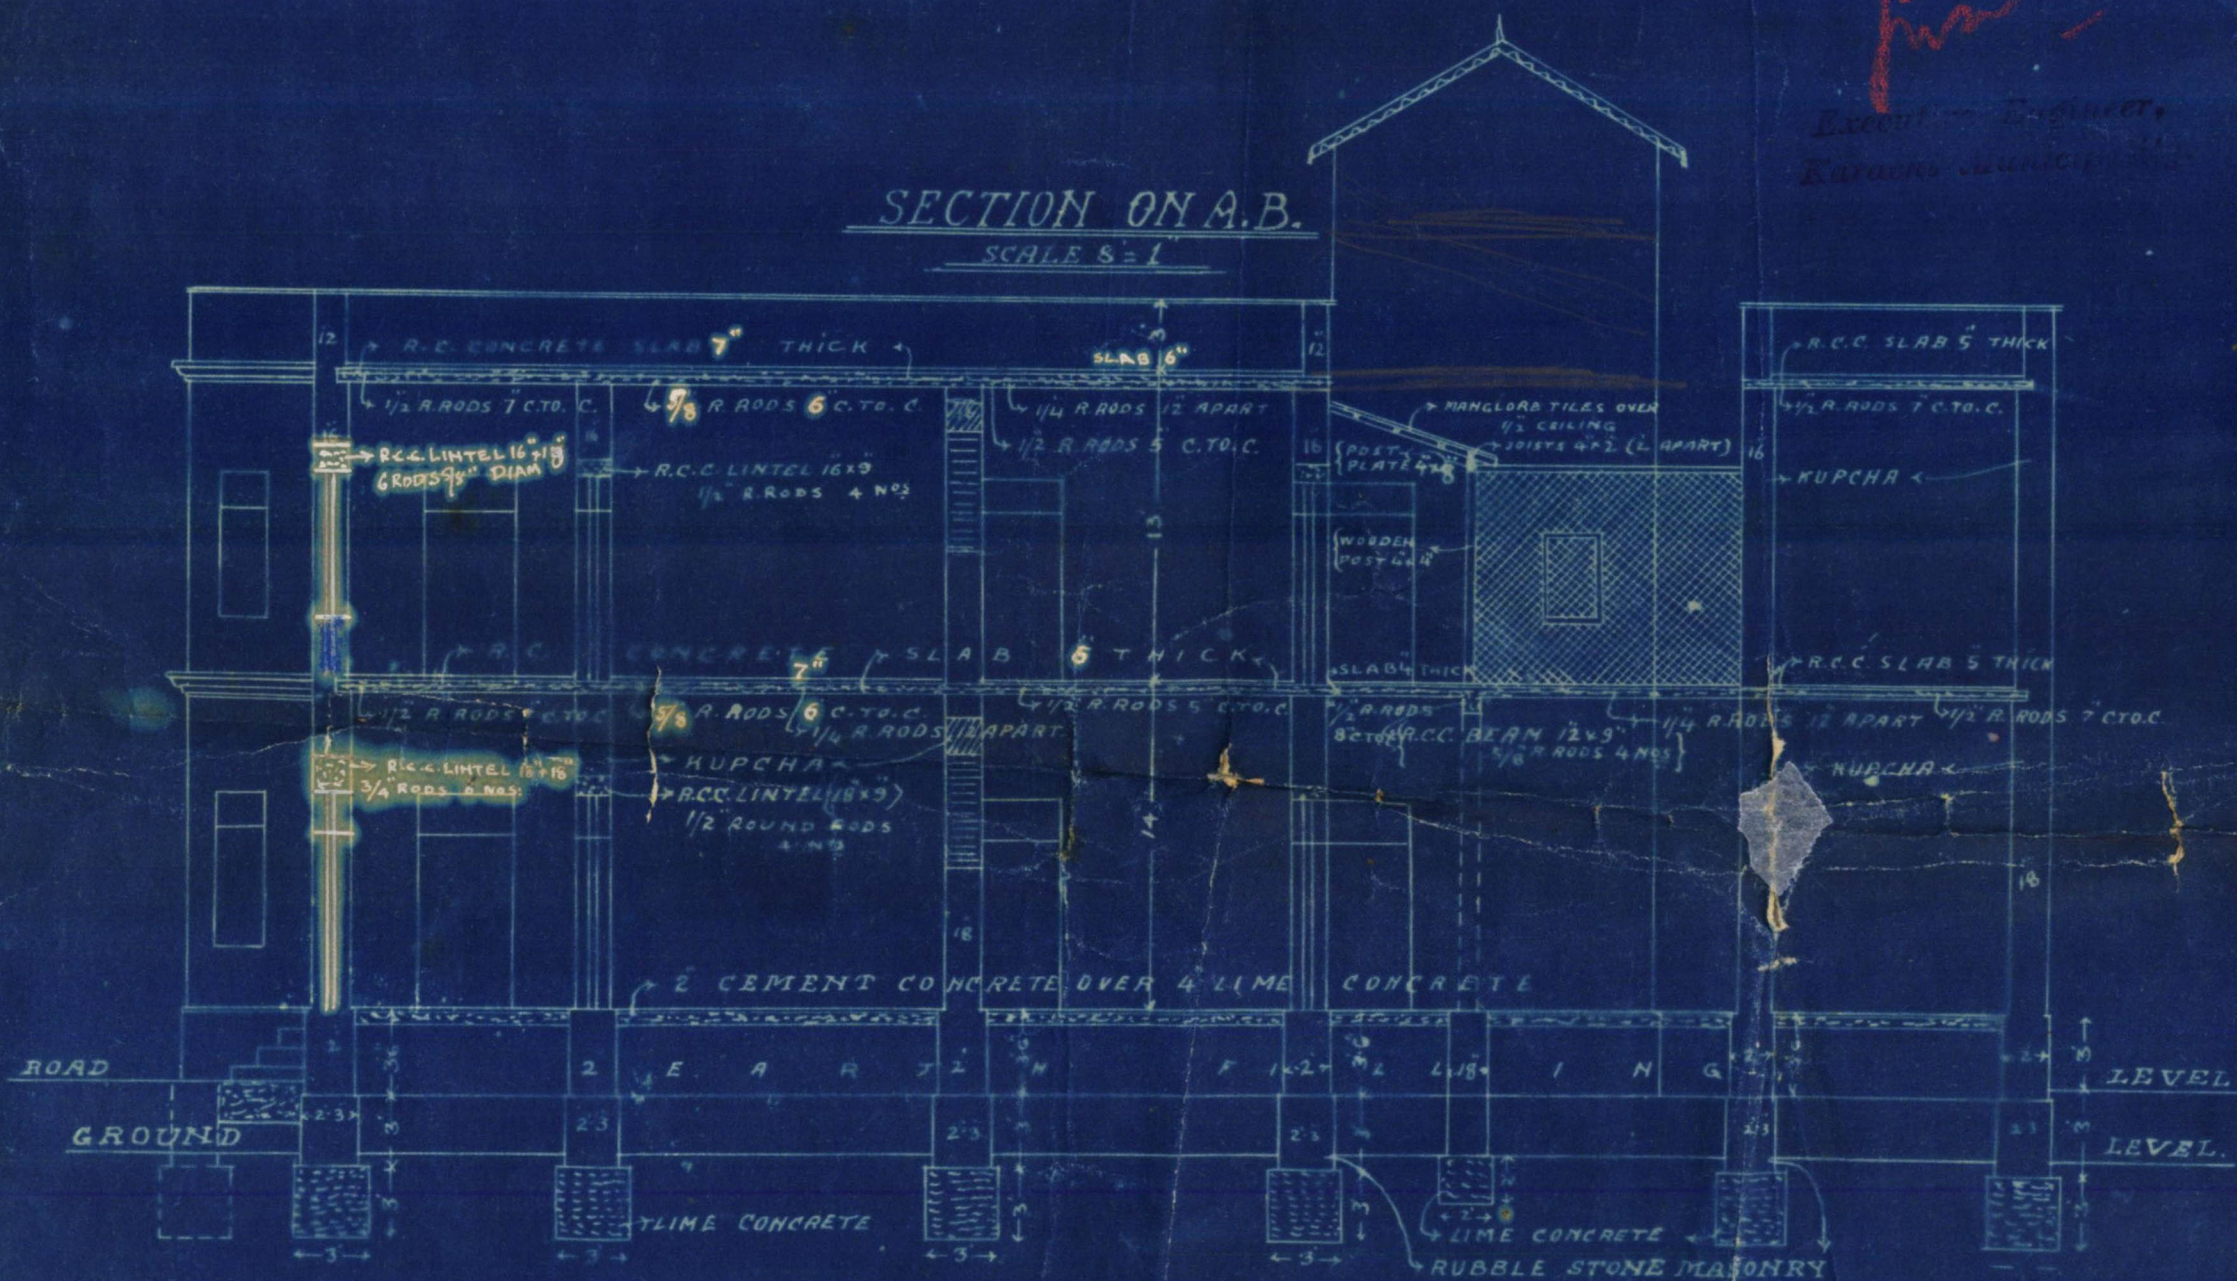

APPROVED

Executive Engineer,  
Karachi Municipal Corporation

T. Chatterjee

OWNER

Hassasing H. Advani  
ARCHITECT & SURVEYOR  
BUNDER ROAD, KARACHI




PLAN OF PROPOSED BUILDING ON PLOT No 4.  
JAMSHED QUARTER.  
SCALE 8"=1'


TOTAL AREA OF THE PLOT 424.25 S.F.  
AREA ALLOWABLE FOR CONSTRUCTION 3474.75 S.F.  
PROPOSED BUILDING AREA:

|                               |                             |
|-------------------------------|-----------------------------|
| MAIN BUILDING                 | (1) 1x425x54 = 2295.00 S.F. |
|                               | (2) 1x13.5x13 = 175.50 "    |
|                               | (3) 1x29x6 = 174.00 "       |
|                               | (4) 1x12.5x3 = 37.50 "      |
|                               | (5) 2x15x1 = 30.00 "        |
|                               | (6) 2x15x4.5 = 94.50 "      |
|                               | (7) 2x17x1 = 34.00 "        |
|                               | (8) 2x17x4.5 = 108.00 "     |
| KITCHEN                       | (9) 1x8x4 = 32.00 "         |
|                               | (10) 1x19x14 = 304.00 "     |
| STEPS                         | (11) 1x7.5x3 = 22.50 "      |
|                               | (12) 1x6x3 = 18.00 "        |
|                               | (13) 1x3x3 = 9.00 "         |
| OUT HOUSES                    | (14) 1x26x19.37 = 832.50 "  |
| STAIRS                        | (15) 1x18x3 = 54.00 "       |
| TOTAL                         | 4220.50 S.F.                |
| TOTAL AREA UNDER CONSTRUCTION | 469 S.F.                    |


BLOCK PLAN  
SCALE 20"=1'

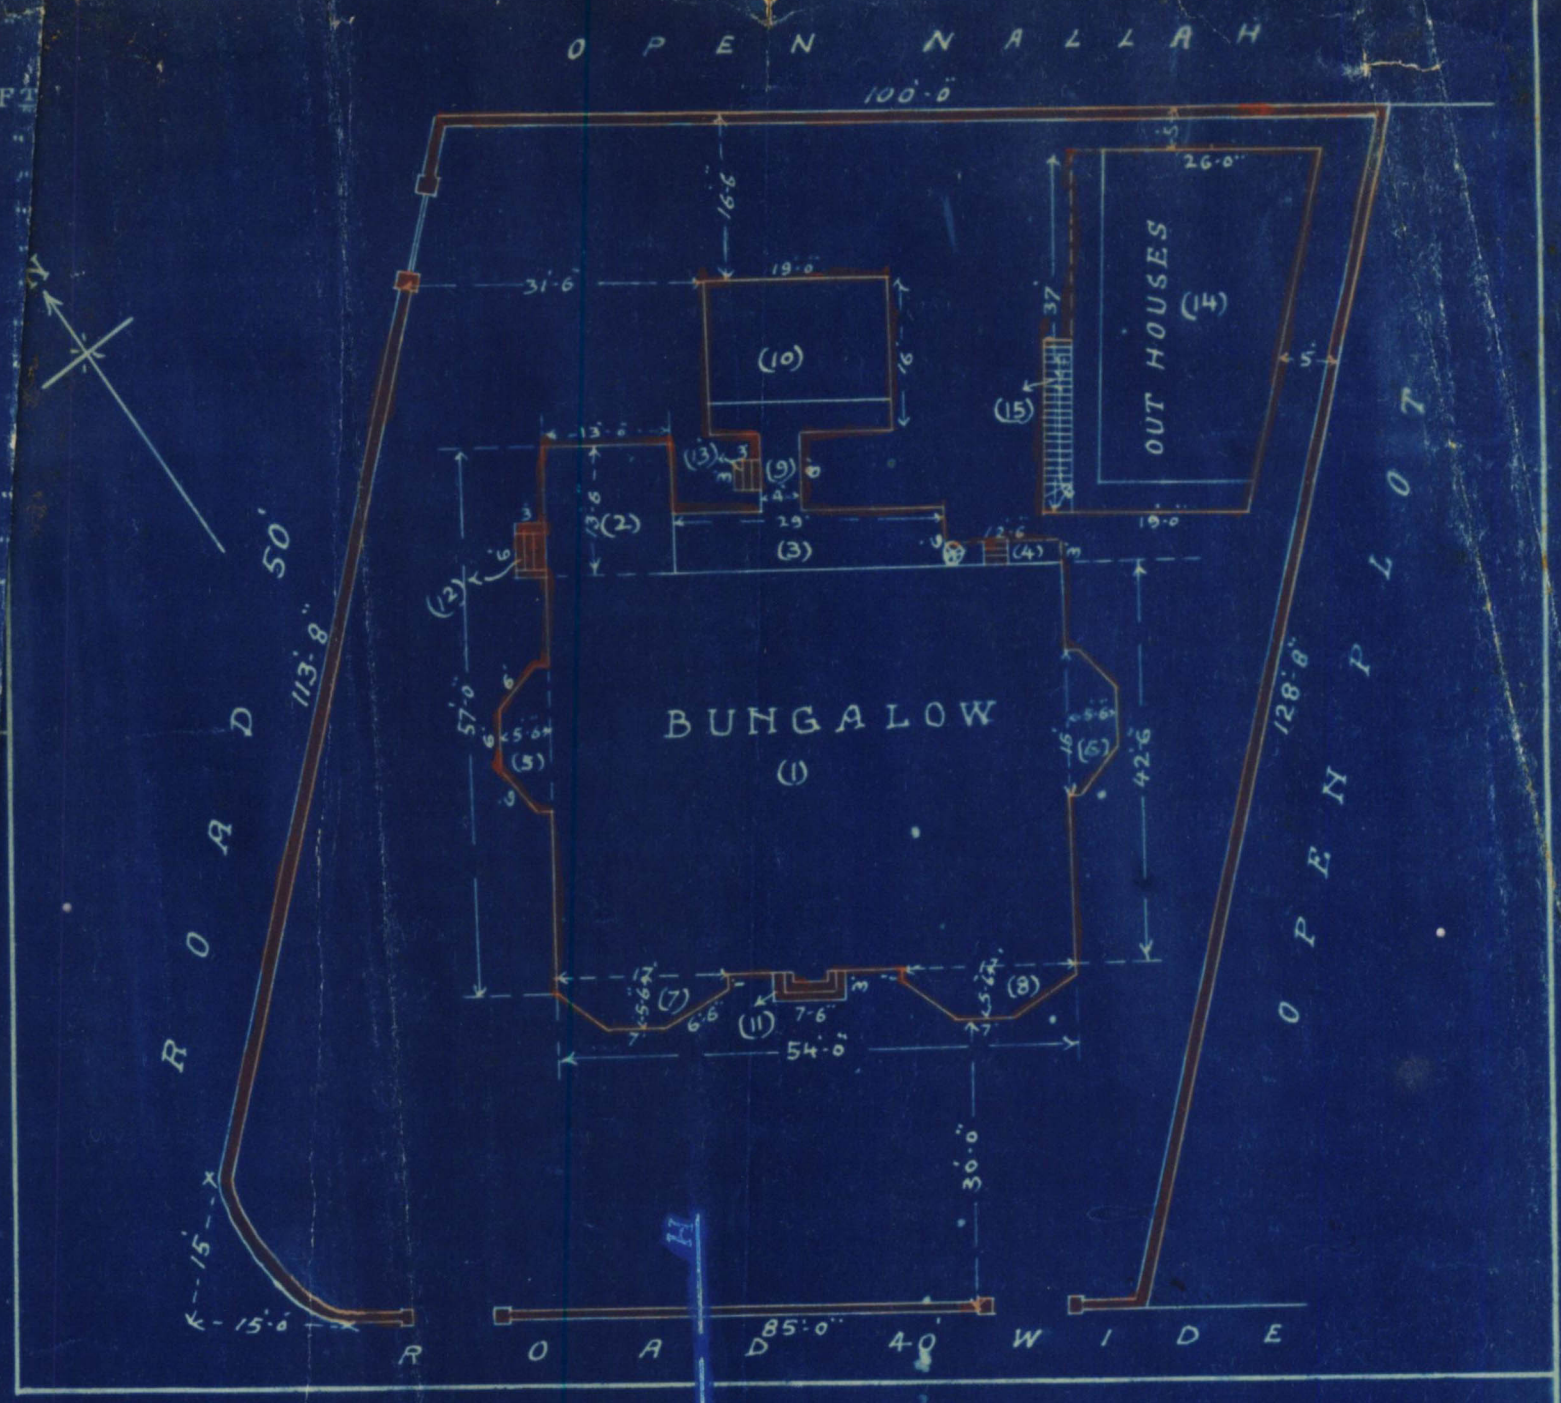


GROUND FLOOR

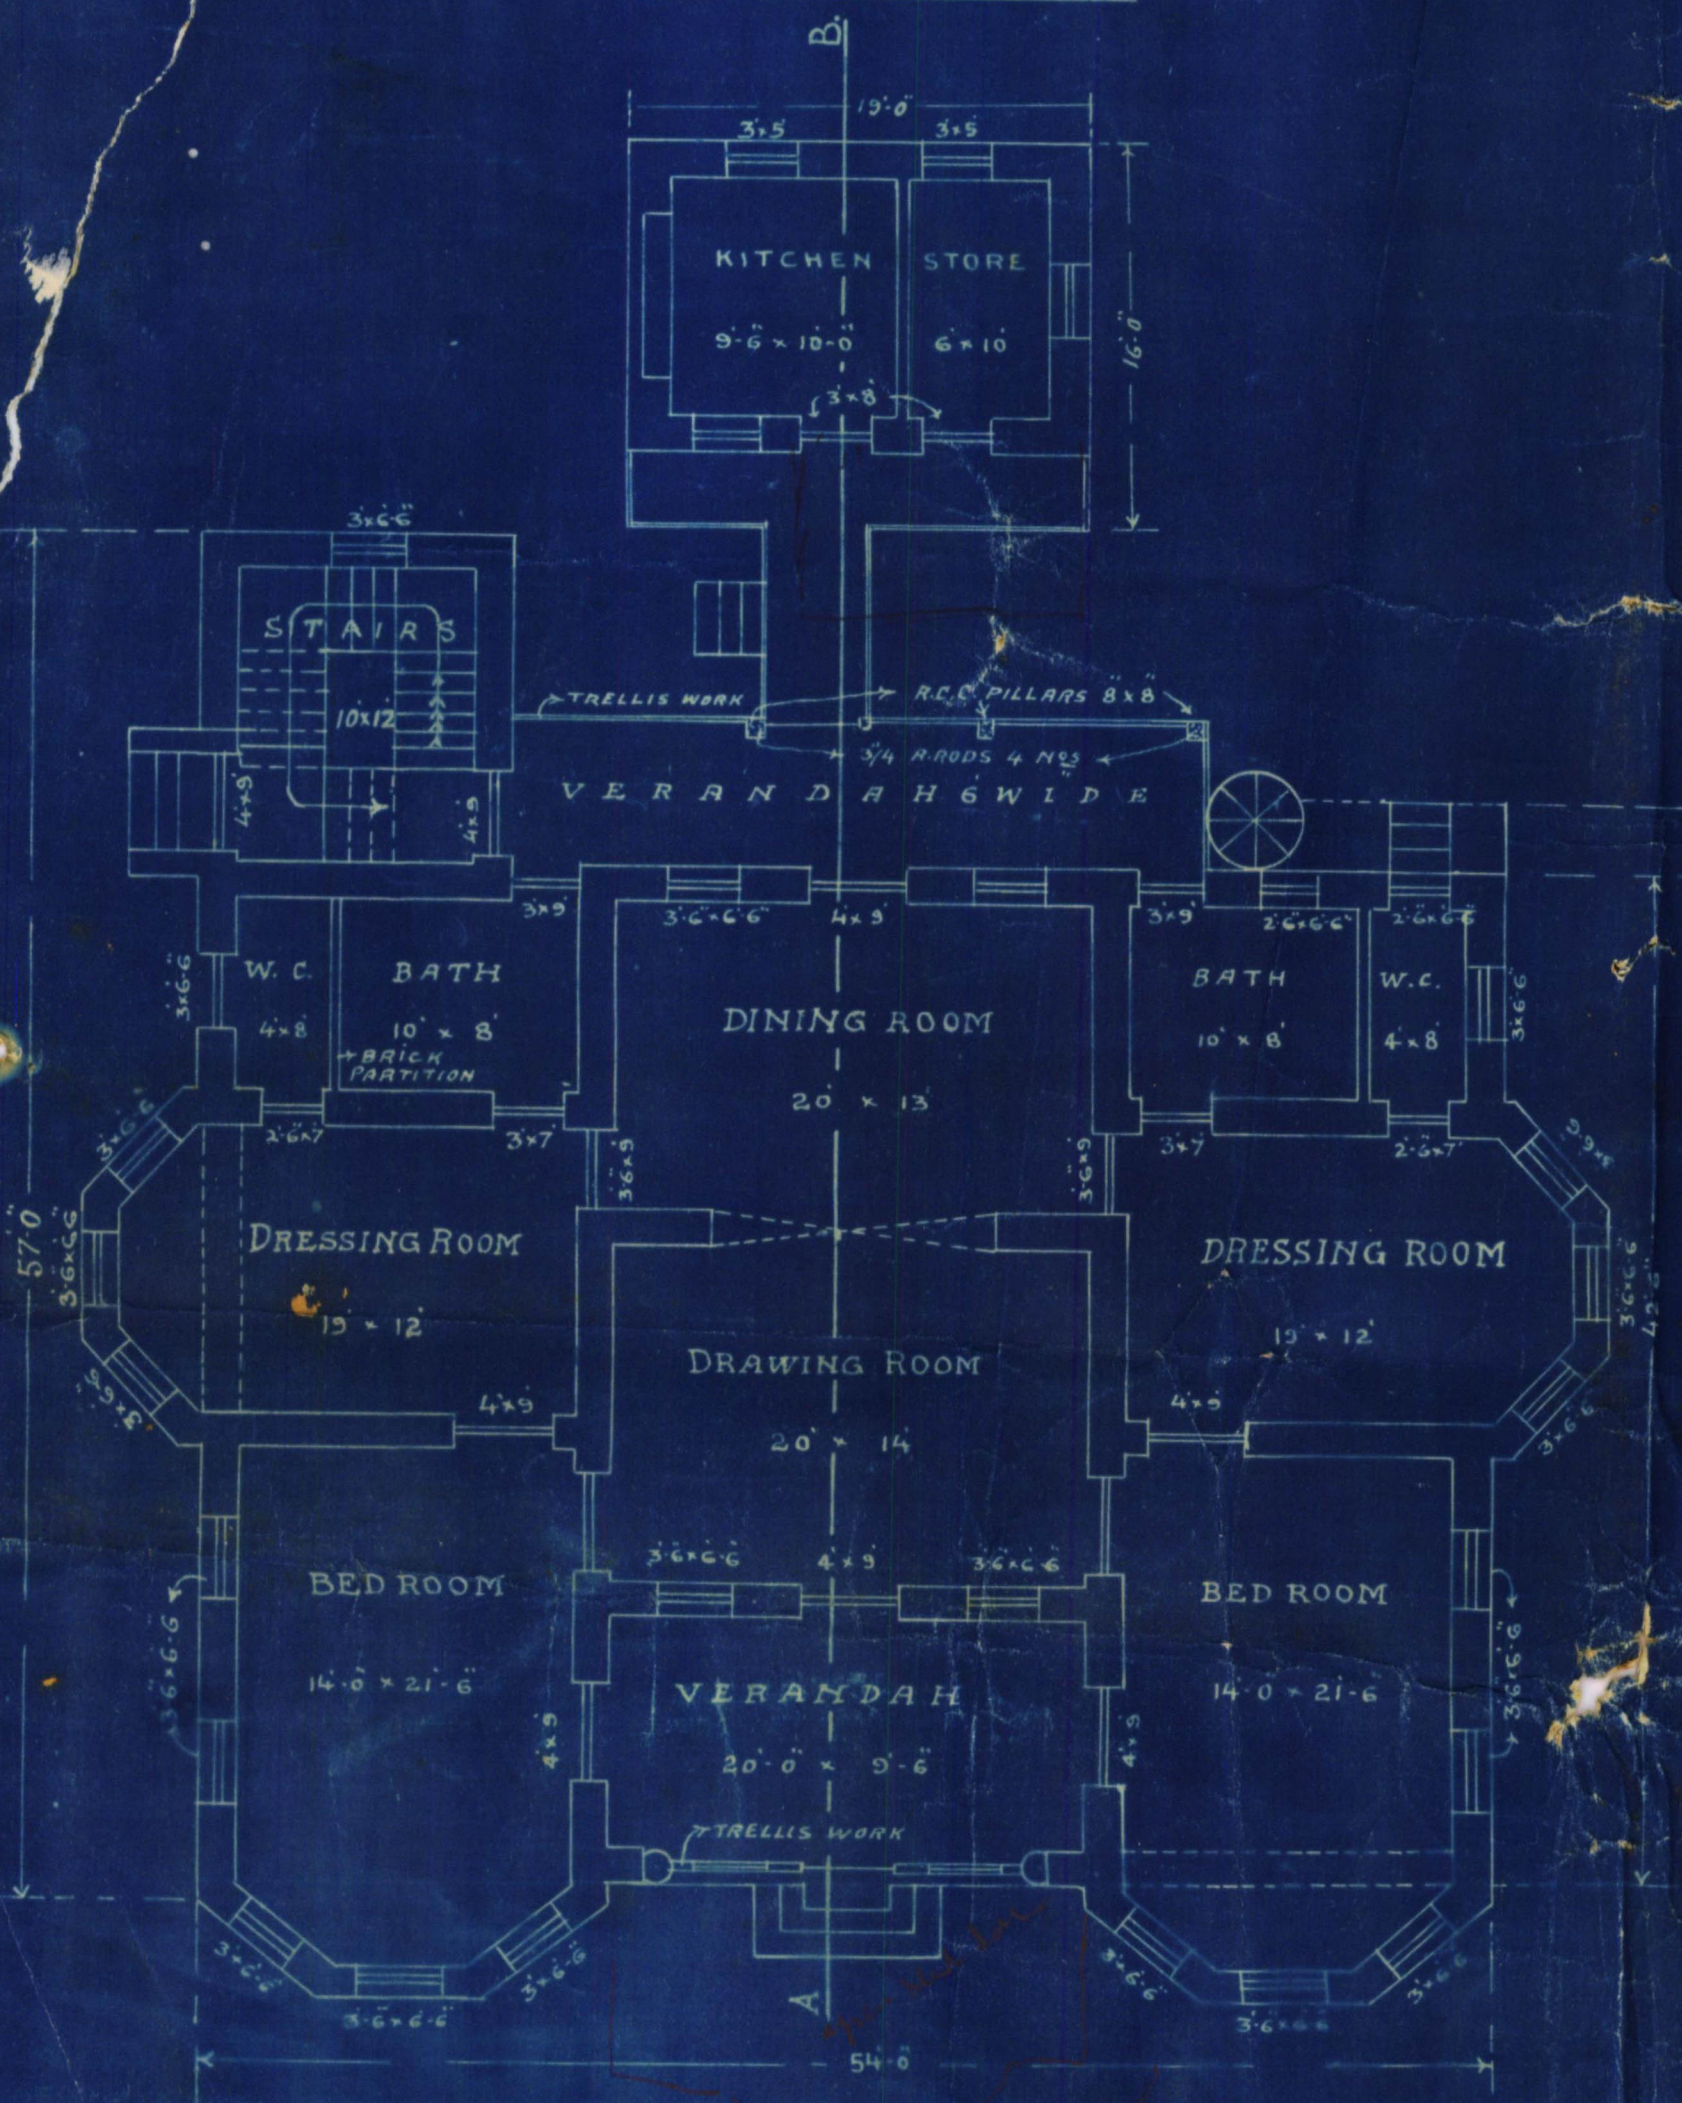


FIRST FLOOR

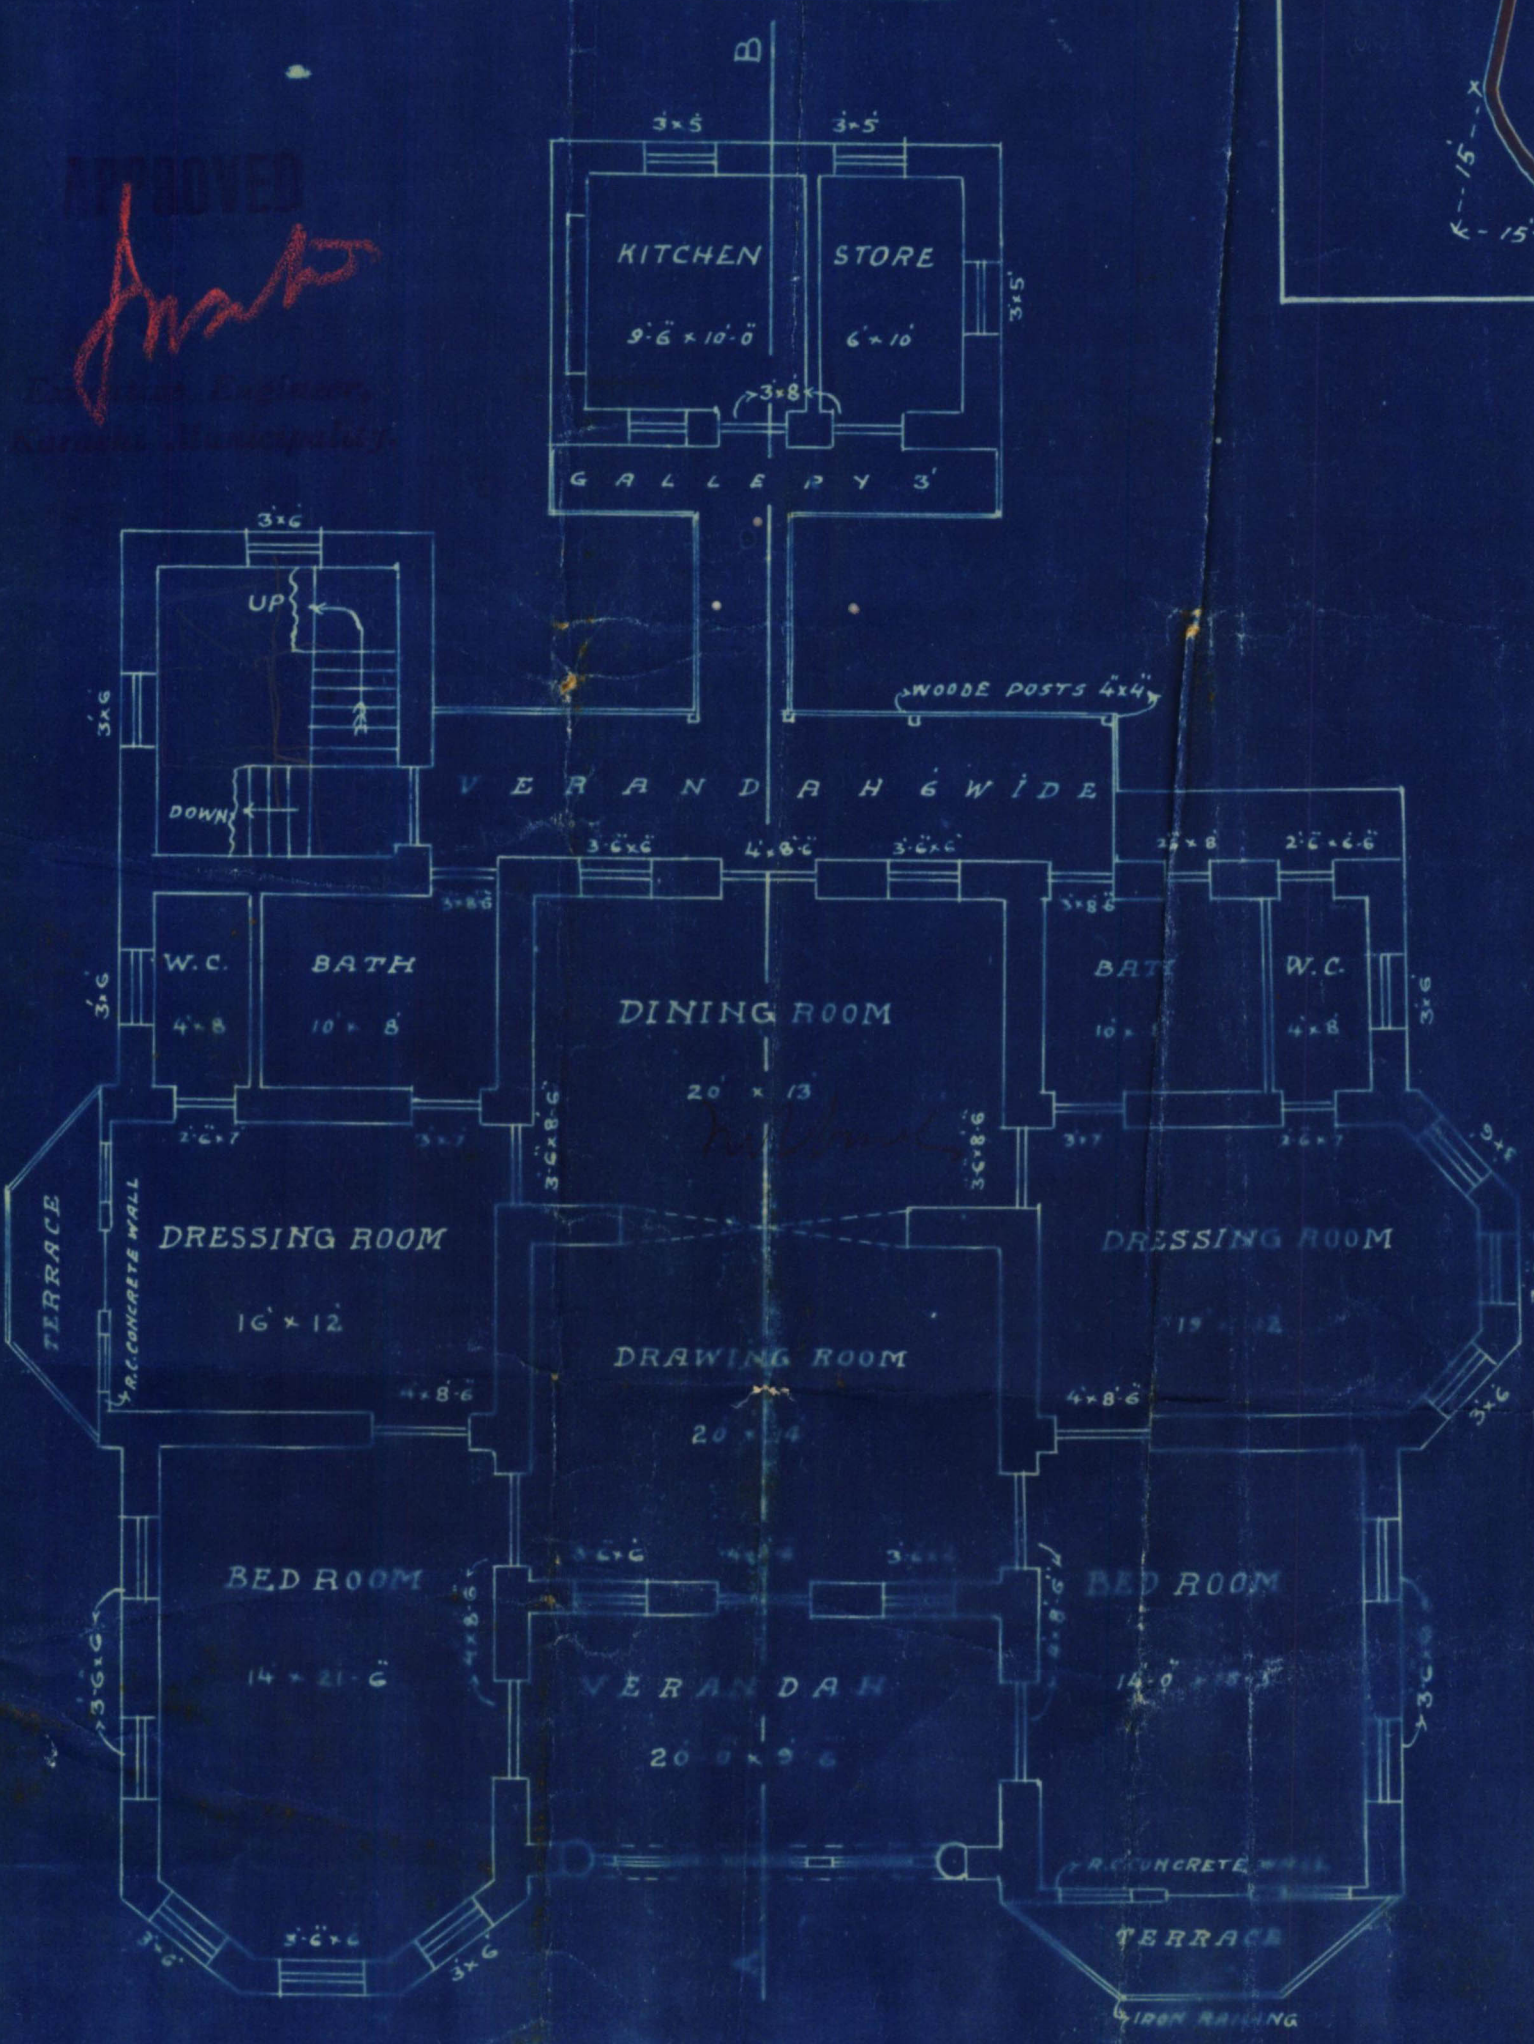

FIRST FLOOR

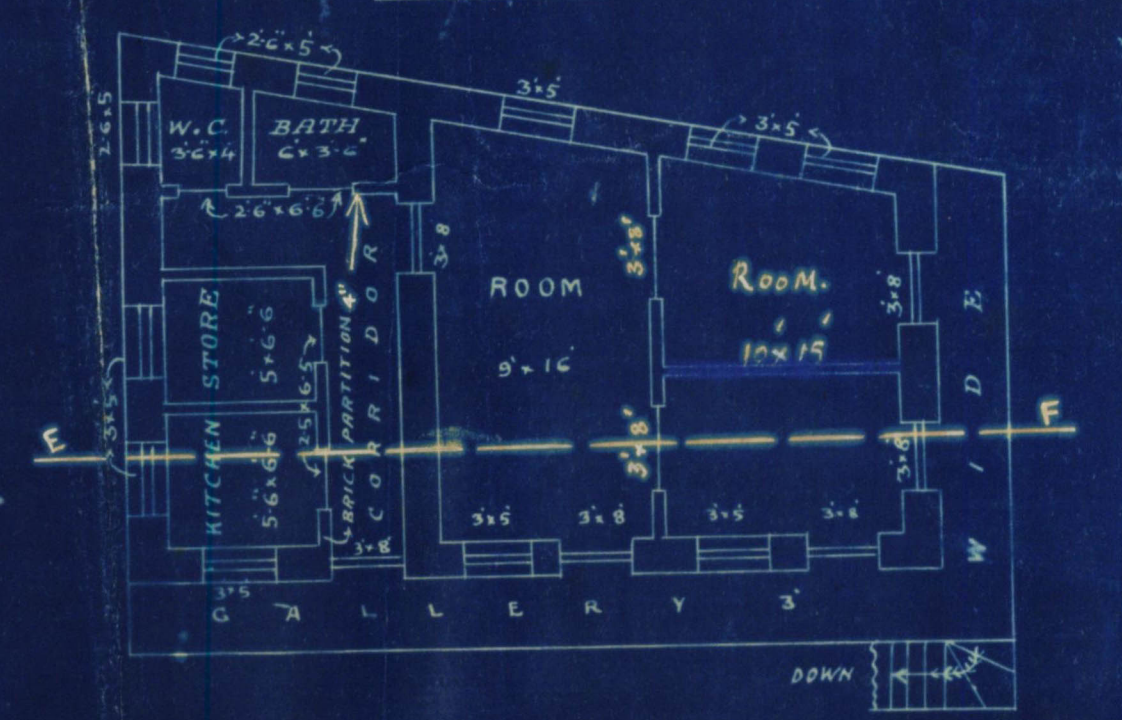

GROUND FLOOR

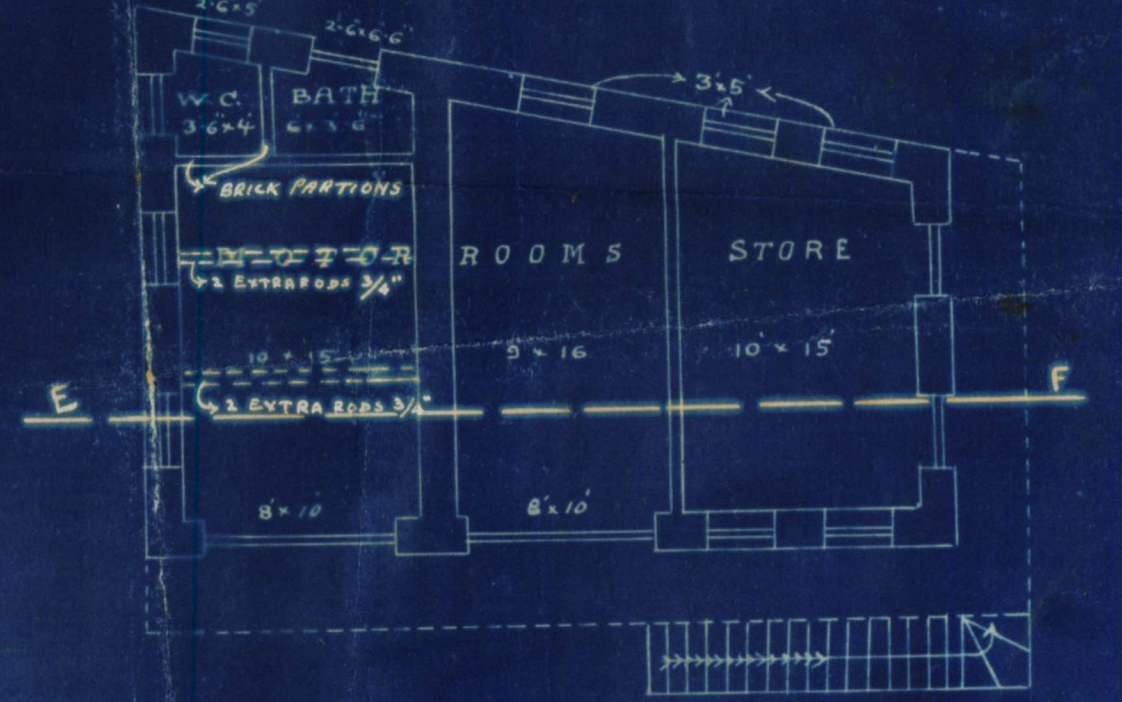

T. C. Butani  
OWNER

Hassanig H. Advani  
HASSASING H. ADVANI  
ARCHITECT & SURVEYOR  
BUNER ROAD, KARACHI.