



Shoy Mohib & Co.
 GENERAL CONTRACTORS
 Merchants & Commission Agents
 AND

TOWN COLLECTOR
 OF

ORMARA.

Address:—"QUARRY"

CODES USED

5th Edition & Private

KHARADUR,

Karachi, 19-11-19

19

The Acting Chief Officer & Chief Engineer
 Karachi Municipality

Sir,

Karachi

I beg to send herewith the amended
 Plan of my Plot No. 86 and 86 A 12 Muchi Meani gr.
 according to your instructions personally given to me.

I shall thank you to kindly grant me
 permission for building the same at your earliest
 convenience.

I beg to remain
 Sir,

Your most obedient servant

Shaban Mohib & Co.

P.S. see ops
 with off/c. 1.8/12/19



1-2

1. ...

where the plan
Nathl

$$\frac{3}{11}$$

9/10 in building file 1913

Ship no 112.

Mr. ...
this has been ...
satisfaction of the ...
please see him & get the
matter settled on me.

Nathl

$$\frac{13}{12.7}$$

200-14-8-17.

Form No. 1.

Karachi, 12th November 1917.

NOTICE UNDER SECTION 96 OF ACT III OF 1901.

To

THE CHIEF OFFICER AND CHIEF ENGINEER,

KARACHI MUNICIPALITY.

SIR,

I beg to inform you that I intend building Bed room on

10th floor on plot No. 36 & 56

Survey Sheet No. A-12 situate in new

Street, Machi Miani Quarter.

As required by the rules of the Municipality, I beg to submit herewith a plan of the same for your approval.

I beg to remain,

Sir,

Your most obedient servant,

Address:—

Signature of the applicant.

No. G. of 191

MUNICIPAL CHIEF OFFICER AND

CHIEF ENGINEER'S OFFICE,

Karachi, 191

Forwarded to the Municipal Engineer for favour of disposal.

M.INST.C.E.,

Chief Officer and Chief Engineer;

Karachi Municipality.

3078
20/11/17
Mr. Lail
Shaw 15/11/17
19/11/17



No. E.

of 191

MUNICIPAL ENGINEER'S OFFICE,

Karachi,

1915

Nov.

191

FICE,

MEMO.

191

The above application is forwarded to the Municipal Health Officer
favour of report.

Sanivaldshurys

A.M.I.C.E.,

Engineer,

Karachi Municipality.

MUNICIPAL HEALTH OFFICER'S REPORT.

Returned to the Engineer, Karachi Municipality, with the following
remarks:—

*No objection**Adams*

D.P.H. (London),

Health Officer,

Karachi Municipality.

Date 23-11-1917

No. E.

of 191

MUNICIPAL ENGINEER'S OFFICE,

Date

23rd

November

1917.

Forwarded to the Building Surveyor for report.

Walton

A.M.I.C.E.,

Engineer,

Karachi Municipality.

Through

THE LAND SURVEYOR,

Karachi Municipality.

3

BUILDING SURVEYOR'S REPORT.

Applicant's name Shahbaz Mobin
Whether he is the owner of the plot on which it is proposed to build yes / one of the
Plot under whose control Government
Whether it is permanent or temporary Permanent
The work proposed Build a room on top floor

Building Surveyor's report

Sir,
I regret that the plot are not
sanctioned. Permission to build has
refused once. I C is here with
all the ches. The applicant can get the
seen personally. Yours & Obedient
S. M. Shahbaz

Date 28/11 1917.

Building Surveyor.

Submitted through the Land Surveyor.

LAND SURVEYOR'S REPORT.

Does the plot come under Alignment no

Area of plot

Area under Alignment

Remarks The plan is in complete the formation
of the present existing boundary must be shown
The chief officer has once refused permission
and is now bound to the work. Request you
order.

Date 5-12- 1917.

Land Surveyor.

ORDERS OF THE ENGINEER.

The existing walls on the first & 2nd floor are
kutcha & a third floor cannot be allowed
to be constructed over them. The proposed
room will block the light & air from the
existing open well.

A.M. INST. C.E.,

Engineer,

Karachi Municipality.



237

2-4

4

No. E. of 191

MUNICIPAL ENGINEER'S OFFICE,

Karachi, 191

Submitted to the Managing Committee with a recommendation that
the plan be approved.

A.M.I.C.E.,

Engineer,

Karachi Municipality.

Through

THE CHIEF OFFICER & CHIEF ENGINEER,

KARACHI MUNICIPALITY.

RESOLUTION OF THE MANAGING COMMITTEE.


Resolution No. dated

PLAN OF TOP FLOOR PROPOSED TO BE

BUILT ON PLOT NO. 36 & 56, A-1

MUCHI MIANEE Q.R.


SCALE 8=1"

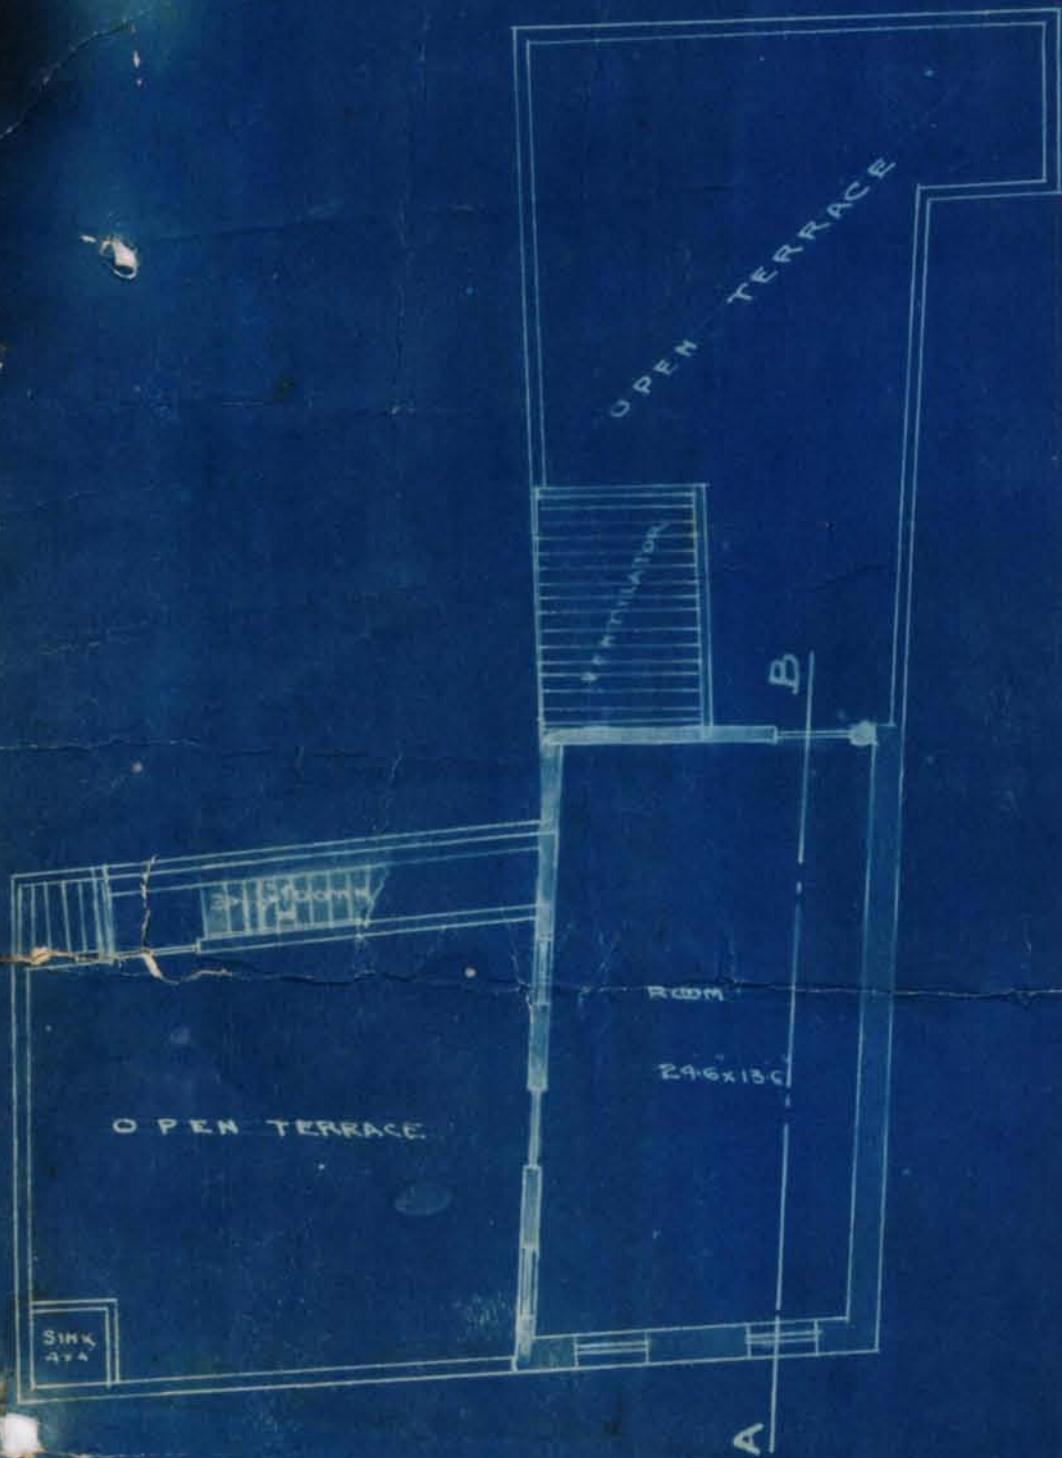

TOP FLOOR PLAN



FRONT ELEVATION OF TOP FLOOR

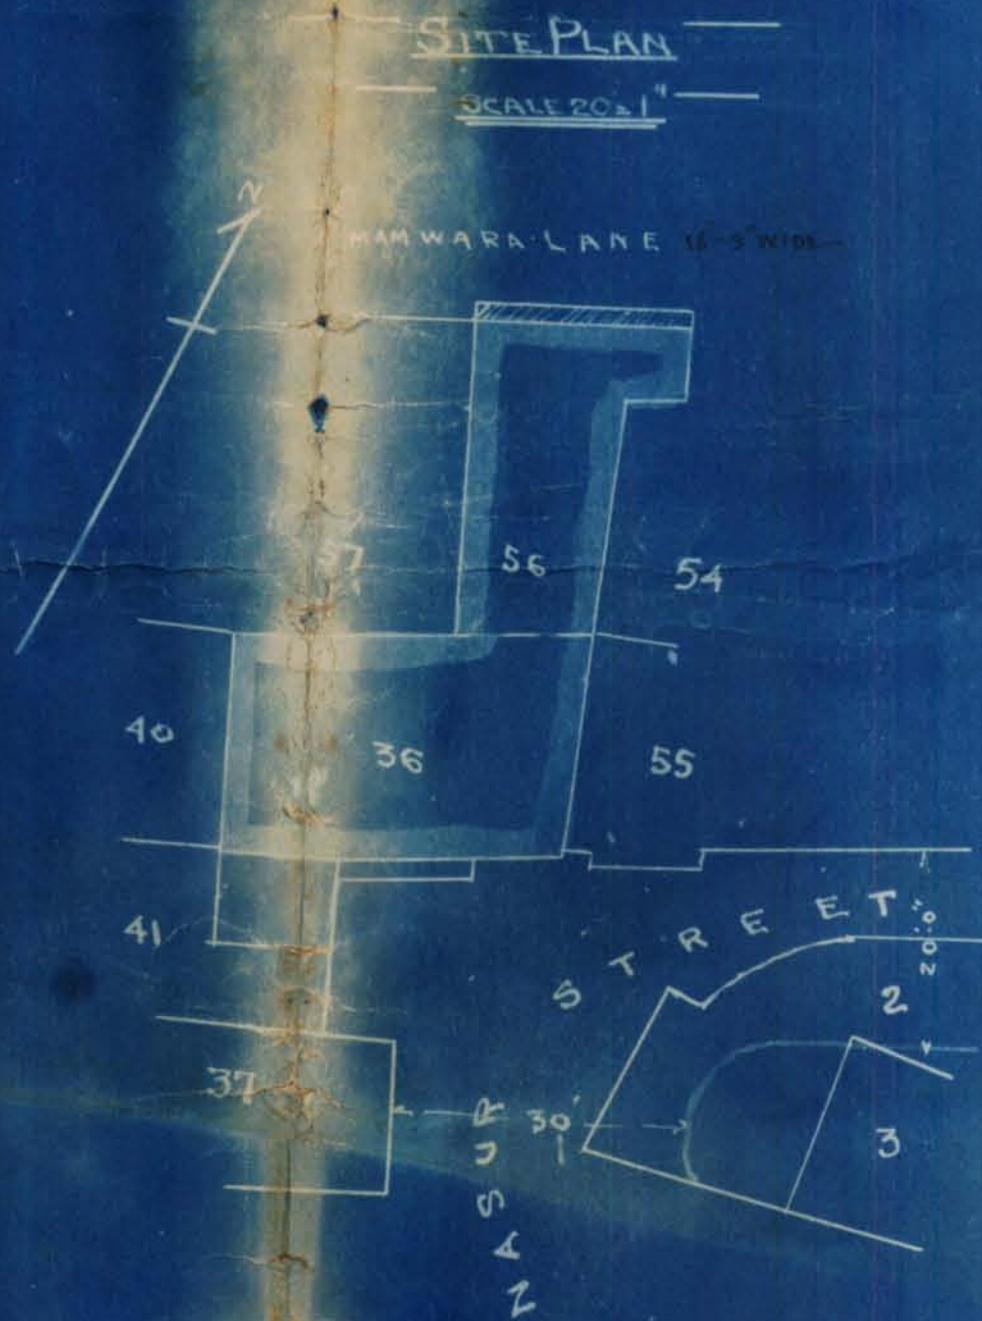

SITE PLAN

SCALE 20=1"



SECTION ON A.B.

Architects & Surveyors
P. K. Pathak & Co.
ARCHITECTS & SUR-
VEYORS.
10 NOV 1917

No. E 11091 of 1917.

Municipal Office.

Karachi. 13th December 1917.

MEMO / -

With reference to his application dated 12th received on 19th November 1917 with plans for plot No. 36 & 56, A-12 Machi Meani Quarter Mr: Shahban Mohib is informed that the existing walls on the first and 2nd floor are katcha and a third floor can not be allowed to be constructed over them proposed room will block the light and air from the existing open wall. The plans are herewith returned for ~~amendment~~ ^{disapproved}.


A. H. Inst. C. E.,

E n g i n e e r

Karachi Municipality.

M2

Sub
This may be filed

20/11/20

Rear