



Heritage

KMR.CDD.GaQ.1920-1921.03

Building Completion Report.

MUNICIPAL OFFICE,

Karachi, 8th April 1921.

To

THE ENGINEER,

KARACHI MUNICIPALITY.

SIR,

I beg to report, the building work on plot No. 5/2 Sheet I 12
Garden Quarter owned by Mr. Salzali Rangwani
is completed according to the plan approved by the Municipality. Orders are
requested to file the correspondence.

Copy to the Assessor & Collector
for information
J. J. J. J.

M. C. E., M. I. C. E.,

Engineer,

Karachi Municipality

Yours obediently,

Lawrence

Building Surveyor "A" Section,

Karachi Municipality.

Form No. 6-300-25.9.20.

No. L. S. 8134 OF 1921.

MUNICIPAL OFFICE,


Karachi, 22
26 1921.

MEMO:


Building Surveyor Section A is informed
that Mr. Lakazali Ramzanali has been permitted
to build out houses
_____ his house
on plot No. 5/2 - 12 Street
Garden Quarter report should be made to the
Undersigned when the house is completed.

M. C. A. M. I. C. E.
M. I. MECH. E.
Engineer,
Ag. Engineer,
Karachi Municipality.


DRAWING No 31

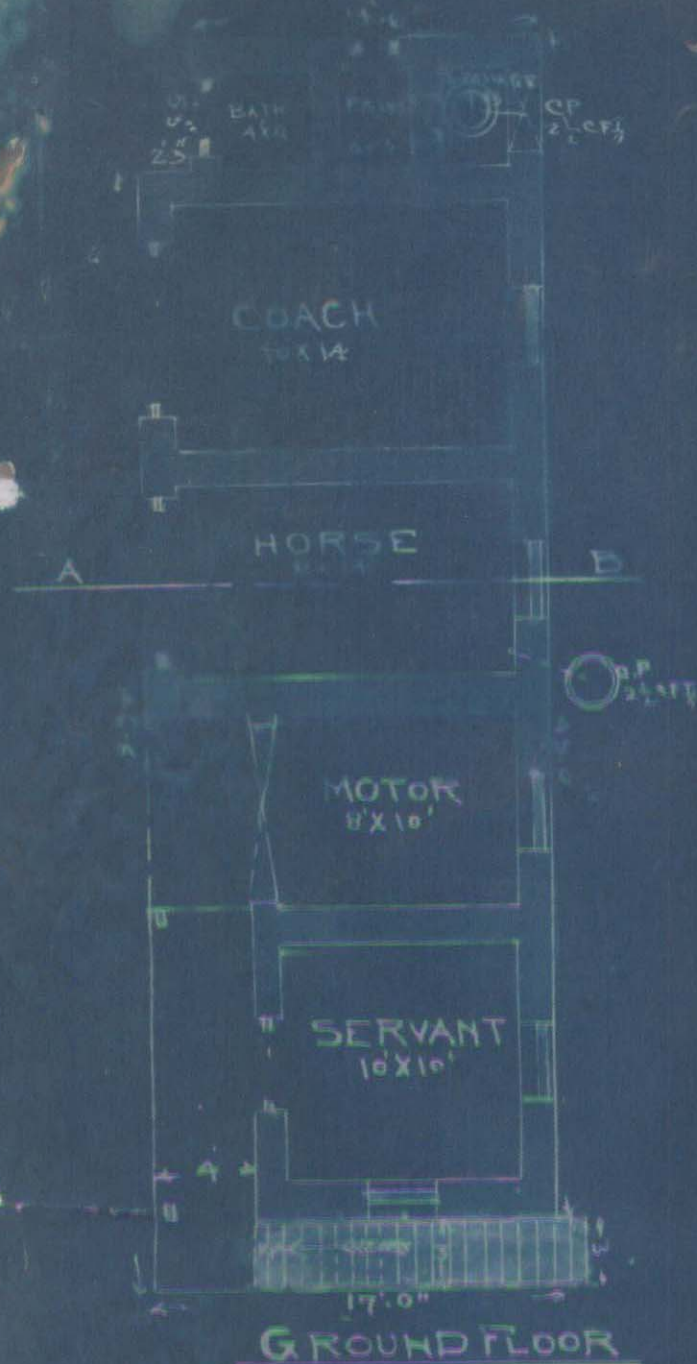

GROUND FLOOR

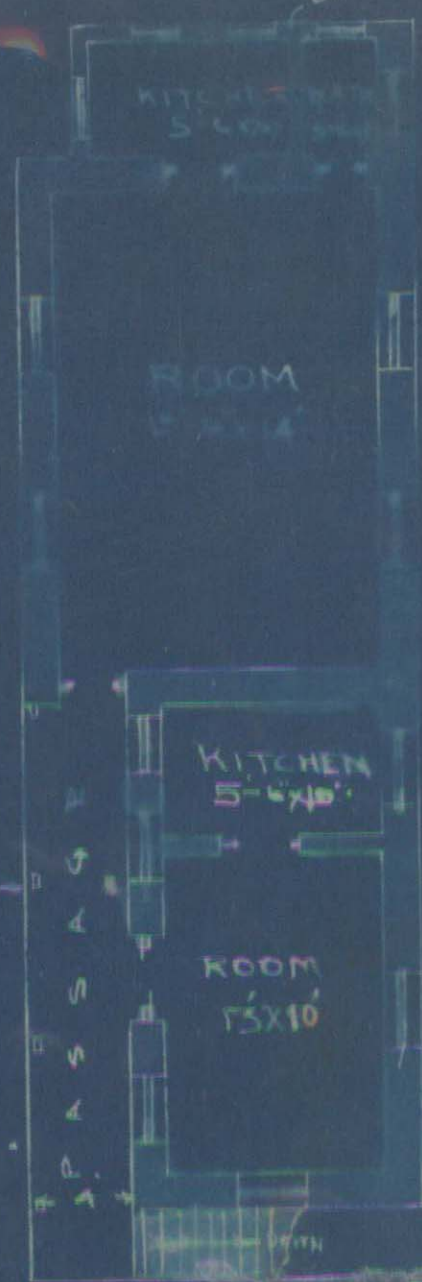

FIRST FLOOR PLAN

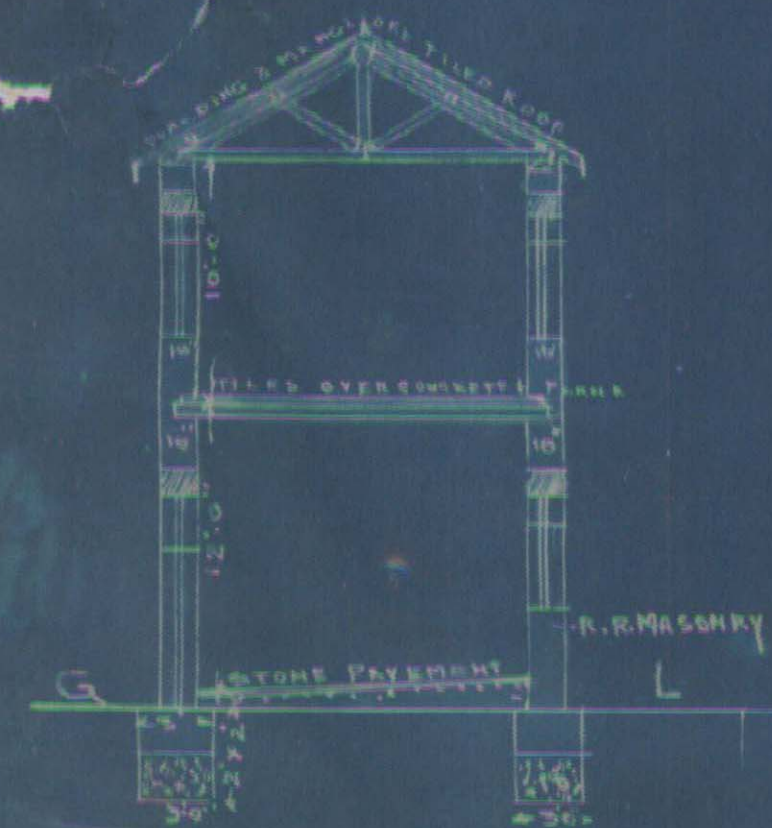

SECTION ON A.B

AMENDED PLAN FOR OUT HOUSES ON SURVEY No 5 SHEET I-12 GARDEN Q5 SCALE 8-1"

NOTE

TOTAL AREA OF PLOT 1925 SQ. YDS.

BUILDING AREA 3715 SQ. YDS.

14.5
ARCHITECTS & SURVEYORS (1920)

BLOCK PLAN SCALE 20-1"


5/4

Z


ROAD 50-0 WIDE




ROAD 30-0 WIDE

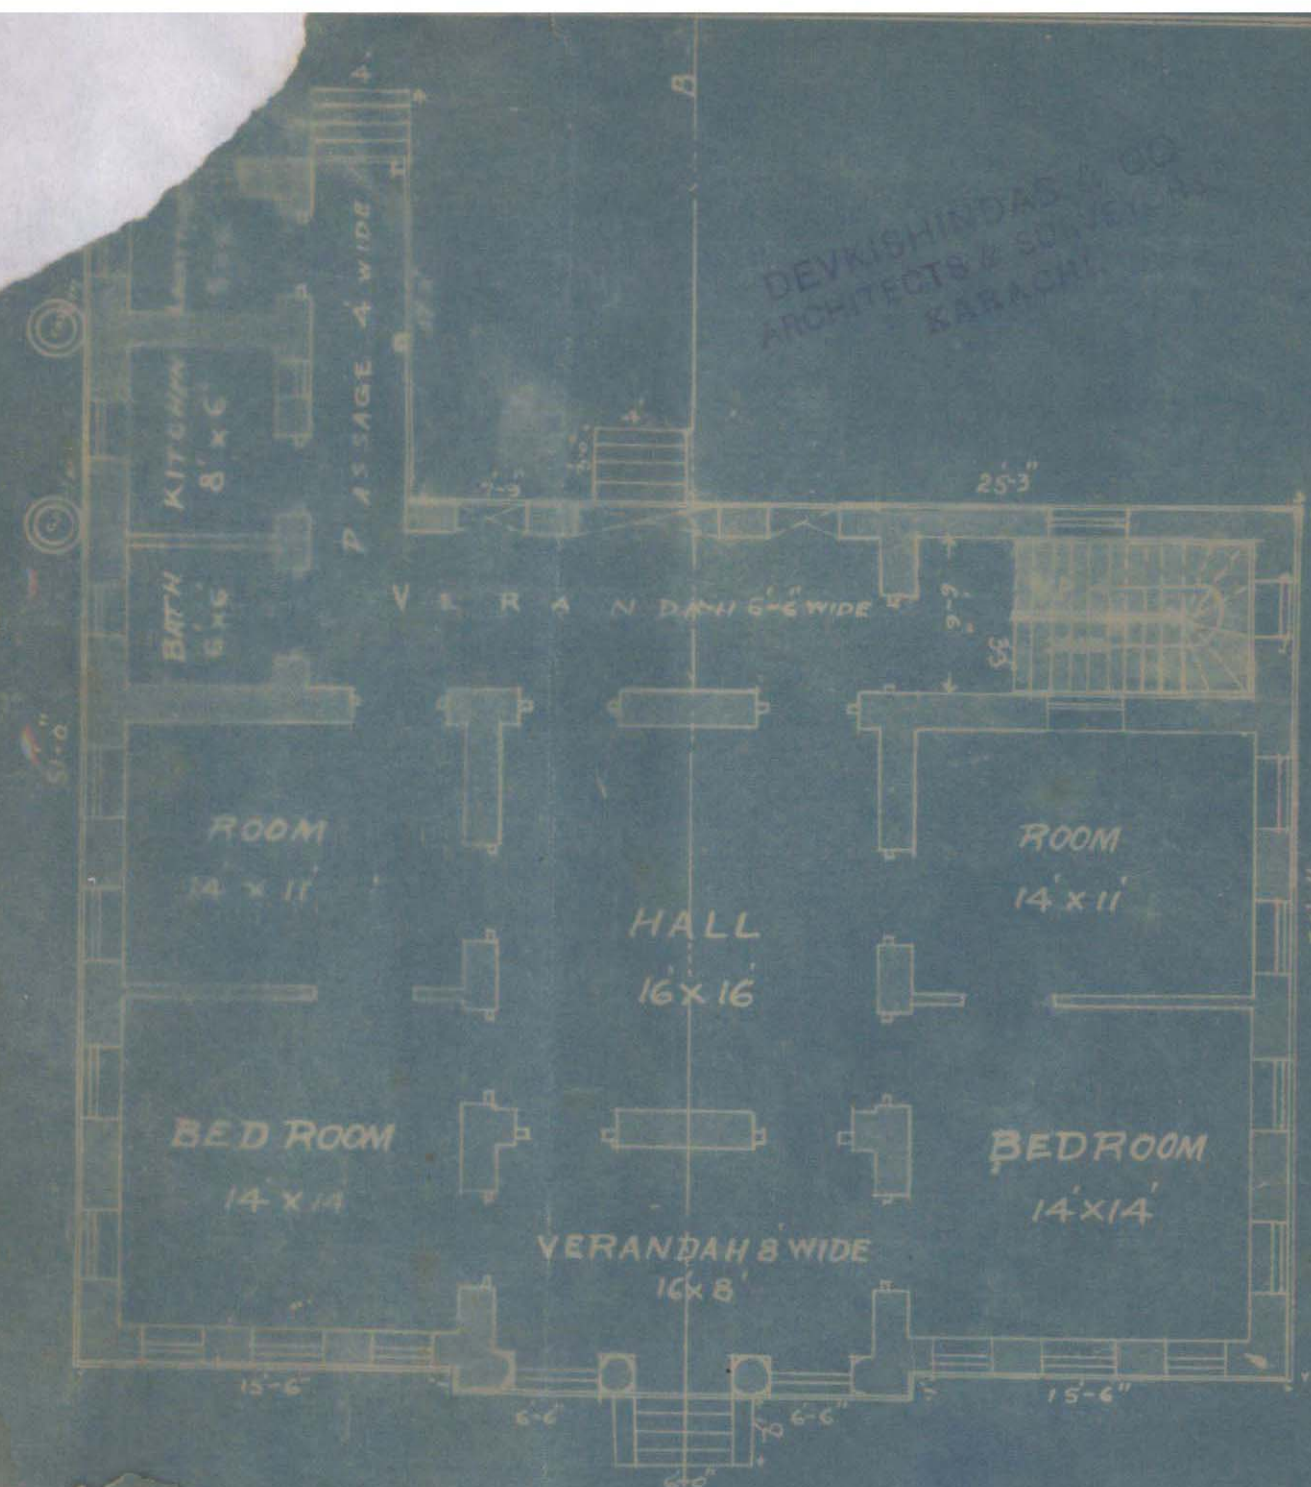

GROUND PLAN

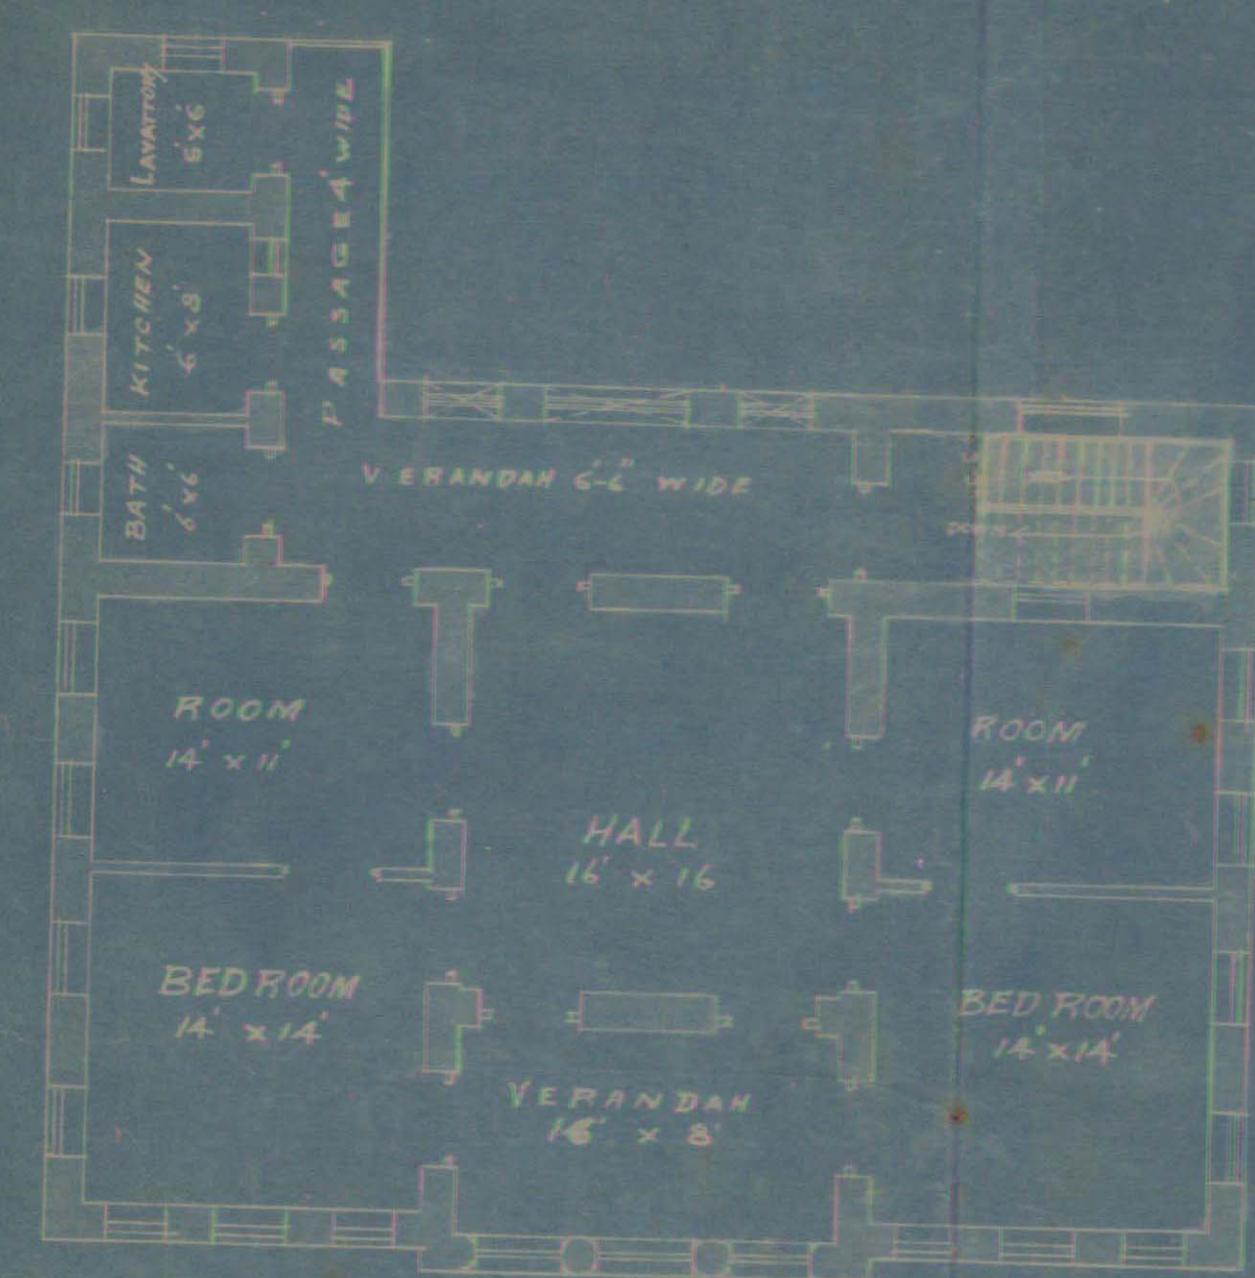


1ST FLOOR PLAN

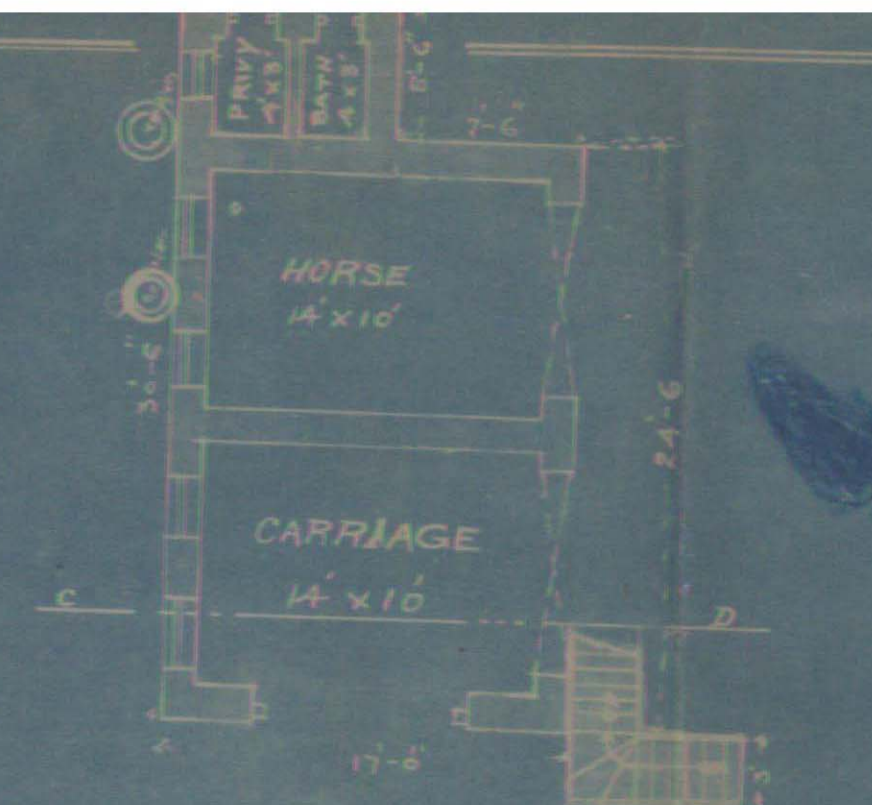

OUTHOUSES GROUND PLAN



1ST FLOOR PLAN

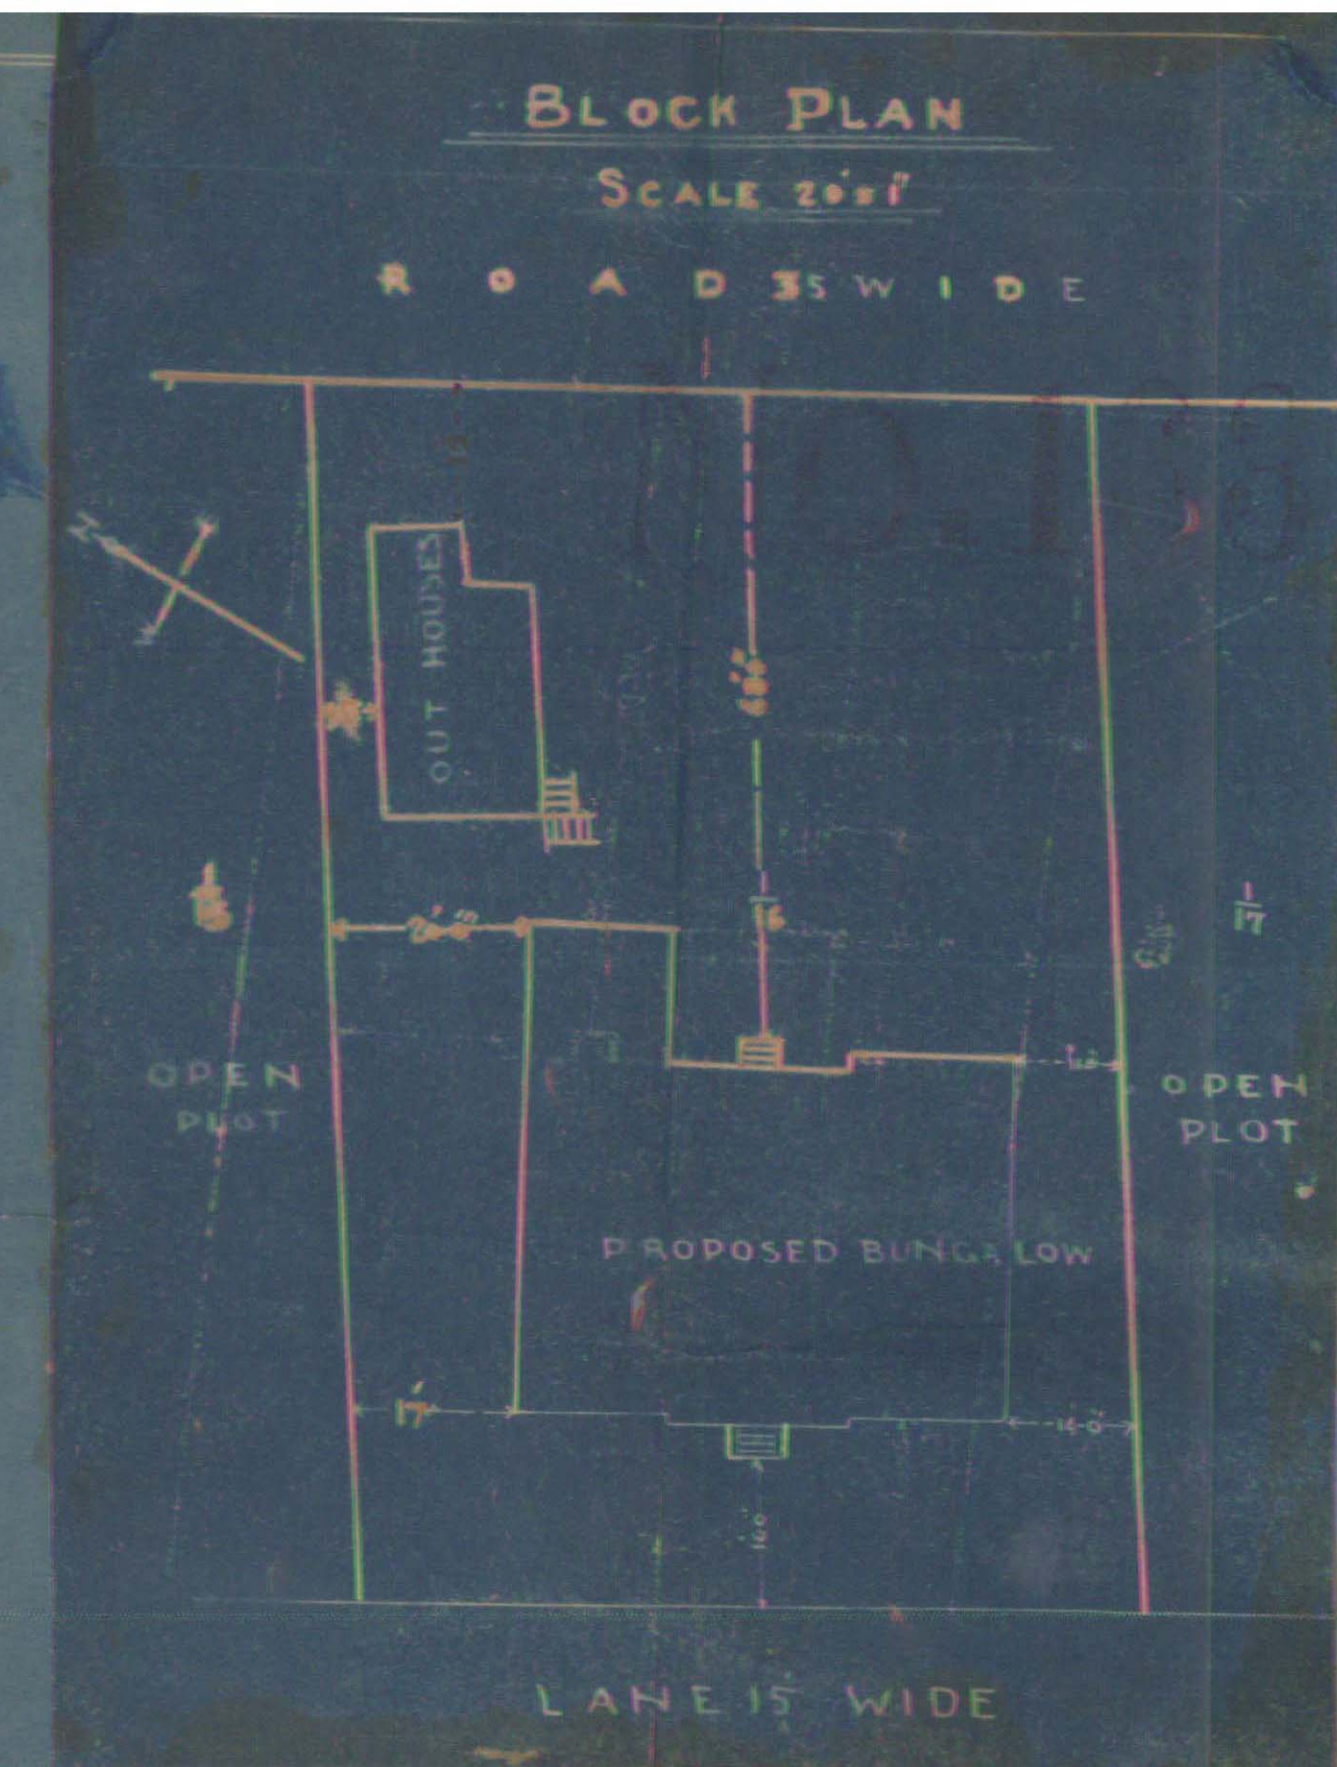

BLOCK PLAN

SCALE 20' = 1"

ROAD 35' WIDE

LANE 15' WIDE


APPROVED
M. I. M. E.
Acting Engineer
Karachi Municipality

GARDEN QUARTER
PLAN OF PROPOSED
BUILDING TO BE BUILT ON
PLOT NO 16 SHEET 1-2.
SCALE 8" = 1' INCH


NOTE:
AREA OF PLOT 1177.52 SQ. FT.
ALLOWABLE AREA 234.5 SQ. FT.
AREA OF BUNGALOW 234.5 SQ. FT.
AREA OF OUTHOUSES 11.5 SQ. FT.
TOTAL OF BUILDING AREA 246.0 SQ. FT.



FRONT ELEVATION

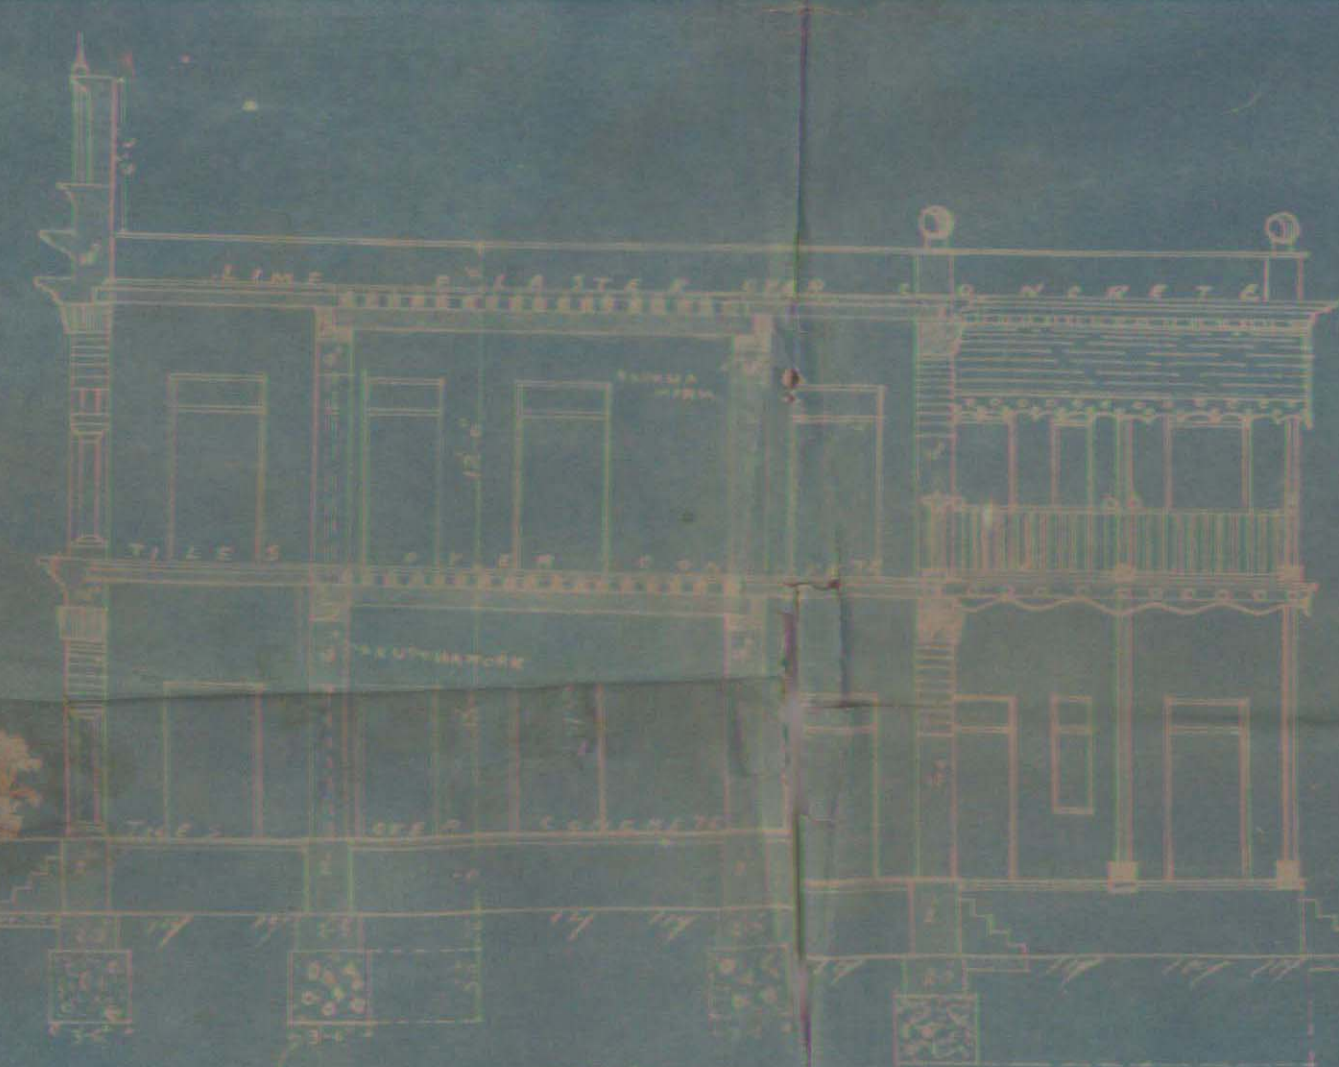

SECTION ON A.B.

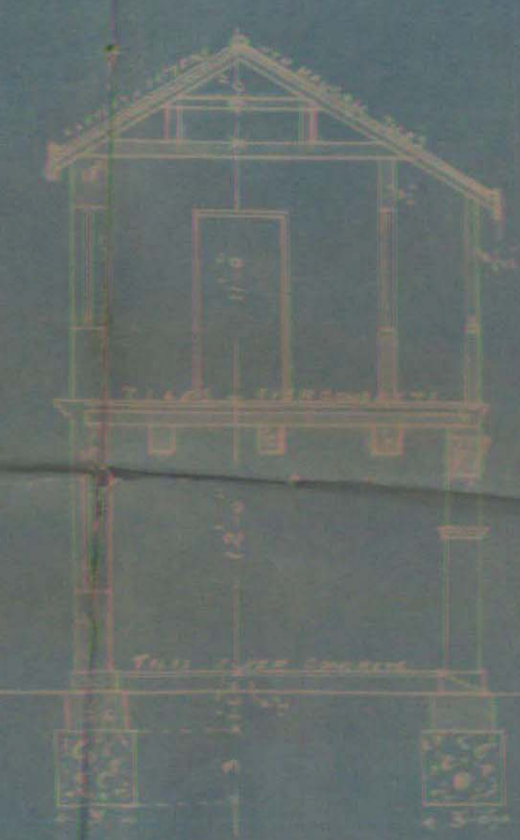



SECTION ON C.D.

D. A. S. M. S. S.
DEVKISHENDAS & CO.
ARCHITECTS & SURVEYORS
NEAR KHORIGARDEN
KARACHI CITY



DRAWING No 51

*Amended Plan Of Out-Houses Of Bungalow
Under Construction On SN^o 46 Sheet L-2
Garden Quarter
— Scale 8 to an Inch*

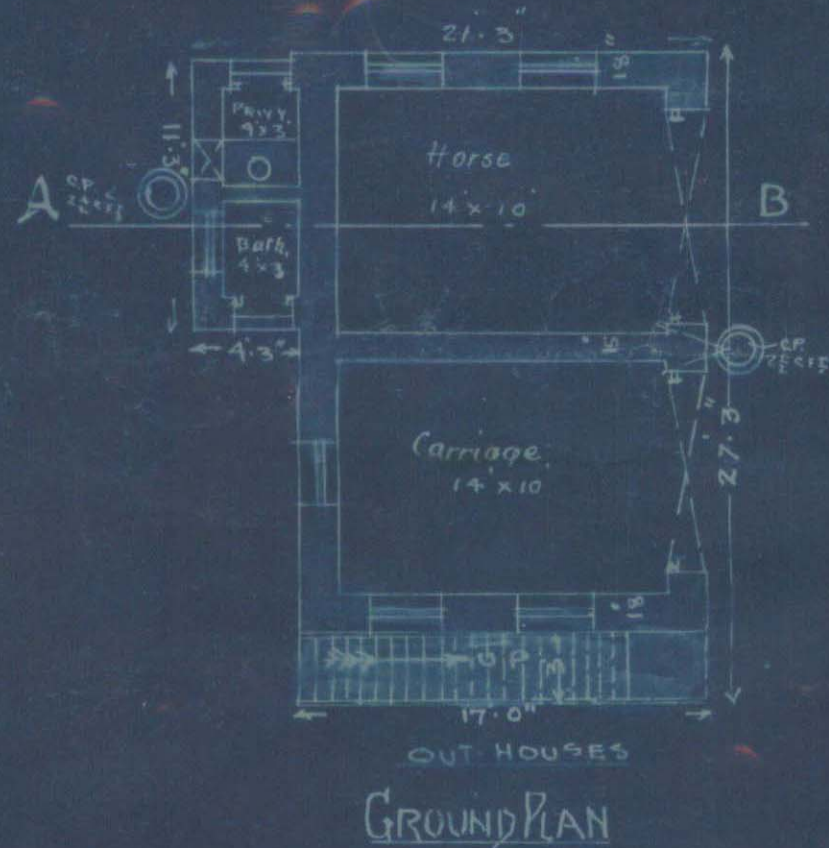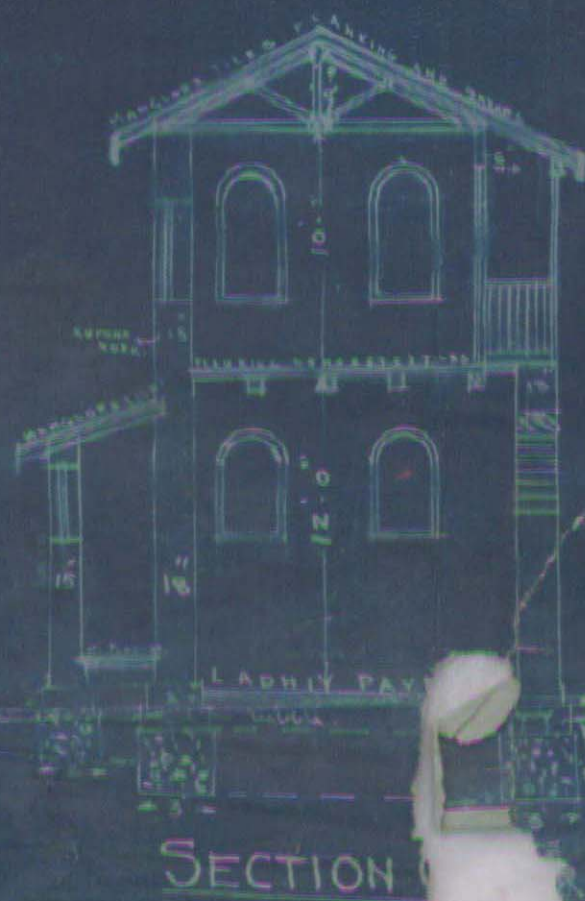


APPROVED 21/20/21

Handwritten signature
L.E. Tulshidas Tejwani

BLOCK PLAN
SCALE 20 = 1"

R O A D 35'0" W I D E

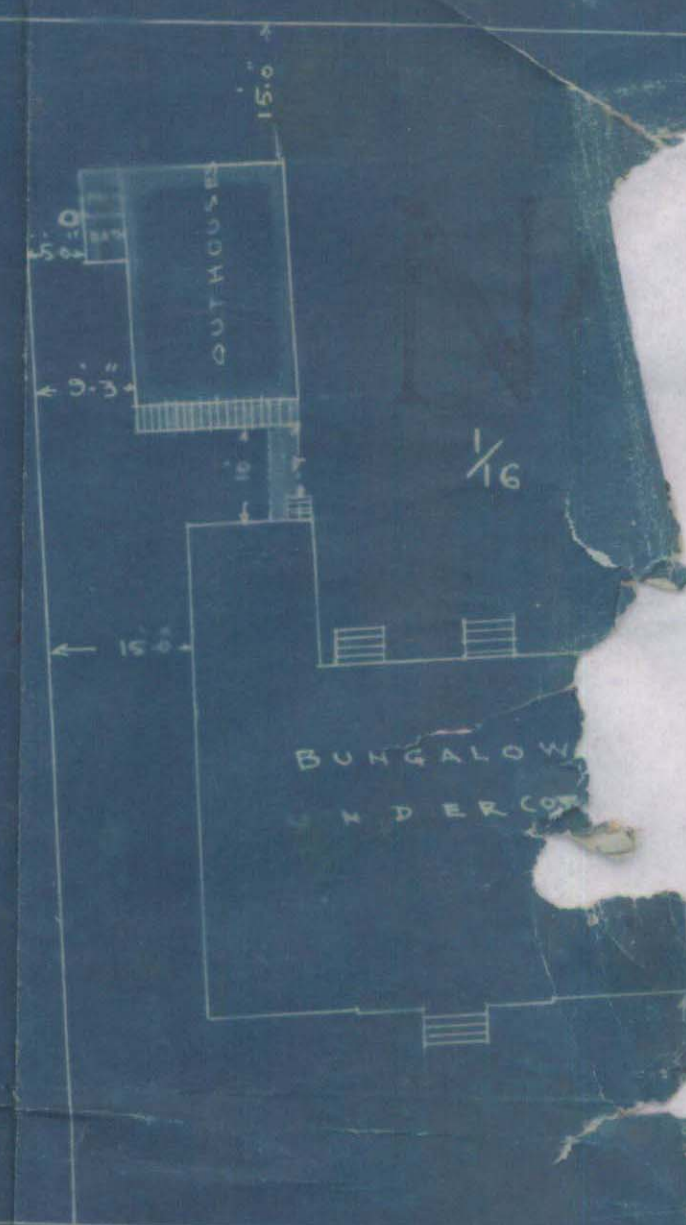

L A N E 15.0'

Note

Area of Plot	1177 SQ YD
Allowable building Area	294 SQ YD
Area of bungalow	232.50 SQ YD
Area of out Houses	57
Total	289.50 SQ YD

Handwritten signature
ARCHITECTS