



No. L.S. 1247 of 1918.

Municipal Office,
Karachi, 19th August 1918.

M E M O /-

With reference to his application dated 29th July 1918 with plans of the proposed rooms and shed to be erected on plot No. 5.K-3 Lyari Quarter Mr. Ladha Khimji is informed that there is no road to the North of the plot, it is Municipal saleable land. The area marked thus must be kept open to sky and a window provided as shown in the room on the South West of the plot.

The plans are herewith returned for amendment.

Laurel H. Kerley

A. M. Inst., C. E.,

E n g i n e e r

Karachi Municipality.

86

See

This may be filed

24/11/20 H. C. C.



200-14-2-18.

Form No. 1.

Karachi, 19th July 1918.

NOTICE UNDER SECTION 96 OF ACT III OF 1901.

To

THE CHIEF OFFICER AND CHIEF ENGINEER,

KARACHI MUNICIPALITY.

SIR,

I beg to inform you that I intend building rooms & shedfor bullocks on plot No. 5Survey Sheet No. K-3 situate in _____Street, Gyare Quarter.

As required by the rules of the Municipality, I beg to submit herewith a
plan of the same for your approval.

I beg to remain,

Sir,

Your most obedient servant,

Address:—

C/o Gulam husain
Kasimie. Zaidha Khimje
Signature of the applicant.No. G. 12714 of 1918.

MUNICIPAL CHIEF OFFICER AND

CHIEF ENGINEER'S OFFICE,

Karachi, 29th July 1918.

Forwarded to the Municipal Engineer for favour of disposal.

Jemanaudh

M.INST.C.E.,

Chief Officer and Chief Engineer,

Karachi Municipality.

R1820
in slip sent to
8
3/8

2-2
No. E ² 5983 of 1918.

MUNICIPAL ENGINEER'S OFFICE,

Karachi, 2/8 1918.

Memo.

The above application is forwarded to the Municipal Health Officer for
favour of report.

Harunch and

A.M.I.C.E.,

For Engineer,

Karachi Municipality.

MUNICIPAL HEALTH OFFICER'S REPORT.

Returned to the Engineer, Karachi Municipality, with the following
remarks:—

If there is a road to the north
of the plot, very the rooms are not
provided with windows for in them all
facing this road & here the windows
are provided in rooms which are built
on the very narrow plot.

D. P. H. (London)

D.P.H. (London),

Health Officer,

Karachi Municipality.

Date 6-8-1918.

No. E ² 5983 of 1918.

MUNICIPAL ENGINEER'S OFFICE,

Karachi, 6.8 1918.

Forwarded to the Building Surveyor for report.

Harunch and

A.M.I.C.E.,

For Engineer,

Karachi Municipality.

Through

THE LAND SURVEYOR,

Karachi Municipality.



3

2-3

BUILDING SURVEYOR'S REPORT.

Applicant's name Ladha Khunji
 Whether he is the owner of the plot on which it is proposed to build Ys
 Plot under whose control Cervs
 Whether it is permanent or temporary Permanent
 The work proposed Build rooms shed

Building Surveyor's report Sir,

They request that the space ^{7-0 inch} between the two rooms
on north side should be kept open to keep
the rooms airy + in light - Requested

Date 6/8/1918

Y. D. V. S. Khan
 Building Surveyor.

Submitted through the Land Surveyor.

LAND SURVEYOR'S REPORT.

Does the plot come under Alignment No

Area of plot —

Area under Alignment —

Remarks Sir, With reference to this I have before that
there seems no objection provided the rooms
towards north & south take kept open to sky
then there seems no objection
Y. D. V. S. Khan

Date 15/11/1918

Land Surveyor.

ORDER OF THE ENGINEER.

There is no road to the north of the plot it is
high valuable land. The area marked there
must be kept open to sky & a window
provided as shown in the room of the
South West of the plot

11/11/18

M. INST. C. E.,

Engineer,

Karachi Municipality.



Heritage

KMR.CDD.LyQ.1918.03

2-4

4

No. E.

of 191 .

MUNICIPAL ENGINEER'S OFFICE,

Karachi, _____ 191 .

Submitted to the Managing Committee for information.

A.M.I.C.E.,

Engineer,

Karachi Municipality.

Through

THE CHIEF OFFICER & CHIEF ENGINEER,

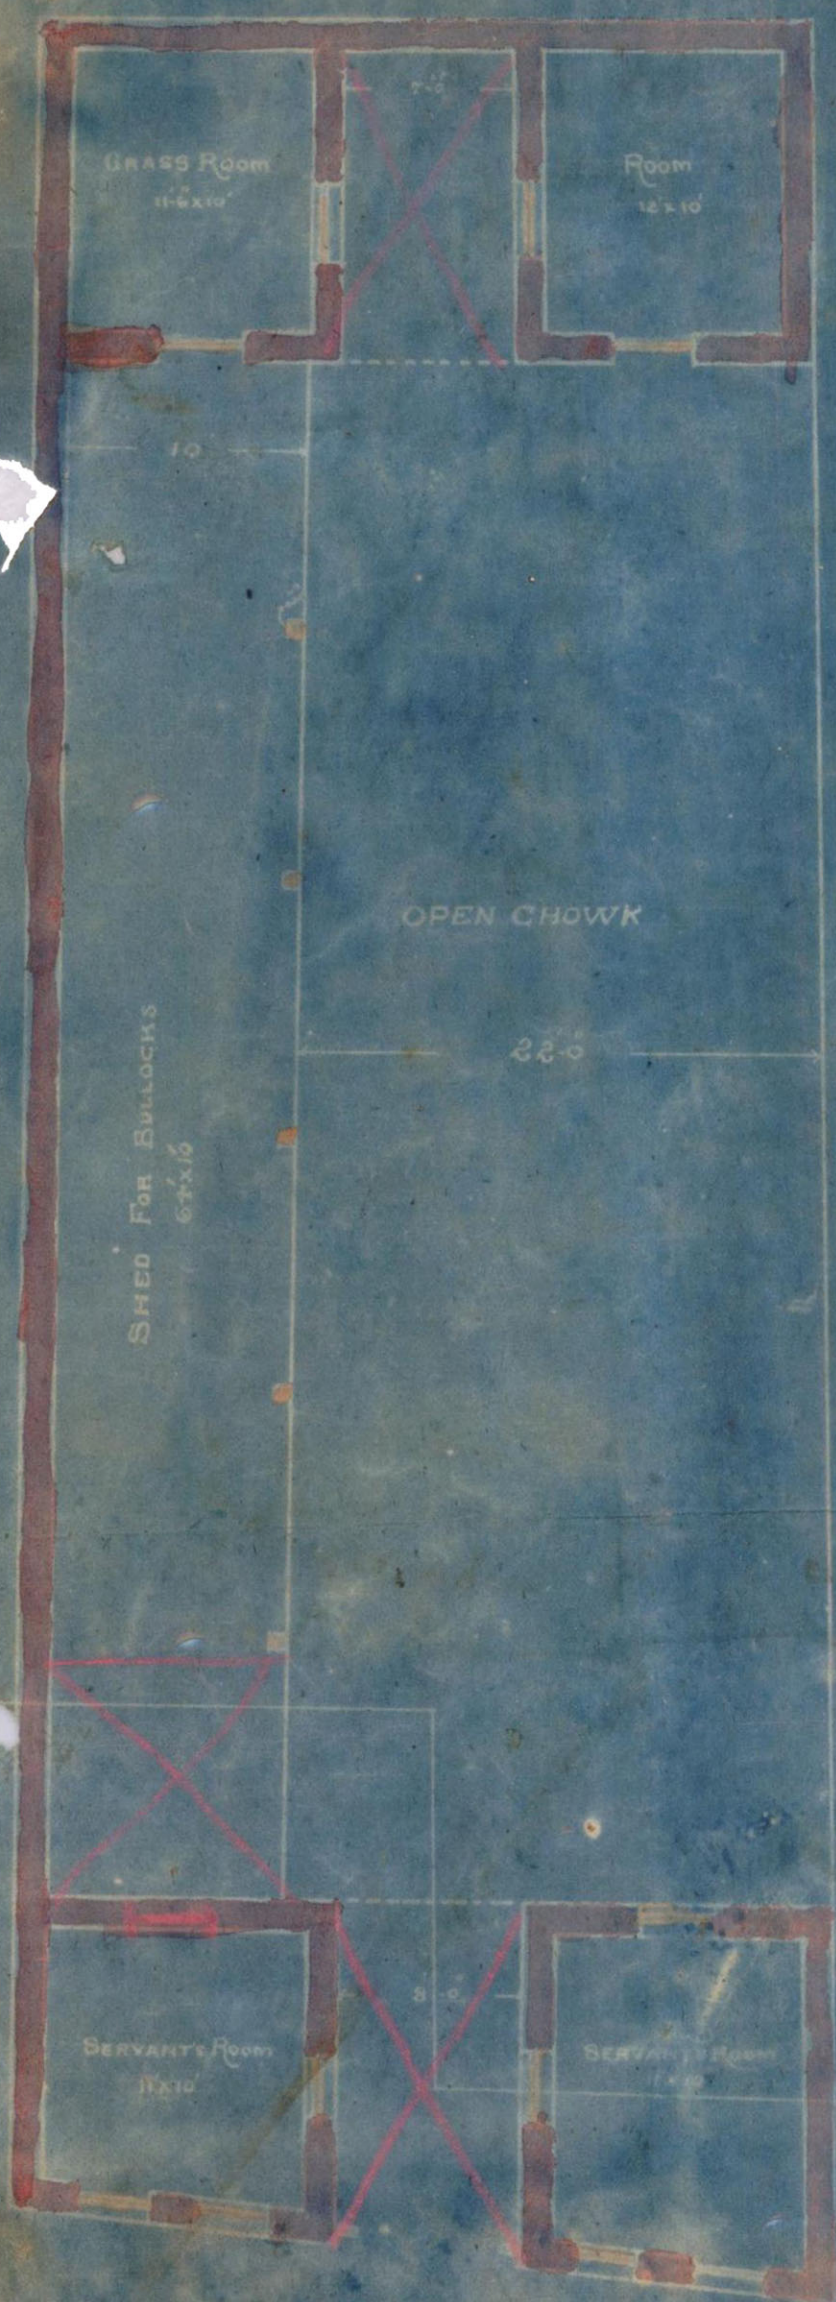
KARACHI MUNICIPALITY.

RESOLUTION OF THE MANAGING COMMITTEE.

Resolution No. _____ dated _____

31

Plan showing proposed shed to be built
on Plot No 5 Sheet No 3 Lyarce Quarter
Scale 5-1

**Block Plan**

SCALE 40 FEET TO AN INCH

GROUND PLAN**FRONT ELEVATION**