



Heritage
FOUNDATION

KMR.CDD.LyQ.1918.04

200-12-7-18,
Form No. 3.

No. L. S. 525 of 1919

MUNICIPAL OFFICE,

Karachi, 28th January 1919
300

MEMO.

With reference to his application, dated 24th inst Mr. Granda Naugomal is
Messrs. 46 B5 Lyari are
informed that plot No. 46 B5 Lyari quarter,
does not stand in the Land Register in his name. He is therefore
their They are
requested to produce any documentary evidence to prove his ownership,
their
when his request for a pass will be considered.
their

Red Survey is
It is impossible to tell where
the plot is from the plan.
No names are given to the streets
The width of the street marked in all corners
he checked & marked on the plan.
V. 30/1/19

Robert H. Kerley

A. M. INST C. E.,
Engineer,
Karachi Municipality.



Heritage

KMR.CDD.LyQ.1918.04

1-2

Form No. 2

MUNICIPAL OFFICE

Certified that the document
was produced today for
proving his ownership.

MEMO

With application dated 2/1/1918

presented

He is the owner

of the land

Robert Kelly

Attest
Engineer
Kanchi Municipality



200-30-9-18.

From No. 1.

Karachi, 24th January 1918.

NOTICE UNDER SECTION 96 OF ACT III OF 1901.

To

THE CHIEF OFFICER AND CHIEF ENGINEER,

KARACHI MUNICIPALITY.

SIR,

I beg to inform you that I intend building Stables
on plot No. 46Survey Sheet No. K-5 situate in -Street, Hydrabad Quarter.As required by the rules of the Municipality, I beg to submit herewith a
plan of the same for your approval.

I beg to remain,

Sir,

Address:-

c/o
Rattan Lal

Your most obedient servant,

Jeewan Lal Negmal
Signature of the applicant.No. G. 873 of 1919.

MUNICIPAL CHIEF OFFICER AND

CHIEF ENGINEER'S OFFICE,

Karachi, 24th January 1919.

Forwarded to the Municipal Engineer for favour of disposal.

43749 Jeewan Lal
M.INST.C.E.,
Chief Officer and Chief Engineer,
Karachi Municipality.Mr. S. L. S. S. S.
24th Jan 1919

No. E 443 of 1919.

MUNICIPAL ENGINEER'S OFFICE,

Karachi, 24th January 1919.

Memo.

The above application is forwarded to the Municipal Health Officer for
favour of report.

A.M.I.C.E.,

Engineer,

Karachi Municipality.

MUNICIPAL HEALTH OFFICER'S REPORT.

Returned to the Engineer, Karachi Municipality, with the following
remarks:—

No objection

D.P.H. (London),

Health Officer,

Karachi Municipality.

Date 27-1-1919.No. E 443 of 1919.

MUNICIPAL ENGINEER'S OFFICE,

Karachi, 27th January 1919

Forwarded to the Building Surveyor for report.

A.M.I.C.E.,

Engineer,

Karachi Municipality

Through

THE LAND SURVEYOR,
Karachi Municipality.

M. Varani please attend report



BUILDING SURVEYOR'S REPORT.

Applicant's name _____
 Whether he is the owner of the plot on which it is proposed to build _____
 Plot under whose control Government
 Whether it is permanent or temporary Permanence
 The work proposed To build Stables

Building Surveyor's Report Sir With reference to this letter
Seems no objection.

Date 28 Jan 1919.

Submitted through the Land Surveyor.

J. J. J. J. J.
 Building Surveyor.

LAND SURVEYOR'S REPORT.

Does the plot come under Alignment no

Area of plot _____

Area under Alignment _____

Remarks Sir, with reference to this I beg to say
that there seems no objection, provided a passage
should be increased to 8' feet. Against over

Date 29-1- 1918.

ORDER OF THE ENGINEER.

Nathall
 Land Surveyor.

The plan as submitted is marked stables
but is not designed for stables. If it is the
intention of the owner to keep horses & carts
he must have stables for the horses & coach
houses for the carts. The passage into the
Compound is too narrow, it should be 8'-0"
wide.

A.M. INST. C.E.,

Engineer,

Karachi Municipality.



Heritage

KMR.CDD.LyQ.1918.04

2-4

4

No. E. of 191

MUNICIPAL ENGINEER'S OFFICE,

Karachi, _____ 191

Submitted to the Managing Committee for information.

A.M.I.C.E.,

Engineer,

Karachi Municipality.

Through

THE CHIEF OFFICER & CHIEF ENGINEE,

Karachi Municipality.

RESOLUTION OF THE MANAGING COMMITTEE.

Resolution No. _____ dated _____

3

Municipal Office
Karachi. 3/2/19

Memo.

With reference to his application of 24th ultimo, with plan for the proposed stable on plot No. 46 K 5 Lyari Quater, Mr. J. Mangroon & is informed that the plan as submitted is marked Stables but is not designed for stables. If it is the intention of the owner to keep horses and for gharis, he must show stables for the horses and Coach house for the gharis.

The passage into the Compound is too narrow it should be 8'0" wide.

The plan is returned herewith for Amendment.

V.

M. J. Mangroon

Karachi

No. L.S. 601 of 1919.

Municipal office,

Karachi 4th February 1919.

MEMO,

With reference to his application dated 24th ultimo with plan for the proposed stables on plot No. 46, K-5 Lyari Quarter Mr. Jeramdas Mangoomal is informed that the plan as submitted is marked stables but is not designed for stables. If it is his intention to keep horses and gharrys, he must show stables for the horses and coach houses for the gharrys. The passage into the compound is too narrow, it should be 8'-0" wide.

The plan is returned herewith for amendment.

A. M. Inst. C. E.,

Engineer,


Karachi Municipality.

See
This may be filed


21/11/20
Dr
Rever

PLAN SHOWING
STABLES TO BE BUILT ON PLOT

SCALE 8 FEET

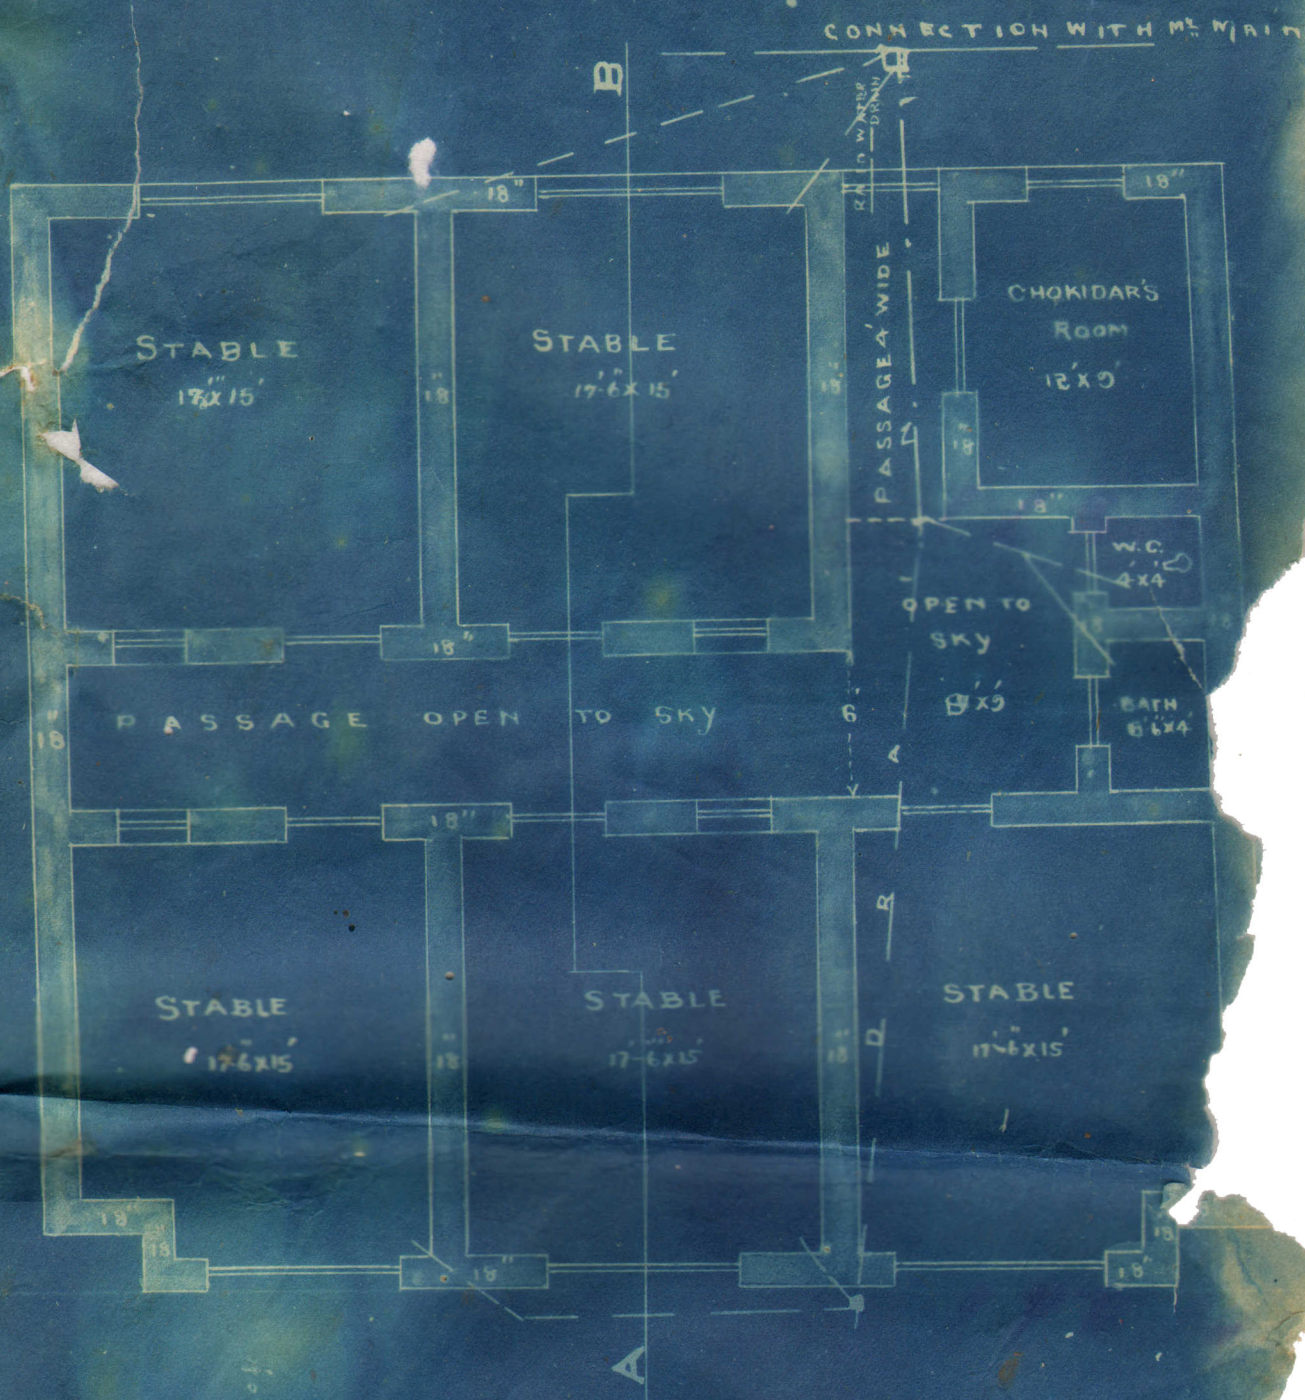

PLAN

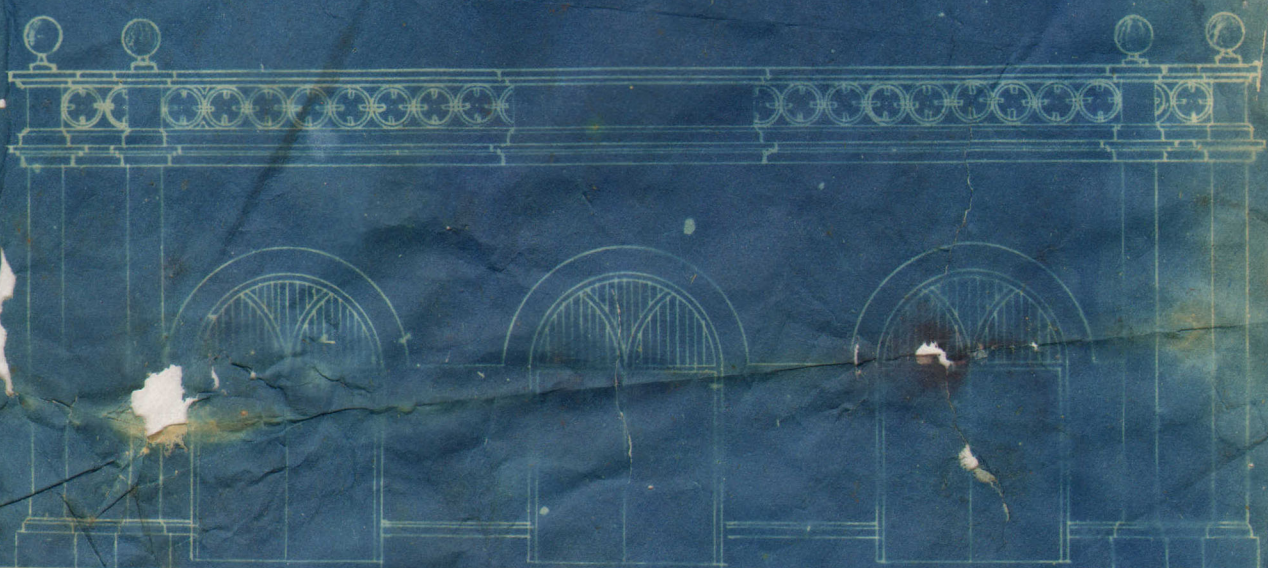

FRONT ELEVATION



Heritage
FOUNDATION

KMR.CDD.LyQ.1918.04

SITE PLAN

SCALE 20'-1"

ROAD 45' WIDE

SECTION IN PLAN

PLOT

NO.

47

12' IN
HEIGHT



SECTION ON A.B.

PATHAN & CO.

ARCHITECT & SURVEYOR

NEAR KMOORE GARDEN

KARACHEE 22 JANUARY 1918