



2000-12-38

FORM A.

NOTICE UNDER SECTION SCHEDULE VI CHAPTER XI RULE 2 (1)
OF THE CITY OF KARACHI MUNICIPAL ACT 1933.Karachi 24/5/40

Date of delivery at Municipal office

THE CHIEF OFFICER,

MUNICIPAL CORPORATION,

Dear Sir,

KARACHI.

Pursuant to the provision of Schedule VI, Chapter XI Rule 2 (1) of the City of Karachi Municipal Act 1933, I hereby given you notice that I intend within the meaning of that rule to erect or re-erect/make additions & alterations to building on plot No. 29, Survey 237/245 sheet m.m. 6 Situated in Maachhimand street Maachhimand Quarter

as per Ground plan, Elevation and Section sent herewith in quadruplicate.

The said building will be of following description.

It is intended for the purpose of _____

†Specification of the work will be as on the reverse.

I further beg to inform that the name of the licensed architect and or surveyor whom I have employed to prepare plans and to supervise the erection or re-erection of, additions and alterations to, the said building is Mr. R. G. Chawla

I hereby under take to abide by the City of Karachi Municipal Act 1933, and all rules and bye-laws framed pursuant to the Act.

Yours faithfully

Signature of the owner 24/5/40

Address of the owner _____

†See on the reverse



1-2

2

Nature of soil in foundation _____

Nature of masonry of foundation _____

do Plinth _____

do Superstructure _____

Kind of roof Rec 2nd renewed

Kind of Floor _____

Method of Draining Sullage Water _____

_____: 0: _____

NOTE—Specification and nature of work should be given against item of works mentioned above.

To,

The Chief Officer,

Karachi

Owner.

20/5/40

Municipal Corporation.

Sir,

Karachi.

With reference to the notice under Schedule VI, Chapter XI, Rule (2) I of the City of Karachi Municipal Act 1933, submitted to you along with the plans for erection or re-erection/additions and alterations on plot No. 29 sheet No. mmb by Mr./Messrs. Shree & Menaj who is/are registered owner/owners of the above plot for building. Renewal of work

I beg to inform you that I have prepared the plans and have agreed to supervise the erection or re-erection of/additions and alteration to, the building work mentioned therein.

I beg to remain,

Sir

Your most obedient servant,

Kh Chand

Licensed Architect and/or Surveyor.

PLAN SHOWING RENEWAL OF WOODEN ROOF INTO R.C.C. ROOF ON 3RD. FLOOR ON PLOT NO. 29.M.M.G.

MACHHI MIANI QR.

SCALE 8 FT.=1 INCH.


SITE PLAN

SCALE 40 FT.=1 INCH.


AREA : 219 1/2 SQ. YDS.
218 A

JAFFER FADOO ROAD (280)


STREET 20 FT.

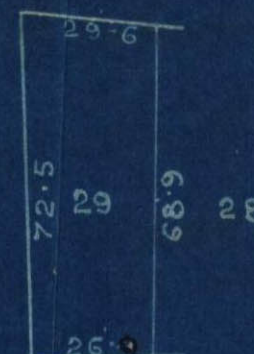

MUGHMIANI MARKET ROAD 35 FT.

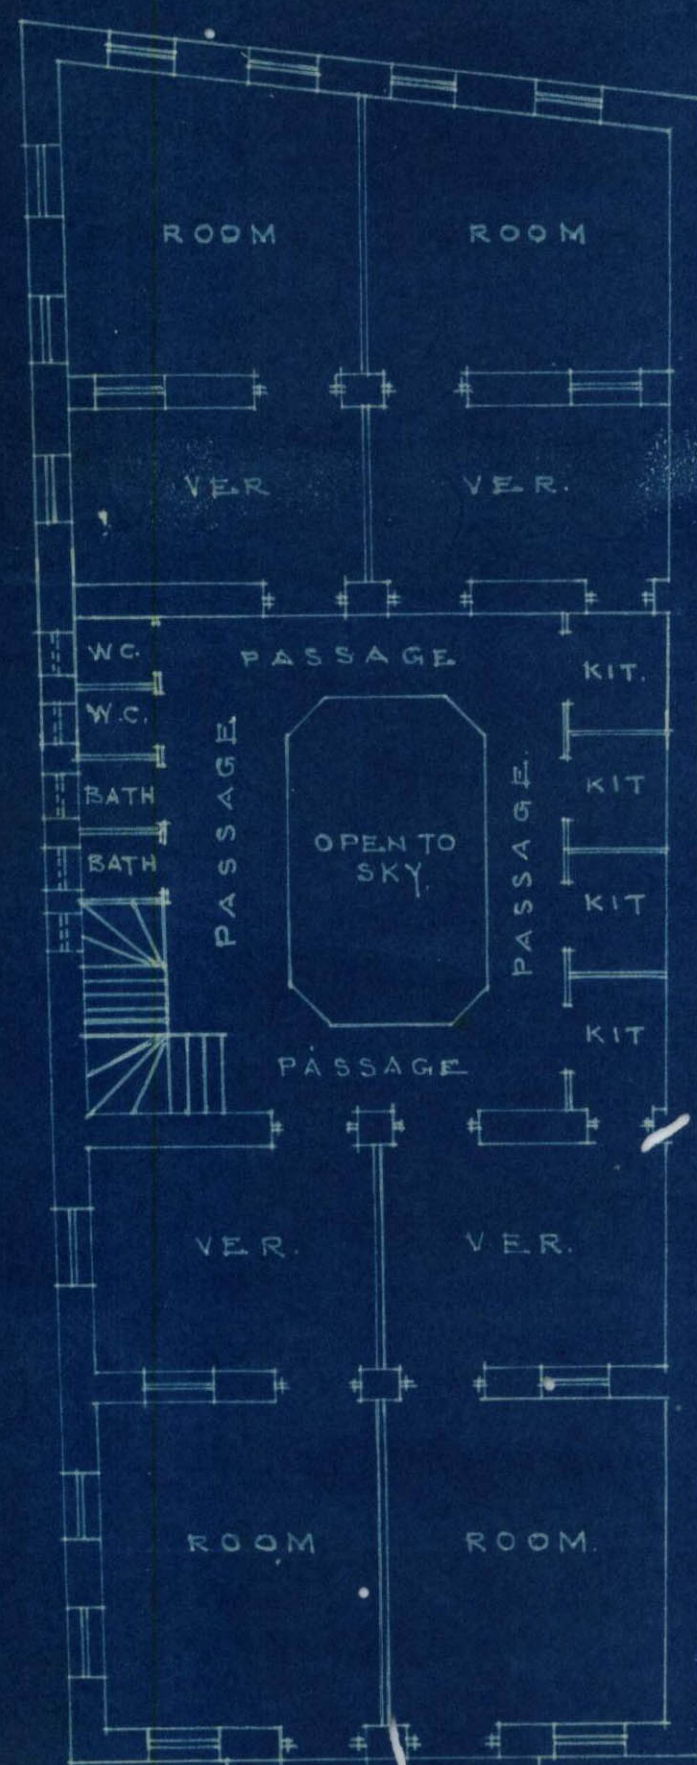


1 ST. & 2ND FLOORS

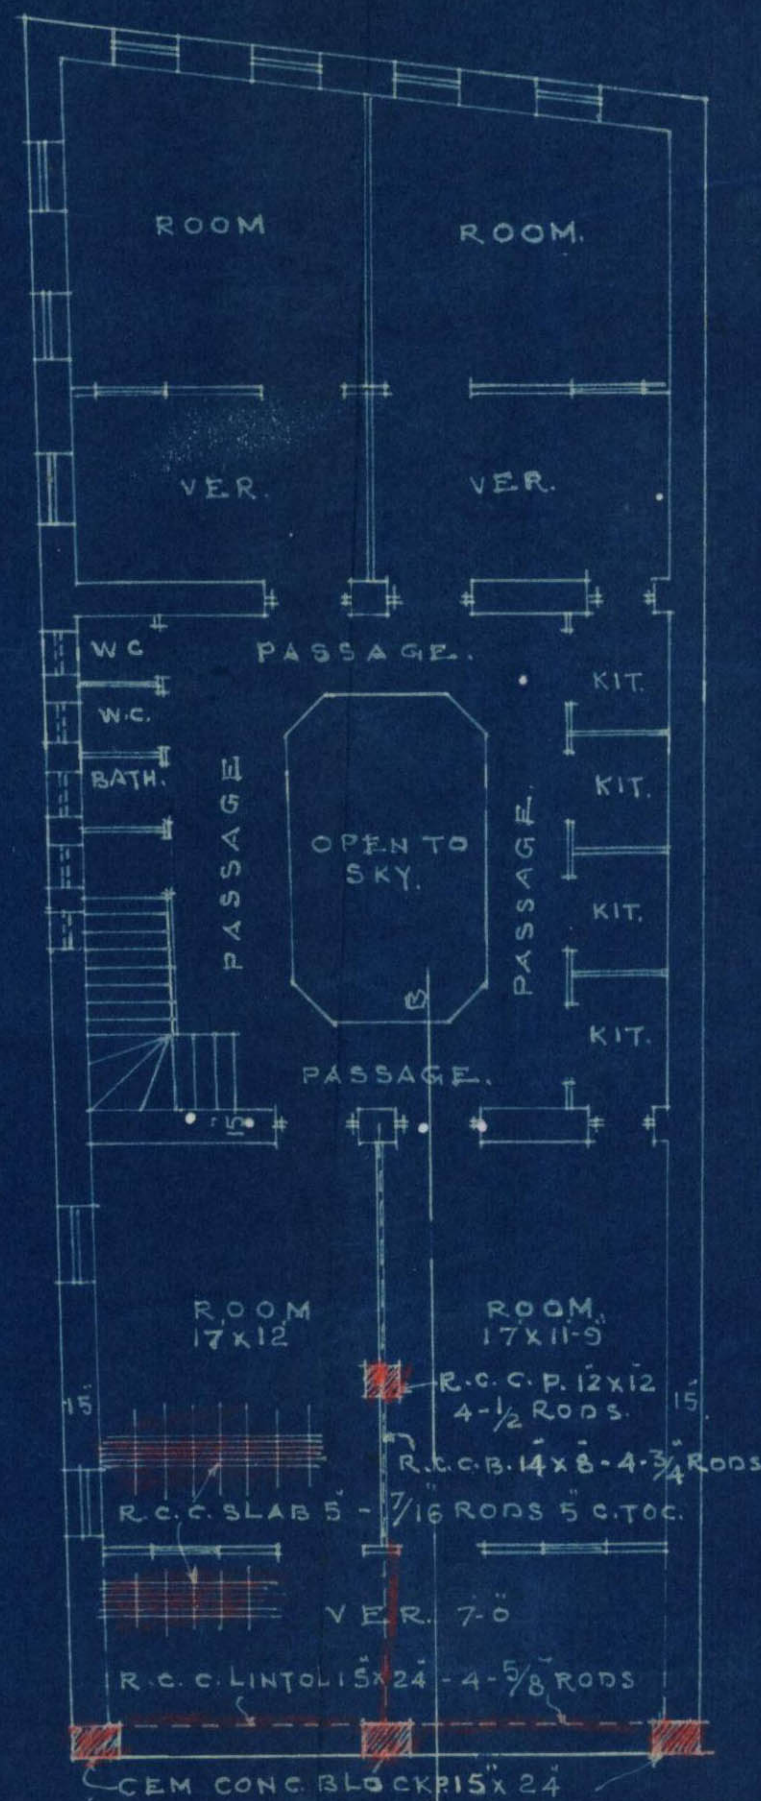

TOP FLOOR

24th Nov 2010
en. Ahmad M. M. M.
OWNER

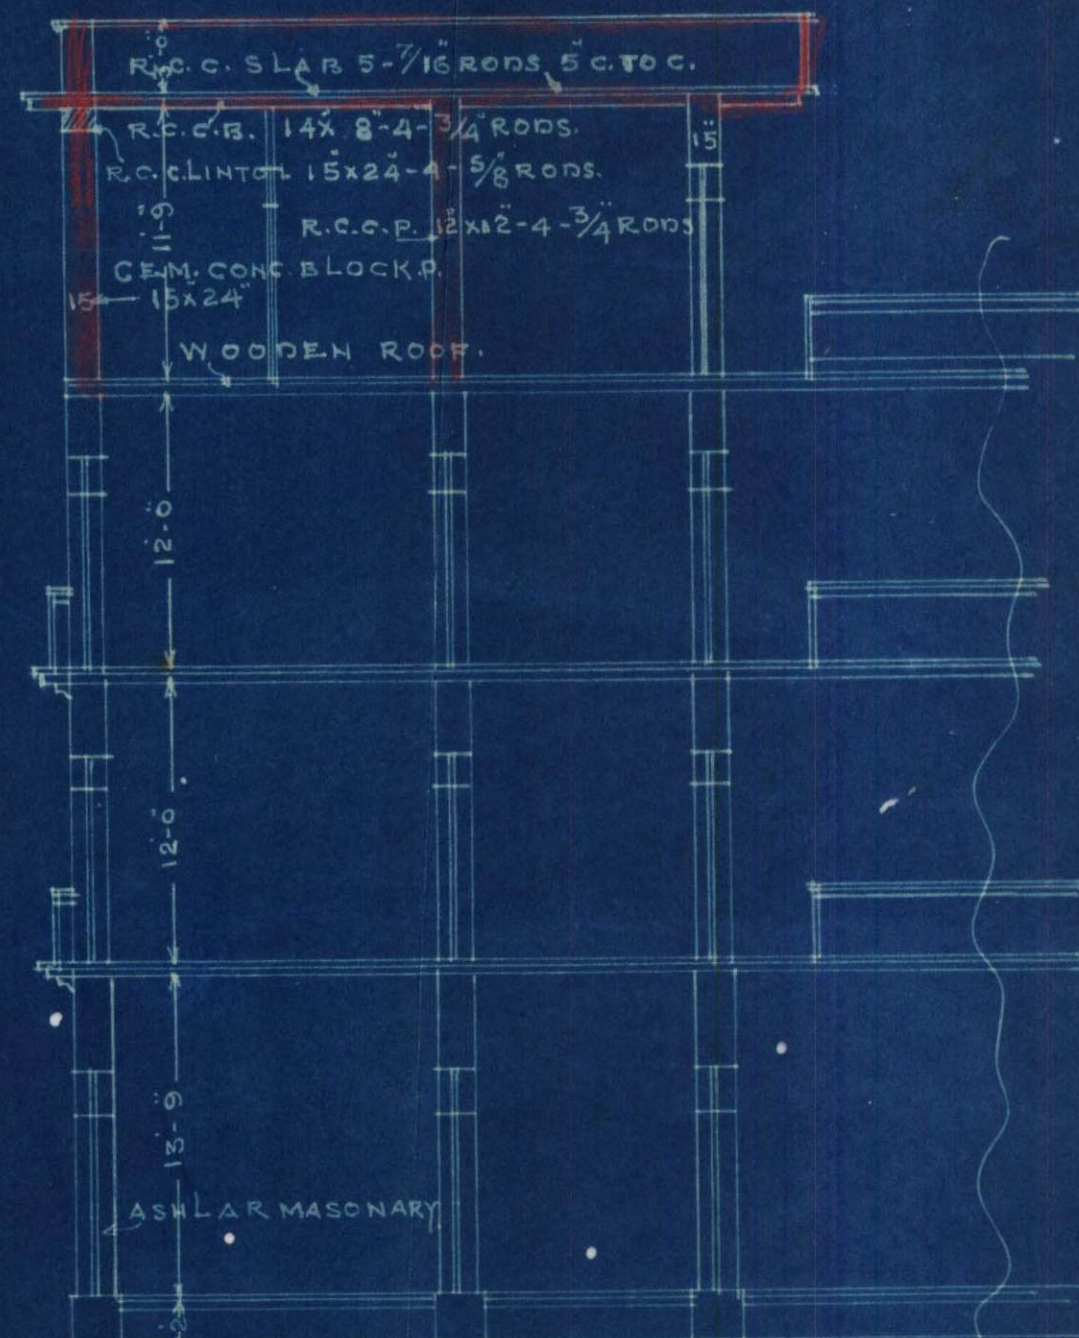

SECTION ON A.B.

R.G. CHAWLA B.E. G.D. ARCH.
ARCHITECT & SURVEYOR.

600—9-39.

3

KARACHI MUNICIPAL CORPORATION.**BUILDING SECTION.****REVIEW FORM.**

Case No. P/6

237/40

RE:—Plot No.

28

, Sheet No.

h. m. 6

h. h. 6

Qr.

A copy of plan is forwarded with compliments to the Sub-Engineer for
favour of remarks.

FOR LAND MANAGER & ARCHITECT.

SUB-ENGINEER'S REMARKS

No objection as there is no
proposal for or alteration
in the drainage lines.

Asstt.

SUB-ENGINEER.

DML



800-2-40.

4

KARACHI MUNICIPAL CORPORATION.
BUILDING SECTION.

REVIEW FORM.

Case No. P/237/40

RE:—Plot No. 29, Sheet No. M.H-6, H. Mehmood Qr.

A copy of plan is forwarded with compliments to the Health Officer for favour of remarks.

6952
23-5 Info Karachi
23/5 55 hours 1500/1
21/5

FOR LAND MANAGER & ARCHITECT.

HEALTH OFFICER'S REMARKS.

No objection
24/5/40
25/5

HEALTH OFFICER.



RS P. 23/40 R: - 28, 4, 4, 6, 5

M. Meari

Sr. Land Surveyor to please
report as usual. 2/5

L.C. for Enrolment Pl.
25/5/40

- (1) Measurement of the Eastern side be corrected.
- (2) Jaffer Jadoo Road width be corrected.
- (3) plot area be correctly shown.
no enrolment.

J. 21/5

Tamaram 25/5/40
526/5

No objection to the site plan
as corrected.

Tamaram 4/6
4/6/40



6-1

KARACHI MUNICIPAL CORPORATION

BUILDING SECTION

REVIEW FORM

Case No. P/C. 237/100

Applicant's Name

Mr. Ahmed Muneer

Architect's Name


EXTRACT FROM THE LAND REGISTER.

New plot No.

29

Sheet No.

446

1/4 Section

Quarter

Old plot No.

Sheet No.

Whether under Govt. or Municipal Control ...	Govt
Registered Holder of plot	Mr. Ahmed Muneer
Area	
Government ...	218 S. 70
Municipal ...	-
Total ...	218 S. 70
Title and period of lease	Rent Free
Form of lease ...	H/1
Any Special conditions of lease ...	-
Remarks ...	-

22
245.



6-2

29 MM 6

No objection to renewal
of roof & front wall on the top floor.

J. M. S.

4/6/40

Alas yhm.

N 576/40

e. e. e. e. e.

6/6

518 2 75

518 2 75

Rent for

11/1

11/1

KARACHI MUNICIPAL CORPORATION.

Diary sheet in respect of Building Regulation plans received.

Date of receipt.	Date When sent.	Date When Retd.	Date when sent to B. S.	Date when put up to L. M. A.	Date when obj sent.	Remarks.
B. S. ...	21/5					
H. O. ...	"	25/5	3/6/00			
E. E. ...	"	27/5				
L. S. ...	"	27/6				
B. S. ...						
H. O. ...						
E. E. ...						
L. S. ...						
B. S. ...						
H. O. ...						
E. E. ...						
L. S. ...						



Heritage

KMR.CDD.MmQ.1940.02

Office Telephone Nos. 2805, 2806, & 2807.

600--6-39

8

F. M. I. KURESHI,
B.Sc. Engineering (Edin.)
LAND MANAGER & ARCHITECT



MUNICIPAL CORPORATION,
KARACHI.

Reference No. B. S. P. 237/40

6 JUN. 1940


KARACHI.

Dear Sir,


With reference to your application dated 193
for the proposed building on the above plot, you
are required to submit one more copy of the
correct plan on cloth

Yours faithfully,

[Signature]
Land Manager & Architect.
6/6

SCALE 8 FT. = 1 INCH.

AREA : 219 1/8 SQ. YDS.

MUGHHI MIANI MARKET ROAD 35 FT

1 ST. & 2ND. FLOORS

TOP FLOOR

2244210
e. Ahmad Mardij
OWNER

SECTION ON A.B.