



Heritage

KMR.CDD.MaQ.1916.06

96



Heritage
FOUNDATION

KMR.CDD.MaQ.1916.06

1-2

on plot No. 87, 88, 44 Street al Joway

Quarter. Report should be made to the undersigned when the house is
completed.

J. Cecil L. Verby

A. M. INST. C. E.,



2

No. E. of 1916,

Municipal Office,

Karachi 17th May 1916.

M E M O:-

With reference to his application dated 10th current with plans to build a house on plot No: 151, A-19 Market Quarter, Mr Dharamdas Premchand is requested to apply for permission to the City Deputy Collector with two plans returned herewith duly signed and approved.

He must not start any building operation until he hears further from this Office.

It is further info that
M. Inst. C. E. has
the plan to acquire
the site of this plot as
shown in the map
The attached map
+ this map he set back
before start of work
before build is granted
to be

M. Inst. C. E.

Chief Officer & Chief Engineer,

Karachi Municipality.

must be set back when
the work of the above
plot build is allowed
to start. started



Heritage

KMR.CDD.MaQ.1916.06

100-5-4-16

Form No. 1.

Karachi, 10 - 5 - 1915

NOTICE UNDER SECTION 96 OF ACT III OF 1901.

To

THE CHIEF OFFICER & CHIEF ENGINEER,

KARACHI MUNICIPALITY.

SIR,

I beg to inform you that I intend building house

on plot No. 15-1

Survey Sheet No. A 19 situate in Market - Qbr

Street, _____ Quarter.

As required by the rules of the Municipality, I beg to submit herewith a plan of the same for your approval.

I beg to remain,

Sir,

Your most obedient servant,

2. 11. 1915
15. Bhairudas Preemhan
Signature of the applicant.

No. G. 6761 of 1916.
MUNICIPAL CHIEF OFFICER AND
CHIEF ENGINEER'S OFFICE,

Karachi, 15th May 1916.

Forwarded to the Municipal Engineer for favour of disposal.

15. 12. 1916
15. 12. 1916
M. INST. C. E.
Chief Officer and Chief Engineer,
Karachi Municipality.

3-2



Heritage

KMR.CDD.MaQ.1916.06

2

No. E. 3927 of 1916.

MUNICIPAL ENGINEER'S OFFICE.

Karachi, 15th May 1916.

MEMO.

The above application is forwarded to the Municipal Health Officer for favour of report.

Antony

A. M. I. C. E.,

Engineer,
Karachi Municipality.

MUNICIPAL HEALTH OFFICER'S REPORT.

Returned to the Engineer, Karachi Municipality, with the following remarks:—

No objection

D. P. H. (London)

D. P. H. (London),
Health Officer,
Karachi Municipality.

Date 15-5-1916

No. E. 3927 of 1916.

MUNICIPAL ENGINEER'S OFFICE.

Date 15th May 1916.

Forwarded to the Building Surveyor for report

S. S. S. S.

A. M. I. C. E.,

Engineer,
Karachi Municipality.

Through

THE LAND SURVEYOR,

Karachi Municipality.



BUILDING SURVEYOR'S REPORT.

Applicant's name

Shamunda Prunchead

Whether he is the owner of the plot on which it is proposed to build

Yes

The work proposed

Build a house

Building Surveyor's report

Sir,

I beg to report that there seems no objection to approve the plans with the C. D. S. consent.

Yours truly
S. B. Anwar

Date

15/5 1916.

Building Surveyor.

Submitted through the Land Surveyor

LAND SURVEYOR'S REPORT.

Does the plot come under Alignment

No-

Area of plot

Area under Alignment

Remarks

Sir, With reference to this I beg to report that there is no objection to permission to build be granted. with the C. D. S. sanction

M. M. I. C. E.
N. B. Anwar

Date

15-5 1916.

Land Surveyor.

ORDERS OF THE ENGINEER.

Inform C. D. S. and owner no objection.

2

3-4

111
16/5/16



Heritage

KMR.CDD.MaQ.1916.06

No. E. ⁴4928 of 1916.

MUNICIPAL ENGINEER'S OFFICE,

Karachi. 21st June 1916

Submitted to the Managing Committee with a recommendation that the plan be approved.

Forwarded
by Chief Officer

J. Cecil L. Parley

A. M. I. C. E.,

Engineer,

Karachi Municipality.

Chief Officer

Through

The CHIEF OFFICER & CHIEF ENGINEER.

KARACHI MUNICIPALITY.

RESOLUTION OF THE MANAGING COMMITTEE.

Resolution No. _____ dated _____



Heritage
FOUNDATION

KMR.CDD.MaQ.1916.06


41

PLAN SHOWING OF PROPOSED BUILDING ON


PLOT NO. 151 SHEET A.19

MARKET QUARTER

SCALE 8=1

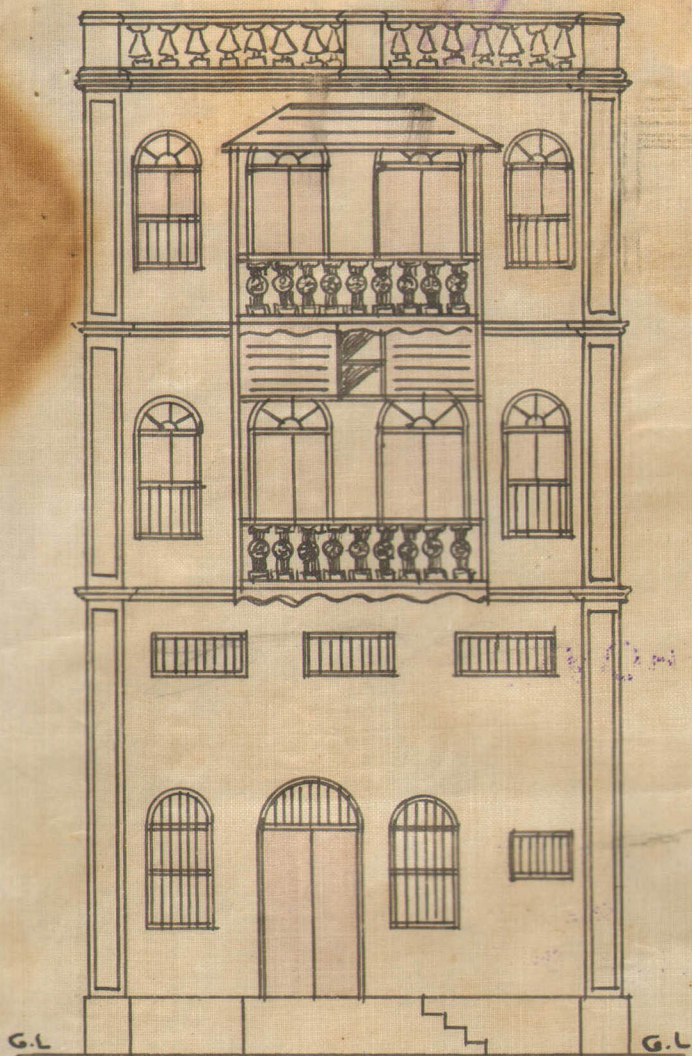


FRONT ELEVATION

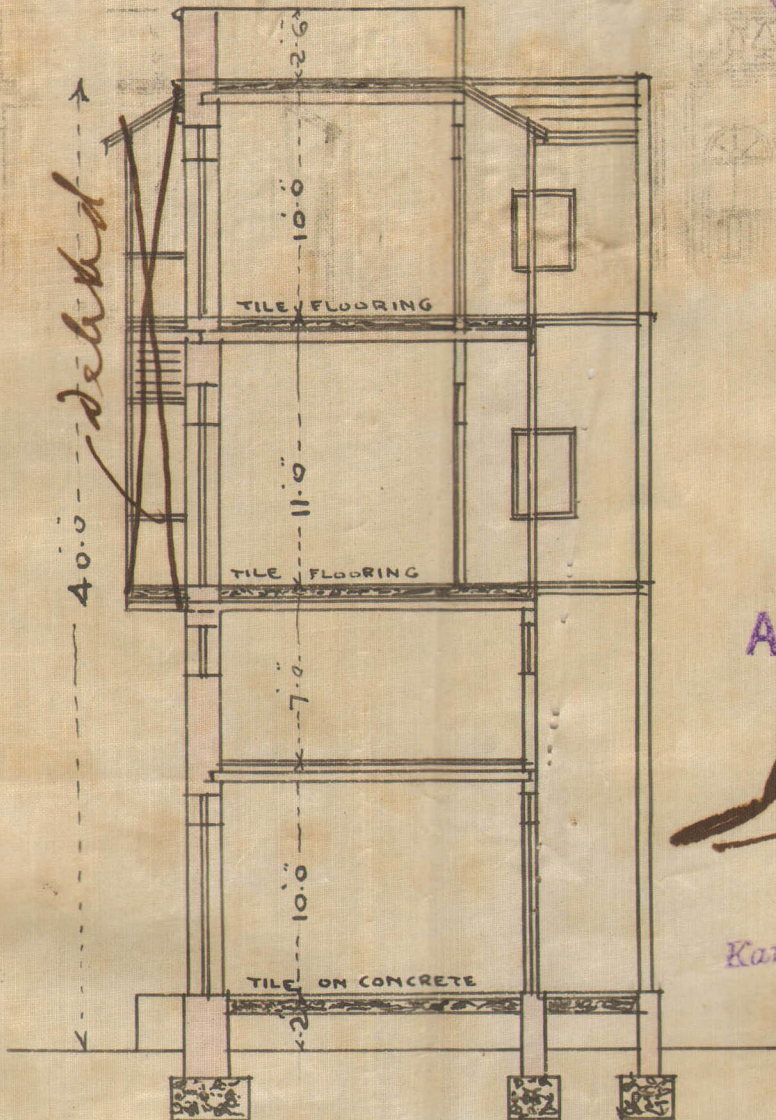


SECTION ON A-B

APPROVED.


S. A. L. Verley
A. M. Inst., C. E.
Engineer,
Karachi Municipality.

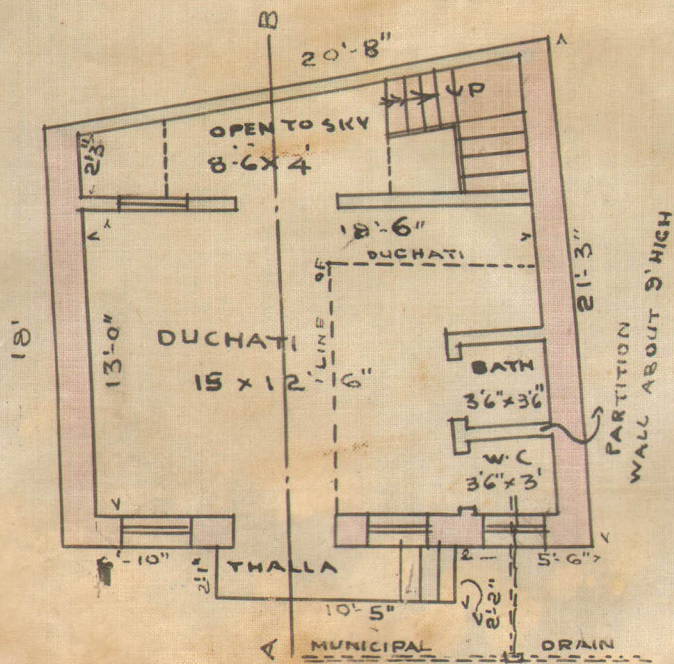

PLAN OF GROUND FLOOR

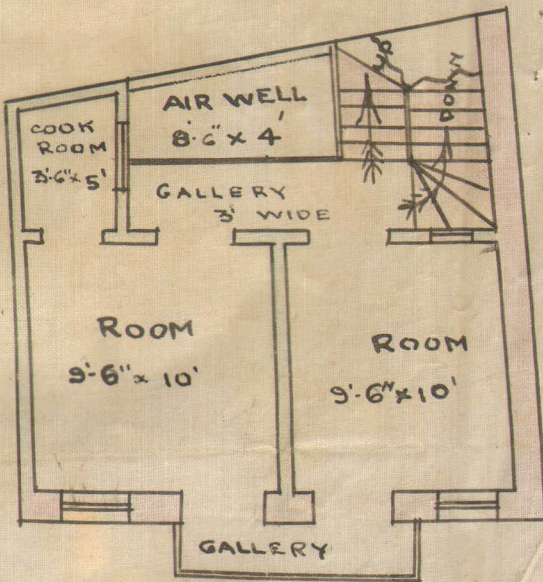

PLAN OF 1ST & 2ND FLOORS

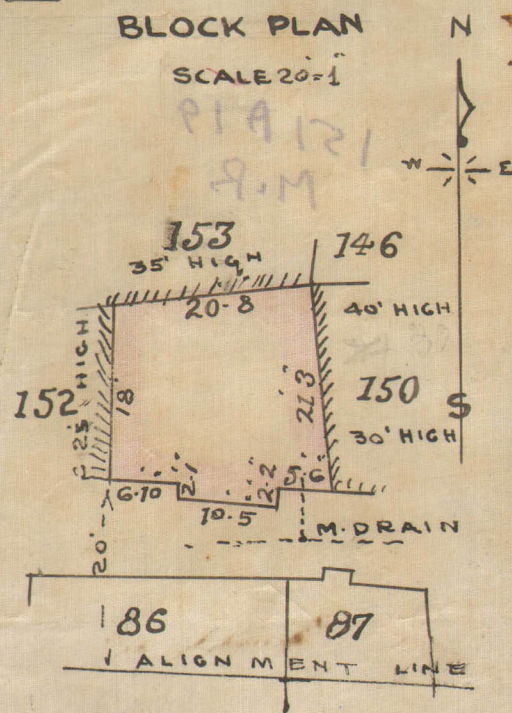

M. Vazaretha 15.5.16

B. A. L. O. E.
ARCHITECT & ENGINEER,
OPPOSITE PARSİ THEATRE.



52

MARKET QUARTER

SHEET N^oA.19.

SCALE 20' = 1"

PLAN N^o 90

DT. -5-1916

NOTE

ORIGINAL AREA 50 S.Y.
TO BE ACQUIRED $2\frac{1}{2}$ S.Y.
BALANCE AREA $47\frac{1}{2}$ S.Y.

Mr. Inst. C. E.
Chief Officer & Chief Engineer

Kathal



S. S. B. J. S.
17-5-1916



61

L.No	PERIOD	PLOT NUMBER	AREA
1		5/93 A 8	0.7
2		~~J 1-B~~ 5 J 1-B	F.T
3		8 A i 4	G R
4		169 K 6	L V
5		100 A 19 ~~60/100~~	M.R
6			
7			
6-2

1916/134

SL. No.	PERIOD	PLANT NUMBER	REMARKS
1	1916	125 B 17	S.R
2		151 A 19	M.R
3		115, 136 B A 5	O.T
4		329, 10 B 3	S.R
5		13 B 10	S.R
6		111, 113, 27 A 20	N.P
7		1 F 15	S.B
8		16 A 6	O-T
9		3A11/3A12 E 5	GR
10		250 E 7	R.S
11		THAKURDAS KANYASHALA	
12		184 G 1	S.B
13		1 B 10	S.R
14		67 E 4	R.C
15		144 A 2	O.T
16		53, 55 A 5	O-T
17		1 G 4	S.B
18		12A N 1	C.F
19		85 C 1	M.M
20		39 G 1	S.B
21		213, 214, 215 E 6	R.S
22		26, 28 B 5	S.R
23		152 C 6	M.R
24		123 A 2	O-T
25		125 B 7	S.R
26		7 A 15	B.R
27		43 K 9	LX
28		22 E 4	R.C
29		6 G 7	CEL
30		78 C 6	M.R
31		49 E 6	R.S
32		8 E 11	GR
33		19E C 2	M.M
34		77 K 12	LX
35		172, 174 A 2	O-T



No. E. 4064 of 1916,
Municipal Office,
Karachi 20th May 1916.

With reference to his application dated 10th current with plans to build a house on plot No 101, A-19 Market Quarter, Mr. Bhurandus Prachand is requested to apply for permission to the City Deputy Collector with two plans returned herewith duly signed and approved.

He is further informed that Municipality propose to acquire the dickie in front of his plot as shown in red on the attached tracing and this must be set back when the work of the above building is started.

He must not start any building operation until he hears further from this Office.

M. Prachand, Esq.

M. Inst. C.E.
Chief Officer & Chief Engineer,
Karachi Municipality.

~~~~~  
No. E. 4064 of 1916,  
Municipal Office,  
Karachi 20th May 1916.

Copy forwarded to the City Deputy Collector  
for information with reference to his letter No: 536  
dated 27th February 1914.

M. Prachand, Esq.

M. Inst. C.E.  
Officer