

PLAN SHOWING PROPOSED ADDITIONS & ALTERATIONS  
TO HOUSE ON PLOT NO. 23.A. SHEET B.5  
SERAI QUARTER  
SCALE 8" = 1" INCH

APPROVED  
*P. G. K. K. K.*  
A. B. C. D. E.  
K. M. R. C. D. D. M. I. Q.



NOTE NEW WORK IS SHOWN IN RED  
LINES OR COLORED  
EXISTING WORK TO BE DEMOLISHED  
IS HATCHED OR NOT SHOWN  
EXISTING WORK IS SHOWN IN BLACK  
OR LEFT UN COLORED.





FRONT ELEVATION




SECTION ON A-B-B-C


BLOCK PLAN  
SCALE 40' = 1"

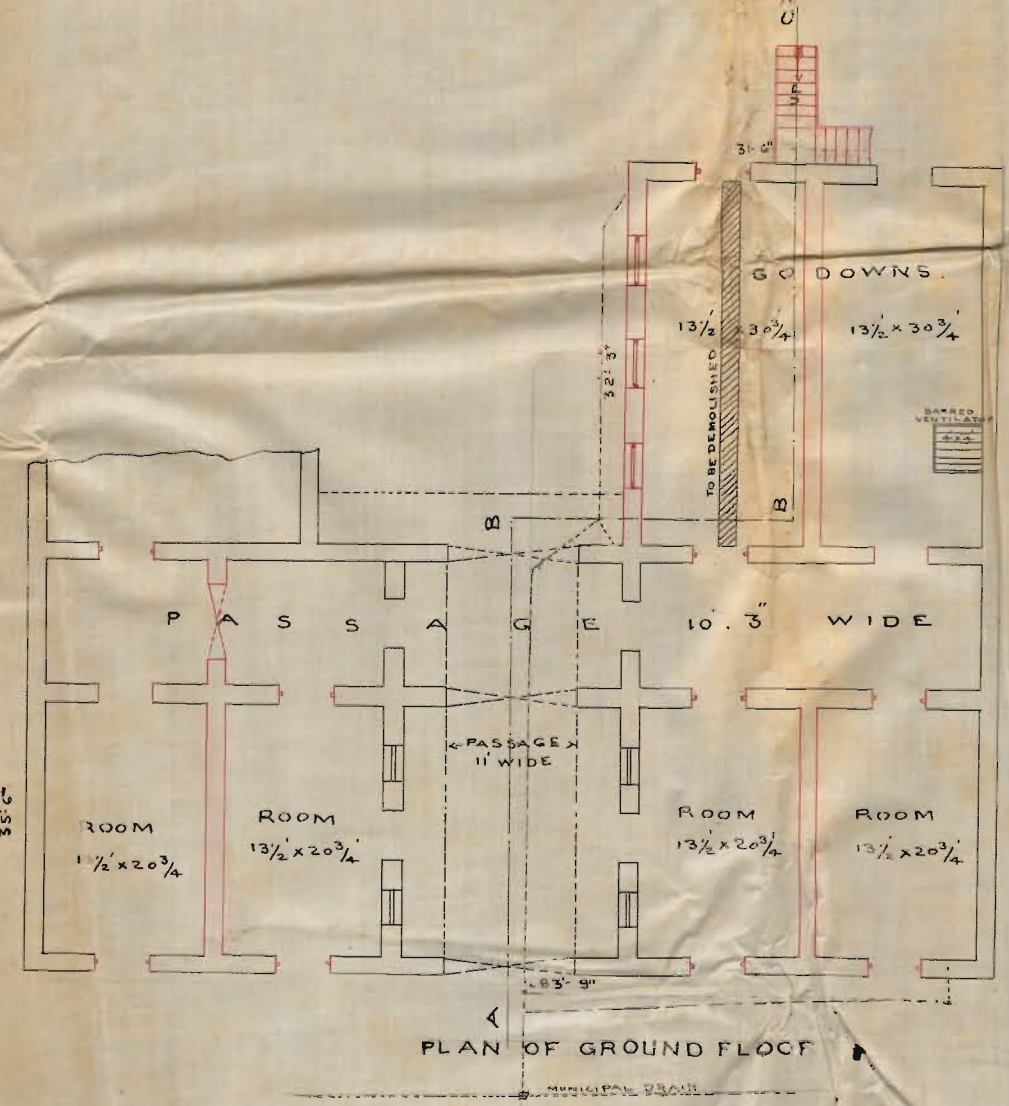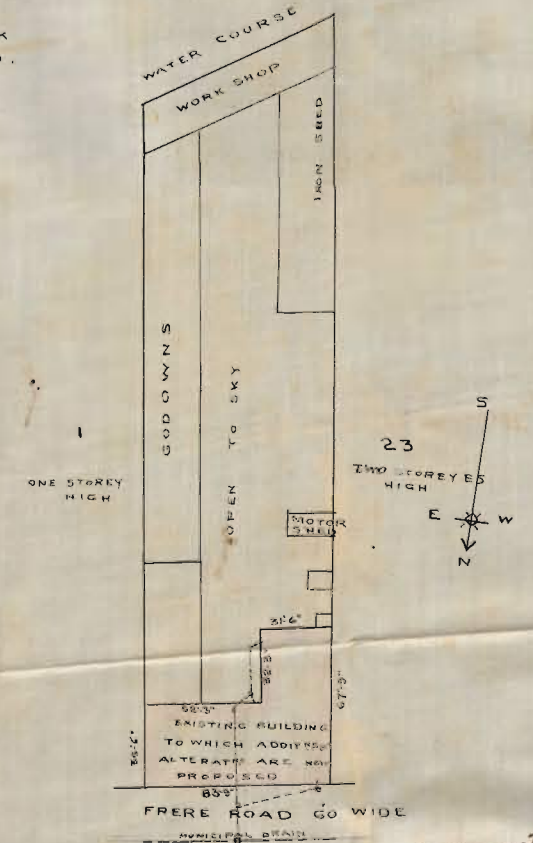

PLAN OF GROUND FLOOR

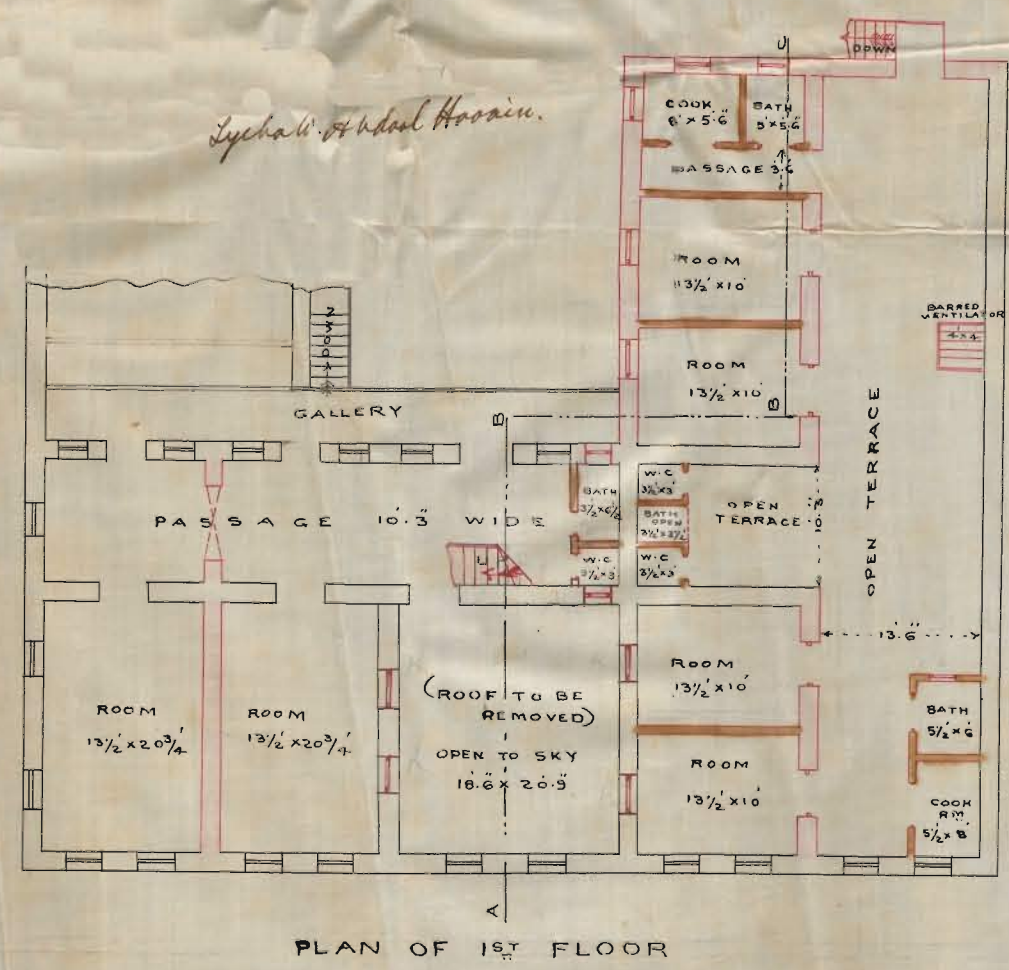

PLAN OF 1ST FLOOR

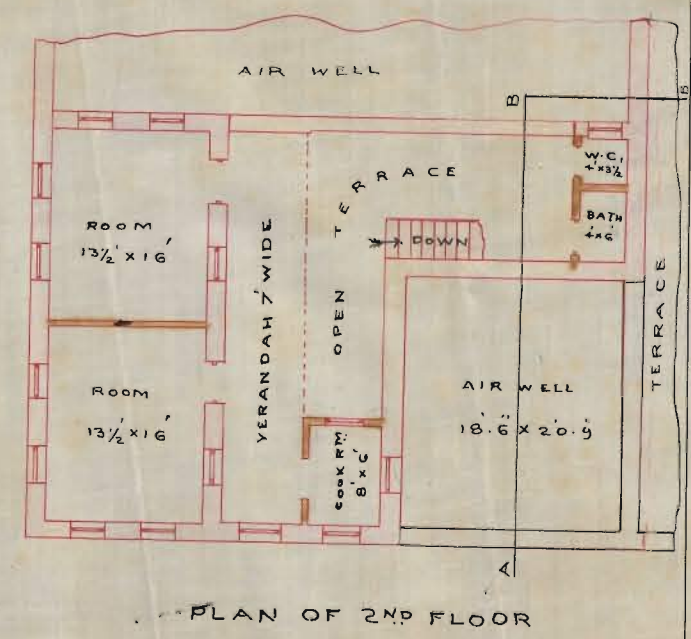

PLAN OF 2ND FLOOR

*Lycha W. Abdul Hossain.*

*M. Nazaretti*  
ARCHITECT & ENGINEER  
OPPOSITE PARSİ THEATRE

# PLAN SHOWING PROPOSED ADDITIONS & ALTERATIONS

TO HOUSE ON PLOT NO. 23.A. SHEET B.5

## SERAI QUARTER

SCALE 8" = 1" INCH



FRONT ELEVATION




SECTION ON A-B-C

NOTE NEW WORK IS SHOWN IN RED  
LINES OR COLORED.  
EXISTING WORK TO BE DEMOLISHED  
IS HATCHED OR NOT SHOWN  
EXISTING WORK IS SHOWN IN BLACK  
OR LEFT UNCOLORED


BLOCK PLAN  
SCALE 40' = 1"



PLAN OF GROUND FLOOR

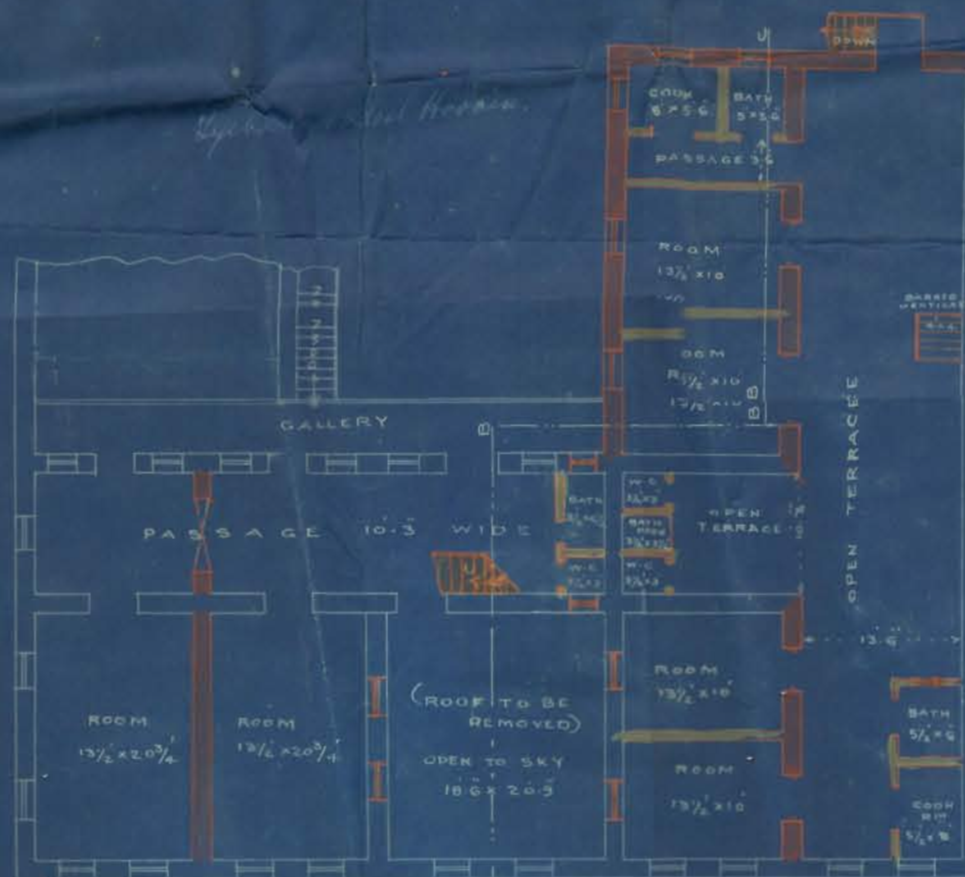

PLAN OF 1ST FLOOR

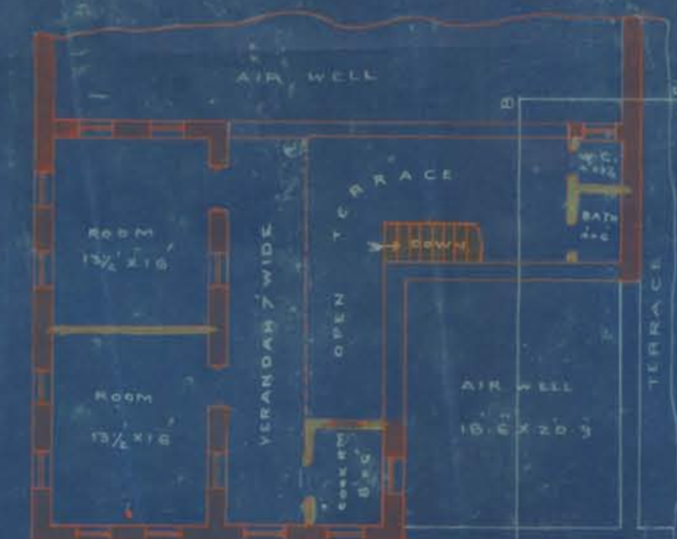

PLAN OF 2ND FLOOR

17. 2/10/1914  
24. 2/10/1914  
BALCO  
ARCHITECT & ENGINEER  
APPROPRIATE PAPER FILED

PLAN SHOWING PROPOSED ADDITIONS & ALTERATIONS

TO HOUSE ON PLOT NO. 23, A. SHEET B.5

SERAI QUARTER

SCALE 8" = 1" INCH



FRONT ELEVATION




SECTION ON A-B-C

NOTE: NEW WORK IS SHOWN IN RED LINES OR COLORED  
EXISTING WORK TO BE DEMOLISHED IS HATCHED OR NOT SHOWN  
EXISTING WORK IS SHOWN IN BLACK OR LEFT UNCOLORED

BLOCK PLAN  
SCALE 40' = 1"



PLAN OF GROUND FLOOR

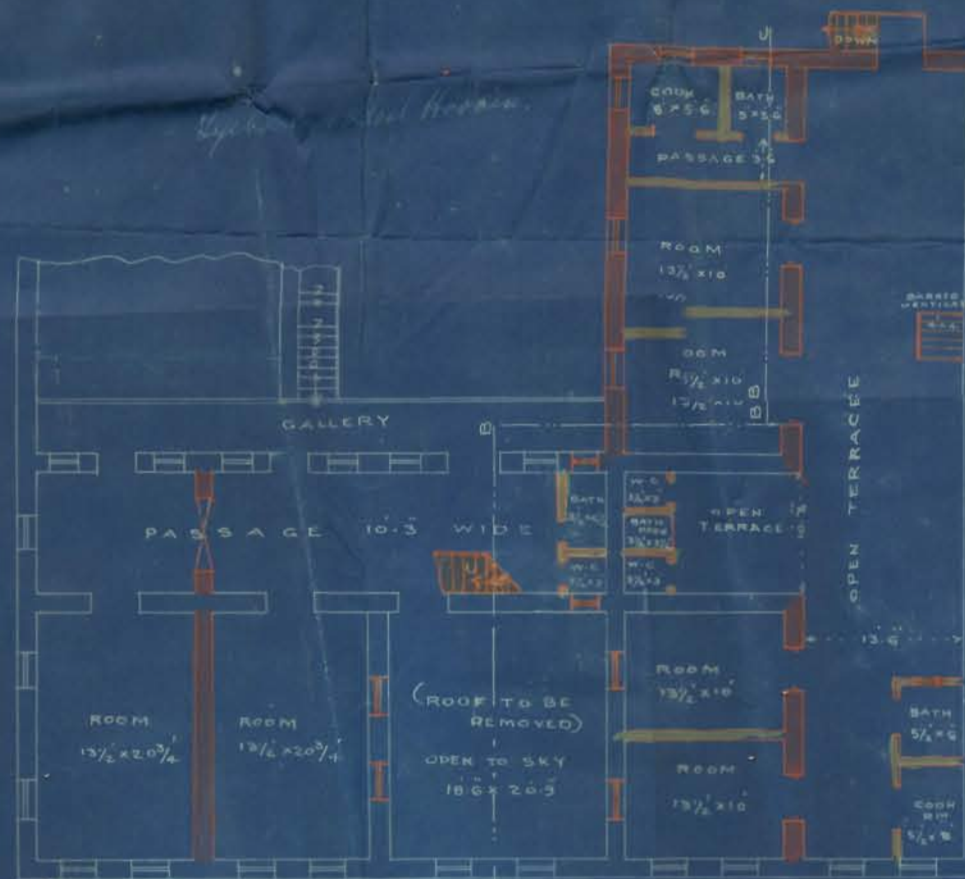

PLAN OF 1ST FLOOR



PLAN OF 2ND FLOOR

W. J. H. Smith  
23, A. SHEET B.5  
ARCHITECT & ENGINEER  
OPPOSITE RAIL STATION

No E 73<sup>20</sup> of 1915.

Municipal Office.

Karachi. 8th September 1915.

Karachi 7<sup>th</sup> Sep 1915

MEMO / -

With reference to his application dated 25th August 1915 with a set of plans for making additions and alterations in his plot no. 23A, B-5 Seral Quarter Mr: Tyabali Abdul Hussain is informed that the drainage arrangements are not shown on the plan. These must be shown thereon before the same can be passed. They are therefore returned herewith for amendment accordingly.

*J. Cecil L. Kirby*  
A. M. Inst. C. E.,

E n g i n e e r

Karachi

Municipality.

§

55

No. 8. 7/1915  
Municipal Office  
Karachi 7<sup>th</sup> Sep. 1915  
8

Memorandum

With reference to his application of  
25<sup>th</sup> August 1915 with a set of plans for  
<sup>making</sup> ~~the~~ additions & alterations in his plot  
No. 23 A B-5 Sec. Q. N. Jyabali.  
Abdul Hussain is informed that the  
drainage arrangements are not shown  
on the plan. These must be shown  
before the same can be passed -  
They are therefore returned herewith  
for amendment accordingly.

V.

A.M. Inst., C.E.,  
Engineer,  
Karachi Municipality.

56

29-6-16.

Form No. 5.

No. E. 7587/1915

MUNICIPAL ENGINEER'S OFFICE,

Karachi, 20<sup>th</sup> September 1915

MEMO.

Building Inspector

is informed

that Mr. Menghraj Tulsidas has been permittedto build shops his houseon plot No. 396 B. Ry Street, Gari

Quarter. Report should be made to the undersigned when the house is

completed.

J. Cecil L. Verky

A. M. INST. C. E.,

Engineer,

Karachi Municipality.

M B

57-1

No E

6405

of 1915.

Municipal Office.

Karachi. 5th August 1915.

MEMO / -

With reference to his application dated 16th July 1915 with two copies of plans for building shops on plot No. 396, K-7 Lyari Quarter Mr: Menghraj Tulsidas is informed that his plans have been approved. He is requested to submit two more copies of the plans which will be returned to him duly signed and approved for applying to the City Deputy Collector. He must not start any building operation until he hears further from this office.

A. M. Inst. C. E.,

Engineer

Karachi

Municipality.

No E

6406

of 1915.

Municipal Office.

Karachi, 5th August 1915.

Copy forwarded to the City Deputy Collector for information.

A. M. Inst. C. E.,

Engineer,

Karachi

Municipality.

Sir,

The applicant has submitted two more  
copies of the plans. A letter may now be  
written to him briefly to City Deputy Collector  
for permission.

Yours obediently  
M. L. Chaudhary 17/8/15-

Sir

I beg to report  
that as the two more  
copies have been supplied  
now the letter forwarded  
to the order to submit  
to the C.D. Collector.

Yours obed

N. L. Chaudhary

17/8/15

Write applicant to submit  
plan to C.D.C.

17/8/15



58'

No E

6706

of 1915.

Municipal Office.

Karachi. 17th August 1915

18th

MEMO / -

With reference to his application dated 16th inst. with a set of plans for building shops on plot No. 396, K-7 Lyari quarter Mr: Menghraj Tulsidas is requested to apply for permission to the City Deputy Collector with two copies of plans returned herewith duly signed and approved. He must not start any building operation until he hears further from this office.

*J. Cecil L. Verby*

A. M. Inst. C. E.,

E n g i n e e r

Karachi Municipality.

\*\*\*\*\*

No E

6707

of 1915.

Municipal Office.

Karachi. 17th August 1915.

18th

Copy forwarded to the City Deputy Collector with reference to his No. 536 dated 27th February 1914.

*J. Cecil L. Verby*

A. M. Inst. C. E.,

E n g i n e e r,

Karachi Municipality.

B

59-1

*16/9/15*  
*2.*

No. 3390 of 1915.

Revenue Department,

Collector's Office,

Karachi, 10th September 1915.

Read letter No. 2335 dated the 27th August 1915 from

-----  
Permission to build shops \*  
\* the City Deputy Collector  
on survey number 396 B(sheet \*  
\* Karachi on the subject  
K-7) Lyari Quarter. \*  
\* noted in the margin.  
\*\*\*\*\*

Reply of the Collector of Karachi.

S a n c t i o n e d.

*For survey report  
for H. V.*

Sd. J. W. Smyth,

Acting Collector of Karachi.

To,

The City Deputy Collector, Karachi (with the plan).

No. 2488 of 1915.

Revenue Department,

City Deputy Collector's Office,

Karachi, 14th September 1915.



Copy forwarded for information to the Engineer

Karachi Municipality with reference to his endorsement

No. E/. 6707 dated 18th August 1915.



*Running*

City Deputy Collector.

*[Signature]*

*See  
It is attached herewith  
our certificate  
14/9/15.  
[Signature]*

I beg to report that  
Now there seems no objection  
to grant pass as the e.d's  
sanction has been received.  
Request yr order.

Yours faithfully  
S. B. Bhandari  
18/9/15

8/8/15



60-1

500-14-7-14.

Form No. 1.

Karachi, 16-7-1915

## NOTICE UNDER SECTION 96 OF ACT III OF 1901.

To

THE CHIEF OFFICER AND CHIEF ENGINEER,

KARACHI MUNICIPALITY.

SIR,

I beg to inform you that I intend building Shops  
on plot No. 396

Survey Sheet No. 147 Situate in \_\_\_\_\_

Street Dyaree Quarter.

As required by the rules of the Municipality. I beg to submit herewith  
a plan of the same for your approval.

I beg to remain,

Sir,

Your most obedient Servant,

*Signature of the applicant.*

No. G. of 8168. 1915

MUNICIPAL CHIEF OFFICER AND

CHIEF ENGINEER'S OFFICE.

Karachi, 16th July 1915

Forwarded to the Municipal Engineer for favour of disposal.

*145-1*  
*16/7/15*  
*In Dinskeen*  
*Shore walls*  
*16 2 15*

*Signature*  
A. M. INSE C. E.,  
Chief Officer and Chief Engineer,  
Karachi Municipality.



60-2

2

No. E. 5785 of 1915

## MUNICIPAL ENGINEER'S OFFICE.

Karachi, 16<sup>th</sup> July 1915.

MEMO.

The above application is forwarded to the Municipal Health Officer for favour of report.

*Walton*

A. M. I. C. E.,

In Engineer,

Karachi Municipality.

## MUNICIPAL HEALTH OFFICER'S REPORT.

Returned to the Engineer, Karachi Municipality, with the following remarks:—

*No objection**D. P. H. (London.)*

D. P. H. (London.)

Health Officer,

Karachi Municipality.

Date 27-7-1915

No. E. 6101 of 1915

## MUNICIPAL ENGINEER'S OFFICE.

Date 27<sup>th</sup> July 1915.

Forwarded to the Enquiry Officer for report.

*Walton*

A. M. I. C. E.,

In Engineer,

Karachi Municipality.

Through

The Land Surveyor,

Karachi Municipality.

60-3

# ENQUIRY OFFICER'S REPORT.

Applicant's name Mr. Mungerni Subudh

Whether he is the owner of the plot on which it is proposed to build Yes

The work proposed Shops.

Enquiry Officer's report Sir, I beg to report that there

appears no objection to grant permission  
with C.D.C.'s consent. Request for order  
4 copies to be supplied

Date 30/7/15 191

Enquiry Officer.

Submitted through the Land Surveyor.

## LAND SURVEYOR'S REPORT

Does the plot come under Alignment no

Area of plot —

Area under Alignment —

Remarks Sir, with reference to this I beg to report

that there is no objection to permission to build the  
proposed and provided 4 copies to be supplied to  
the concerned authorities.

Date 30-7-15 191

Land Surveyor.

## ORDERS OF THE ENGINEERS.

Engineer's approval accordingly -

V. 3/8/15

Issue Pass

Stent. L. Verby

A. M. I. C. E.,

Engineer,

Karachi Municipality.

Sh. 1/5  
Survey Sh. 1/5  
2/8/15

No. E. 4509 of 1915

MUNICIPAL ENGINEER'S OFFICE.

Karachi, 10<sup>th</sup> Sept 1915.

Submitted to the Managing Committee with a recommendation that the plan be approved.

Forwarded

*W. Ashman Lee*  
A. M. I. C. E.

*J. Cecil L. Kirby*

A. M. I. C. E.,

Engineer,

Karachi Municipality.

Chief Officer, Karachi Municipality.

Through

THE CHIEF OFFICER AND CHIEF ENGINEER,

KARACHI MUNICIPALITY.

RESOLUTION OF THE MANAGING COMMITTEE.


Resolution No.

Date

16043  
21/9/15

PLAN  
SHOWING PROPOSED SHOPS  
ON PLOT NO 396 SHEET K7  
LYAREE QUARTER  
SCALE 4 FT = 1 INCH


GROUND FLOOR

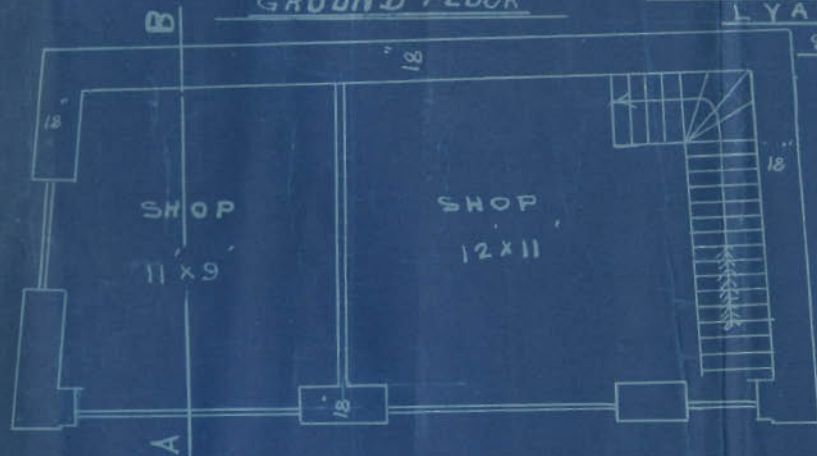

ELEVATION



SECTION ON AB

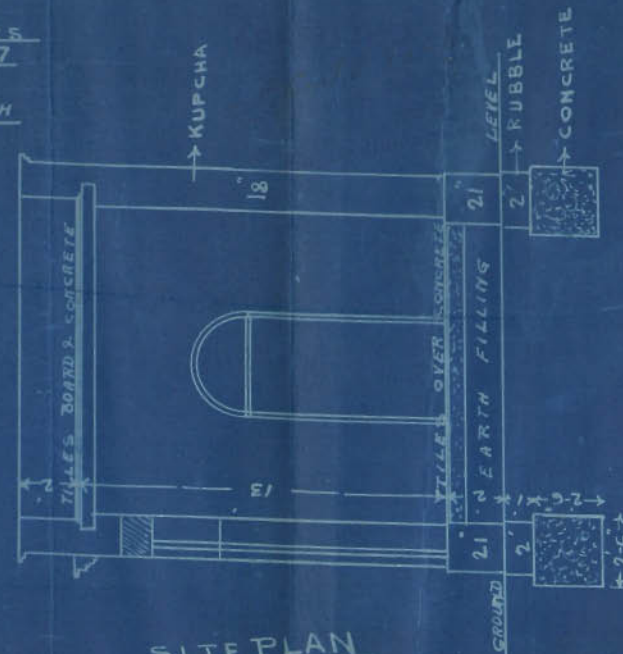

SITE PLAN  
SCALE 40 FT = 1 INCH



*Designed and Drawn by*  
A.C.E.  
*Architect*

62

200-23-6-15.

Form No. 2.

## ORDERS UNDER SECTION 96 (2) OF ACT III OF 1910.

No. E/

7653  
OF 1915.

MUNICIPAL ENGINEER'S OFFICE,

Karachi, <sup>21<sup>st</sup></sup> ~~21<sup>st</sup>~~ September 1915.

## MEMO:

With reference to his application, dated 25<sup>th</sup> August 1915,  
 Mr. Fyabali Abdul Hussein is informed  
 that the plan submitted by him for building making additions and  
alterations on plot No. 28a Survey Sheet B5  
 situate in Freer Road Street, Serai  
 Quarter, is approved, and permission to build in accordance therewith is  
 granted. The building to be erected subject to the Byelaws and Rules of the  
 Municipality.

  
 A.M. INST. C.E.,

Engineer,

Karachi Municipality.

NOTE 1.—This pass does not give permission to occupy Municipal land with building materials. This can only be allowed when the street is wide enough to permit building materials being deposited on it without it being a source of danger to the public, and only then on a hoarding being placed round the land to be occupied, and on payment in advance of fees for occupation of Municipal land, at the following rates:—

|                                                           | Rs. | A. | P.              |
|-----------------------------------------------------------|-----|----|-----------------|
| (1) For the first three months, per square yard, per diem | ... | 0  | 0 $\frac{1}{2}$ |
| (2) For the next three months                             | ... | 0  | 0 1             |
| (3) For any subsequent time                               | ... | 0  | 0 2             |

NOTICE 2.—Windows, steps and doors of the building will not be permitted to project on or overhang any public street or Municipal land.

NOTICE 3.—Plinths will not be allowed to project more than 2" on any public street for ornamental purposes.

(200-29-6-15.)

Form No. 5.

No. E.

1915

MUNICIPAL ENGINEER'S OFFICE,

Karachi, 21<sup>st</sup> September 1915

MEMO.

Building Inspector

is informed

that *Mr. Syahali Abdul Hussain* has been permitted

for making additions &amp; alterations on his house

on plot No. *23a, B5, Faure Road* Street, *Serai*

Quarter. Report should be made to the undersigned when the house is  
completed.

*J. Cecil L. Verby*

A. M. INST. C. E.,

Engineer,

Karachi Municipality.

*M B*

64

(200-29-6-15.)

Form No. 5.

No. E. 7656 1915

MUNICIPAL ENGINEER'S OFFICE,

Karachi, 21<sup>st</sup> September 1915

MEMO.

Building-Inspector Serai is informed

that Am Tyabali Abdul Hussain has been permitted

for making additions & alterations on his house

on plot No. 230, B. Free Road Street, Serai

Quarter. Report should be made to the undersigned when the house is

completed.

J. Cecil L. Verby

A. M. INST. C. E.,

Engineer,


Karachi Municipality.

Through the Health Office  
Karachi Municipality

65

**SOLE AGENTS FOR  
ROBSON'S OIL ENGINES  
& SUCTION GAS PLANTS.**

**& also  
FORD MOTOR CARS.**

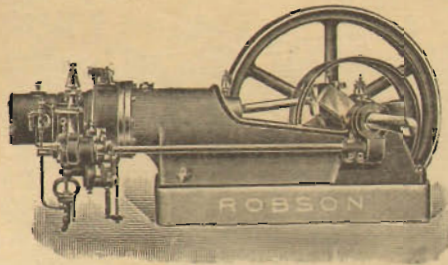

*Could supply for the factory*  
17/9/15

Telegraphic Address  
"SHAIKH," Karachi.  
A B C Code, 5th Edition.  
Telephone No. 170.

# JEEWANJI EBRAHIMJI & Co.

ESTABLISHED 1866.

**METAL MERCHANTS & CONTRACTORS,  
IRON AND BRASS FOUNDERS,  
MECHANICAL WORKS.**

SUPPLIERS OF MATERIALS AND TOOLS OF ALL SORTS FOR USE OF  
BUILDINGS, ROADS, BRIDGES, RAILWAYS AND IRRIGATION PURPOSES.

In Reply or Order, kindly quote No. J-

398, FRERE ROAD,

**KARACHI, 16th. Sept: 1915.**  
(CITY).

## MANUFACTURERS

of Watering and Night-Soil Carts, Latrines, Tanks, Ironwork for Roofs and Bridges, Culvert Pipes, Trusses, Surface Boxes, Water and Drainage Works, Fittings, Railings, Brackets, Etc., Etc., Etc.

Casting and Machine Work of every description in Brass, Copper, Metal and Cast Iron.

## SUPPLIERS

of Metals, such as Rolled Steel Beams, Tees, Angles, Plates, Steel Bars and various other sorts.

## ROOFING MATERIALS.

Galvanized, Corrugated and Plain Sheets, Ridging, Gutters, Congo Roofing and Fittings.

## TOOLS.

Pickaxes, Powrahs, Shovels, Jumpers, Hammers, Crowbars and Tools of every description.

## WATER WORKS.

Cast Iron and Galvanized Iron Pipes and Fittings of every sort, Pumps, etc.

## ENGINE REQUISITES.

Leather & Hair Beltings, Asbestos Boards and Packing.

BELLOWS, FORGES, VICES, ANVILS, MANILLA ROPE & FENCING WIRE OF EVERY SORT, SCALDS, ETC., ETC.

*6755  
18.9.15*

The ENGINEER,

Karachi Municipality,

Karachi.

Sir,

With reference to your letter No. E/ 7320 of the 9th. September 1915, I beg to resubmit the Plans for alterations to my house on plot No. 23 A., B-5, Serai Quarter with the Drainage arrangements duly shown thereon.

I beg to remain,

Sir,

Your most obedient servant.

*Lychab Abdul Hussain*

*Sir,*

*It is attached herewith*

*Yours obediently*

*Mubashir. 18.9.15*



166 66-1

100-30-7-15

Form No. 1.

Karachi, 28<sup>th</sup> August 1915.

NOTICE UNDER SECTION 96 OF ACT III OF 1901.

To

THE CHIEF OFFICER AND CHIEF ENGINEER,  
KARACHI MUNICIPALITY.

SIR,

I beg to inform you that I intend <sup>making</sup> building additions and  
alterations to my House on plot No. 23A  
Survey Sheet No. B.5 situate in Jure Road  
Street Serai Quarter.

As required by the rules of the Municipality, I beg to submit herewith 4 copies  
a plan of the same for your approval.

I beg to remain,

Sir,

Your most obedient servant,

*Lye-hai Abdul Haqain*

Signature of the applicant.



No. G. of 9578191 .  
MUNICIPAL CHIEF OFFICER AND  
CHIEF ENGINEER'S OFFICE,

Karachi, 15<sup>th</sup> August 1915.

Forwarded to the Municipal Engineer for favour of disposal.

*[Signature]*

A. M. INST. C. E.,

Chief Officer and Chief Engineer,  
Karachi Municipality.

*Mr. Dinnail*  
*now to Ho*

25<sup>8</sup>/<sub>15</sub>

*[Signature]*



66-2

2

No. E. 6930 of 1915.

## MUNICIPAL ENGINEER'S OFFICE.

Karachi, 25<sup>th</sup> August 1915

MEMO.

The above application is forwarded to the Municipal Health Officer for favour of report.

A. M. I. C. E.,

Engineer,  
Karachi Municipality.

## MUNICIPAL HEALTH OFFICER'S REPORT.

Returned to the Engineer, Karachi Municipality, with the following remarks:—

*No objection*

D. P. H. (London.)  
Health Officer,  
Karachi Municipality.

Date 27-8-1915.

No. E. 7000 of 1915.

## MUNICIPAL ENGINEER'S OFFICE.

Date 27<sup>th</sup> August 1915.

Forwarded to the Building Surveyor for report.

A. M. I. C. E.,

Engineer,  
Karachi Municipality.

Through

THE LAND SURVEYOR,

Karachi Municipality.

## BUILDING SURVEYOR'S REPORT.

Applicant's name Tyballi Abdool Hussein

Whether he is the owner of the plot on which it is proposed to build Yes

The work proposed Making addition alterations  
in the existing premises on plot no. 23A  
B-5 Sec. 6

Building Surveyor's report  $\delta W_i$ 

The plot on which it is proposed to build  
is Municipal One. There is no objection to  
the permission being granted, from Sanitary  
or ml. point of view. Request yr order.

Date 30 of August 1915.

W. B. Bannan  
Building Surveyor.

Submitted through the Land Surveyor.

## LAND SURVEYOR'S REPORT.

Does the plot come under Alignment *no*

Area of plot

Area under Alignment

Remarks per. With reference to this I beg to report  
that there is no objection to permission to bring  
back about the slot is present one

22nd July

Kauai

Date 3-8-1915

Land Surveyor.

## ORDERS OF THE ENGINEER.

Is sent permission  
ask applicant to show drainage arrangements  
on plan. 1. 2/9/11

Grant permission

V. 20/9/3

A. M. I. C. E.,  
Engineer,  
Karachi Municipality.

No. E.

of 1915

## MUNICIPAL ENGINEER'S OFFICE.

Karachi, 23<sup>rd</sup> Sept 1915.

Submitted to the Managing Committee with a recommendation that  
the plan be approved.

Forwarded

~~By~~

J. Cecil L. Kirby

A. M. I. C. E.,

Engineer,

Karachi Municipality.

Chief Officer  
13.9.15

Through

THE CHIEF OFFICER &amp; CHIEF ENGINEER,

KARACHI MUNICIPALITY.

## RESOLUTION OF THE MANAGING COMMITTEE.

Resolution No. \_\_\_\_\_ Date \_\_\_\_\_

16/26/15  
25/19/15



67

8742

To,

The Engineer

Karachi. Amn. eng. off.

Sir,

With reference to this  
they to report that there is now  
no objection to permission  
to be granted as the  
drainage line has been  
shown on the block plan.

Yours absolutely

Nathaniel

E. O.  
24/15

20/15.

68



154



69

200-23-6-15.

Form No. 2.

## ORDERS UNDER SECTION 96 (2) OF ACT III OF 1910.

No. E/

7794 OF 1915.

MUNICIPAL ENGINEER'S OFFICE,

Karachi, 25<sup>th</sup> September 1915.

## MEMO:

With reference to his application, dated 4<sup>th</sup> August 1915, Mr. Turram Amal is informed that the plan submitted by him for building a house on plot No. 14 Survey Sheet A 26 situate in Goolmahamed Street, Trapez Quarter, is approved, and permission to build in accordance therewith is granted. The building to be erected subject to the Byelaws and Rules of the Municipality.

J. Cecil L. Verby  
A.M. INST. C.E.,

Engineer,  
Karachi Municipality.

NOTE 1.—This pass does not give permission to occupy Municipal land with building materials. This can only be allowed when the street is wide enough to permit building materials being deposited on it without it being a source of danger to the public, and only then on a hoarding being placed round the land to be occupied, and on payment in advance of fees for occupation of Municipal land, at the following rates :—

|                                                           | Rs. | A. | P.              |
|-----------------------------------------------------------|-----|----|-----------------|
| (1) For the first three months, per square yard, per diem | ... | 0  | 0 $\frac{1}{2}$ |
| (2) For the next three months " " "                       | ... | 0  | 0 1             |
| (3) For any subsequent time " " "                         | ... | 0  | 0 2             |

NOTICE 2.—Windows, steps and doors of the building will not be permitted to project on or overhang any public street or Municipal land.

NOTICE 3.—Plinths will not be allowed to project more than 2" on any public street for ornamental purposes.

145

500-14-7-14.

Form No. 1.

Karachi, 191

NOTICE UNDER SECTION 96 OF ACT III OF 1901.

To

THE CHIEF OFFICER AND CHIEF ENGINEER,

KARACHI MUNICIPALITY.

SIR,

I beg to inform you that I intend building a building  
on plot No. 232

Survey Sheet No. E1 Situate in Mujmoodin  
Street Jail Quarter.

As required by the rules of the Municipality. I beg to submit herewith  
a plan of the same for your approval.

I beg to remain,

Sir,

Your most obedient Servant,

*Edmund Schickel*

Signature of the applicant.

*Mr. Benjamin  
Shaw to H  
24/7/15*

*Dr. J. H. H. H.*

No. G. of 8432 1915

MUNICIPAL CHIEF OFFICER AND  
CHIEF ENGINEER'S OFFICE.

Karachi, 24/7/15 1915

Forwarded to the Municipal Engineer for favour of disposal.

1539  
24.7.15

*Edmund Schickel*

A. M. INST. C. E.

Chief Officer and Chief Engineer,  
Karachi Municipality.

2

No. E. 600<sup>1</sup> of 1915.

## MUNICIPAL ENGINEER'S OFFICE.

Karachi, 24<sup>th</sup> July 1915.

MEMO.

The above application is forwarded to the Municipal Health Officer for favour of report.

*W. L. L. L.*  
A. M. I. C. E.,

*W. L. L. L.* Engineer,  
Karachi Municipality.

## MUNICIPAL HEALTH OFFICER'S REPORT.

Returned to the Engineer, Karachi Municipality, with the following remarks:—

*No objection*

*W. L. L. L.*  
D. P. H. (London.)

*W. L. L. L.*  
Health Officer,  
Karachi Municipality.

Date 27-7-1915.

No. E. 610<sup>2</sup> of 1915.

## MUNICIPAL ENGINEER'S OFFICE.

Date 27<sup>th</sup> July 1915.

Forwarded to the Enquiry Officer for report.

*W. L. L. L.*  
A. M. I. C. E.,

*W. L. L. L.* Engineer,  
Karachi Municipality.

Through

The Land Surveyor,

Karachi Municipality.

## ENQUIRY OFFICER'S REPORT.

Applicant's name Mr. Laidumal Datchand (he is the  
Trustee of the property of Plot no 231 & 1 Jail Br. as  
Whether he is the owner of the plot on which it is proposed to build per consideration submitted by him  
The work proposed to build a house

Enquiry Officer's report Sir I beg to report that there  
is no objection to grant permission the work  
plot is Municipal one  
Date 1<sup>st</sup> September 1915. P. S. Datchand  
Enquiry Officer.

Submitted through the Land Surveyor.

## LAND SURVEYOR'S REPORT.

Does the plot come under Alignment no

Area of plot —  
Area under Alignment —  
Remarks Sir, With reference to this I beg to  
report that there is no objection to grant  
perm. Plot under Municipal control (Zona old)  
Date 27-7 1915 Nashid  
Land Surveyor.

## ORDERS OF THE ENGINEERS.

Grant permission  
Start to build

A. M. I. C. E.,

Engineer,

Karachi Municipality.

70-4

4

No. E. 7659 of 1915

MUNICIPAL ENGINEER'S OFFICE.

Karachi, 23rd Sept 1915.

Submitted to the Managing Committee with a recommendation that the plan be approved.

*Forwarded*

*A. M. I. C. E.*

*Chief Officer Karachi Municipality*

*23.9.15* Through

*J. Cecil L. Verby*

A. M. I. C. E.,

Engineer,

Karachi Municipality.

THE CHIEF OFFICER AND CHIEF ENGINEER,

KARACHI MUNICIPALITY.

RESOLUTION OF THE MANAGING COMMITTEE.

Resolution No. \_\_\_\_\_ Date \_\_\_\_\_

*16264*  
*25/9/15*



71

541

M. I. M. E.,  
Acting Engineer,  
Karachi Municipality.

WALING



72

10

200-23-6-15.

Form No. 2.

## ORDERS UNDER SECTION 96 (2) OF ACT III OF 1910.

No. E/

765-8  
OF 1915

MUNICIPAL ENGINEER'S OFFICE,

Karachi, 22<sup>nd</sup> September 1915.

23

## MEMO:

With reference to his application, dated 24<sup>th</sup> July 1915,  
 Mr. Gudamal Fatechand is informed  
 that the plan submitted by him for building a house  
 on plot No. 232 Survey Sheet 81  
 situate in Dargamoodi Street, Jail  
 Quarter, is approved, and permission to build in accordance therewith is  
 granted. The building to be erected subject to the Byelaws and Rules of the  
 Municipality.

J. Cecil L. Verky

A.M. INST. C.E.,

Engineer,

Karachi Municipality.

NOTE 1.—This pass does not give permission to occupy Municipal land with building materials. This can only be allowed when the street is wide enough to permit building materials being deposited on it without it being a source of danger to the public, and only then on a hoarding being placed round the land to be occupied, and on payment in advance of fees for occupation of Municipal land, at the following rates :—

|                                                           | Rs. | A. | P.              |
|-----------------------------------------------------------|-----|----|-----------------|
| (1) For the first three months, per square yard, per diem | ... | 0  | 0 $\frac{1}{2}$ |
| (2) For the next three months " " "                       | ... | 0  | 0 1             |
| (3) For any subsequent time " " "                         | ... | 0  | 0 2             |

NOTICE 2.—Windows, steps and doors of the building will not be permitted to project on or overhang any public street or Municipal land.

NOTICE 3.—Plinths will not be allowed to project more than 2" on any public street for ornamental purposes.

73  
No. E. 7660/1915



KMR.CDD.MiQ.1914-1921.01

(200-29-6-15.)

Form No. 5.

MUNICIPAL ENGINEER'S OFFICE,

Karachi, 22<sup>nd</sup> September 1915  
23<sup>rd</sup>

MEMO.

Building Inspector Jail is informed

that Mr. Sudamal Fatechand has been permitted

to build his house

on plot No. 232. E. Dargamuddin Street, Jail

Quarter. Report should be made to the undersigned when the house is completed.

*J. Cecil L. Verby*

A. M. INST. C. E.,

Engineer,

Karachi Municipality.

Thro. the Health Officer  
Karachi Municipality

(200-29-6-15.)

Form No. 5.

No. E. 7661 1915

MUNICIPAL ENGINEER'S OFFICE,

Karachi, 22<sup>nd</sup> September 191523<sup>rd</sup>

MEMO.

Building Inspector \_\_\_\_\_ is informed

that Mr. Sudumal Fateshand has been permittedto build his houseon plot No. 232, E. Muzmudeni Street, Jail

Quarter. Report should be made to the undersigned when the house is  
completed.

J. C. B. L. Parby

A. M. INST. C. E.,

Engineer,

Karachi Municipality.

P. B.



75-1

Municipal Office,

Karachi 3rd September 1915

From,

J. Cecil L. Verley. Esquire. A. M. Inst. C. E.

Engineer,

Karachi Municipality.

To,

Gidamal Fatechand Esquire,

Karachi.

Sir,

I have the honor to acknowledge the receipt of the order of the Court appointing you as one of the trustees for the property on plot No. 232-E-1 Jail Quarter and return back the same as desired. Permission to build as per plan submitted will follow.

I have the honor to be,

Sir,

Your most obedient servant,

*J. Cecil L. Verley*  
A. M. Inst. C. E.

Engineer,

Karachi Municipality.

\*\*\*\*\*

N<sup>o</sup>. E. 7217 of 1915.

Municipal Office

Karachi 3rd September 1915

Copy forwarded to the Land Surveyor

to show Undersigned plan on ground.

7c is attached herewith

Yours obediently  
Mulchand

6/9/15

ackd 78

Nadil

4 9/18

875

*J. Cecil L. Verley*  
A. M. Inst. C. E.

A. M. Inst. C. E.

Engineer,

Karachi Municipality.

Sir,

Sir,

Rept is made in the  
printed form

Yours obediently  
Mulchand

8/9/15

$75 - 2$ 

Nadri's

21  
27.5

21.9.15

25



76

No. E. 726 of 1915,  
Municipal Office,  
Karachi 3rd September 1915

From,

J. Cecil L. Verley, Esquire, A. M. Inst. C. E.  
Engineer,  
Karachi Municipality.

To,

Gidamal Fatechand Esquire,  
Karachi.

Sir,

I have the honor to acknowledge the receipt of the order of the Court appointing you as one of the trustees for the property on plot No. 232-B-1 Jail Quarter and return back the same as desired. Permission to build as per plan submitted will follow.

I have the honor to be,

Sir,

Your most obedient servant,

*J. Cecil L. Verley*  
A. M. Inst. C. E.

Engineer,

Karachi Municipality.

\*\*\*\*\*

No. E. 727 of 1915.

Municipal Office

Karachi 3rd September 1915

Copy forwarded to the Land Surveyor  
to show Undersigned plan on ground.

*J. Cecil L. Verley*

A. M. Inst. C. E.

Engineer,

Karachi Municipality.

SB



No: 8.

2/10/15

Municipal Office


Karachi 1<sup>st</sup> Sept. 1915

8.

Gidamal Fatehchand Esq.  
Karachi.

Sir,

I have the honor to acknowledge the receipt of the order of Court appointing you as one of the trustees for the property on Plot No. 232 E1 Jail Av. & return back the same as desired. Permission to build as per plan submitted will soon follow.

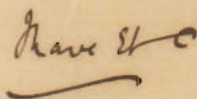Yours etc  


Y.

J.M. Inst., C.E.,  
Engineer,

Karachi Municipality.

By  
 Copy to L. Surveyor to show up  
 plan on ground.

78-1

*Could Lawyer  
to attach the  
& report. The  
court may be relieved  
under provisions.  
27/8/15*



Karachi 21 st August 1915.

To,

The Engineer,

Karachi Municipality,

K a r a c h i .

Sir ,

With reference to your no E. 6168 of 28/29 July last, I have the honour to enclose herein the order of the Court under which I have been appointed Trustee along with others and have applied to the Municipality

I shall thank you to return me the enclosed order of the court when done with.

I have the honour to be,

Sir,

Yours most obedient servant

*Gudramal Jethabhai*

*Sir,*

*J.C. is attached herewith  
yours obediently*

*Mulchand 28/8/15*

79  
No. E.

6196  
Heritage  
of 1915

KMR.CDD.MiQ.1914-1921.01

Municipal Office,

Karachi, 28. 7. 1915.

MEMO:—

With reference to <sup>his</sup>~~their~~ application dated

Mr. Sidramab Fatihchand <sup>is</sup>~~are~~  
Messrs.  
informed that plot No. 232-81 — face quarter

does not stand in the Land Register in <sup>his</sup>~~their~~ name. <sup>He is</sup>~~They are~~ therefore

requested to produce any documentary evidence to prove <sup>his</sup>~~their~~ ownership,

when <sup>his</sup>~~their~~ request for a pass will be considered.

J. Cecil L. Verby

A. M. INST. C. E.,

Engineer,

Am Karachi Municipality.

D.




# JAIL QUARTER PLAN

SHOWING ADDITIONS ON PLOT N<sup>o</sup> 232 - E  
SCALE 8" = 1"




APPROVED  
*Carl L. Kirby*  
A.M. Engineer  
Karachi Municipal


GROUND PLAN

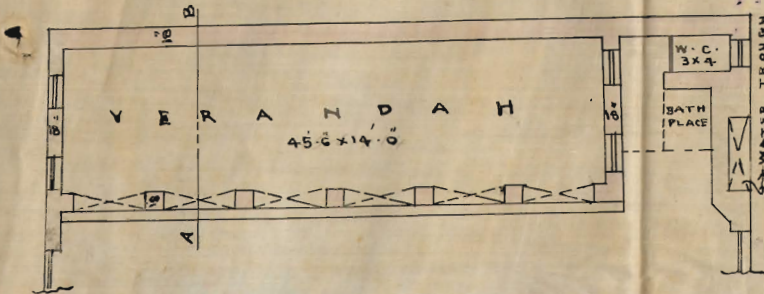

SECTION ON A-B

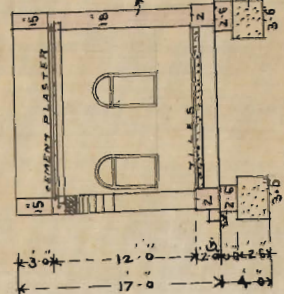


ELEVATION

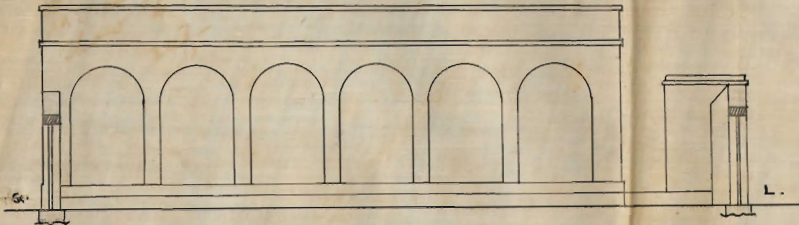


SITE PLAN


JAMES TERRACE  
87'-0" WIDE

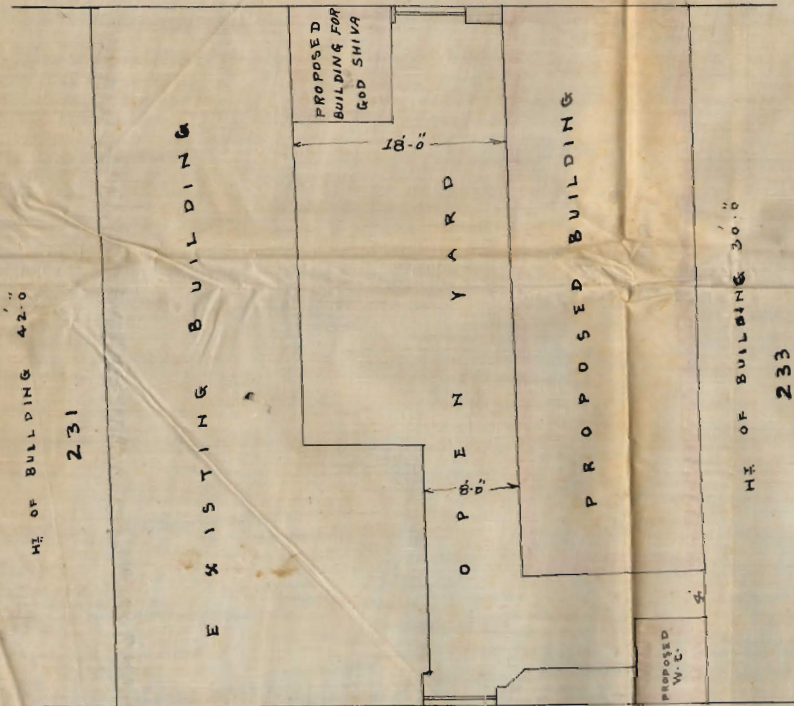

PLAN

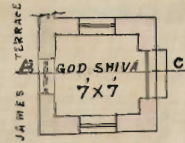

SECTION ON B-C

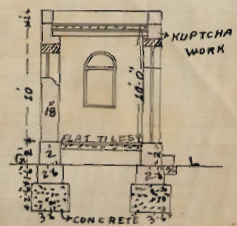

N J M O O D I N

WIDE 49'-4"

navlakham T.  
Surveyor

500—14-7-14.

Form No. 1.

Karachi, 20- 7- 1915

## NOTICE UNDER SECTION 96 OF ACT III OF 1901.

To

THE CHIEF OFFICER AND CHIEF ENGINEER,  
KARACHI MUNICIPALITY.

SIR,

I beg to inform you that I intend building addition of shed  
on plot No. 1/14, 1/15 & 120

Survey Sheet No. G 4 Situate in \_\_\_\_\_

Street Sudder Bazar Quarter.

As required by the rules of the Municipality. I beg to submit herewith  
a plan of the same for your approval.

I beg to remain,

Sir,

Your most obedient Servant,

per pro N E Dinsdale

Signature of the applicant.

Signature of the applicant.

No. G. of 8281 1915

MUNICIPAL CHIEF OFFICER AND  
CHIEF ENGINEER'S OFFICE.

Karachi, 20<sup>th</sup> July 1918

Forwarded to the Municipal Engineer for favour of disposal.

A. M. INST. C. E.

Chief Officer and Chief Engineer,  
Karachi Municipality.

2


No. E. 5934 of 1915

## MUNICIPAL ENGINEER'S OFFICE.

Karachi, 20<sup>th</sup> July 1915.

MEMO.

The above application is forwarded to the Municipal Health Officer for  
favour of report.

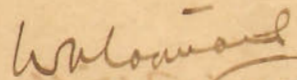


A. M. I. C. E.,

In Engineer,

Karachi Municipality.

## MUNICIPAL HEALTH OFFICER'S REPORT.

Returned to the Engineer, Karachi Municipality, with the following  
remarks:— *No objection because outhouses  
& a shop are used as godowns*

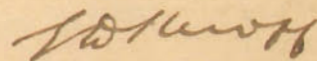

D. P. H. (London.)

Health Officer,

Karachi Municipality.


Date 21-7-1915.

No. E. 5958 of 1915

## MUNICIPAL ENGINEER'S OFFICE.

Date 24 July 1915.

Forwarded to the Enquiry Officer for report.

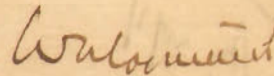

A. M. I. C. E.,

In Engineer,

Karachi Municipality.

Through

The Land Surveyor,

Karachi Municipality.



81-3

3

## ENQUIRY OFFICER'S REPORT.

Applicant's name

Mr. Abdul Din Shah

Whether he is the owner of the plot on which it is proposed to build

Yes

The work proposed

addition of shed

Enquiry Officer's report

Sir, I beg to report that the shed will obstruct the air & light of the shops & request your order.

Admural

Date

27-7-1915

Enquiry Officer.

Submitted through the Land Surveyor.

## LAND SURVEYOR'S REPORT.

Does the plot come under Alignment

No.

Area of plot

LS. 2733

Area under Alignment

Remarks

Sir, With reference to this I beg to report that the shed will obstruct the air & light of the shops & request your order.

Admural

Date

22-7-1915

Land Surveyor.

## ORDERS OF THE ENGINEERS.

Sgt. C. C. Brown on objection.

30/7/15

Jasul Parsi

A. M. I. C. E.,

Engineer,

Karachi Municipality.

L. Surveyor  
for the point  
on the plot  
1-28/7/15  
must find  
order  
M

2706  
29.7.15



81-4

No. E.

4

7671

of 1915

## MUNICIPAL ENGINEER'S OFFICE.

Karachi, 22nd September 1915.

Submitted to the Managing Committee with a recommendation that  
the plan be approved.

*Forwarded**A. M. I. C. E.**J. Cecil L. Verby*

A. M. I. C. E.,

Engineer,

Karachi Municipality.

*Chief Officer Karachi Municipality.*

23.5.15

Through

THE CHIEF OFFICER AND CHIEF ENGINEER,

KARACHI MUNICIPALITY.

## RESOLUTION OF THE MANAGING COMMITTEE.

Resolution No. \_\_\_\_\_ Date \_\_\_\_\_

*16263*  
*25/9/15*



## ORDERS UNDER SECTION 96 (2) OF ACT III OF 1910.

No. E/

7723 OF 1915

MUNICIPAL ENGINEER'S OFFICE,

Karachi, 23<sup>rd</sup> September 1915.

## MEMO:

With reference to his application, dated 27<sup>th</sup> March 1915, Mr. Jayashanker Inadhang is informed that the plan submitted by him for building a house on plot No. 34, 34 a Survey Sheet C6 situate in \_\_\_\_\_ Street, Inadhang Quarter, is approved, and permission to build in accordance therewith is granted. The building to be erected subject to the Byelaws and Rules of the Municipality.

A.M. INST. C.E.,

Engineer,

Karachi Municipality.

NOTE 1.—This pass does not give permission to occupy Municipal land with building materials. This can only be allowed when the street is wide enough to permit building materials being deposited on it without it being a source of danger to the public, and only then on a hoarding being placed round the land to be occupied, and on payment in advance of fees for occupation of Municipal land, at the following rates:—

|                                                           | Rs. | A. | P.              |
|-----------------------------------------------------------|-----|----|-----------------|
| (1) For the first three months, per square yard, per diem | ... | 0  | 0 $\frac{1}{2}$ |
| (2) For the next three months " " "                       | ... | 0  | 0 1             |
| (3) For any subsequent time " " "                         | ... | 0  | 0 2             |

NOTICE 2.—Windows, steps and doors of the building will not be permitted to project on or overhang any public street or Municipal land.

NOTICE 3.—Plinths will not be allowed to project more than 2" on any public street for ornamental purposes.

Amended 9 June file  
1916 Sep No 22.

83-1

No. 3449 of 1915.

Revenue Department,

Collector's Office,

Karachi, 14th September 1915.

Read letter No. 2424 dated the 9th September 1915

-----\*

Permission to build a shop and \* from the City Deputy  
 dwelling house on survey number 34 \* Collector Karachi, on  
 plus 34 A, (sheet C-6) Market Quarter. \* the subject noted in  
 \*\*\*\*\* the margin.

Reply of the Collector of Karachi.


S a n c t i o n e d.

Sd. J. W. Smyth,

Acting, Collector of Karachi.

To,

The City Deputy Collector Karachi, (with the plan).

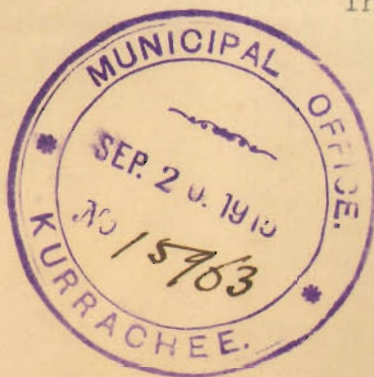

No. 2531 of 1915.

Revenue Department,

City Deputy Collector's Office,

Karachi, 18th September 1915.

Copy forwarded for information to the Engineer  
 Karachi Municipality with reference to his endorsement  
 No. E/ 6808 dated 19th August 1915.

City Deputy Collector.

H. H. V.

It is attached herewith 18/9/15.

yours obediently

M. A. D. 21/9/15

Ls. 8780

With reference to this I  
beg to report that there is now  
no objection to permission  
to be granted.

Yours truly  
Nathan

22/15.



84-1

No

6807

of 1915.

Municipal Office.

Karachi. 18th August 1915.

19<sup>th</sup>

MEMO / -

With reference to his application dated 9th inst. with a set of amended plans for building a house on plot No. 74 & 74A, C-6 Market Quarter Mr. Jayashanker Madhuji is requested to apply for permission to the City Deputy Collector with two copies of plans returned herewith duly signed and approved. He must not start any building operation until he hears further from this office.

*J. Cecil L. Turkey*

A. M. Inst. C. E.,

E n g i n e e r

Karachi

Muni

\*\*\*\*\*

No E

6806

Municipal Office

Karachi. 18th August

19<sup>th</sup>

Copy forwarded to the City Deputy Collector with reference to his No. 536 dated 27th February 1914.

*J. Cecil L. Turkey*

A. M. Inst. C. E.,

E n g i n e e r

Karachi

Municipality.

B

The other Papers are attached with  
question Papers.

Karachi,

85-1

Engineer  
9/8/15

To be attached to  
report  
9/8/15

To

The Chief Officer Chief Engineer  
Karachi Municipality

Karachi

5456  
10/8/15

Sir,

with reference to your <sup>L.</sup> No. 7864 of 6<sup>th</sup> July  
I beg to submit herewith a plan fresh plan  
for a house on Plots No 34 & 34 A. Street C. 6  
Market Quarter for favour of your approval  
The old plans submitted some time ago may  
be returned.

I beg to remain

Sir

Your most obedient servant

Gopalchandra Madhavi  
for Madhavi, Vishwaji

Sir

As attached herewith

Yours truly

Bhawan. D. 12/8/15

85-2

The Chief Officer of the  
Karachi Municipality

Forwarded to the

Health Officer for review  
of reports.




No objection  
16/11/15

Land Surveyor

Sd/- V. 14/11/15  
has been made on  
the proposed application from  
the  
Karachi

Direct Collector  
General  
2.1.16

(200-29-6-15.)

Form No. 5.

No. E.

1915

MUNICIPAL ENGINEER'S OFFICE,

Karachi, 23<sup>rd</sup> September 1915-

MEMO.

Building Inspector

is informed

that Mr. Jayashanker Dhadhamp has been permittedto build his houseon plot No. 34, 34a C6 Street, Dorabai

Quarter. Report should be made to the undersigned when the house is

completed.

J. Cecil L. Verby

A. M. INST. C. E.,

Engineer,

Karachi Municipality.

B. B.  
n



87

(200-29-6-15.)

Form No. 5.

No. E. *77<sup>th</sup>* 191<sup>5</sup>

MUNICIPAL ENGINEER'S OFFICE,

Karachi, *23<sup>rd</sup>* September 191<sup>5</sup>

MEMO.

Building Inspector

*Market**As* is informedthat *Mr. Jayashanker Madhwa* has been permittedto *build* his houseon plot No. *34, 34a* *C6* Street, *Market*

Quarter. Report should be made to the undersigned when the house is

completed.

*J. Cecil L. Verby*

A. M. INST. C. E.,

Engineer,

*Through the Health Officer**Karachi Municipality**Dr* Karachi Municipality.*JS*

APPROVED.



# PLAN OF PROPOSED HOUSE


ON PLOT NOS 34 &amp; 34A SHEET C.G

MARKET Q.B.


SCALE 8" = 1"

A.M. Inst.,  
Engineer,  
Karachi Municipality


*for Mathariji Vishwajee Vyas  
Jalashankar Mathariji Vyas.*

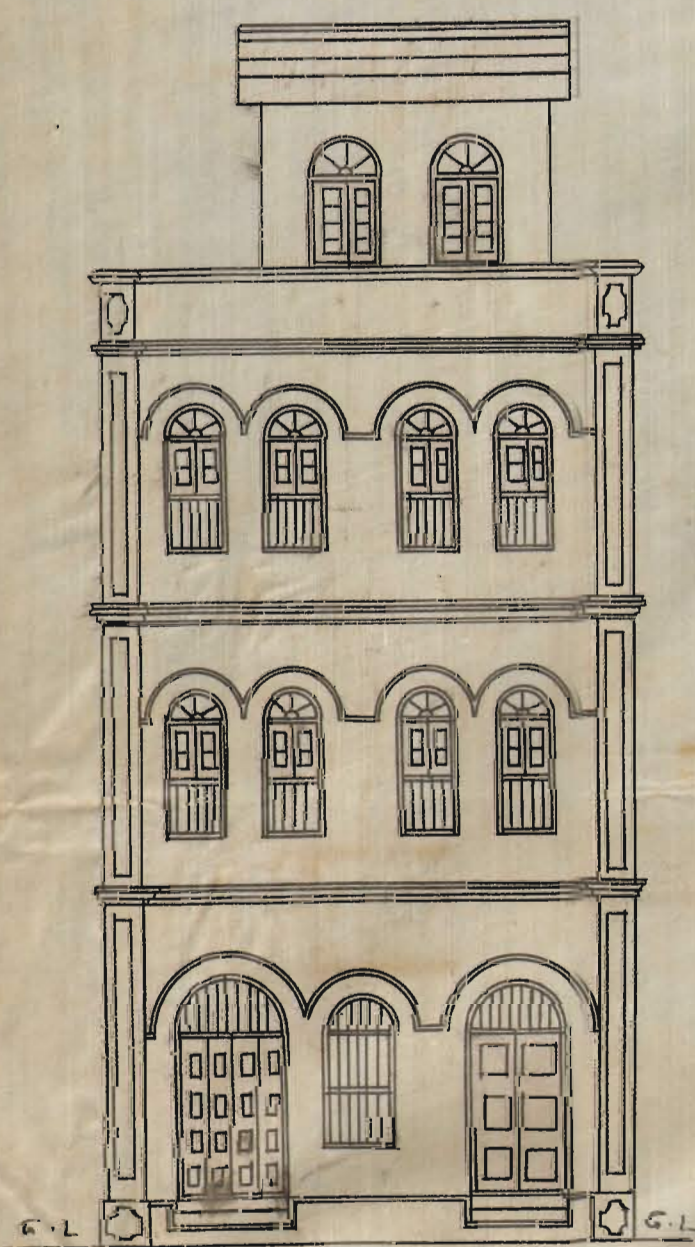


ELEVATION

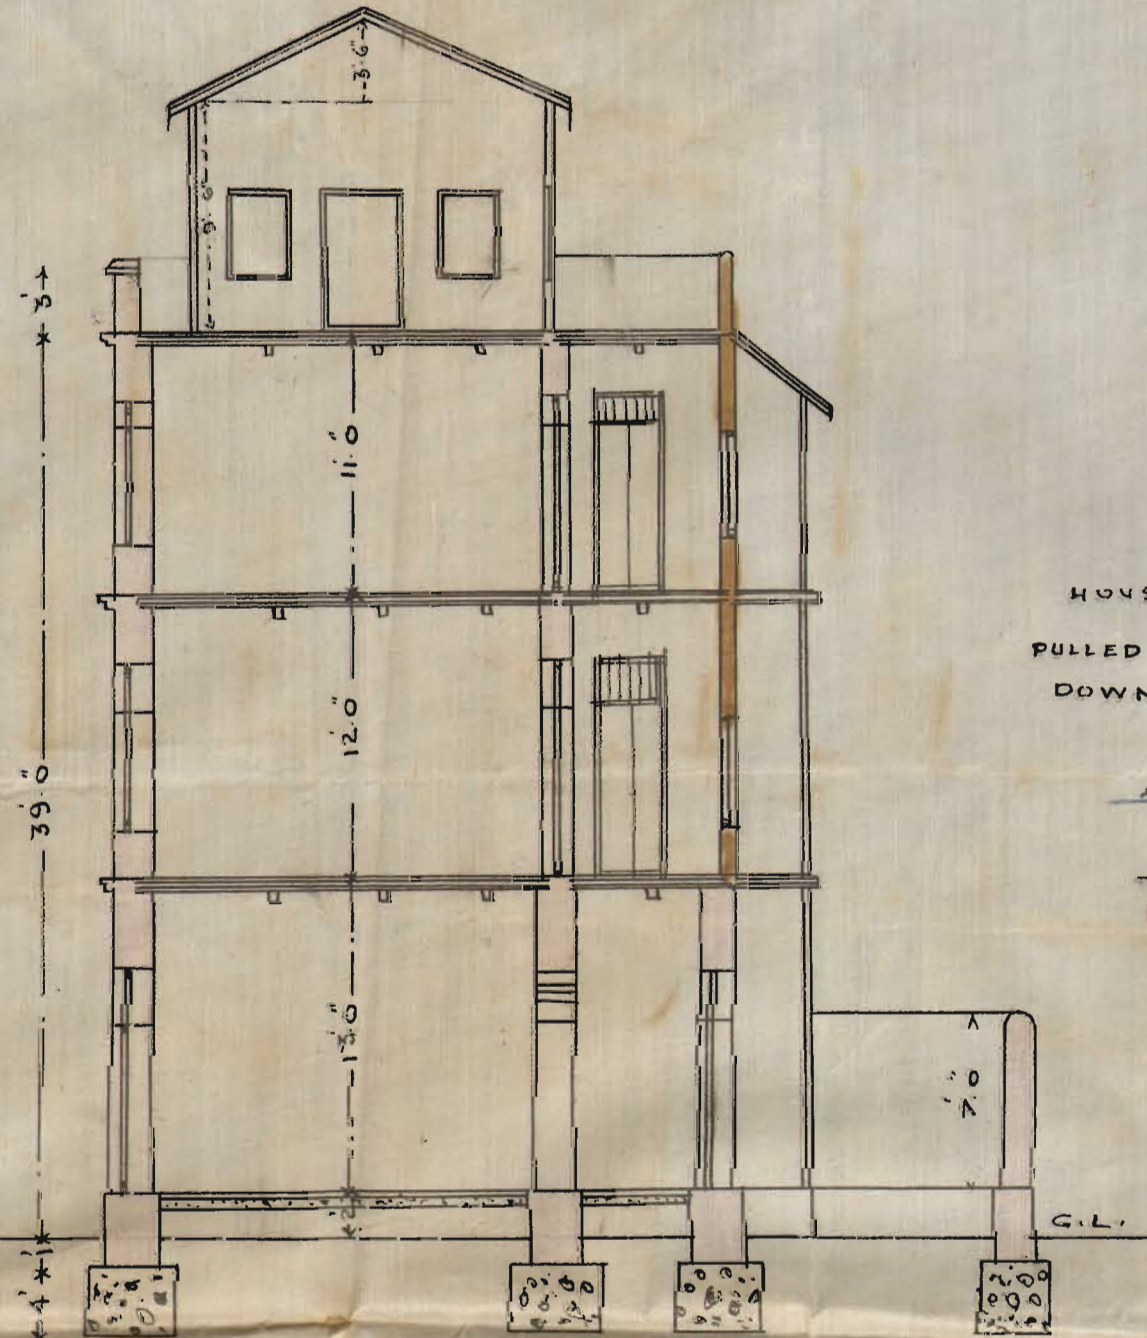


SECTION ON A.B.

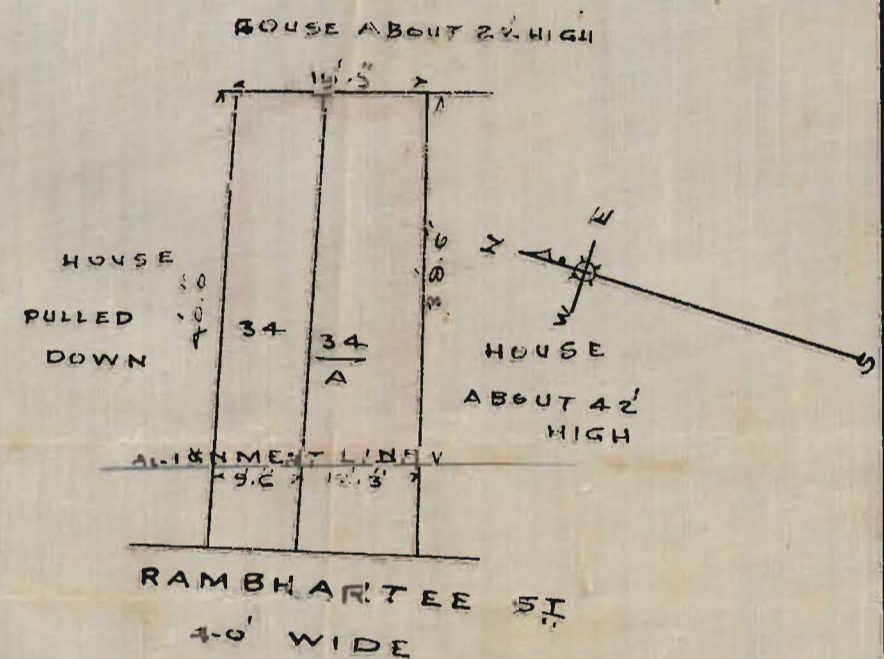


M. Nazareth 9th Aug 15

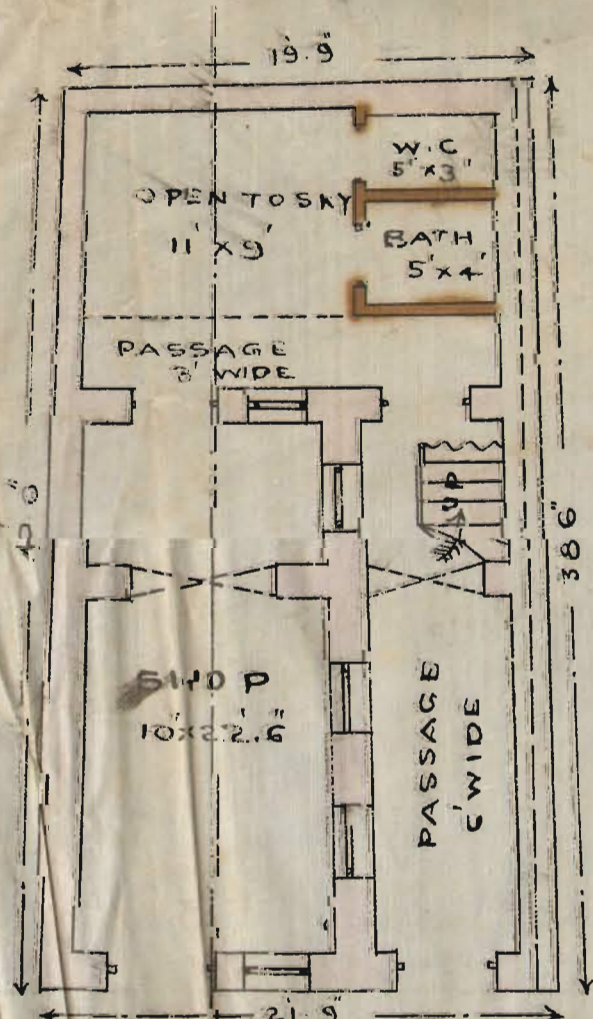B.A.L.C.E.  
ARCHITECT & ENGINEER,  
OPPOSITE PARSII THEATRE.


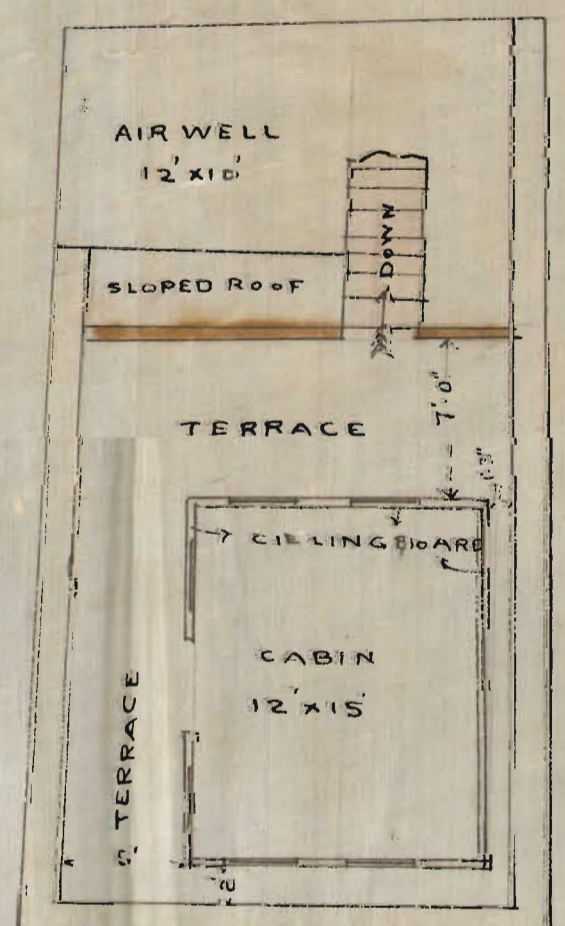
PLAN OF GROUND FLOOR

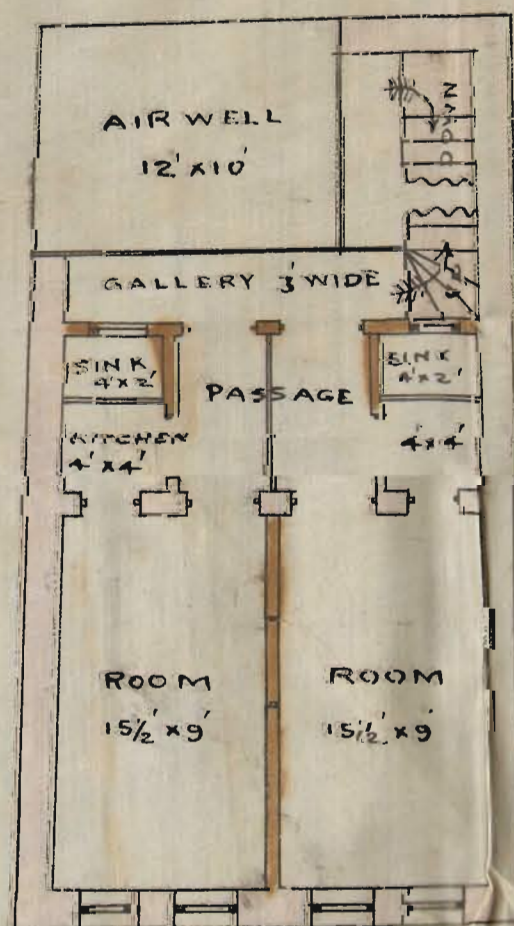

PLAN OF 1ST FLOOR

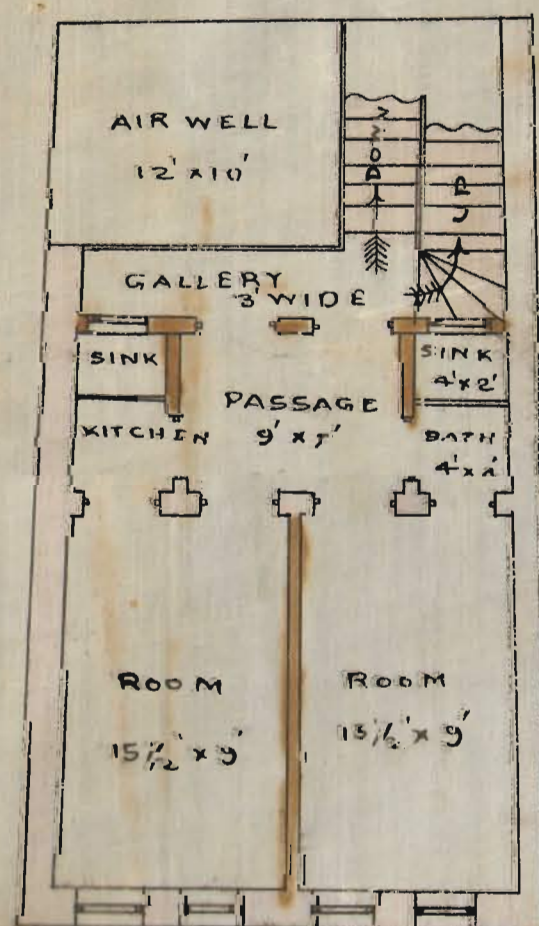

PLAN OF 2ND FLOOR



PLAN OF 3RD FLOOR




# PLAN OF PROPOSED HOUSE

ON PLOT NO 34 & 34A SHEET C.6


MARKET Q 5

SCALE 8 = 1


*for Madhanga Mohan Singh  
Jatunbader Madhanga Singh*

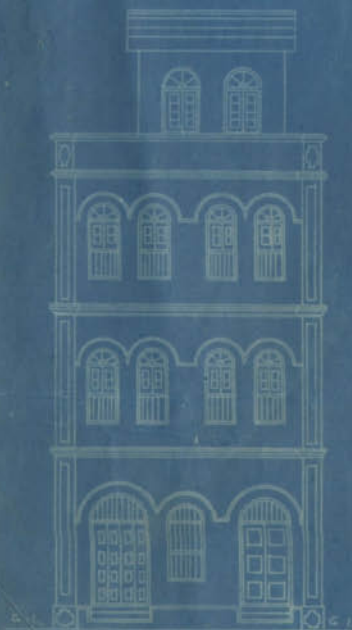


ELEVATION

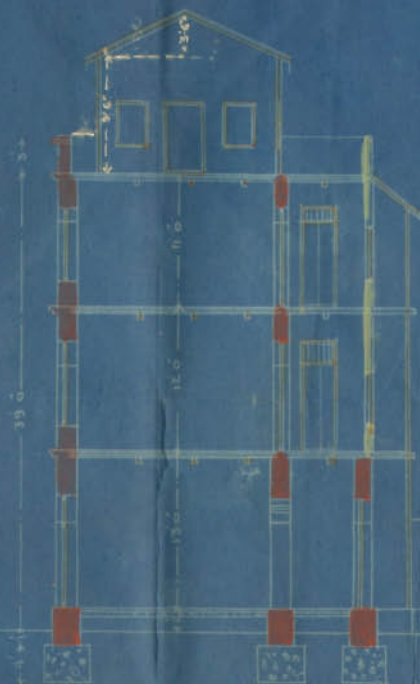


SECTION ON A.B.

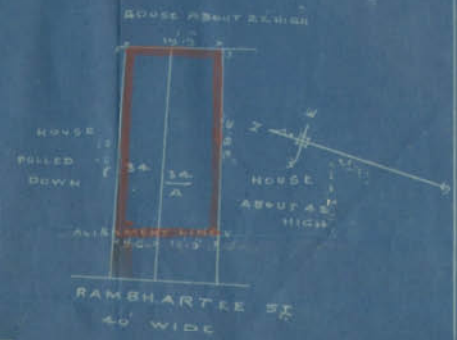

*M. Nayanath 9th Aug 15*  
ARCHITECT & ENGINEER  
OPPOSITE PANGI THEATRE

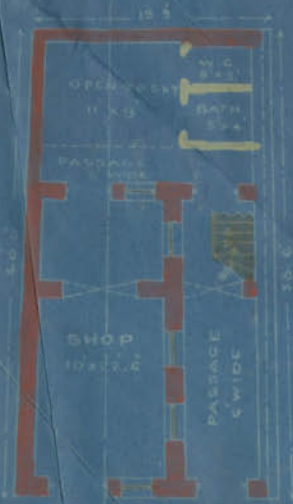

PLAN OF GROUND FLOOR

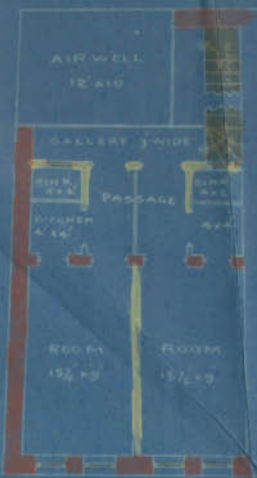

PLAN OF 1ST FLOOR



PLAN OF 2ND FLOOR



PLAN OF 3RD FLOOR

No. E/- 3246 of 1915.

Municipal Office,  
Karachi, 17th April 1915.

M e m o :-

With reference to their application dated the 27<sup>th</sup> ultimo, with sets of four plans for the house to be rebuilt on plot No. 34 & 34 A, C-6, Rambaugh Street, Market Quarter, Messrs: Jaiy Shanker Mahadeoji & Madhowji Vishinji are informed that the matter <sup>is</sup> under consideration and he should not commence building until he hears from the undersigned, as the portion of the above plot comes under alignment.

*J. Cecil L. Verby*

A. M. Inst. C. E.,

Engineer,

Karachi Municipality.

*M. B.*



91

no 6

of 1915.

Municipal office

Karachi 16<sup>th</sup> April 15**URGENT**

Memo.

With reference to this  
 application dated the 27<sup>th</sup>  
 ultimo, with sets of four plans  
 for the house to be rebuilt on  
 plot no 34 +  $\frac{3}{4}$  of Ramlah  
 Street, Market for art. messrs  
 Jai Shankar Prasadji &  
 Madhavi Vishaji are again  
 that the matter must be considered  
 & be shown not commenced building  
 as the portion of the plot comes  
 under the adjacent scheme.

could be heard  
 from the up.

A.M. Inst., C.E.,

Engineer,

Karachi Municipality.

URGENT

92

Building Surveyor please as it will cover  
 the matter under consideration, & at the  
 same time find permission granted to  
 slots No. 1  $\frac{1}{4}$ , 3  $\frac{4}{5}$  and 17 of March 22.

This is most urgent

34/3/18

1918 Part II

1 Part III Dec. 1907

2 Part IV 1908

Slip 14

Nach









PLAN OF PROPOSED HOUSE  
ON PLOT Nos 34/A & 34/B SHEET C 6

MARKET Q R


SCALE 8' = 1"

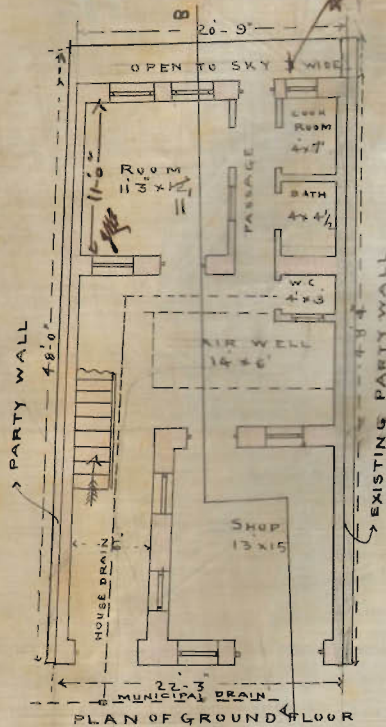


RAMBHARTEE ROAD

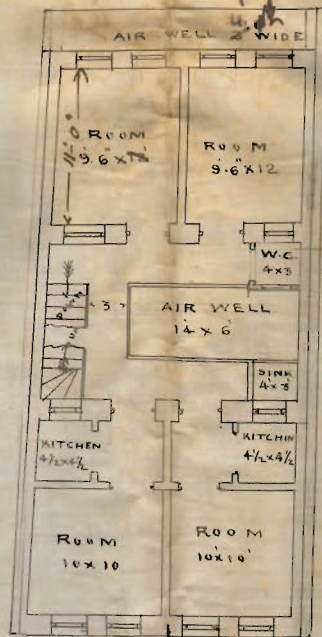


NOTE:-  
IN THE 2<sup>ND</sup> FLOOR  
SINK WILL BE  
PROVIDED INSTEAD.

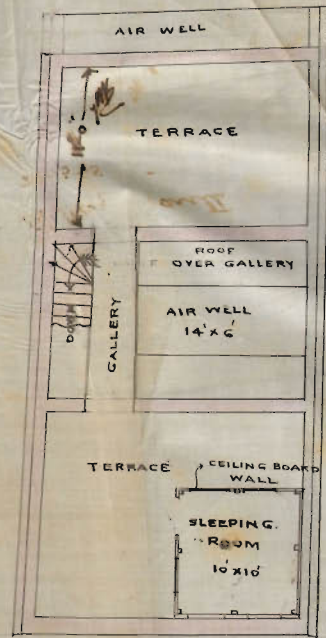

PLAN OF III FLOOR.

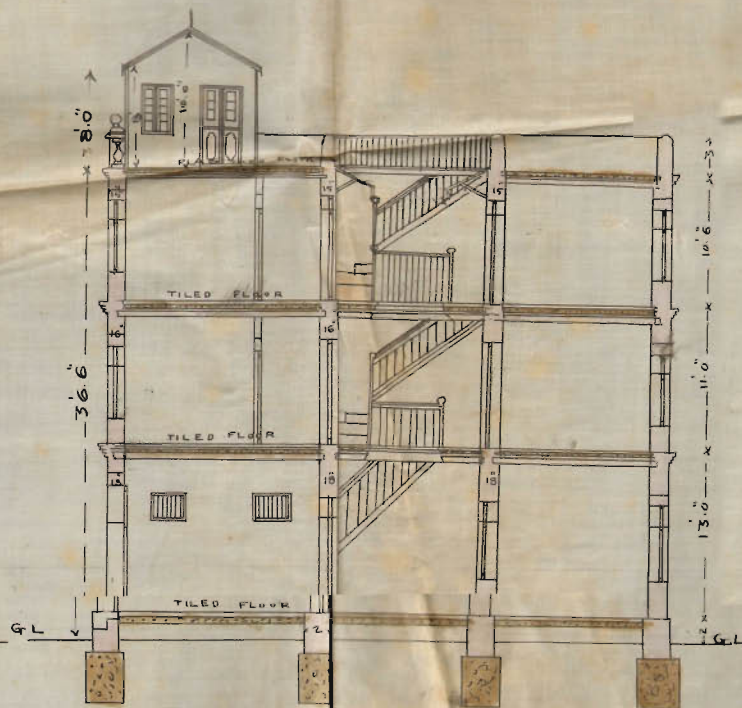


BLOCK PLAN  
SCALE 20' = 1"

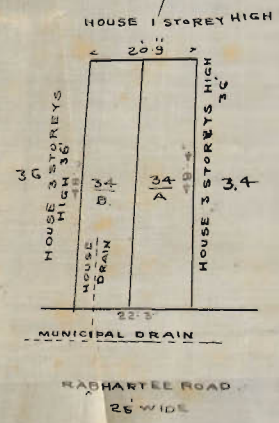


M. Narasimha  
B.A., L.C.E.  
27-3-15 ARCHITECT & ENGINEER  
OPPOSITE PARI THEATRE


PLAN OF PROPOSED HOUSE  
ON PLOT N<sup>o</sup> 34/A & 34/B SHEET C 6  
MARKET Q<sup>o</sup>  
SCALE 8" = 1"

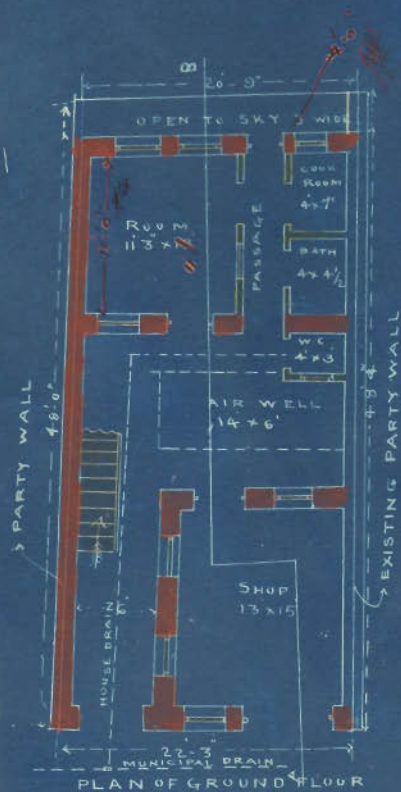

RAMBHARTEE ROAD

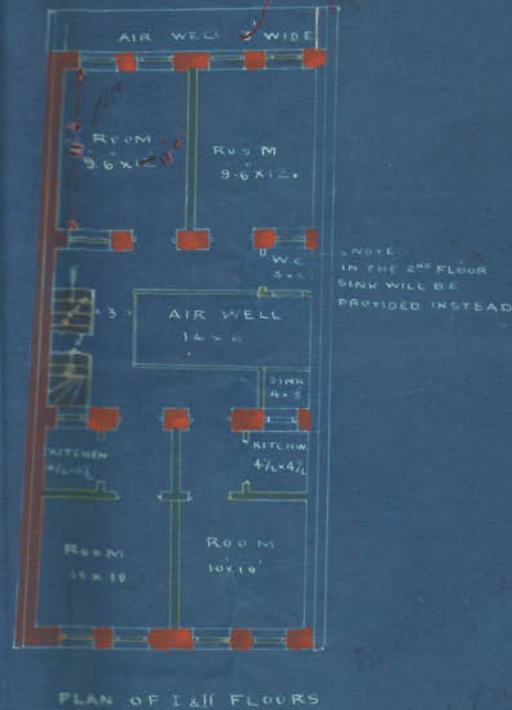


FRONT ELEVATION

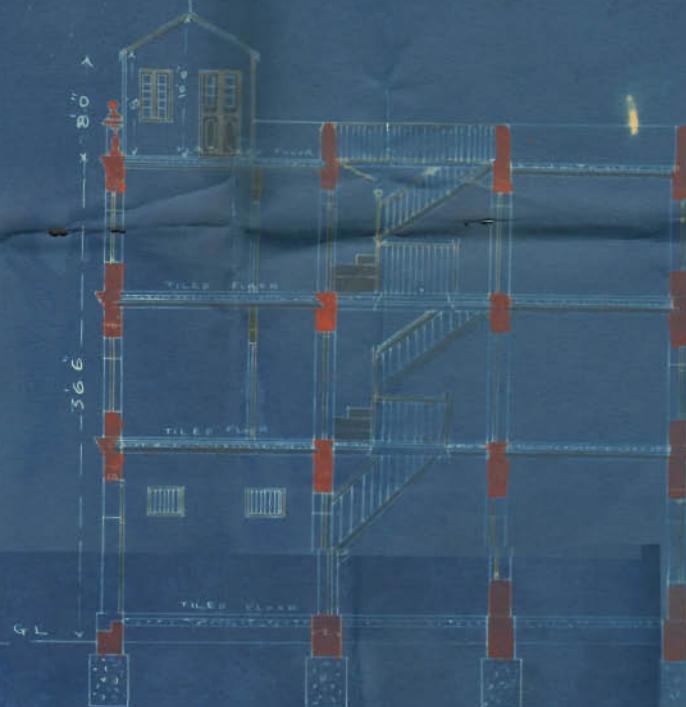

SECTION ON A-B

BLOCK PLAN  
SCALE 20" = 1"

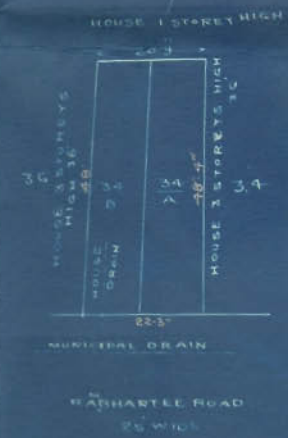

M. Ramaswami  
ARCHITECT & ENGINEER  
OPPOSITE PABAI THEATRE

95

No E 6502 of 1915.

Municipal Office.

Karachi. 7th August 1915.

MEMO / -

With reference to his application dated 24th July 1915 with a set of plans for building an upper storey to his house on plot No. 165A, -A-21 Napier Quarter Mr: Miran and Mulchand is requested to apply for permission to the City Deputy Collector with two copies of plans returned herewith duly signed and approved. He must not start any building operation until he hears further from this office,...

*J. Cecil B. Kerby*  
A. M. Inst. C. E.,

Engineer,

Karachi Municipality.

\*\*\*\*\*

No E 6503 of 1915.

Municipal Office.

Karachi. 7th August 1915.

Copy forwarded to the City Deputy Collector with reference to his No. 536 dated 27th February 1914.

*J. Cecil B. Kerby*

A. M. Inst. C. E.,

Engineer,

Karachi Municipality.

118

No. 3392 of 1915.

Revenue Department,

Collector's Office,

Karachi, September 1915.

Read letter No. 2338 dated the 27th August 1915 from

-----\*  
Permission to build a dwelling the City Deputy  
\*  
house on survey number 105 A \* Collector of Karachi  
\*  
(sheet A,21) Napier Quarter. \* on the subject noted  
\*\*\*\*\*  
in the margin.

Reply of the Collector of Karachi.

Sanctioned.

Sd. J. W. Smyth,

Acting Collector of Karachi.

To,

The City Deputy Collector, Karachi (with the plan).



No. 2487 of 1915.

Revenue Department,

City Deputy Collector's Office,

Karachi, 14th September 1915.

*Land Survey  
to attach  
report*

Copy forwarded for information to the Engineer  
Karachi Municipality with reference to his endorsement  
No. E/.6503 dated 9th August 1915.

*Benning*

City Deputy Collector.

*B.*


Sir

It is attached herewith

*over ready  
holder*

H. *14/9/15* V.

14/9/15.

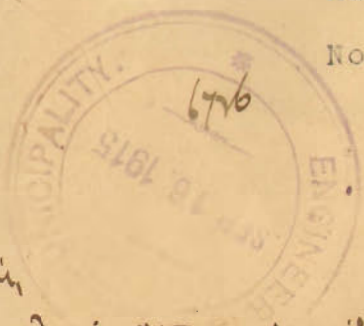

Sir,

With reference to this I beg to  
 report that now pension can  
 be granted as the C.O.'s sanction  
 has been received. Request yr.  
 order.

Yours sincerely

SMB am an

18/9/15

A20

E.O

20.9.15



(200-29-6-15.)

Form No. 5.

No. E.

7668/1915

MUNICIPAL ENGINEER'S OFFICE,

Karachi, 21<sup>st</sup> September 191523<sup>rd</sup>

MEMO.

Building Inspector

is informed

that

Mr. Kuranand Mulchand

has been permitted

to

build an upper story on

his house

on plot No. 105A.

220 Prince of Wales Street

Street

Napier

Quarter. Report should be made to the undersigned when the house is

completed.

J. Cecil L. Verby

A. M. INST. C. E.

Engineer,

Karachi Municipality.

An

18



98

(200-29-6-15.)

Form No. 5.

No. E.

7668/1915

MUNICIPAL ENGINEER'S OFFICE,

Karachi, 21<sup>st</sup> September 1915  
W.W.

MEMO.

Building Inspector

Dapui

is informed

that Mr. Anand Mulchand has been permitted

to build an upperstory on his house

on plot No. 105A, Old River Embankment Street

Dapui

Quarter. Report should be made to the undersigned when the house is

completed.

J. Cecil L. Percy

A. M. INST. C. E.,

Engineer,

Karachi Municipality.

Through the Health Officer

Karachi Municipality

ORDERS UNDER SECTION 96 (2) OF ACT III OF 1910.

No. E/

7666

OF 1915.

MUNICIPAL ENGINEER'S OFFICE,

Karachi, 21<sup>st</sup> September 1915.

MEMO:

With reference to his application, dated 24<sup>th</sup> July 1915,  
Mr. Huanand Mulchand is informed  
that the plan submitted by him for building an upper story  
on plot No. 105 a. Survey Sheet 221  
situate in River Embankment Street, Drapier  
Quarter, is approved, and permission to build in accordance therewith is  
granted. The building to be erected subject to the Byelaws and Rules of the  
Municipality.

J. Cecil L. Verkey

A.M. INST. C.E.,

Engineer,

Karachi Municipality.

NOTE 1.—This pass does not give permission to occupy Municipal land with building materials. This can only be allowed when the street is wide enough to permit building materials being deposited on it without it being a source of danger to the public, and only then on a hoarding being placed round the land to be occupied, and on payment in advance of fees for occupation of Municipal land, at the following rates:—

|                                                           | Rs. | A. | P.              |
|-----------------------------------------------------------|-----|----|-----------------|
| (1) For the first three months, per square yard, per diem | ... | 0  | 0 $\frac{1}{2}$ |
| (2) For the next three months "                           | ... | 0  | 0 1             |
| (3) For any subsequent time "                             | ... | 0  | 0 2             |

NOTICE 2.—Windows, steps and doors of the building will not be permitted to project on or overhang any public street or Municipal land.

NOTICE 3.—Plinths will not be allowed to project more than 2" on any public street for ornamental purposes.

(200-29.6.15.)

Form No. 5.

No. E. 7744/1915

MUNICIPAL ENGINEER'S OFFICE,

Karachi, 24<sup>th</sup> September 1915

MEMO.

Building Inspector \_\_\_\_\_ is informed

that Mr. R. Young has been permittedto make additions to Bungalow his houseon plot No. 17, 21 Bonus Road Street, Civil Lines

Quarter. Report should be made to the undersigned when the house is  
completed.

J. Cecil L. Kelly

A. M. INST. C. E.,

Engineer,

Karachi Municipality.

AmM

## ORDERS UNDER SECTION 96 (2) OF ACT III OF 1910.

No. E/

7742 OF 1915

MUNICIPAL ENGINEER'S OFFICE,

Karachi, 24<sup>th</sup> September 1915.

## MEMO:

With reference to his application, dated 21<sup>st</sup> September 1915, Mr. R. Young is informed that the plan submitted by him for building additions to Bungalow on plot No. 17 Survey Sheet 211 situate in Bonus Road Street, Civil Lines Quarter, is approved, and permission to build in accordance therewith is granted. The building to be erected subject to the Byelaws and Rules of the Municipality.

*J. Cecil L. Verby*  
A.M. INST. C.E.,

Engineer,

Karachi Municipality.

Am  
50

NOTE 1.—This pass does not give permission to occupy Municipal land with building materials. This can only be allowed when the street is wide enough to permit building materials being deposited on it without it being a source of danger to the public, and only then building being placed round the land to be occupied, and on payment in advance of fees on Municipal land, at the following rates:—

|                                                       | Rs. | A. | P.              |
|-------------------------------------------------------|-----|----|-----------------|
| For the first three months, per square yard, per diem | ... | 0  | 0 $\frac{1}{2}$ |
| For the next three months: " " "                      | ... | 0  | 0 1             |
| For any subsequent time " " "                         | ... | 0  | 0 2             |

Rows, steps and doors of the building will not be permitted to project on or street or Municipal land.

will not be allowed to project more than 2' on any public street for