



146-2

2

No. E. 9020 of 1914.

MUNICIPAL ENGINEER'S OFFICE.

Karachi, 23rd October 1914.

MEMO.

The above application is forwarded to the Municipal Health Officer for favour of report.

A. M. I. C. E.,

J. C. Engineer,

Karachi Municipality.

MUNICIPAL HEALTH OFFICER'S REPORT.

D 2586
28/10/14

Returned to the Engineer, Karachi Municipality, with the following remarks:—

The W. C. is so situated that there are no means for foul air to find exit. Rooms are not well ventilated. It they must have through ventilation.

D. P. H. (London.)

Health Officer,

Karachi Municipality.

Date 28-10-1914

5-5-15

no objection

8/15

No. E. 9144 of 1914.

MUNICIPAL ENGINEER'S OFFICE.

Date 29th October 1914..

Forwarded to the Enquiry Officer for report.

A. M. I. C. E.,

J. C. Engineer,

Karachi Municipality.

Through

The Land Surveyor,

Karachi Municipality.

146-3

3

ENQUIRY OFFICER'S REPORT.

Applicant's name Kanyalob HasamalWhether he is the owner of the plot on which it is proposed to build yesThe work proposed to build a houseEnquiry Officer's report Sir I beg to report that there is no objection to grant pass for the same with C. D. Co's sanctionDate 191Enquiry Officer. Ferdinand Dr

Submitted through the Land Surveyor.

LAND SURVEYOR'S REPORT.

Does the plot come under Alignment noArea of plot Area under Alignment Remarks Sir With reference to this I beg to report that there is no objection to grant pass with the C.D. Co's consent. Yours trulyDate 18-8-1915Land Surveyor. Nachil

ORDERS OF THE ENGINEERS.

Inform C.D.C. no objection to grant permission 11/8/15J. Cecil L. Verley

A. M. I. C. E.,

20/9/15

Engineer,

Karachi Municipality.



146-4

4

No. E.

of 1915

MUNICIPAL ENGINEER'S OFFICE.

Karachi, ^{27th Sept} 1915

Submitted to the Managing Committee with a recommendation that
the plan be approved.

W. Graham Lea

M. J. & F.

Through
Chief Officer, Karachi MunicipalityJ. Cecil L. Verkey

A. M. I. C. E.

Engineer,

Karachi Municipality.

THE CHIEF OFFICER AND CHIEF ENGINEER,

KARACHI MUNICIPALITY.

RESOLUTION OF THE MANAGING COMMITTEE.

Resolution No.

Date

1390
28/9/15



147

(200-24-9-15.)

Form No. 5.

No. E. 4797 1915

MUNICIPAL ENGINEER'S OFFICE,

Karachi, 25th September 1915-
27th

MEMO.

Building Inspector Darpi is informedthat Mrs. Tahir Amal has been permittedto build his houseon plot No. 11, 226 Salmanabad Street, Darpi

Quarter. Report should be made to the undersigned when the house is
completed.

J. Cecil L. Verby

A. M. INST. C. E.,

Engineer,

Karachi Municipality.

Through the H. O. B. B.
H. O. B.



148

(200-24-9-15.)

Form No. 5.

No. E. 7796 1915

MUNICIPAL ENGINEER'S OFFICE,

Karachi, 25th September 1915

MEMO.

Building Inspector _____ is informed

that Mr. Kesram Amal has been permittedto build his houseon plot No. 11. 226 Goolmohamed Street, Dopari

Quarter. Report should be made to the undersigned when the house is

completed.

J. Cecil L. Kirby

A. M. INST. C. E.,

Engineer,

Karachi Municipality.

149-1

No. 3446 of 1915.

Revenue Department,
Collector's Office,
Karachi, 14th September 1915.

Read letter No. 2408 dated 6th September 1915, from

-----*
Permission to build a * the City Deputy Collector
godown and a dwelling house * Karachi on the subject
on survey number 14(Sheet A-26)* noted in the margin.
Napier Quarter. *

Reply of the Collector of Karachi.

S a n c t i o n e d.

Sd. J. W. Smyth,
Acting Collector of Karachi.

To,

The City Deputy Collector, Karachi, with the plan.

No. 2533 of 1915.

Revenue Department,
City Deputy Collector's Office,
Karachi, 18th September 1915.

Copy forwarded for information to the Engineer
Karachi Municipality with reference to his endorsement
No. E. 7130 dated 14th September 1915.

[Signature]
City Deputy Collector.

H. H. V.

18/9/15.



Handwritten note:
Land Survey W
attached to
report
V.

Sin

7 is attached herewith

Handwritten: please check this

Handwritten: M.H. 21/9/15

hs 8603

149-2

54.

With reference to this
they report that there

Yours truly
Nathl

22, 15

E. o

Please grant pass -

SBama.

24/9/15

150

No E

7129

of 1915.

Municipal Office.

Karachi. 31st August 1915.

14 Sep 1915

MEMO / -

With reference to his application of to day's date with a set of amended plans for building a house on plot No. 14, A-26 Napier Quarter Mr: Visram Amal is requested to apply for permission to the City Deputy Collector with two copies of plans returned herewith duly signed and approved. He must not start any building operation until he hears further from this office.

J. Cecil L. Verby

A. M. Inst. C. E.,

E n g i n e e r

Karachi

Municipality.

@@

No E

7130

of 1915.

Municipal Office.

Karachi. 31st August 1915.

Copy forwarded to the City Deputy Collector with reference to his No. 536 dated 27th February 1914.

J. Cecil L. Verby

A. M. Inst. C. E.,

E n g i n e e r

Karachi

Municipality.

B



151

Karachi 31st August 1915.

To

The Engineer Karachi Municipality .

K A R A C H I .

Sir,

With reference to your Memo No. 6694. dated 17th August ,I beg to return the plan duly amended as required by you. I now believe the same will meet with your approval.

For your information I may tell you that the beams across the gully are merely to support the 6" boundary wall. the spaces between them are left open and so the gully ^{is not covered}. As the wall is 40' high ^{and} I giving these cross beams to support it.

Regarding ownership I herewith send the sale deed for the same for your perusal.

Yours faithfully.

Sirram anal
Jonia Bazaar



Heritage

KMR.CDD.MIQ.1914-1921.01

PLAN OF PROPOSED HOUSE
ON PLOT NO 14 SHEET A26

NAPIER QB

SCALE 8-1"

APPROVED.

J. C. L. Kirby


J. M. D. G. E.

T. D. D.


Karachi Municipal Corp.



FRONT ELEVATION

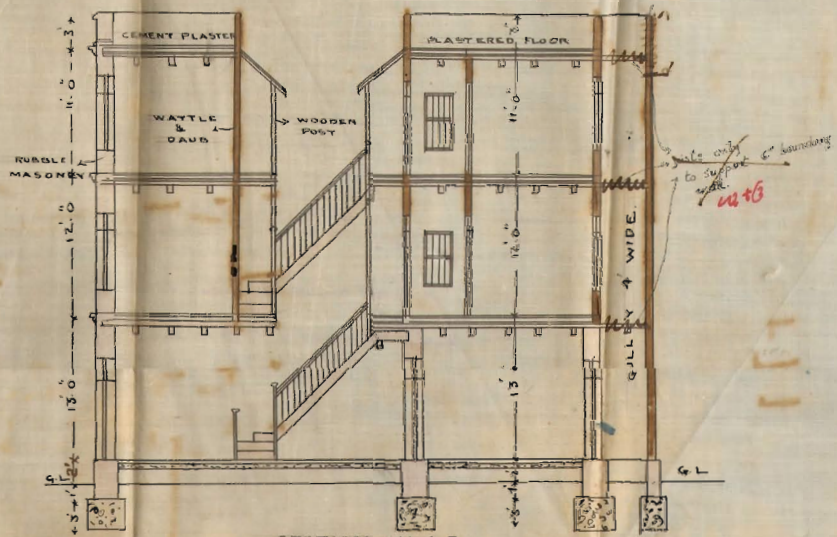


SECTION ON A-B

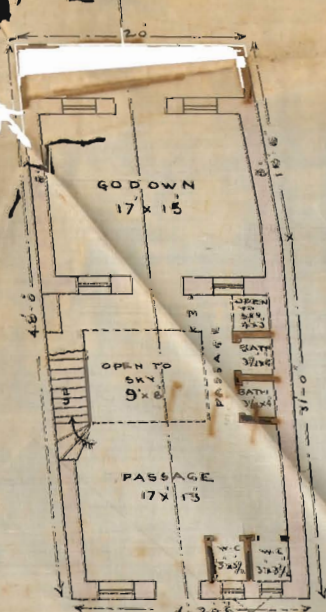


PLAN OF GROUND FLOOR

MUNICIPAL OFFICE

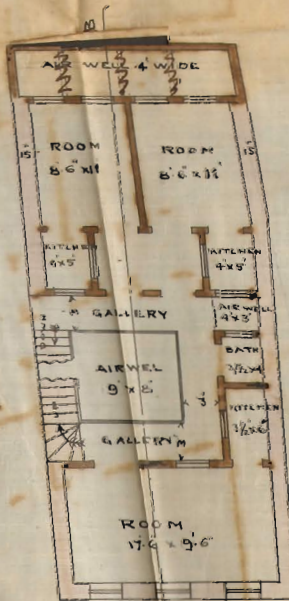

PLAN OF 1ST & 2ND FLOORS

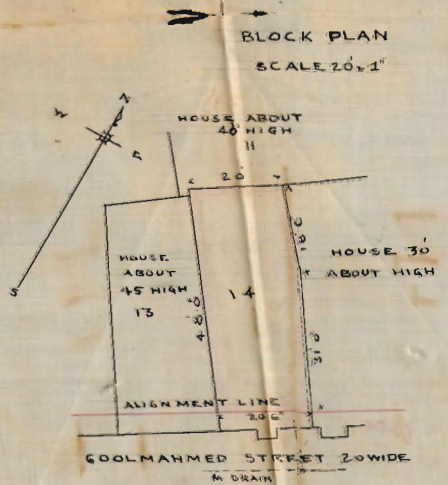BLOCK PLAN
SCALE 20x1"

9/5/22 26/3/22

M. Nazamulla 30 Aug 1922

ARCHITECT & ENGINEER
OPPOSITE FARBI THEATRE

No E

6694
or 1915.

Municipal Office.

153
Karachi.17th August 1915.

MEMO / -

With reference to his application dated 4th instant with a set of plans for building a house on plot No. 14, A-26 Napier Quarter Mr: Visram Umala is informed that atleast 5'-0" width of space must be left for the open gully.

The coverings shown over the open gully on the three floor must be removed.

A pucca wall must be erected on the ground floor at the back of the baths.

He must also produce documentary evidence to prove the ownership of the above plot, as the same does not stand in his name in the Land Register.

The plans are returned herewith for amendment.

J. Cecil L. Kerby

A. M. Inst. C. E.,

E n g i n e e r

Karachi

Municipality.



Lc. 19.

154

Lob 11915

Municipal appn

To,

The Engineer

Kawachi Municipality.

Sir,

With reference to the
attached application dated the
4th inst with a plan of
a house to be rebuilt on
plot no. 14. R 26. Napier.

I beg to report that the L.C.
beneath the living room is
allowed in several cases. I
don't see why this case not
allowed. As in the 3rd case
it should be kept at least 4 to 5
feet. Respect your order.

Yours atly

Nadli

Inform applicant that ^{10/15}
at least 5' 0" ^{and the} space must be
left for the open gully.

The covering shown over the
open gully on the three floor
must be removed.

A pataka wall must be
erected on the ground floor
at the back of the abattoir.

V. 12/8/10

500-14-7-14.

Form No. 1.

Karachi, 4th Aug. 1915.

NOTICE UNDER SECTION 96 OF ACT III OF 1901.

To

THE CHIEF OFFICER AND CHIEF ENGINEER,

KARACHI MUNICIPALITY.

SIR,

I beg to inform you that I intend building a house
on plot No. 44


Survey Sheet No. A. 26 Situate in GoolmahomedStreet Napier Quarter.

As required by the rules of the Municipality. I beg to submit herewith 4 copies
a plan of the same for your approval.

I beg to remain,

Sir,

Your most obedient Servant,

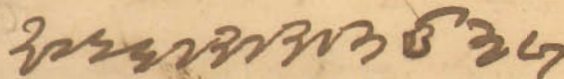

Signature of the applicant.



No. G. of 8973. 1915

MUNICIPAL CHIEF OFFICER AND

CHIEF ENGINEER'S OFFICE.

Karachi, 6th August 1915

Forwarded to the Municipal Engineer for favour of disposal.

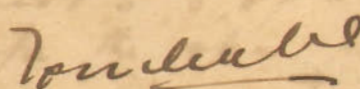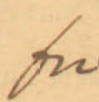
A. M. INST. C. E.,
Chief Officer and Chief Engineer,
Karachi Municipality.

Mr. Benjamin
Show to H.O.
6 & 7
15

Satranj
Holehand } To Khushabai



155-2

2

No. E. 6387 of 1915

MUNICIPAL ENGINEER'S OFFICE.

Karachi, 6th August 1915

MEMO.

The above application is forwarded to the Municipal Health Officer for favour of report.

W. A. M. I. C. E.
A. M. I. C. E.,

Engineer,
Karachi Municipality.

MUNICIPAL HEALTH OFFICER'S REPORT.

Returned to the Engineer, Karachi Municipality, with the following remarks:—

*3' fall at the back is inadequate
arrangement for ventilation. The living
room on the 1st floor over the w.c. is
objectionable*

D. P. H. (London.)
D. P. H. (London.)

Health Officer,
Karachi Municipality.

Date 10-8-1915

No. E. 6526 of 1915

MUNICIPAL ENGINEER'S OFFICE.

Date 10th August 1915

Forwarded to the Enquiry Officer for report.

W. A. M. I. C. E.
A. M. I. C. E.,

Engineer,
Karachi Municipality.

Through

The Land Surveyor,
Karachi Municipality.



155-3

3

ENQUIRY OFFICER'S REPORT.

Applicant's name Vishram AmalaWhether he is the owner of the plot on which it is proposed to build yes
he produces the sale deed for the plotThe work proposed to build a houseEnquiry Officer's report Sir I beg to report that there
is no objection to grant pass for the samethe as in government Central
request your order
Date 31st August 1915 Resholaim D.
Enquiry Officer.

Submitted through the Land Surveyor.

LAND SURVEYOR'S REPORT.

Does the plot come under Alignment yes. It will be set
back before building is being built.Area of plot Area under Alignment Remarks Sir I beg to report that there seems now
no objection to permission to be granted
provided the C.C. & M.C. sanction is taken
your orderDate 31-8-1915 Nadil
Land Surveyor.

ORDERS OF THE ENGINEERS.

In your application of 20/8/15
for permission with two copies of plan
I grant permission 11.3/8/15G. Cecil L. Toth

A. M. I. C. E.,

Engineer,

Karachi Municipality.



155-4

4

No. E.

7795 of 1915

MUNICIPAL ENGINEER'S OFFICE.

Karachi,

27th Sept 1915.

Submitted to the Managing Committee with a recommendation that
the plan be approved.

A. M. L. C. E.

Engineer,

Karachi Municipality.

Through

THE CHIEF OFFICER AND CHIEF ENGINEER,

KARACHI MUNICIPALITY.

RESOLUTION OF THE MANAGING COMMITTEE.

Resolution No.

Date

1638
28/9/15

138

156-1

500-14-7-14.

Form No. 1.

Karachi, 16 — 7 — 1915

NOTICE UNDER SECTION 96 OF ACT III OF 1901.

To

THE CHIEF OFFICER AND CHIEF ENGINEER,

KARACHI MUNICIPALITY.

SIR,

I beg to inform you that I intend building

Cabinon plot No. 747 DITESurvey Sheet No. 15 Situate inStreet Garden Quarter.

As required by the rules of the Municipality. I beg to submit herewith
a plan of the same for your approval.

I beg to remain,

Sir,

Your most obedient Servant,

Ghulam Must Khan

Signature of the applicant.

No. G. of 8164 1915

MUNICIPAL CHIEF OFFICER AND

CHIEF ENGINEER'S OFFICE.

Karachi, 16th July 1915

Forwarded to the Municipal Engineer for favour of disposal.

17.7.15

Karandas
Ghulam
Shah Wali
1449
16/7/15Tarikh

A. M. INST. C. E.,

Chief Officer and Chief Engineer,
Karachi Municipality.



156-2

2

No. E.

5787

of 1915.

MUNICIPAL ENGINEER'S OFFICE.

Karachi,

1915.

MEMO.

The above application is forwarded to the Municipal Health Officer for favour of report.

A. M. I. C. E.,

Engineer,

Karachi Municipality.

MUNICIPAL HEALTH OFFICER'S REPORT.

Returned to the Engineer, Karachi Municipality, with the following remarks:—

No objection

D. P. H. (London.)

Health Officer,

Karachi Municipality.

Date 17-7-1915.

No. E.

5854

of 1915.

MUNICIPAL ENGINEER'S OFFICE.

Date

17-7-1915.

1915.

Forwarded to the Enquiry Officer for report.

A. M. I. C. E.,

Engineer,

Karachi Municipality.

Through

The Land Surveyor,

Karachi Municipality.

156-3

ENQUIRY OFFICER'S REPORT.

Applicant's name Mr. Usman Masti KhanWhether he is the owner of the plot on which it is proposed to build yesThe work proposed balun

Enquiry Officer's report

Sir,
I beg to report that
there is no objection to grant pass
with CDD's consent. your orderDate 20/3/15 1915.Enquiry Officer. [Signature]

Submitted through the Land Surveyor.

LAND SURVEYOR'S REPORT

Does the plot come under Alignment yesArea of plot —Area under Alignment —Remarks Sir I beg to report that there is noobjection to grant pass with consentof CDD.your orderDate 19/3/15 1915.Land Surveyor. [Signature]

ORDERS OF THE ENGINEERS.

to be submitted to the CDD for permission
to be submitted to the CDD for permissionGrant permission
10/9/15
10/9/15
10/9/15G. A. C. L. Verkey
10/9/15

A. M. I. C. E.,

Engineer,

Karachi Municipality.


156-4

4

No. E.

7777

of 1915

MUNICIPAL ENGINEER'S OFFICE.

Karachi,

27/9/15

1915.

Submitted to the Managing Committee with a recommendation that the plan be approved.

M. J. Q. & Co.
Chief Officer, Karachi Municipality
Through

J. G. L. Verby
A. M. I. C. E.,
Engineer,
Karachi Municipality.

THE CHIEF OFFICER AND CHIEF ENGINEER,

KARACHI MUNICIPALITY.

RESOLUTION OF THE MANAGING COMMITTEE.

Resolution No.

Date

1638
28/9/15

158



Heritage

KMR.CDD.MIQ.1914-1921.01

152

Dr. Mahabir Prasad

of the Government of India



159

200-23-6-15.

Form No. 2.

ORDERS UNDER SECTION 96 (2) OF ACT III OF 1910.

No. E/

7776 OF 1915.

MUNICIPAL ENGINEER'S OFFICE,

Karachi, 25th September 1915.

MEMO:

With reference to his application, dated 16th July 1915, Mr. Roman Mushkhan is informed that the plan submitted by him for building a kalun on plot No. 74, 75, & 76 Survey Sheet 15 situate in Street, Garden Quarter, is approved, and permission to build in accordance therewith is granted. The building to be erected subject to the Byelaws and Rules of the Municipality.

J. Cecil L. Turkey
A.M. INST. C.E.,

Engineer,

Karachi Municipality.

NOTE 1.—This pass does not give permission to occupy Municipal land with building materials. This can only be allowed when the street is wide enough to permit building materials being deposited on it without it being a source of danger to the public, and only then on a hoarding being placed round the land to be occupied, and on payment in advance of fees for occupation of Municipal land, at the following rates:—

		Rs.	A.	P.
(1)	For the first three months, per square yard, per diem	...	0	0 $\frac{1}{2}$
(2)	For the next three months " " "	...	0	0 1
(3)	For any subsequent time " " "	...	0	0 2

NOTICE 2.—Windows, steps and doors of the building will not be permitted to project on or overhang any public street or Municipal land.

NOTICE 3.—Plinths will not be allowed to project more than 2" on any public street for ornamental purposes.

(200-24-9-15.)

Form No. 5.

No. E. ~~7778~~ 1915

MUNICIPAL ENGINEER'S OFFICE,

Karachi, ~~25th~~ ^{27th} September 1915

MEMO.

Building Inspector Garden is informedthat Mr. Aman Mustakhan has been permittedto build a cabin his houseon plot No. 79, 70 + 78 Is Street, Garden

Quarter. Report should be made to the undersigned when the house is

completed.

J. Cecil L. Verby

A. M. INST. C. E.,

Engineer,

Karachi Municipality.

Through the Health Officer MH. D. M.



161

(200-24-9-15.)

Form No. 5.

No. E. 7779 1915

MUNICIPAL ENGINEER'S OFFICE,

Karachi, 25th September 1915

MEMO.

Building Inspector _____ is informed

that Mrs. Aiman Mustekhan has been permittedto build a kalni his houseon plot No. 74, 70, 78, 15 Street, Garden

Quarter. Report should be made to the undersigned when the house is

completed.

J. Cecil L. Parry

A. M. INST. C. E.,

Engineer,

Karachi Municipality.

162-1

No: 3460 of 1915.

Revenue Department.

Collector's Office.

Karachi, 15th September 1915

Read letter No: 2446 dated the 9th September

-----+ 1915 from the
 1
 Permission to build a cabin over the City Deputy
 1
 top of buildings on survey Nos. 7G, 7B 1 Collector,
 1
 and 7E (Sheet I-6) Garden Quarter. 1 Karachi, on the
 1
 ----- subject noted

in the margin.

Reply of the Collector of Karachi.

S a n c t i o n e d.

Sd J. W. Smyth,

Acting Collector of Karachi.

To,

The City Deputy Collector, Karachi, (with the plan).

No: 2582 of 1915

Revenue Department.

City Deputy Collector's Office,
Karachi, 21 September 1915.

Copy forwarded for information to the Engineer
 Karachi Municipality with reference to his endorsement
 No: E/ 6086 dated 26th July 1915.

Engr. J. W. Smyth
22.9.15
Letter to J. W. Smyth
for info.



4c is attached here with
your receipt
M. G. S. 23/9/15

K. G. S.

20/9/1915.

City Deputy Collector.



S821

162-2

Sir,

With reference to this
I beg to report that there is
no objection to permission
to be granted -

Yours truly
Nathaniel

23 15.
9

Received
of the collector



163

No E 6085 of 1915.

Municipal Office.

Karachi. 26th July 1915.

MEMO / -

With reference to his application dated 16th inst. with a set of plans for building a cabin on plot No. 7/C, 7/D & 7/E, I-5 Garden Quarter Mr: Osman Mustikhan is requested to apply for permission to the City Deputy Collector with two copies of plans returned herewith duly signed and approved. He must not start any building operation until he hears further from this office.

J. Cecil L. Verby

A. M. Inst. C. E.,

E n g i n e e r

Karachi

Municipality.

No E 6086 of 1915.

Municipal Office,

Karachi. 26th July 1915.

Copy forwarded to the City Deputy Collector with reference to his No. 536 dated 27th February 1914.

J. Cecil L. Verby

A. M. Inst. C. E.,

E n g i n e e r

Karachi

Municipality.



164

16

200-23-6-15.

Form No. 2.

ORDERS UNDER SECTION 96 (2) OF ACT III OF 1910.

No. E/

777²OF 191⁵.

MUNICIPAL ENGINEER'S OFFICE,

Karachi, ~~25th August~~ ^{27th September} 191⁵.

MEMO:

With reference to his application, dated 21st July 191⁵,
 Mr. Thakurdas Telamul is informed
 that the plan submitted by him for building a bungalow & out houses
 on plot No. 31 Survey Sheet 17
 situate in Thakurdas Telamul Street, Garden
 Quarter, is approved, and permission to build in accordance therewith is
 granted. The building to be erected subject to the Byelaws and Rules of the
 Municipality.

*Sir, With reference to this
 the plan is approved.*
J. Cecil L. Verby

A.M. INST. C.E.,

Engineer,

Karachi Municipality.

M B

NOTE 1.—This pass does not give permission to occupy Municipal land with building materials. This can only be allowed when the street is wide enough to permit building materials being deposited on it without it being a source of danger to the public, and only then on a hoarding being placed round the land to be occupied, and on payment in advance of fees for occupation of Municipal land, at the following rates :—

	Rs.	A.	P.
(1) For the first three months, per square yard, per diem ...	0	0	$\frac{1}{2}$
(2) For the next three months " " " ...	0	0	1
(3) For any subsequent time " " " ...	0	0	2

NOTICE 2.—Windows, steps and doors of the building will not be permitted to project on or overhang any public street or Municipal land.

NOTICE 3.—Plinths will not be allowed to project more than 2" on any public street for ornamental purposes.



165-1

143

500—14-7-14.

Form No. 1.

Karachi, 21-7-1915

NOTICE UNDER SECTION 96 OF ACT III OF 1901.

To

THE CHIEF OFFICER AND CHIEF ENGINEER,

KARACHI MUNICIPALITY.

SIR,

I beg to inform you that I intend building a bungalow & out-houses on plot No. 31

Survey Sheet No. 17 Situate in _____

Street Garden Quarter.

As required by the rules of the Municipality. I beg to submit herewith a plan of the same for your approval.

I beg to remain,
Sir,

Your most obedient Servant,

Shankar Das Tilomal
Signature of the applicant.

No. G. of 8548 1915

MUNICIPAL CHIEF OFFICER AND

CHIEF ENGINEER'S OFFICE.

Karachi, 22 July 1915

Forwarded to the Municipal Engineer for favour of disposal.

A. M. INST. C. E.,

Chief Officer and Chief Engineer,
Karachi Municipality.

Mr. Narayana
Mr. K. S.
22/7/15

1509
22/7/15



165-2

No. E. ⁵⁹⁶⁶ of 1915

MUNICIPAL ENGINEER'S OFFICE.

Karachi, 22nd 1915

MEMO.

The above application is forwarded to the Municipal Health Officer for favour of report.

W. L. ...
A. M. I. C. E.,

In Engineer,
Karachi Municipality.

MUNICIPAL HEALTH OFFICER'S REPORT.

Returned to the Engineer, Karachi Municipality, with the following remarks:—

no objection
The applicant should be requested to
have the stable & provide a
catchpit to the same

D. P. H. (London.)

Health Officer,

Date 24-7-1915

Karachi Municipality.

No. E. ⁶⁰⁰⁷ of 1915

MUNICIPAL ENGINEER'S OFFICE.

Date 24th 1915

Forwarded to the Enquiry Officer for report.

W. L. ...
A. M. I. C. E.,

In Engineer,
Karachi Municipality.

Through

The Land Surveyor,

Karachi Municipality.

ENQUIRY OFFICER'S REPORT.

Applicant's name Mr. Shaker Das Samual

Whether he is the owner of the plot on which it is proposed to build Yes

The work proposed a kunjlow, ^{out house} offices

Enquiry Officer's report Sir, I beg to report that the
out houses only show 11 one foot and frame
the compound wall. Section does not show how
the people get to the premises. Request your order.
 Date 1915 Enquiry Officer.

Submitted through the Land Surveyor.

LAND SURVEYOR'S REPORT.

Does the plot come under Alignment No

Area of plot —

Area under Alignment —

Remarks Sir, With reference to this I beg to report
that the out houses only show (i) one foot and frame
the compound wall section does not show how the
people get to the premises. Request your order.
 Date 27-7-1915 Land Surveyor.

ORDERS OF THE ENGINEERS.

outhouse opening must be set back at least
3'6" from the compound wall.

No objection subject to the tables being
made & catchpit provided.

Grant permission
17/8/15
20/9/15
 A. M. I. C. E.,
 Engineer,
 Karachi Municipality.



165-4

4

No. E. 7773 of 1915.

MUNICIPAL ENGINEER'S OFFICE.

Karachi, 27th Sept, 1915.

Submitted to the Managing Committee with a recommendation that the plan be approved.

M. J. J. J.

Chief Officer, Karachi Municipality.

J. Cecil L. Kirby
A. M. I. C. E.

Engineer,
Karachi Municipality.

Through

THE CHIEF OFFICER AND CHIEF ENGINEER,

KARACHI MUNICIPALITY.

RESOLUTION OF THE MANAGING COMMITTEE.

Resolution No.

Date

16389
28/9/15



166

(200-24.9.15.)

Form No. 5.

No. E. ~~4775~~ 1915

MUNICIPAL ENGINEER'S OFFICE,

Karachi, 25th September 1915

MEMO.

Building Inspector Garden Re is informedthat Mr. Phakurdes Tilsamal has been permittedto build a bungalow & out house his houseon plot No. 31 97 Street, Garden

Quarter. Report should be made to the undersigned when the house is

completed.

J. Cecil L. Verby

A. M. INST. C. E.,

Engineer,

Karachi Municipality.

Through the Health Officer

W. D. N.

No: 3447 a of 1915.

Revenue Department,

Collector's Office.

Karachi, 13th September 1919

Read letter No: 2433 dated the 9th September 1915

----- from the City Deputy
1
Permission to build a bungalow 1 Collector, Karachi on
1
and outhouses on survey No: 3 11 the subject noted in
1
(sheet I-7) Garden Quarter. 1 the margin.

Reply of the Collector of Karachi.

S a n c t i o n e d.

Sd/ J. W. Smyth,

Acting Collector of Karachi.

The City Deputy Collector, Karachi, (with the plan)

[illegible]

No: 2551 of 1915.

Revenue Department.

City Deputy Collector's Office.

Karachi, 21 September 1915

Copy forwarded for information to the Engineer

Karachi Municipality with reference to his endorsement

No: E/6714 dated 18th August 1915.

City Deputy Collector.

K. G. S.

20/9/1915.

His attached herewith

Yours obedtly

4/11/95 23/9/95-

Grumme

879

Sir,

With reference to this
 they to report that there is
 no objection to permission
 to leave the quarter

Yours truly
Nathaniel

23
 7 15





168

No E

6713

of 1915.

Municipal Office.

Karachi. 17th August 1915.

18th

MEMO / -

With reference to his application dated 12th August 1915 with a set of amended plans for building on plot No. 31, I-7 Garden quarter Mr: Thakurdas Tillumal is informed that the plans are approved subject to the stables being paved and a catchpit provided. He must apply to the City Deputy Collector with two copies of plans returned herewith duly signed and approved and must not start any building operation until he hears further from this office.

J. Cecil L. Verity
A. M. Inst. C. E.,

Engineer

Asst

Karachi Municipality.

No E

6714

of 1915.

Municipal Office.

Karachi. 17th August 1915.

18th

Copy forwarded to the City Deputy Collector with reference to his No. 536 dated 27th February 1914.

J. Cecil L. Verity

A. M. Inst. C. E.,

Engineer

Karachi

Municipality.

JS

KARACHI

12.8.15

To

The Engineer

Karachi Municipality

Sir,

With reference to your Memo: No: E/ 3426 of 1915,
I beg to submit herewith plan for proposed bungalow on plot
No: 31, sheet I 7, Garden Quarter.

1. Out- houses and privy are already shown 3' away
from the compound wall. The dimension shown was 4' including
1' compound wall.

2. A bath place has been provided for servants.

3. Regarding block plan all of the dimensions are
shown correct.

I therefore request you to kindly grant me
early permission to build.

I beg to remain

Sir

Your most obedient servant

7c is attached herewith

yours obediently

Mukesh

16/8/15

SD/ Mukesh Dilliwala
in our name

Ls. 8154

Sir,

With reference to this
 I beg to report that now there

Yours sincerely
 Nathaniel

16
 15.



170

No E

bu 26

of 1915.

Municipal Office.

Karachi. 6th August 1915.

7th

MEMO / -

With reference to his application dated 21st July 1915 with a set of plans for building a bungalow and out-houses on plot No. 31, I-7 Garden Quarter Mr: Thakurdas Tilumal is informed that the same can not be approved unless the following requirements are complied with.

- 1, Out-houses and privy must be set back at least 3'-0" from the compound wall as the present space is not sufficient for sanitary requirements.
2. Bath room must be provided for the out-houses.
3. Block plan to be corrected as the dimensions shown therein do not seem to be correct.

The plans are returned herewith for amendment.

V.

A. M. Inst. C. E.,

Engineer,

Karachi

Municipality.

B. B.
n.



L.S. 2779

No. 6. 21/9/15

Municipal Office

Karachi 31/12/1915

5

Memo

With reference to his appl. of 21/7/15 with
 a set of plans for building a bungalow & outhouse
 on plot no. 31 27 Garden St. Mr. Shakhzad
 Tilluwal is informed that the same cannot
 be approved unless the following requirements
 are complied with.

1. Outhouse & privy must be set back at least
 3'-0" from the compound wall as the present
~~of it is not sufficient for sanitary requirements~~
2. Bath room must be provided for the
 outhouse
3. Block plan to be corrected as per the
 dimensions shown there so not seen to be
 correct.

The plans are returned herewith for amendment.

V

A.M. Inst., C.E.

Engineer.

Karachi Municipality.

A2
a

Good drug sample
for favor of hospital.

Nachp


30
7 4

Back rooms for authors not
provided. Block plan in-
correct.

SKBauer
3/7/15

PLAN
OF PROPOSED BUNGLOW & OUT HOUSES
ON PLOT NO 31 SHEET 17
GARDEN QUARTER
SCALE 8 FT = 1 INCH


GROUND FLOOR

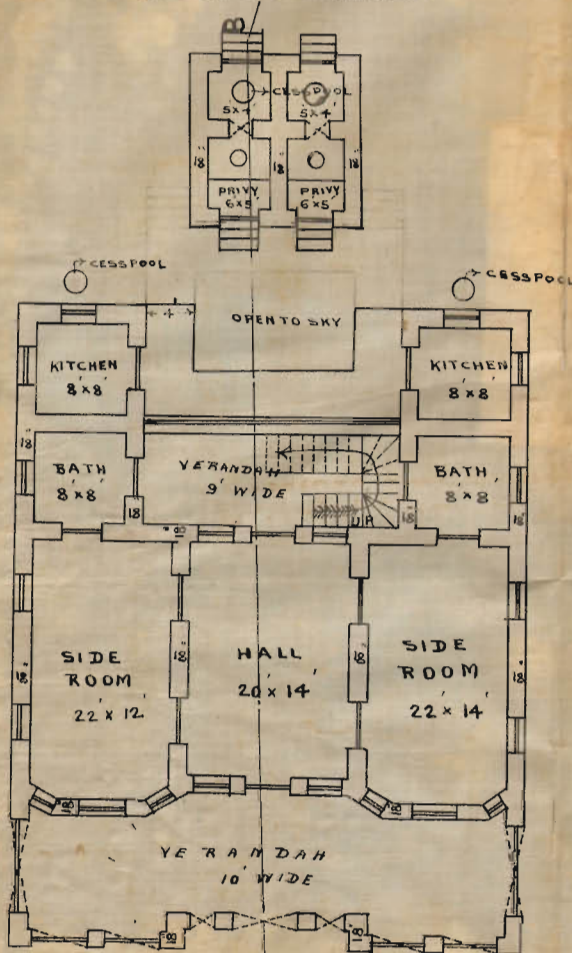


ELEVATION




FIRST FLOOR

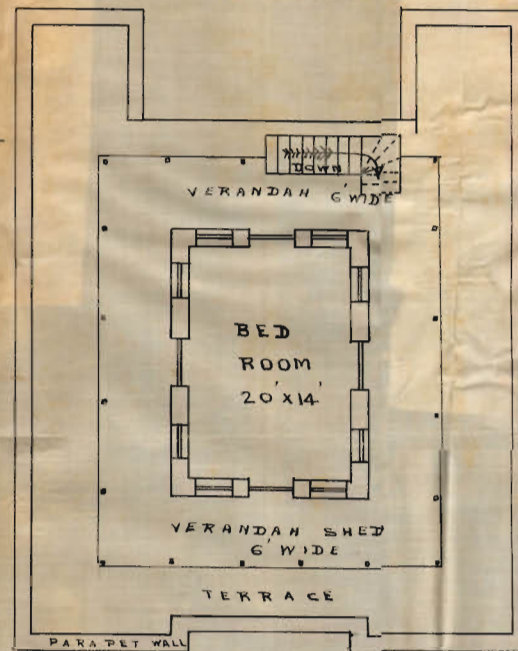


GROUND FLOOR

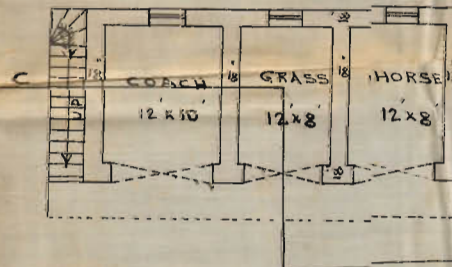


FIRST FLOOR

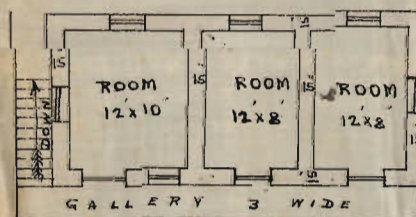



SECTION ON AB

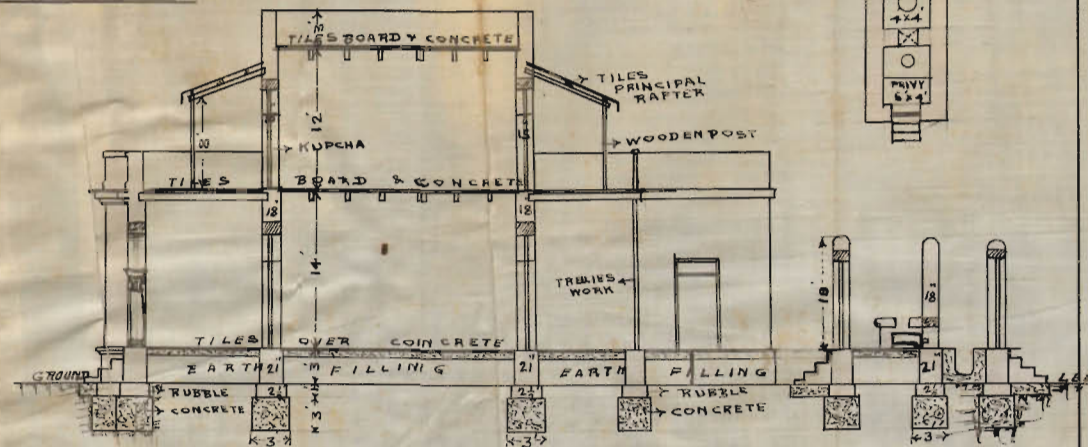


BLOCK PLAN
SCALE 20 FT = 1 INCH

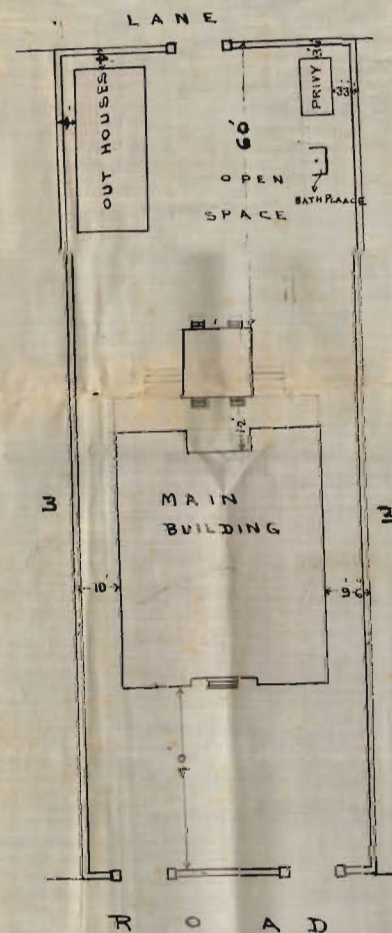

PLAN

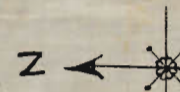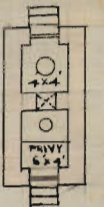

SECTION ON CD

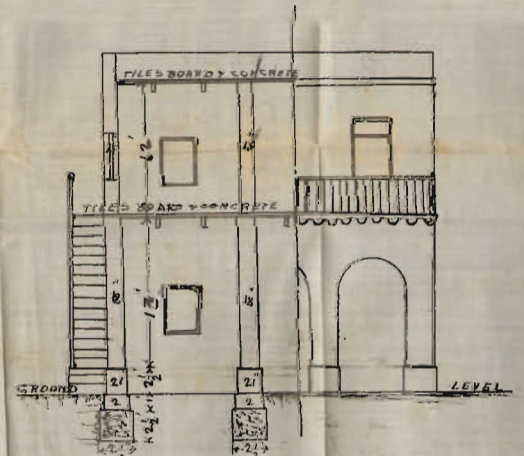

NOTE
 AREA UNDER PLOTS 1257 SQYDS.
 AREA UNDER PROPOSED
 BUILDING & OUT HOUSES 413 SQYDS.
Daryamal Ramkumar
 L.C.E
 Architect.

APPROVED.
H. K. Verley
 District
 Engineer

174

(200-24-9-15.)

Form No. 5.

No. E.

1915

MUNICIPAL ENGINEER'S OFFICE,

Karachi, 25th September 1915

MEMO.

Building Inspector _____ is informed

that Mr. Flakurdes Tilsomal has been permittedto build a lunglaw & out house his houseon plot No. 31 27 Street, Garden

Quarter. Report should be made to the undersigned when the house is

completed.

J. Cecil L. Verky

A. M. INST. C. E.,

Engineer,

Karachi Municipality.

M. NAZARETH.

B. A. I. C. E.

ARCHITECT & ENGINEER.

175-

No. 212

of 191

ARCHITECTS OFFICE

BUNDER ROAD,

Karachi, 15th Sept 1915

*Land Survey
to be made
for work
16/9/15*



The Engineer

Karachi Municipality

Karachi

Sir,

With reference to your No. E. 7220 of 4th Sept. 15, addressed to Mr. Harunul Parsumul I have the honour to return herewith the plans for a house on Plot No. 123, A 20, Napier Quarter with the dachatie deleted as required.

No wall is put on the east as there is an existing wall of adjoining owner as shown in full line on plan & in dotted line on site plan. The portion projecting beyond the adjoining house will be walled in by 6" brick wall. The beams will rest on the North & South walls and no weight will come on the east wall.

I have the honour to be

Sir

Your most obedient servant

M. Nazareth

Sir,

7c is attached herewith

Yours obediently

M. Nazareth. 16/9/15



Sir,

With reference to this

they to report that this is as
subject to your pass

Yours truly
Nash

E.O.
25.9.15

With reference to your No. 3.22.0 of the
Sept. 12, addressed to Mr. Harman's
I have the honour to return herewith the plan
for a house on Plot No. 123, 124, 125, 1000

I have the honour to be
Yours truly
M. Hargrave

Received
M. Hargrave

176

(200-29-6-15.)

Form No. 5.

No. E. 777/1915

MUNICIPAL ENGINEER'S OFFICE,

Karachi, 25th September 1915

MEMO.

Building Inspector

is informed

that Mr. Hameed Pirmahal has been permittedto build his houseon plot No. 123, Ahs Ravi Embankment Street,
FloodDroper

Quarter. Report should be made to the undersigned when the house is

completed.

J. Cecil L. Verby

A. M. INST. C. E.,

Engineer,

Karachi Municipality.

B. S.

177

(200-29-8-15.)

Form No. 5.

No. E.

1915

MUNICIPAL ENGINEER'S OFFICE,

Karachi, 26th September 191527th

MEMO.

Building Inspector

Dopai

Is informed

that Mr. Hammal Fursumal has been permittedto build his houseon plot No. 128, 2nd Rumi Embankment Street

Road

Dopai

Quarter. Report should be made to the undersigned when the house

completed.

J. B. C. S.

Through the Health Officer

Karachi Municipal

178

200-

Form

ORDERS UNDER SECTION 96 (2) OF ACT III OF 1910.

No. E/

7768

OF 1915.

MUNICIPAL ENGINEER'S OFFICE,

Karachi, 26th September 1915.27th

MEMO:

With reference to his application, dated 11th August 1915,
 Mr. Harunul Persumal is informed
 that the plan submitted by him for building a house
 on plot No. 123 Survey Sheet 220
 situate in River Embankment Road Street, Rapier
 Quarter, is approved, and permission to build in accordance therewith is
 granted. The building to be erected subject to the Byelaws and Rules of the
 Municipality.

A.M. INST. C.E.,

Engineer,

Karachi Municipality.

An SB

NOTE 1.—This pass does not give permission to occupy Municipal land with building materials. This can only be allowed when the street is wide enough to permit building materials being deposited on it without it being a source of danger to the public, and only then on a hoarding being placed round the land to be occupied, and on payment in advance of fees for occupation of Municipal land, at the following rates:—

	Rs.	A.	P.
(1) For the first three months, per square yard, per diem	...	0	0 $\frac{1}{2}$
(2) For the next three months "	...	0	0 1
(3) For any subsequent time "	...	0	0 2

NOTICE 2.—Windows, steps and doors of the building will not be permitted to project on or overhang any public street or Municipal land.

NOTICE 3.—Plinths will not be allowed to project more than 2" on any public street for ornamental purposes.

See Amended Plan file 1916 S 46

179




PLAN OF PROPOSED HOUSE
ON PLOT NO 123 SHEET A.20


NAPIER Q.B.
SCALE 8"=1"

M. Nazarelli
11th Aug. 15.


APPROVED
Sd. H. Verley
Sd. Hameed Usmanul

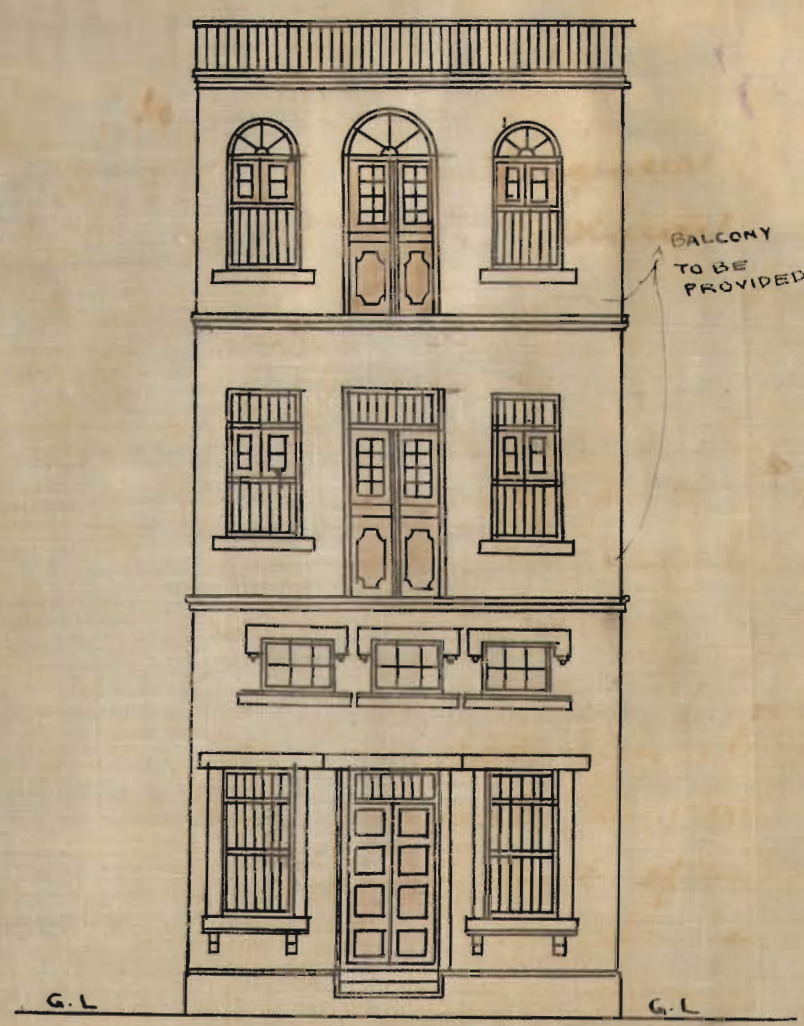


NORTH ELEVATION

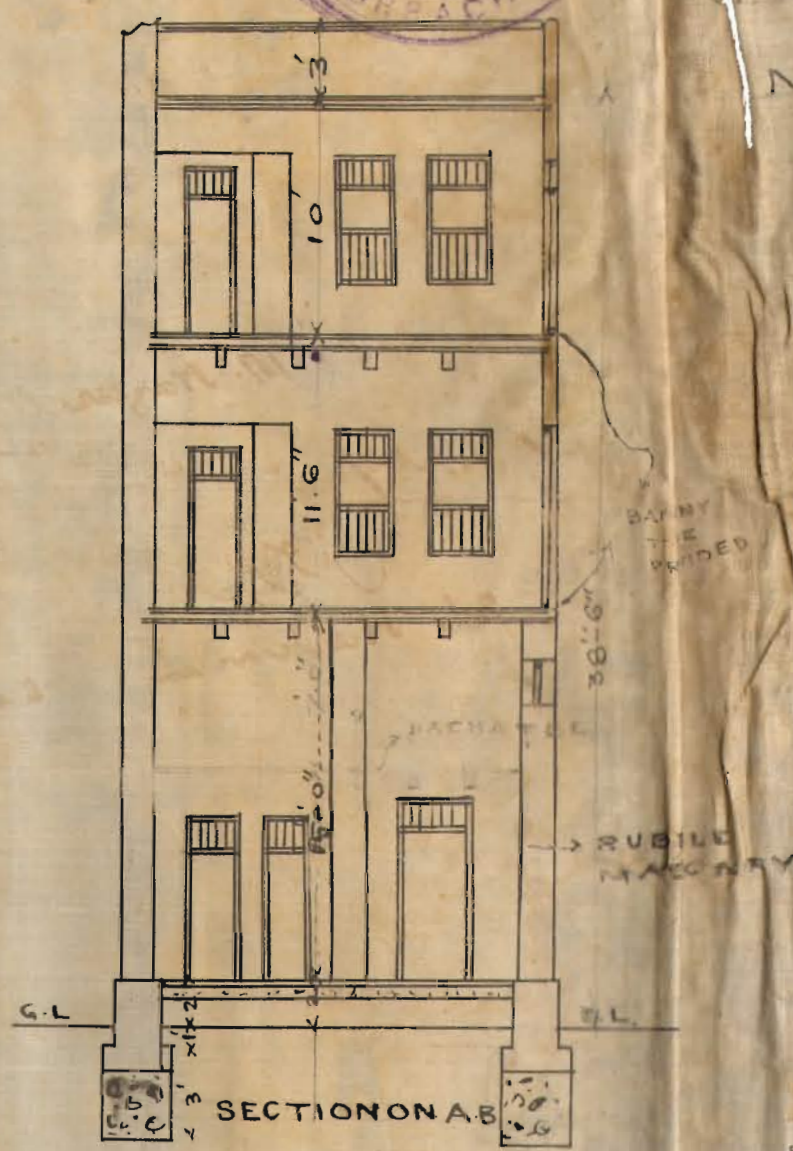


SECTION ON A-B

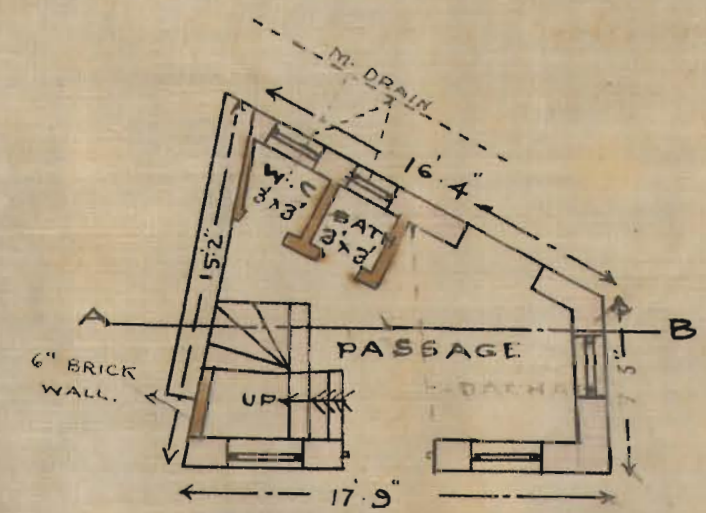

PLAN OF GROUND FLOOR

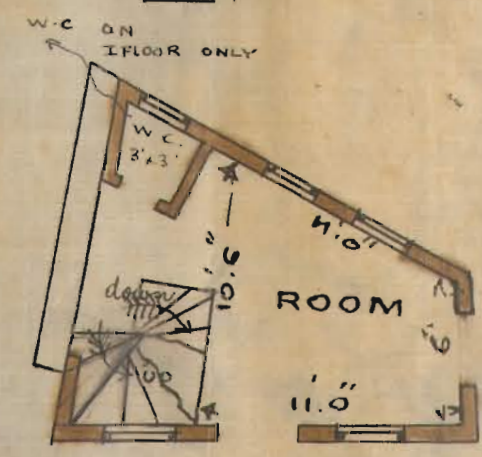

PLAN OF 1ST & 2ND FLOORS

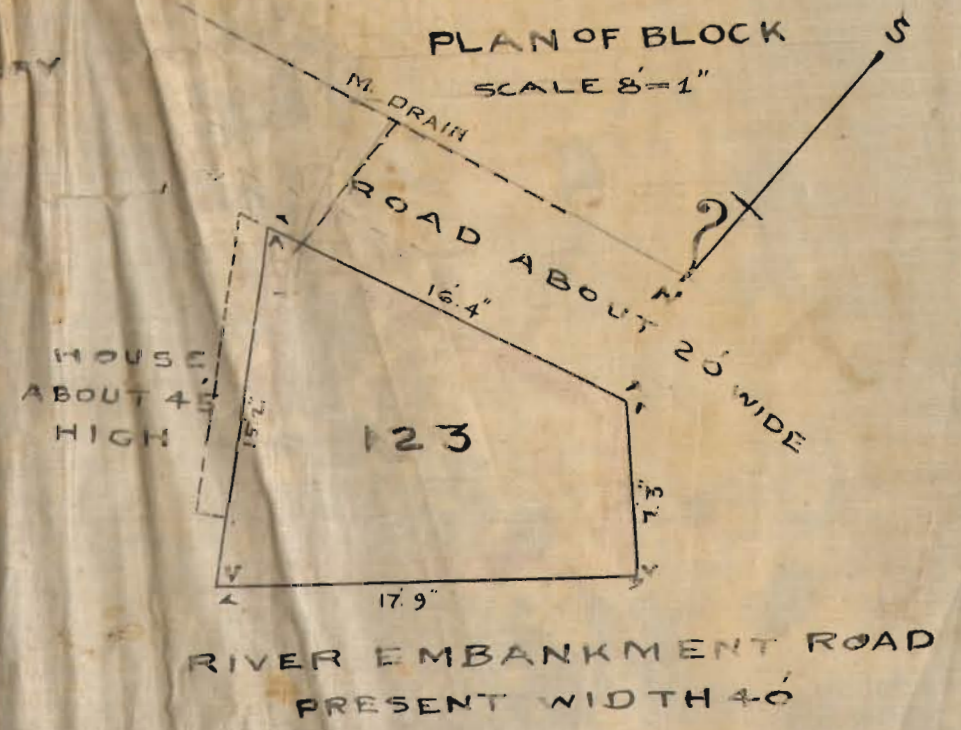

PLAN OF BLOCK
SCALE 8"=1"

RIVER EMBANKMENT ROAD
PRESENT WIDTH 40'



180

Chas. E.

27/12/11

Municipal Office

Karachi. 31st August 1911

Memo.

With ref. to his application of "Current
with a set of plans for bldg. house on plot
no. 123 A20. Mr. Harwood Purmurel is
informed that the Section shown therein
can not be allowed - He is requested to
explain how he proposes to support the bldg.
on the east side without any wall. The
plans can not be approved & are returned
herewith for amendment.

Y.

A.M. Inst., C.E.,

Engineer.

Karachi Municipality.

M
A

To,

The Engineer
Karachi Municipality

Sir,

With reference to the
attached application dated
the 11th inst. with a
sketch of a house to be
rebuilt on plot no 123
A 20 Kaperi quarter. I beg
to report that this is the
same plot which was
pulled down under the
order of the Judicial
Commissioners Court who
wishes to rebuild but the
plot is small one and not
sub divided officially. but
there was a separate boundary
known since long. Such
is not in accordance with
the M.C. laws. Respectfully
yours
V. Nath

L. Purnan an up 27/8/15
with this V.
29/8/15

Upon application that the
"dichotomies" cannot be allowed
He is requested to explain how he
proposes to support the building
on the East side without any
walls.

V.
31/8/15



Heritage

KMR.CDD.MiQ.1914-1921.01

NAPIER QUARTER

SHEET No. A-20

SCALE 20' = 1"

N



EMBANKMENT

ROAD

122

114

123

120

7

HURGOONDASS

STREET

118

2

3

4

HINDOO TEMPLE

2/A

4/1

4-A

PEER

110

DURRYA LAL

STREET

85

45

96

99

100

98

101

102

103

*Shundas Lathwal*

158

183-1

500-14-7-14.

Form No. 1.

Karachi, 11th Aug. 1915.

NOTICE UNDER SECTION 96 OF ACT III OF 1901.

To

THE CHIEF OFFICER AND CHIEF ENGINEER,

KARACHI MUNICIPALITY.

SIR,

I beg to inform you that I intend building 12on plot No. 123Survey Sheet No. A-20 Situate in River Embankment Road
Street old Napier Quarter.As required by the rules of the Municipality. I beg to submit herewith two copies
a plan of the same for your approval.

I beg to remain,

Sir,

Your most obedient Servant,

Signature of the applicant.

*Hareemul Huseinul*No. G. of 9107. 1915

MUNICIPAL CHIEF OFFICER AND

CHIEF ENGINEER'S OFFICE.

Karachi, 11th August 1915.

Forwarded to the Municipal Engineer for favour of disposal.

1759
11/8/15
Mr. Benjamin
Sham to H.O.
11/8/15

for
A. M. INST. C. E.,
Chief Officer and Chief Engineer,
Karachi Municipality.

183-2

No. E. ² 6565 of 1915.

MUNICIPAL ENGINEER'S OFFICE.

Karachi, 11th August 1915.

MEMO.

The above application is forwarded to the Municipal Health Officer for
favour of report.

A. M. I. C. E.,

In Engineer,

Karachi Municipality.

MUNICIPAL HEALTH OFFICER'S REPORT

Returned to the Engineer, Karachi Municipality, with the following
remarks:—

No objection

D. P. H. (London.)

Health Officer,

Karachi Municipality.

Date 14-8-1915

No. E. 6631 of 1915.

MUNICIPAL ENGINEER'S OFFICE.

Date 14th August 1915.

Forwarded to the Enquiry Officer for report.

A. M. I. C. E.,

In Engineer,

Karachi Municipality.

Through

The Land Surveyor,

Karachi Municipality.



184

No. E. 7220 of 1915.

Municipal Office,

Karachi, 3rd September 1915.

M e m o,

With reference to his application dated 11th ultimo with a set of plans for building house on plot No. 123 A 20 ^{Nagar Quarter} Mr: Harumal Pursomal is informed that the Duchatis shown therein cannot be allowed. He is requested to explain how he proposes to support the building on the east side without any wall. The plans cannot be approved and are returned herewith for amendment.

J. Cecil L. Parley

A. M. INST. C. E.

Engineer,

Karachi Municipality.

185

158

186 No E 7845 of 1915.

Municipal Office.

Karachi. 28th September 1915.

From,

The Engineer,

Karachi Municipality.

To,

Kalichbeg. F. Mirza, Esquire.

Retired Deputy Collector,

K a r a c h i .

Sir,

With regard to your letter dated 29th Sept. & received on 28th August 1915 regarding demolition and re-building of out-houses and the erection of a new wall on plot No. 60, E-3 Runchore Quarter in passing the plan I am instructed to inform you that the conditions of sale of the plot provides for only one bungalow being erected on the plot and that these conditions must be complied with.

I have therefore the honour to inform you that permission to carry out the work as per plan submitted is herewith attached subject to the above conditions being complied with.

I have the honour to be

Sir,

Your most obedient servant

J. Cecil L. Kirby

A. M. Inst. C. E.,

E n g i n e e r

Karachi Municipality.



ORDERS UNDER SECTION 96 (2) OF ACT III OF 1910.

No. E/

7846
or 1915.

MUNICIPAL ENGINEER'S OFFICE,

Karachi, 23rd September 1915.

MEMO:

With reference to his application, dated _____ 191 _____,
 Mr. Kalichbeg J. Inza is informed
 that the plan submitted by him for building compound wall and
outhouses on plot No. 60 Survey Sheet 63
 situate in Gaseabkhan Street, Runchoe
 Quarter, is approved, and permission to build in accordance therewith is
 granted. The building to be erected subject to the Byelaws and Rules of the
 Municipality. and subject to the compliance of the conditions
of the sale of the above plot which provide for only one
dwelling to be erected thereon

J. Cecil L. Verby
 A.M. INST. C.E.,

Engineer,

Karachi Municipality.

B
R

NOTE 1.—This pass does not give permission to occupy Municipal land with building materials. This can only be allowed when the street is wide enough to permit building materials being deposited on it without it being a source of danger to the public, and only then on a hoarding being placed round the land to be occupied, and on payment in advance of fees for occupation of Municipal land, at the following rates:—

	Rs.	A.	P.
(1) For the first three months, per square yard, per diem	...	0	0 $\frac{2}{3}$
(2) For the next three months	...	0	0 1
(3) For any subsequent time	...	0	0 2

NOTICE 2.—Windows, steps and doors of the building will not be permitted to project on or overhang any public street or Municipal land.

NOTICE 3.—Plinths will not be allowed to project more than 2" on any public street for ornamental purposes.

(200-29-6-15.)

Form No. 5.

No. E. *7849* 191*5*

MUNICIPAL ENGINEER'S OFFICE,

Karachi, *23rd* September 191*5*

MEMO.

Building Inspector _____ is informed

that *Om. Kalicheg J. Durgai* has been permittedto *build compound wall & out house on* his houseon plot No. *60, 83, Gaovali Khan* Street, *Punchoe*

Quarter. Report should be made to the undersigned when the house is
completed.

J. Cecil L. Verby

A. M. INST. C. E.,

Engineer,

Karachi Municipality.

B. N.

Form No. 5.

No. E.

7848
1915

MUNICIPAL ENGINEER'S OFFICE,

Karachi, 23rd September 1915
24th

MEMO.

Building Inspector

Runchore

is informed

that Mr. Khalidbeg F. Druza has been permitted

to build compound wall and houses his house

on plot No. 60. 83 Yacoolkhan Street,

Runchore

Quarter. Report should be made to the undersigned when the house is

completed.

J. Cecil L. Verby

A. M. INST. C. E.,

Engineer,

Karachi Municipality.

Through the Health Officer

K. D. M.

L. Brown a letter stating the
M/c's resolution must accompany
this plan.

V.
24/9/15-

191-1

1915
Municipal Office
Karachi 24th Sep 1915
15

J.

Kalichbeg

Karachi

Sw.

I have the honor to inform you that the Managing Committee at their meeting held on the 14th current passed the following resolution in connection with the plan submitted by you for bldg. a compound wall & outhouse on plot no. 60 E3 Rackett St. Thet. The M.C. see no objection to permission being granted to build the compound wall and outhouse as shown on the plan submitted but the owner who is informed that the condition of sale of the plot provides for only one bungalow being seated on the plot & that this condition must be complied with. You are therefore advised that permission to build as per plan submitted is hereby attached & subject to the above resolution which please note.

Have M.C.

A.M. Inst., C.E.

Engineer,

Karachi Municipality.

(Signed over)

To Mr. Kalichag. F. Murga

Sir

With regard to your
letter dated 29/9/15
received on the 28/9/15
re demolition & re-
building of out house
& the erection of a new
wall on plot No. 60 & 3
Ranchore Q. No. in
pursuing the plan
I am interested
to inform you that
the conditions of sale
of the plot provides for
only one bungalow
being erected on the
plot & that these con-
ditions must be
complied with.
~~I have therefore the honor~~
~~to inform you that~~
that permission to
carry out the work
as per plan submitted
is hereby attached
subject to the above
conditions being
complied with.

V.
27/9/15



KARACHI MUNICIPALITY.

Extract from the Proceedings of the Meeting of the Managing Committee of the
Karachi Municipality held on the 14th Sept 1915.

SUBJECT—

7. Memo No. 9986, dated 7th September 1915, from the Chief Officer and Chief Engineer, submitting with his remarks papers ending with letter, dated 29th August 1915, from Mr. Kalichbeg F. Mirza, requesting permission to build on plot No. 60, E-3, Runchore Quarter.

RESOLUTION No.—

762.- The Managing Committee see no objection to permission being granted to build the compound wall and 4 out-houses as shown on the plan submitted but the owner to be informed that the conditions of sale of the plot provide for only one bungalow being erected on the plot and ^{that these} conditions must be complied with.

Messrs H. J. Mahon and W. N. Richardson record their dissent.

No. 10266 of 1915.

Karachi, 15th Sept 1915.

MEMO.

True extract forwarded to the Engineer for disposal
with file

T. M. C.
For Chief Officer,
Karachi Municipality.

R.