



11

19 GK2
(mm)
2.



Heritage

KMR.CDD.MmQ.1938.17

Office Telephone Nos. 2805, 2806 &
2807



MUNICIPAL CORPORATION,
KARACHI.

LAND MANAGER & ARCHITECT

MAY 23 1938

Reference No. L. C. P. 823/38.

MEMO :

Re : Plan No 19/22-2. Sheet h. hian. Qr.

Plan for area & alb.

on the above plot submitted by Mr. Thandul Narayana
have been approved by the Karachi Municipal Corporation.

18 Land Manager & Architect.
1938

Copy forwarded to —

1. Health Officer,
2. Supdt of Machinery,
3. Assessor,
- ✓ 4. Building Surveyor, with plan,
5. Land Surveyor,
6. Enquiry Officer,

for information and necessary action.

1000-23-2-38.



n n start
d
9/x

P. +

u
don 215

SCALE 8' TO 1"

NOTE: PROPOSED WORK SHOWN RED

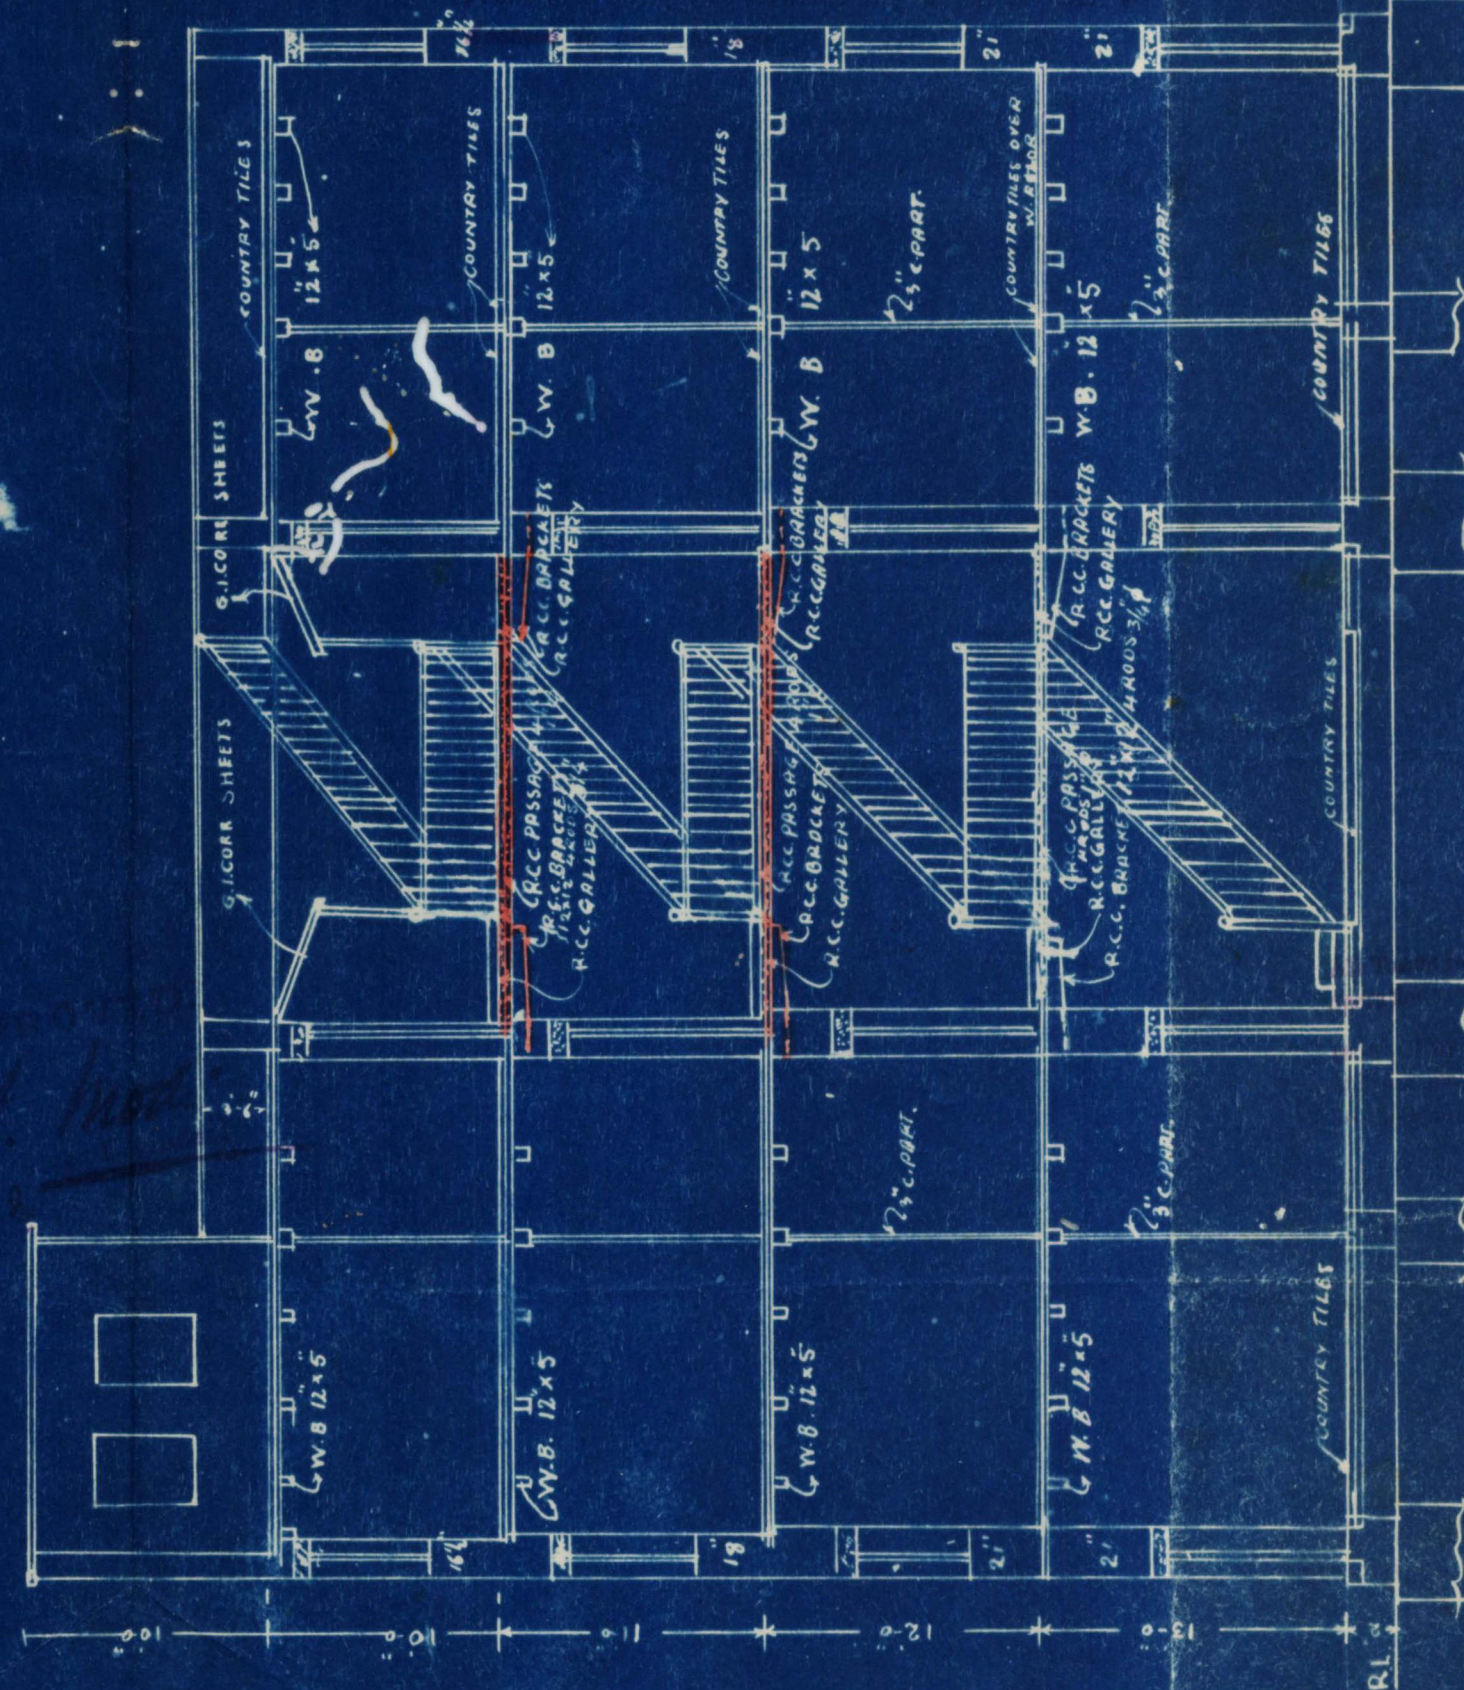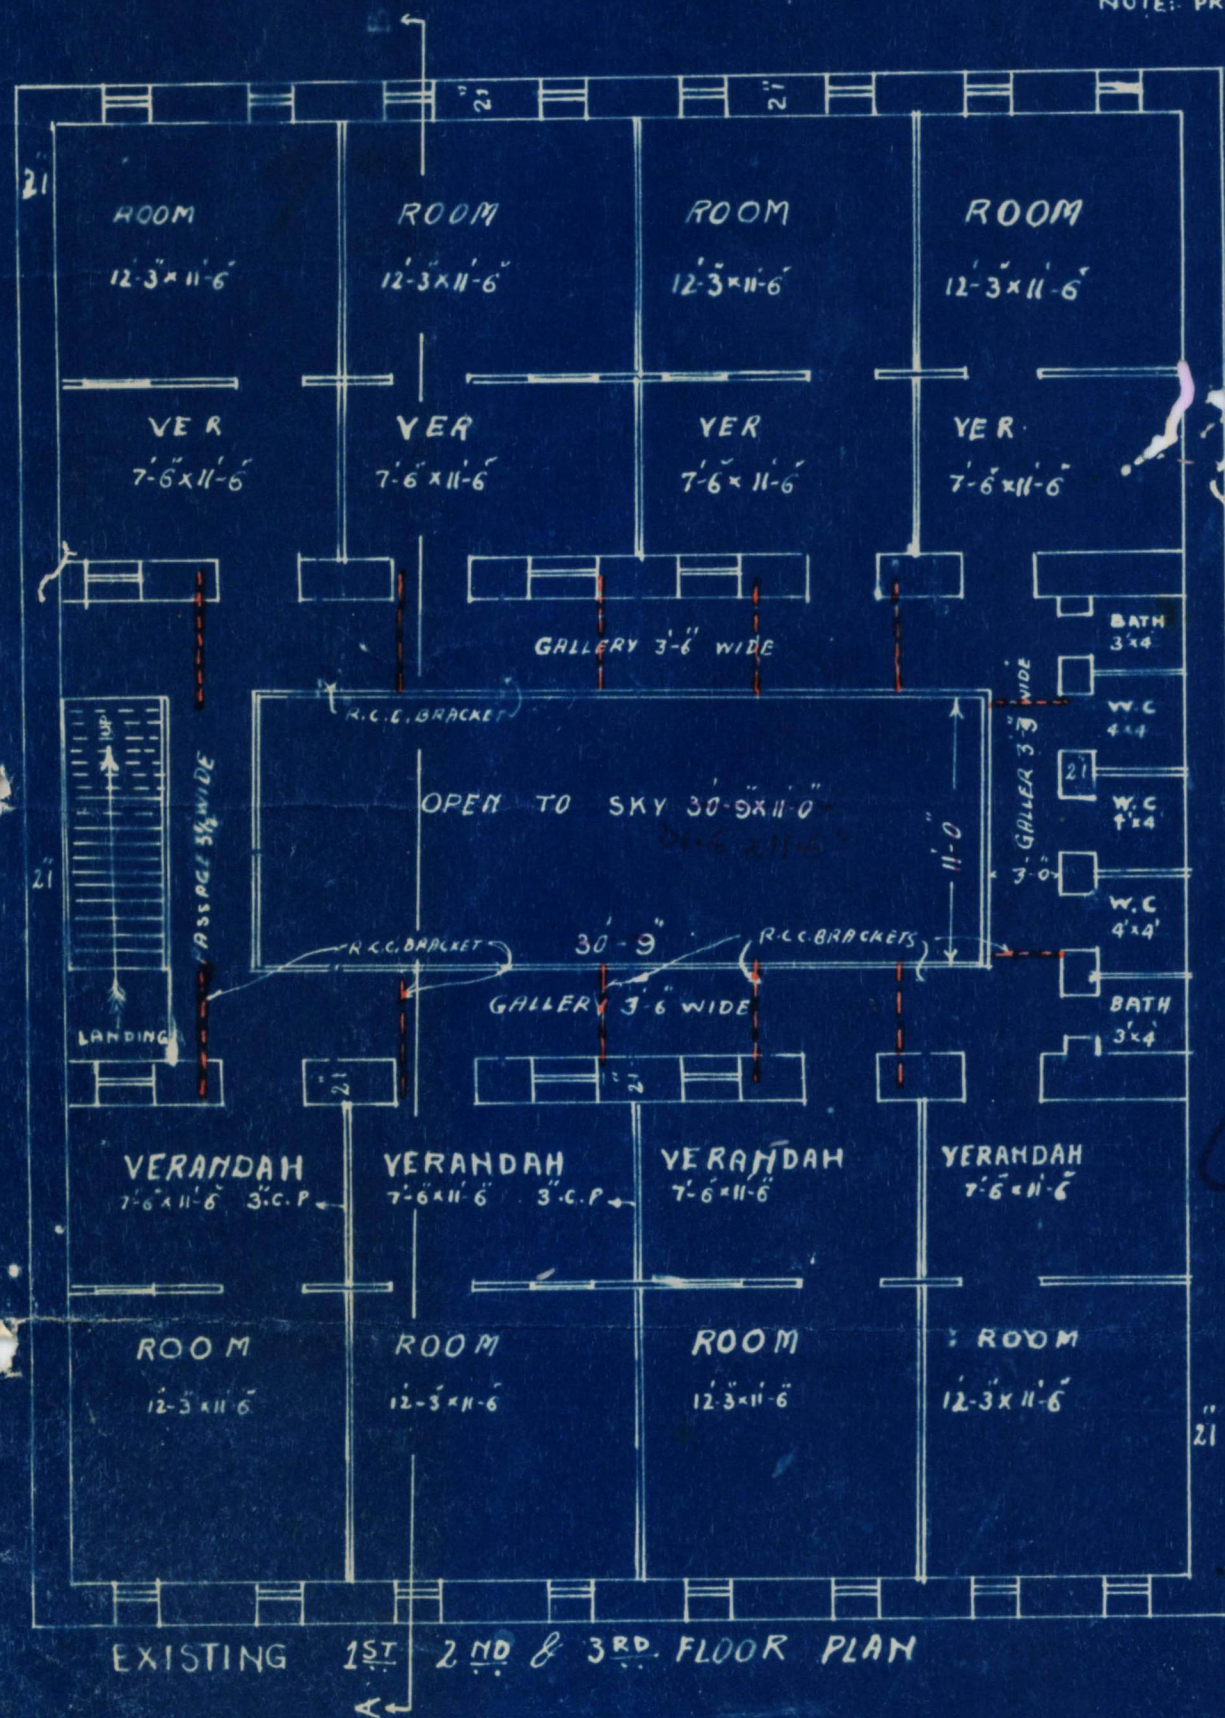

SECTION A-B

is. Tharionel Narayanas
OWNER.

A. H. AGHA
A. H. AGHA,
ARCHITECT, ENG. SURVEYOR,
WATER COURSE ROAD,
KARACHI