



Heritage

KMR.CDD.NaQ.1905.05

17
2

11-4-1905

11-A28 N.P

**OFFICE OF THE CHIEF ENGINEER, K.M.C.**

Section _____

No: CE/ _____

Dated _____

Tenders in sealed covers are invited from the Municipal approved contractors for the following work:—

Tender schedule can be had from the Office of the undersigned on payment of Rs. _____ (not refundable) between 9 A.M. to 12 noon on any working day except the day of opening of the tenders.

A Challan receipt (of Habib Bank K. M. C. Branch) showing cash deposited as earnest money amounting to Rs. _____ which is liable to be forfeited if the tenderer failed to carry out the work according to the schedule, specification and time allowed for the work, should be attached with the tender form.

The tenders will be opened by the Deputy Chief Officer on _____ by 10-30 A. M. in presence of such contractors who wish to be present

CHIEF ENGINEER, K. M. O.

NOTICE BOARDS

Copy to:—

1. The Deputy Chief Officer
2. Assistant Accounts Officer
3. Assistant Executive Engineer, Designs
4. Executive Engineer _____ Division, for information.
5. Store Purchase Officer for pasting on the Notice Board.
6. Financial Adviser & Chief Accounts Officer.



Heritage

KMR.CDD.NaQ.1905.05

The above application is forwarded to the Municipal Land Surveyor for full report regarding the particulars noted below.

Date NO 2776 190

Town Surveyor's Report.

S. M. C. V.
Chief Officer ~~Acting~~ Engineer,
Karachi Municipality.

Particulars.	Remarks.
Whether the applicant is the owner of the plot on which it is proposed to build.	<i>He appears to be owner of his plot.</i>
State Privy accommodation and arrangement for removal of waste water.	<i>He agrees to build a new closet.</i>
Is ventilation sufficient.	<i>Yes</i>
Is light ditto.	<i>Yes</i>
It should be stated exactly the distance the proposed building is to be from an adjoining building.	<i>Three sides are double stone houses and one side is a road.</i>
Other Remarks.	<i>Yours obediently 11-05-05 M. M. Khan</i>

Submitted to the Municipal Chief Officer and Acting Engineer with compliments.

Nathan
Land Surveyor,
Karachi Municipality.

11-05-05



Form No. 1.

Karachi, 11th April 1905.

Notice under Section 96 of the Municipality Act III of 1901.

To

THE CHIEF OFFICER AND ACTING ENGINEER,
KARACHI MUNICIPALITY.

Sir,

I beg to inform you that I intend building a shop

on plot No. 11, Survey Sheet No. A28, situate in Old Market Stn

Street, Napier Quarter.

As required by the Rules of the Municipality I beg to submit herewith
a Plan of the same for your approval.

I beg to remain,

Sir,

[Signature]
Your most obedient Servant,

W. Bhajim Lal Naomani



MEMO.

Plan of proposed building on plot No. 11, Survey Sheet No. 128,

Karis Quarter, is submitted to the Managing Committee

for approval.

Chief Officer and Acting Engineer being of opinion that the plan is

Satisfactory

Dated 11th May 190 5

D. P. H. Candan,
M. I. C. E.,

Chief Officer and Acting Engineer,

Karachi Municipality.

Resolution of the Managing Committee.

MEMO.




The plan showing the shop to be rebuilt
on plot No 11. 128.

NAPIER QUARTER


Scale 8 feet = 1 inch.

Mr. P. H. (Caudan)
Mr. Chief Officer
Karachi Municipality


12/11/1905

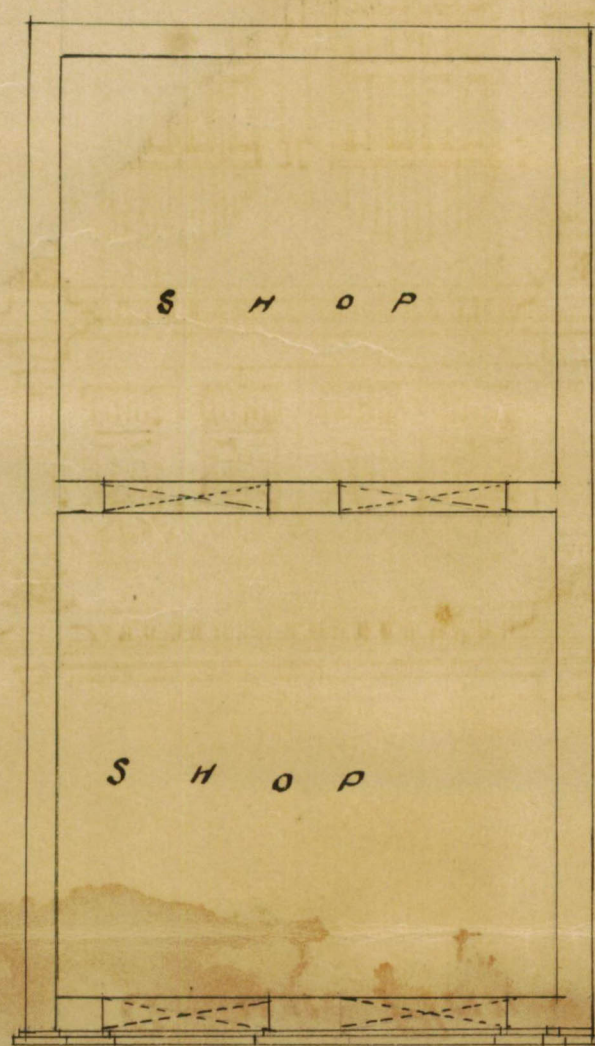


Ground Plan

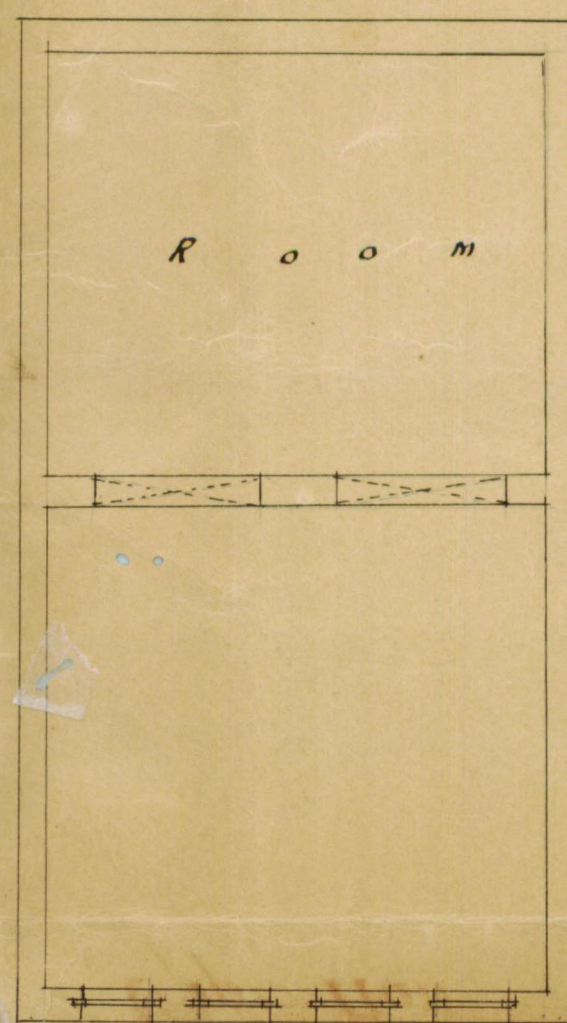

Upper Plan

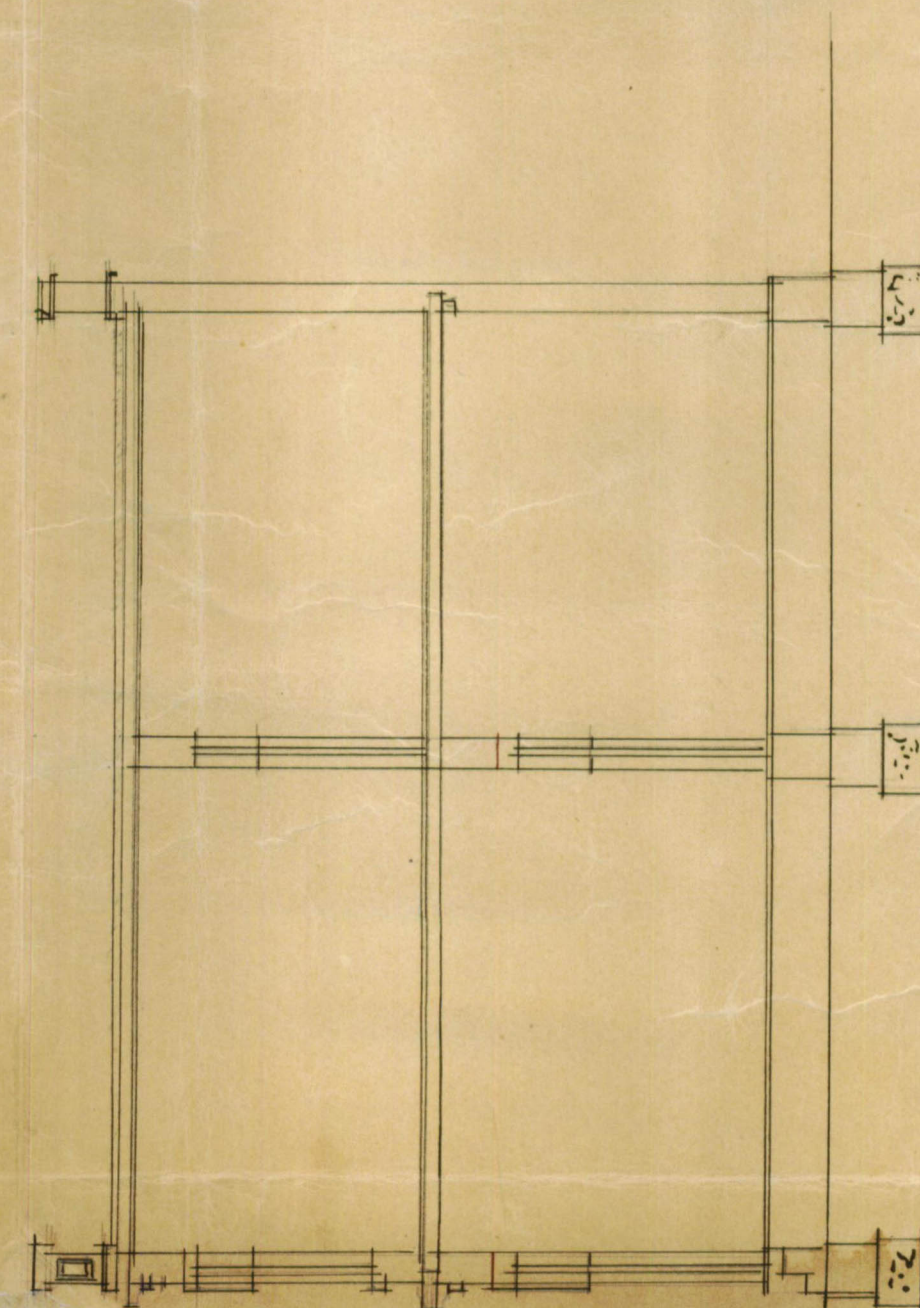

SECTION.

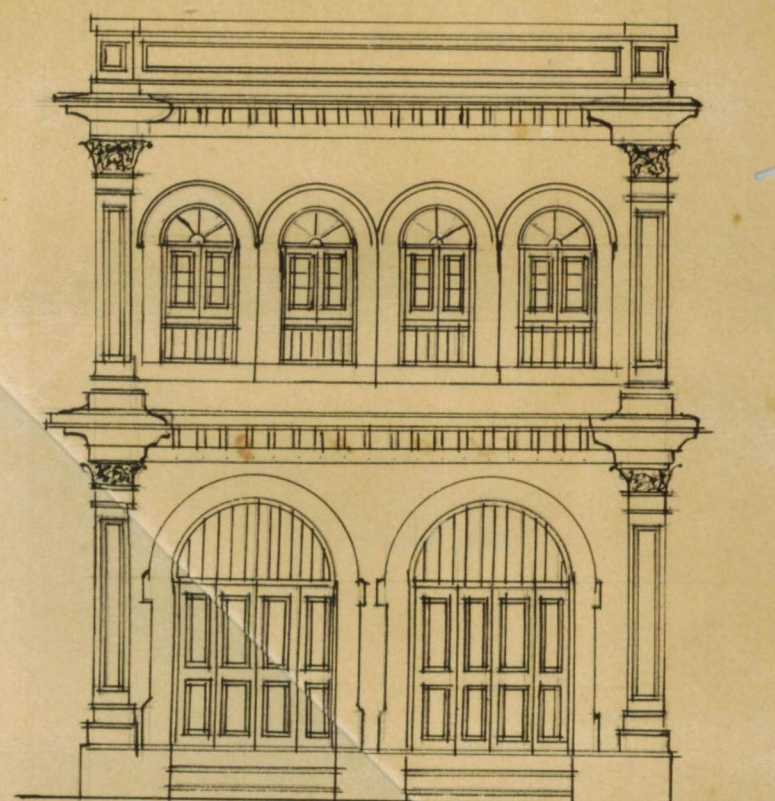

ELEVATION.