



KMR.CDD.JaQ.1932.01

NOTES.



B.S.C.
32

Dr. 3.2.32.

To,
Mr. Abdul Husain Noorhooy Lotia,
Karachi.

Dear Sir,

Re:- Plot No. 4, R.B.9, Rambagh Qr.

With reference to the building erected on
the above plot, I have to request you to sub-
mit the completion certificate duly signed by
the Architect failing which legal action will
be taken against you.

Yours faithfully,

Dr. 2/2
/ B.Sc., A.M. Inst., C.E.,
Land Manager & Architect.

*and
1
copy*

223
7

63467 J. 6



FORM A

[Vide Rule 238/A (1)]

NOTICE UNDER SECTION 96 (1) CHAPTER IX OF THE BOMBAY
DISTRICT MUNICIPAL ACT III OF 1901 AS MODIFIED
UPTO THE 1st MARCH 1915.

Karachi,

20th April 1932

Date of delivery at Municipal Office.

To,

THE CHIEF OFFICER,

KARACHI MUNICIPALITY.

Dear Sir,

Pursuant to the provision of Section 96 of the Bombay District Municipal Act III of 1901 I hereby give you notice that I intend with the meaning of that Section to erect a building on plot No. Old/new 63 & 61 Survey sheet Old/new J-1-6 situated in Swiandes Chaudhary street Jail Quarter as per Ground plan, Elevation and Section sent herewith in quadruplicate.

The said building will be of the following description.

Addition & alteration to 7 room

It is intended for the purpose of

Residence

†Specification of the work will be as follows:—

*I also submit herewith a certificate from the Electrical Inspector to Government as required under Rule 62 (3) of the Indian Electricity rules.

I further beg to inform you that the name of the person whom I intend to employ to supervise the erection of the said building is Shen Keshubhai

I hereby under take to abide by the Bombay District Municipal Act and all rules and bye-laws framed pursuant to the Act.

Yours faithfully,

Signature of the owner

Maghaanul Hiranandji

Address of the owner

eto 1 & another.
Shen Keshubhai

See on the reverse.

*This line to be struck off if there is no electric aerial line passing by the plot.

NOTICE:—1 Printed copy of the extracts of the Bombay District Municipal Act and the rules and regulations framed under Section 48, together with the form of notice under Section 96 (1) can be had from the Municipal Office at.....each.

NOTICE:—2 It is requested that all notices and plans should be delivered to the Office Clerk of the Land Manager and Architect from whom a receipt can be obtained.

4-2
2
Nature of soil in foundation already laidNature of masonry in foundation Concrete Rubble Masonrydo Plinth do.do Superstructure do.Kind of woodwork in trusses, post, etc. PaneKind of Roof P.C. RoofKind of Floor Paved FloorMethod of Drawing Sullage Water Connection with main

:O:

NOTE:—Specification and nature of work should be given against items of work mentioned above.

Karachi, dated 20th April 1932

To

The Chief Officer,

Karachi Municipality.

Sir,

With reference to the notice under Section 96 of the Municipal Act submitted to you by Mr. Maghannal Hirani & others

for the building at 63 & 61 FL-6 Jail Cr.

I beg to inform you that I have agreed to supervise the erection of building work mentioned therein.

I beg to remain,

Sir,



Your most obedient servant,

Benkeshwar

Licensed Surveyor.



SHIVANDAS CHANDUMAL ROAD
35' WIDE

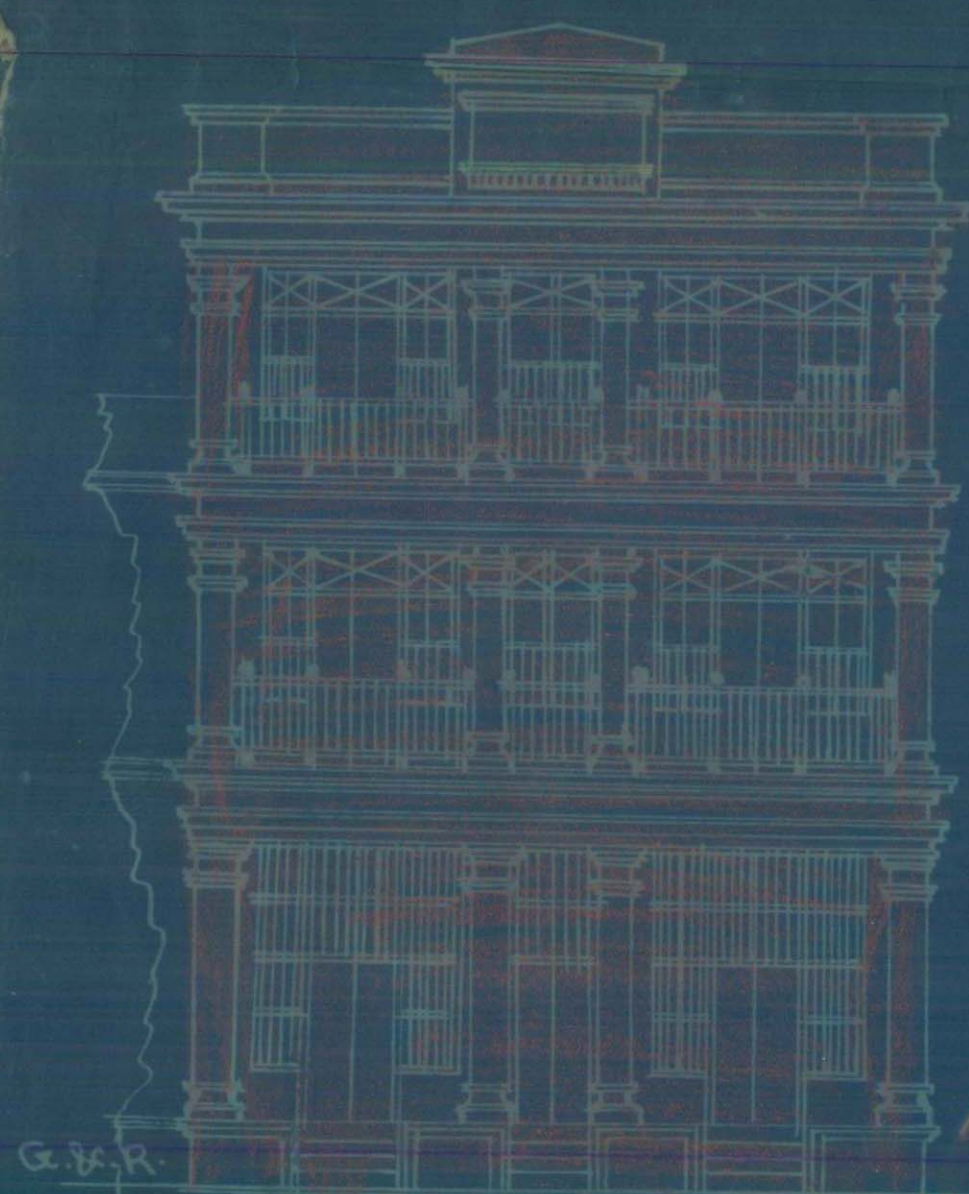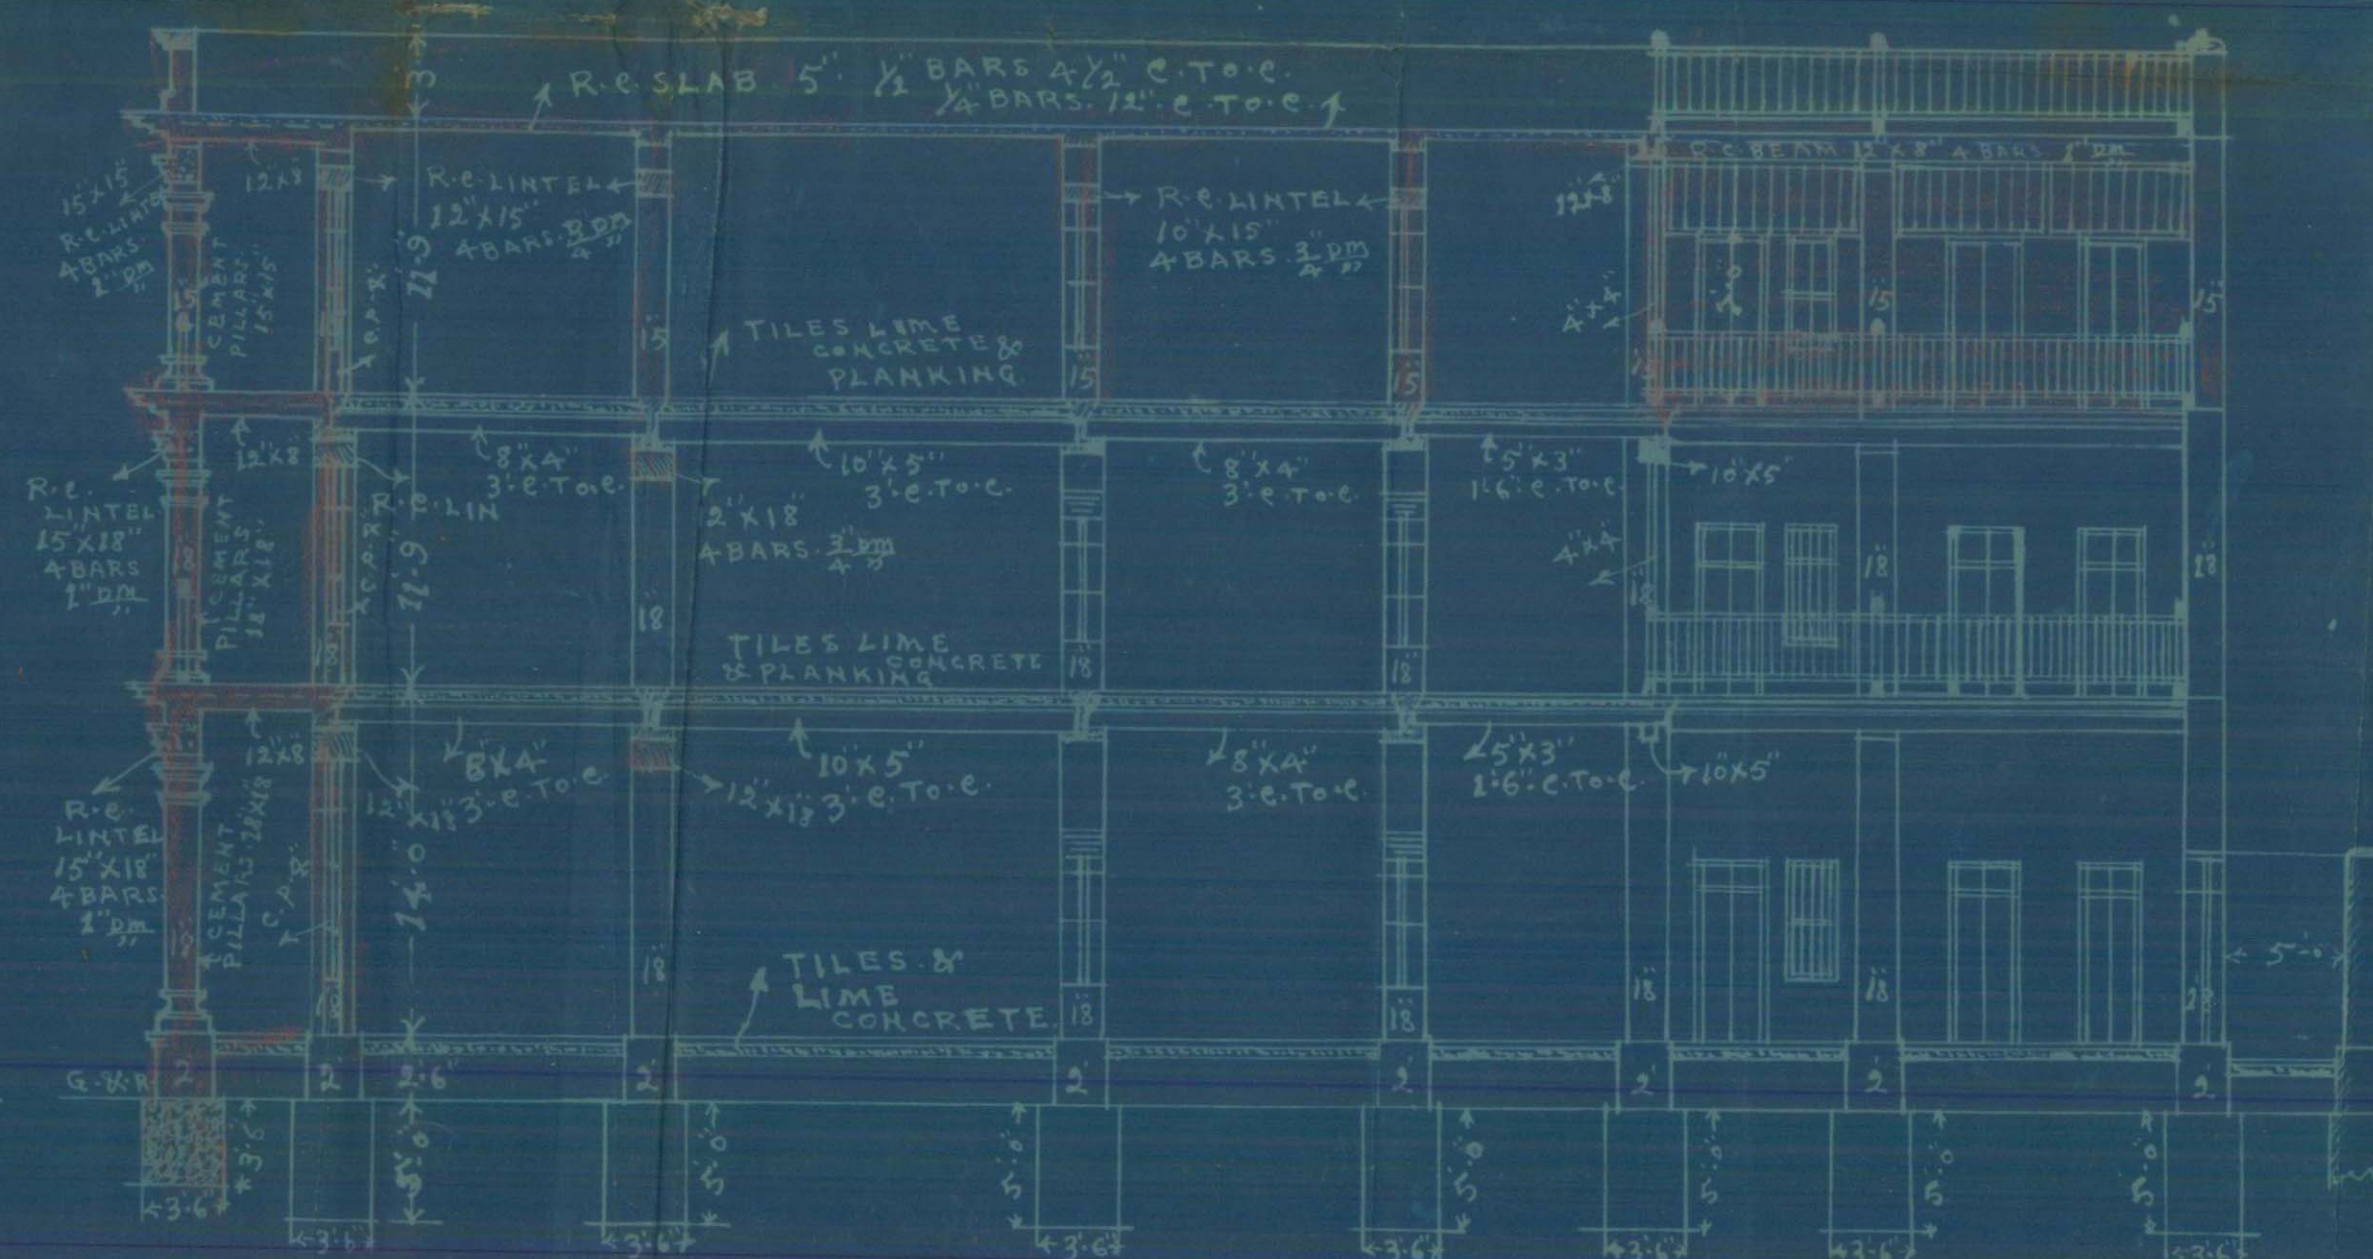

**PLAN OF ADDITIONS & ALTERATION
ON TOP FLOOR TO BE BUILT
PLOT N^o 63+61 SHEET N^o J.L. 6
JAIL QUARTER
SCALE 8'1" INCH**

Maghamand Shrivastava & Son

1911

SECTION ON A.B.