

Map pg no. 6

(1)

$$\frac{1905}{(14)}$$

7 1/2 C 2 M.M.

1-2

SUBJECT 4

A LIVE STOCK RESEARCH STATION FOR SIND FOR ALL CLASSES OF LIVESTOCK.

NOTE BY THE DEPUTY DIRECTOR OF AGRICULTURE, GOVT. BANK.

There cannot be two opinions about the necessity of a central Live Stock Research Station in Sind with respect to genetical and other work in all classes of Live Stock like Cattle, goat, sheep, poultry etc. It is presumed that a well experienced ~~expert~~ expert in animals genetics will be available to be in charge and control of the proposed research station. The proper place to locate this station will depend on the amount of money available for capital, and recurring cost. Besides, if it is intended to have animal nutrition section also, then all facts and circumstances taken together, the choice to ~~which~~ locate the said station will have to be Sakrand. At Sakrand good many facilities already exist and hence the capital and recurring cost will be less if the station is located at Sakrand. The next best choice for locating this station will ^{be} ~~the~~ Willingdon Cattle Farm, Malir. The importance in favour of Malir is its mild climate

--@@--

Shamdas.

2-1

No. L 5419 of 1905.

MUNICIPAL OFFICE,

Karachi 2nd May 1905.3rd

MEMO.

With reference to ^{his} application dated 26th April 1905.Messrs. Deshmukh & Vithalchand are informed thatsons of Raji Karsinthe plan submitted for building an upper story ^{on} his house on plotNo. 71 C2, Rachhi Karsin ^{Rao} Street, Rachhi Karsin Quarter, is

approved, and permission to build in accordance therewith granted.

YoursW. P. H. (Claude)M. I. C. E.

Chief Officer,

Karachi Municipality.

NOTE—This pass does not give permission to occupy Municipal land with building materials. This can only be allowed when the street is wide enough to permit building materials being deposited on it without it being a source of danger to the public, and only then on a hoarding being placed round the land to be occupied, and on payment in advance of fees for occupation of Municipal land, at the following rates :—

				Rs. A. P.
(1)	For the 1st three months, per square yard per diem...	...	0	0 $\frac{1}{2}$
(2)	For the next three months " " "	...	0	0 1
(3)	For any subsequent time " " "	...	0	0 2



Form No. 6.

No. 5426 of 1905.

MUNICIPAL OFFICE,

Karachi, 20 May 1905

Memo.


Quarter. Report should be made to the undersigned when the house is completed.

Handwritten signature

Handwritten signature
D. P. H. Choudhary,
N. I. C. E.,
Chief Officer,
Karachi Municipality.

Through
The Health Officer.



11/5/05
18/4/05

4-1

The ag Chief officer
Karachi Municipality

Sir/

With reference to the
attached application dated 26th
instt together with a plan of
house to be rebuilt on plot No 71 C2
Munchee Mearae quarter. There is no
objection in granting permission with
the Health officer's report.

The plot does not come under
the alignment committee's report.

Yours obediently
27/4/05. Nathan Basha

Forwarded to the Health officer
for favor report.

Smt

Imp. Secy D.H.O.
28/4

D. P. H. (London),
Acting Chief Officer,
Karachi Municipality.

4-2

No objection

Lms

1/5

Land Surveyor

Plan approved for
permission

Lms

D. P. H. (London),
Acting Chief Officer,
Karachi Municipality.

15-
805-



Form No. 1.

Karachi, 26th April 1905.

Notice under Section 96 of the Municipality Act III of 1901.

To

THE CHIEF OFFICER AND ACTING ENGINEER,

KARACHI MUNICIPALITY.

SIR,

I beg to inform you that I intend building to built ^{emc} upper floor, Privy & Bath
on plot No. 7, Survey Sheet No. C.2, situate in Muchee Meanoo Road
Street, Muchee Meanoo Quarter.

As required by the Rules of the Municipality I beg to submit herewith
a Plan of the same for your approval.

I beg to remain,

Sir,

Your most obedient Servant,

Mahomed & Abu Mahomed Sons of Haji Kassim

The above application is forwarded to the Municipal Land Surveyor for full report regarding the particulars noted below.



Chief Officer and Acting Engineer,
Karachi Municipality.

Date *APR. 26. 1905* 190
Town Surveyor's Report.

Particulars.	Remarks.
Whether the applicant is the owner of the plot on which it is proposed to build.	<i>The applicants are the owners of the plot.</i>
State Privy accommodation and arrangement for removal of waste water.	<i>Privy accommodation is proper. It connects with the municipal drain.</i>
Is ventilation sufficient.	<i>Yes</i>
Is light ditto.	<i>Yes</i>
It should be stated exactly the distance the proposed building is to be from an adjoining building.	<i>Three sides are clear and one side is a double story house.</i>
Other Remarks.	<i>Yours obediently 2-5-05. <i>Mohamed</i></i>

Submitted to the Municipal Chief Officer and Acting Engineer with compliments.

Nathan
Land Surveyor,
Karachi Municipality.



MEMO.

Plan of proposed building on plot No. 71, Survey Sheet No. 62,
1

Sanitary Quarter, is submitted to the Managing Committee

for approval.

The Chief Officer and Acting Engineer being of opinion that the plan is

Satisfactory

Summa

M. T. C. E.,

M. T. C. E.,

Daed

21 May

190

5

Chief Officer and Acting Engineer,

Karachi Municipality.

Resolution of the Managing Committee.

MEMO.

PLAN SHOWING PROPOSED UPPER FLOOR

PRIVY & A BATH ROOM TO BE BUILT ON PLOT

N^o 71 C.2 MUCHEEMEANEE Q^R

SCALE 10 FT = 1 INCH. 21/2 of nine 5/16 in




D. P. H. (London),
Acting Chief Officer,
Karachi Municipality.


Final
26/4

Summa
D. P. H. (London),
Acting Chief Officer,
Karachi Municipality.


Reference
Proposed work shown in red,
Old D^o D^o in black.

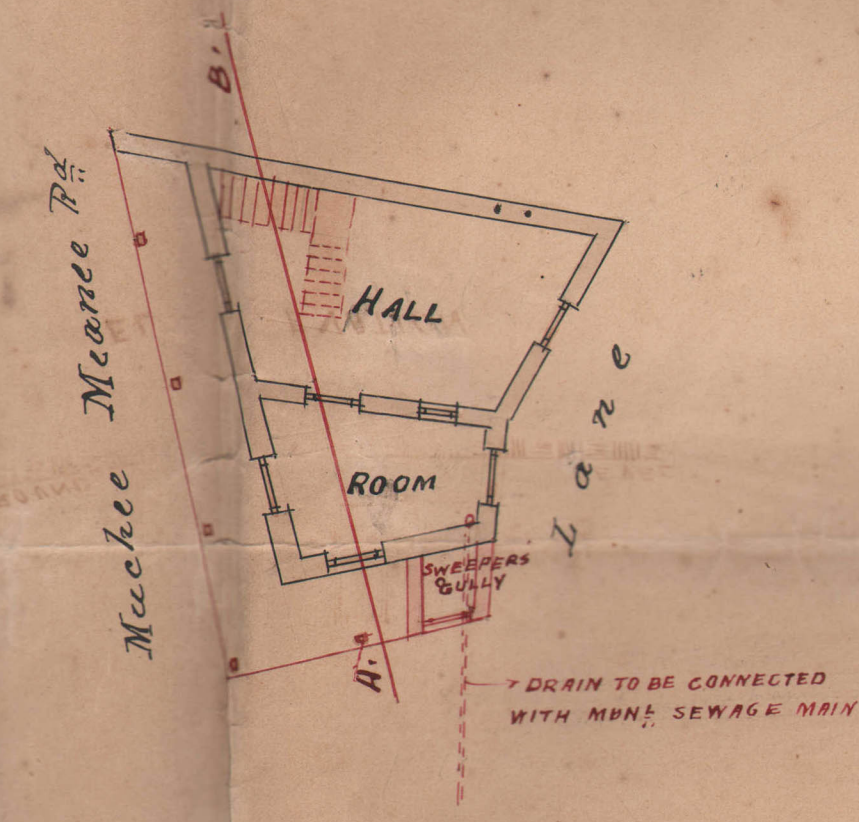



GROUND PLAN

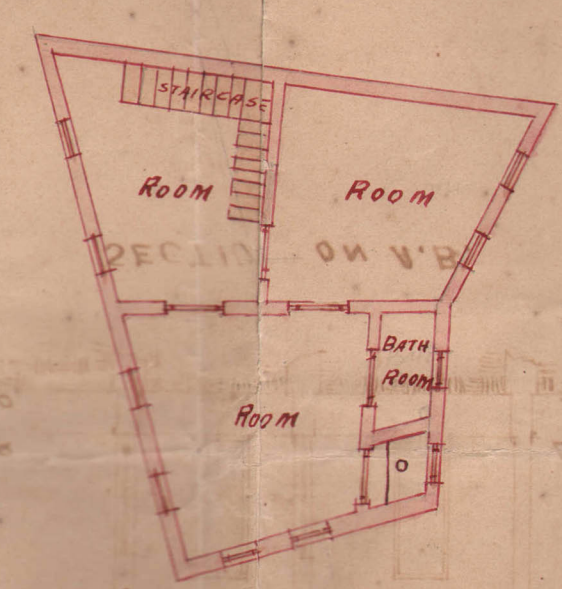


PLAN OF PROPOSED UPPER FLOOR

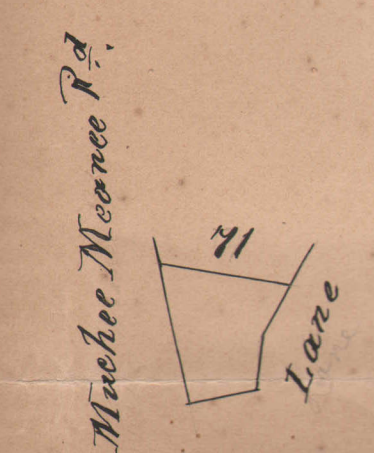

Block Plan
Scale 40 ft = 1 inch.

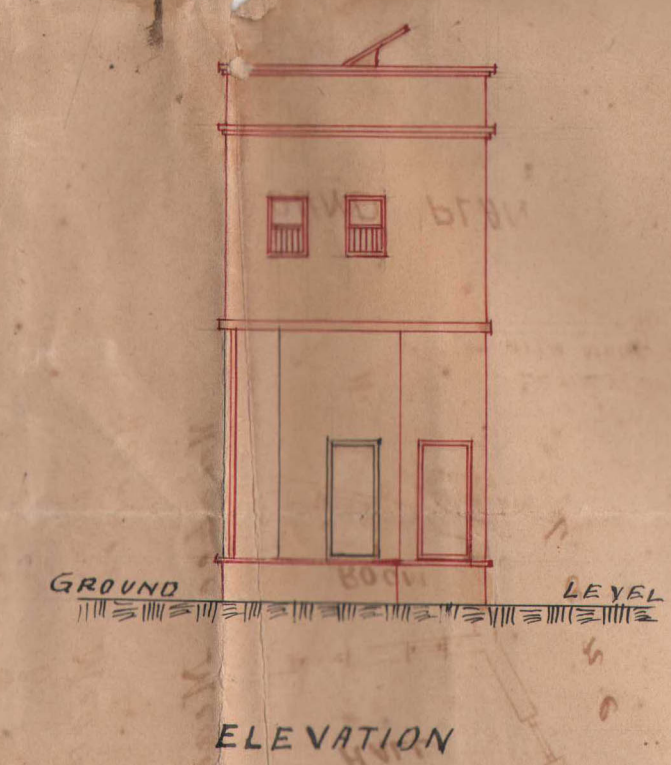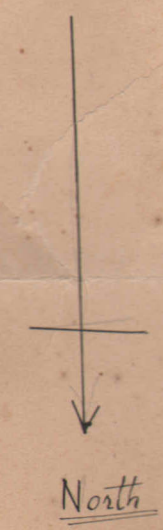

ELEVATION

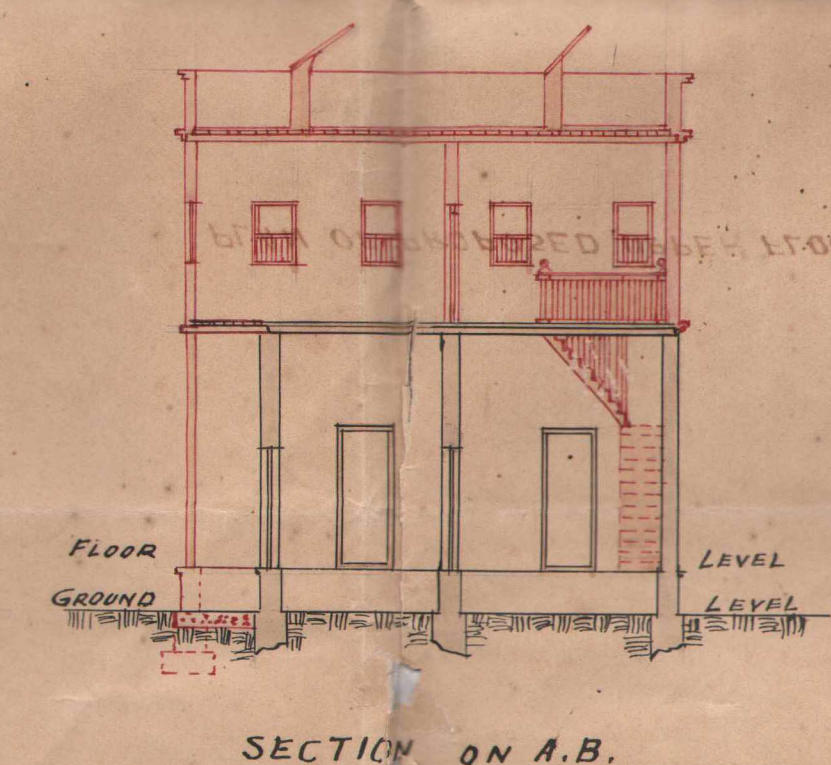

SECTION ON A.B.