


— : SCALE: 8' = 1" INCH : —

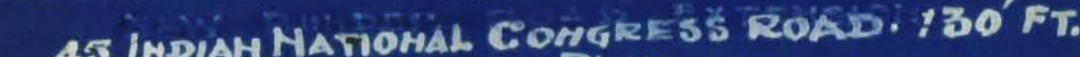

SITE PLAN

—SCALE 30=1—

DETAILS OF AREA


TOTAL BUILT UP AREA = 252.0 SQ YAR
ADD. AREA OF CORNER = 3 SQ YAR

246.7 SQ YARDS
ADD AREA OF PASSAGE A.B. = $4 \times 12 = 48$ SQ. FT.
= 5.3 SQ. YDS.



Justin Lekcham

SIGNATURE OF OWNER -

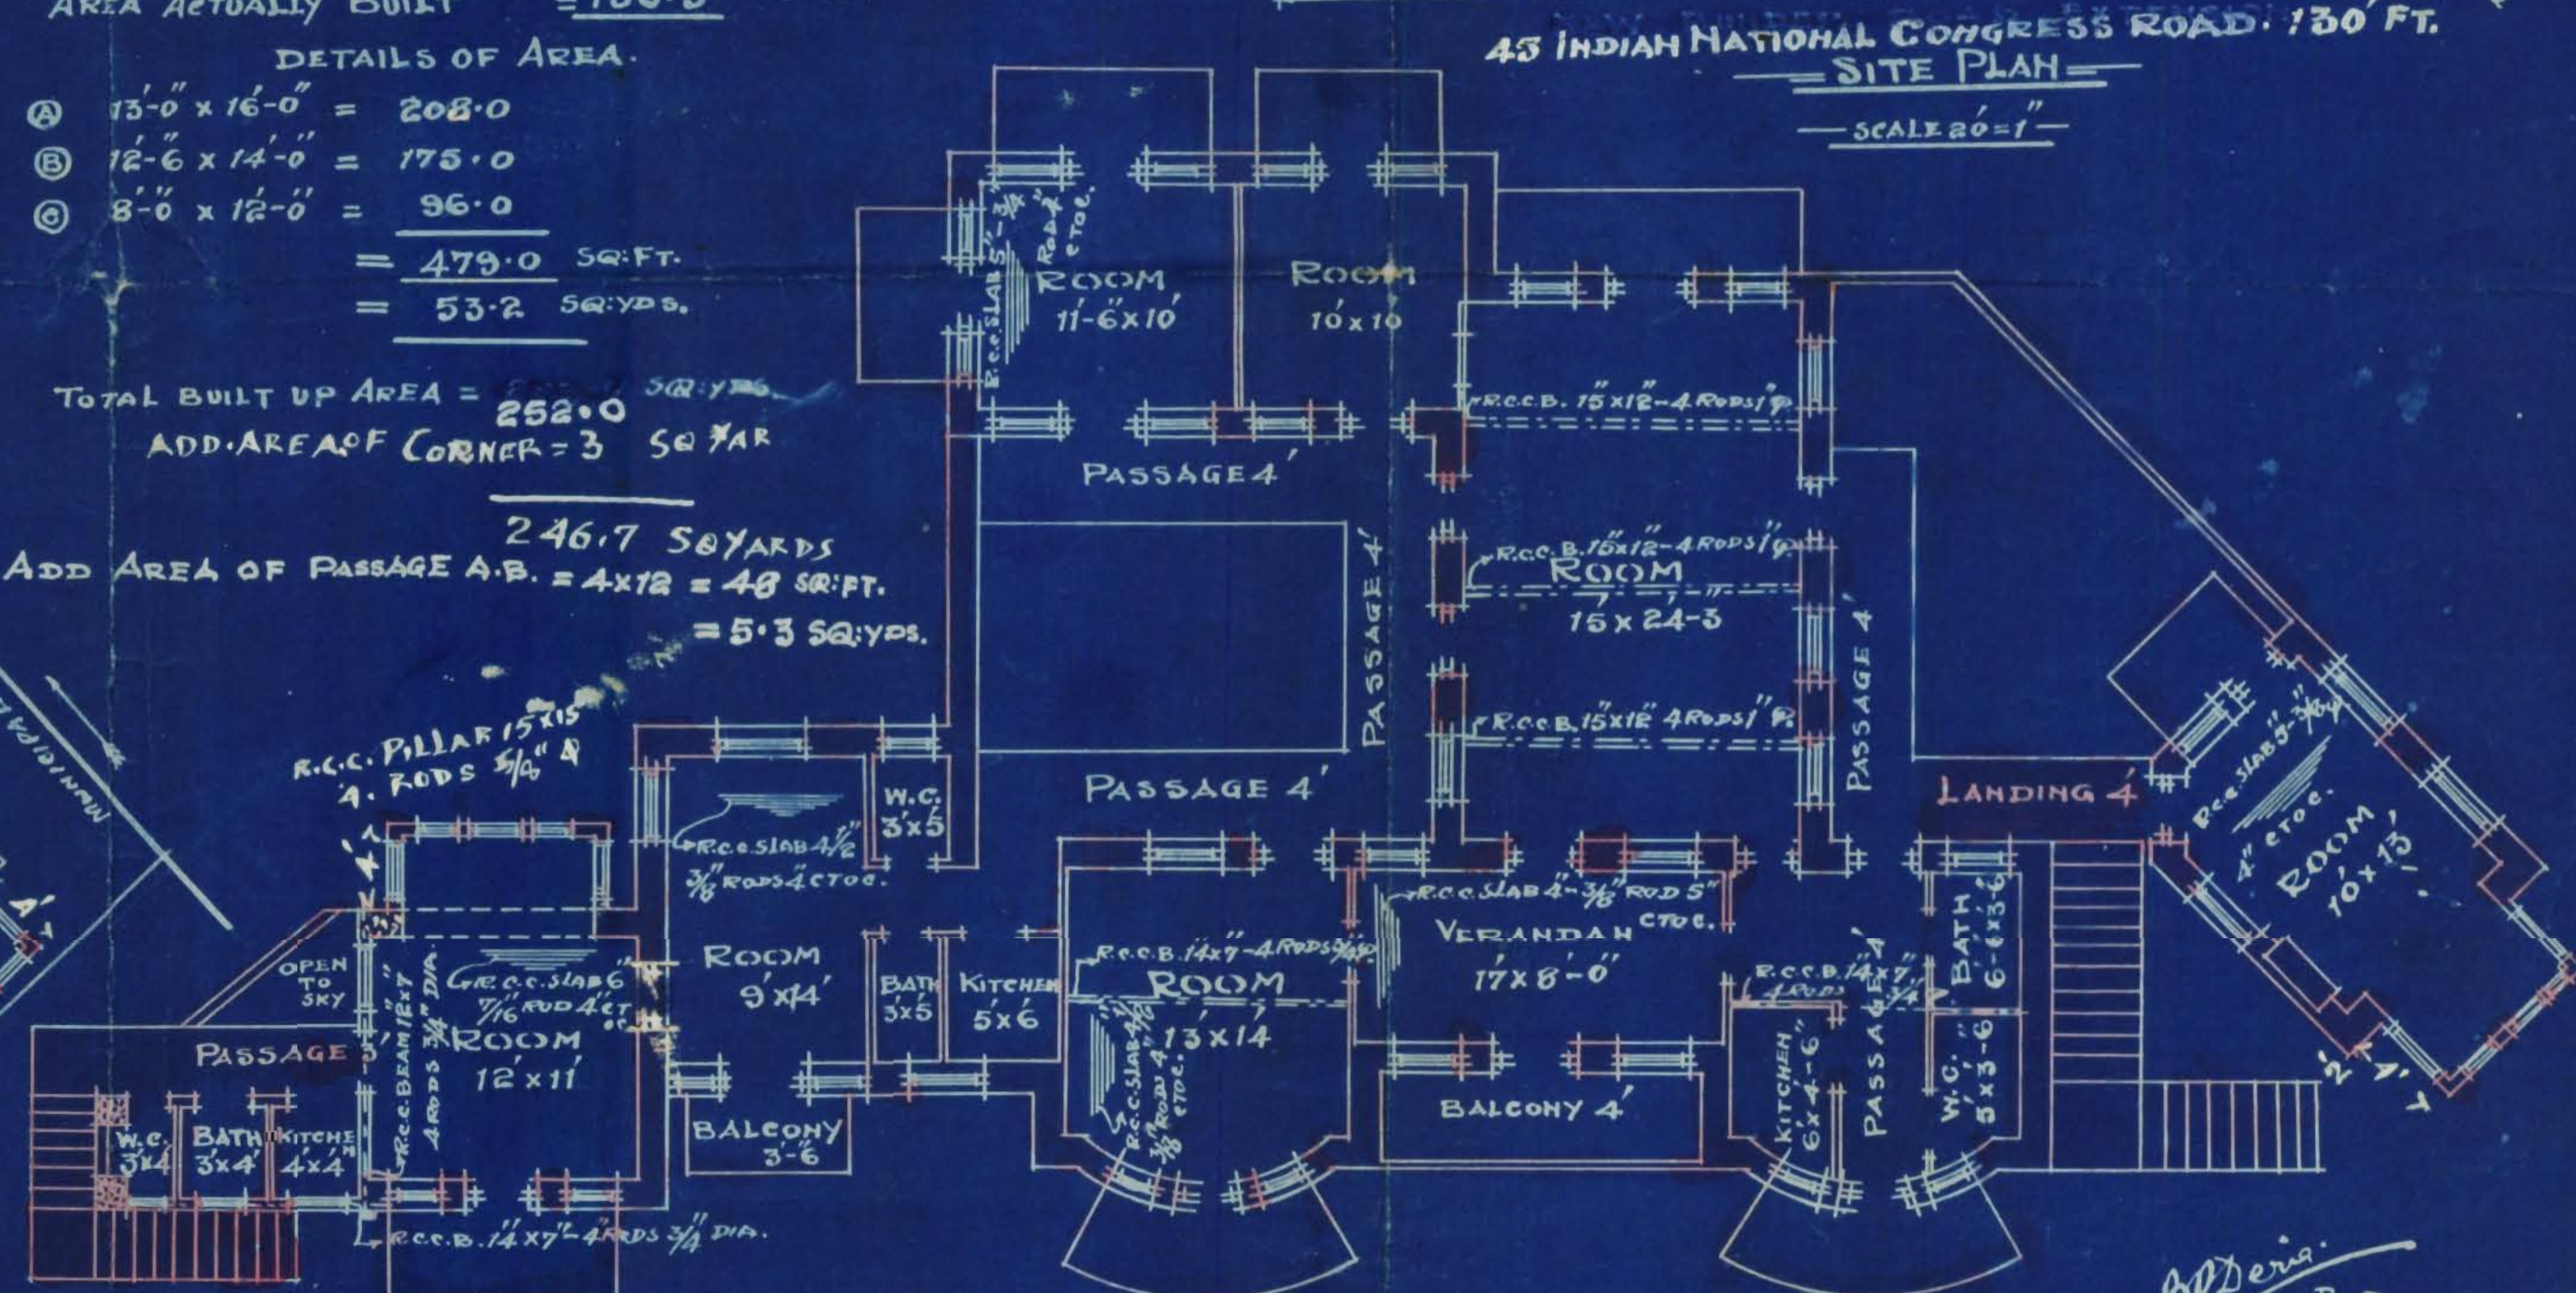

FIRST FLOOR PLAN

ADDRES:
B.E.
DERIA & MOHAN LAL
ENGINEERS & ARCHITECTS
OFFICE:- WATERCOURSE ROAD
KARACHI