



PLAN OF PROPOSED BUILDING ON


PLOT No 192 SHEET K-7

LYAREE Q.R.

SCALE 8"=1"




GROUND PLAN

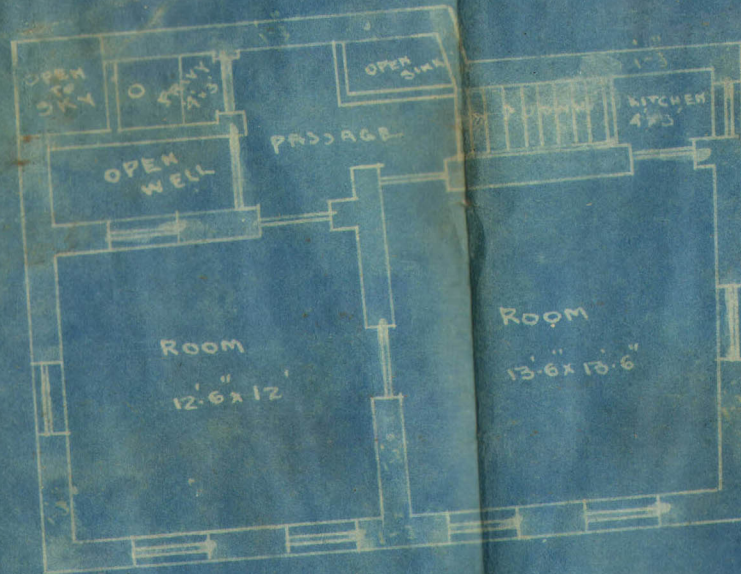


FIRST FLOOR PLAN

SITE PLAN
SCALE 20"=1"

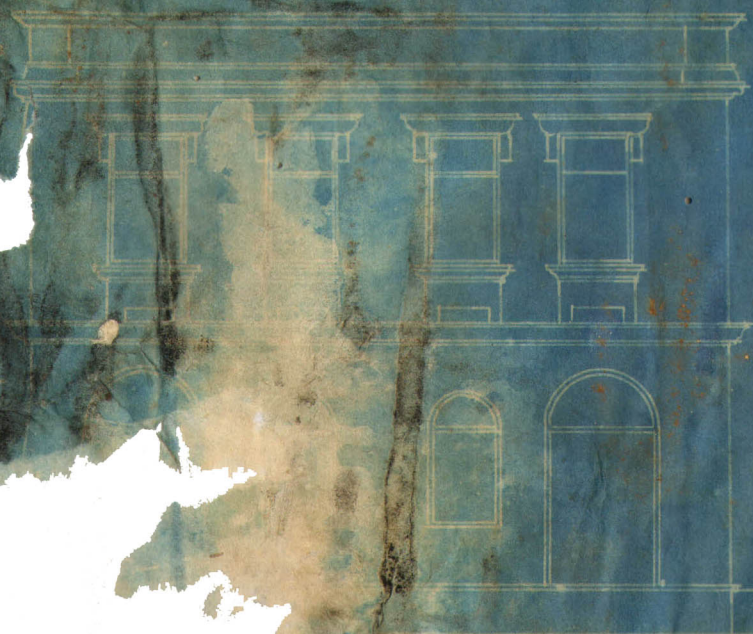

ELEVATION

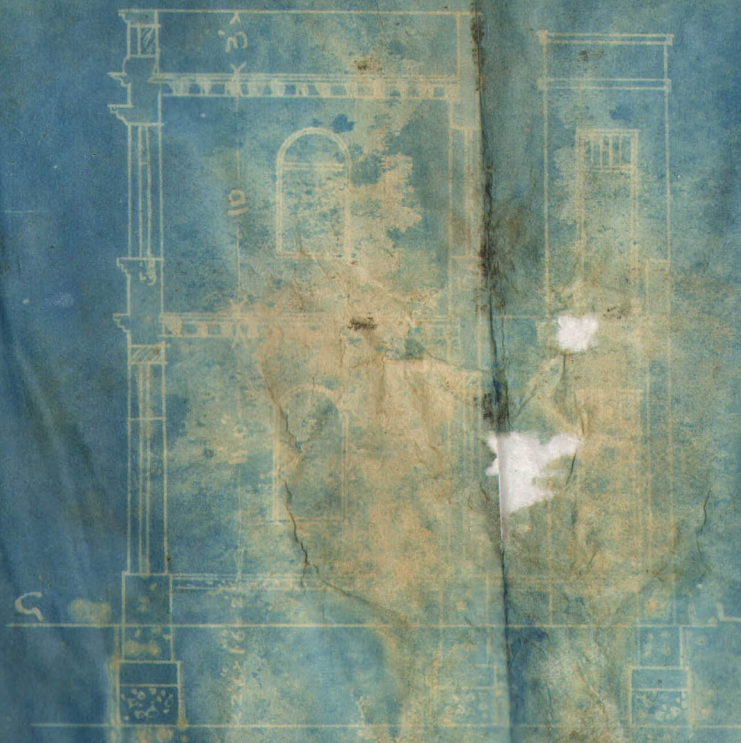

Boysaram B. B. B.

Hirashanker P. B. B.


To,

The Engineer

Municipality

Karachi.

Sir,

With reference to your letter no
P 11227 of the 19th. I beg to send herewith the
plans of plot no 192 K-72 area quarter, amended
accordance with your suggestions. which
will kindly approve at your earliest conven

I beg to remain
Sir,

Your most obedient
Sagaram Bosh.



Heritage

KMR.CDD.LyQ.1917-1918.02

2-2

With reference to
 they to report that
 application has been
 completed the order
 there seems no objection
 to your pass with
 City Dept. Collection




6/18

of H. O. for form
 ref. at. 4

Inspector Allot
 show W.H.O.

7/1/18

Kind Surgeon
 of the

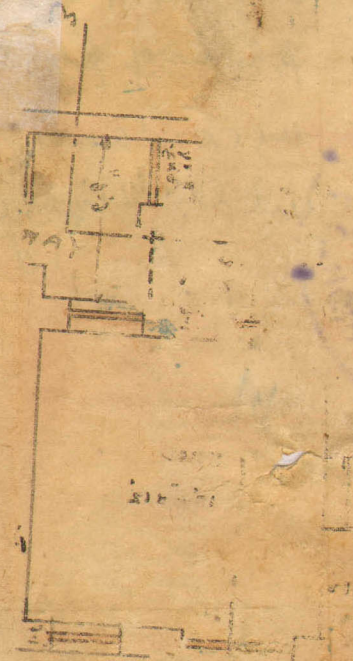



3-1
No. 1168 of 1918,
Revenue Department,
City Deputy Collector's office
Karachi, 26th January 1918.

Memorandum.

With reference to his application dated 14th January 1918, requesting permission to build shops and dwelling rooms on survey No. 192 (sheet K-7) Lyari Quarter, in accordance with plan No. 767 submitted and approved by the Engineer, Karachi Municipality, Seth Dayaram Gordhandas is informed that the permission applied for will not be granted, as the above plot is held on a temporary lease.

2. No building work should be started.

Sd. F. E. Cumming.
City Deputy Collector.

2/1
H. L. M.



Heritage

KMR.CDD.LyQ.1917-1918.02

3-2

Handwritten notes:
No. 1169
of 1918
Revenue Department
City Deputy Collector's office
Karachi, 11 January 1918.
South West

No. 1169 of 1918,
Revenue Department,
City Deputy Collector's office,
Karachi, 11 January 1918.

Copy forwarded for information to the Engineer, Karachi Municipality, with reference to his endorsement No. E/393 dated January 1918.

Permission to build may kindly not be granted as the plots held on a temporary lease.

City Deputy Collector.

H. L. M.

Handwritten mark: \$

*Building Surveyor please
write to the owner and state.*

Naik

23/1



Heritage

KMR.CDD.LyQ.1917-1918.02

No. E

118

of 1918.

Municipal Office.

Karachi. 1st February 1918

MEMO / -

The attention of Mr: Dayaram Gorshandas is drawn to the City Deputy Collector's No. 1168 dated 26th ~~November~~ January 1918 and he is informed that as instructed therein he is not to erect the proposed building on plot No. 192, K-7 Lyari Quarter as the same is held on temporary occupation lease. Any work hereafter carried out will be removed at his risk and cost.

113

J. G. H. Kirby

A.M.Inst.C.E.,

Engineer

Karachi Municipality.

*Li**This may be filed**21/11/20 W.C.*

ity.

5
No. E of 1917.

Municipal Office.

Karachi. 17th December 1917.

MEMO / -

With reference to his application dated 27th Nov 1917 with plans for plot No. 192, K-7 Lyari Quarter Mr: Dayar Gordhandas is informed that the street level must be shown on the section. The foundations and walls must be fully dimensioned and the materials of which constructed, stated.

The plans are herewith returned for amendment.

J. A. M. Inst. C. E.,

A. M. Inst. C. E.,

Engineer

Karachi Municipality

6



Heritage

KMR.CDD.LyQ.1917-1918.02

No. E 392 of 1

Municipal Office.

Karachi. 11th January 19

12

MEMO / -

With reference to his application dated 3rd inst with plans for plot No. 192, R-7 Lyari Quarter Mr: Dayaram Gordhandas is requested to apply for permission to the City Deputy Collector with two copies of plans returned herewith duly signed and approved. He must not start any building on/ tion until he hears further from this office.

A. M. Inst. E. E.,

E n g i n e e r

Karachi Munic

* *****

No. E 392

Municipal O

chi. 11th

Copy forwarded to
reference to his No. 536 dated 27



200-14-8-17.

Form No. 1.

Karachi, 23rd November 1917.

NOTICE UNDER SECTION 96 OF ACT III OF 1901.

To

THE CHIEF OFFICER AND CHIEF ENGINEER,

KARACHI MUNICIPALITY.

SIR,

I beg to inform you that I intend building shops & upperstorey on plot No. 192Survey Sheet No. K-7 situate in _____Street, Gyaree Quarter.

As required by the rules of the Municipality, I beg to submit herewith a
plan of the same for your approval.

I beg to remain,

Sir,

Address:—

Your most obedient servant,

Soyaram Surhand

Signature of the applicant.

Bombay Bazar
Karachi

No. G. 13806 of 1917

MUNICIPAL CHIEF OFFICER

CHIEF ENGINEER'S OFFICE,

Karachi, 27-11-

Forwarded to the Municipal Engineer for favour of disposal!

M.I.N.S.T.C.E.

Chief Officer and Chief Engineer

Karachi Municipality

Mr. NarainShroff27/11



No. E. ² 10418 of 1917.

MUNICIPAL ENGINEER'S OFFICE,
Karachi, 27th November 1917.

MEMO.

The above application is forwarded to the Municipal Health Officer for favour of report.

Summaldalung
A.M.I.C.E.,
Engineer,
Karachi Municipality.

MUNICIPAL HEALTH OFFICER'S REPORT.

Returned to the Engineer, Karachi Municipality, with the following remarks:—

Bath rooms are not finished

1-12-1917
D.P.H. (London),
Health Officer,
Karachi Municipality.

No. E. ² 10418 of 1917.

MUNICIPAL ENGINEER'S OFFICE,
Date 27th Dec 1917.

Forwarded to the Building Surveyor for report.

Summaldalung
A.M.I.C.E.,
Engineer,
Karachi Municipality.

THE LAND SURVEYOR,
Karachi Municipality.



8-3

3

BUILDING SURVEYOR'S REPORT.

0-14-8-17.

Applicant's name

No. 1.

Whether he is the owner of the plot on which it is proposed to build

Plot under whose control

Whether it is permanent or temporary

The work proposed

Building Surveyor's report

Date

191

Building Surveyor.

Submitted through the Land Surveyor.

LAND SURVEYOR'S REPORT.

Does the plot come under Alignment

Area of plot

Area under Alignment

Remarks

ICE,

Date

191

Land Surveyor.

ORDERS OF THE ENGINEER.

The chief level must be shown on these

The foundations & walls must be fully defined

The material of which the walls are constructed



Heritage

8-4
KMR.CDD.LyQ.1917-1918.02

4

No. E.

of 191 .

MUNICIPAL ENGINEER'S OFFICE,

Karachi, 191 .

Submitted to the Managing Committee with a recommendation that
the plan be approved.

A.M.I.C.E.,

Engineer,

Karachi Municipality.

Through

THE CHIEF OFFICER & CHIEF ENGINEER,

KARACHI MUNICIPALITY.

RESOLUTION OF THE MANAGING COMMITTEE.

Resolution No. _____ dated _____

JUR

K