

Map Pgno. 6

1-1

1905

21

43 A 25 N.P

SUBJECT 5

APPOINTMENT OF DAIRY DEVELOPMENT OFFICER

NOTE BY THE DEPUTY DIRECTOR OF AGRICULTURE, DEPT. BANK.

(a) The appointment of such an officer is long over due. The possibilities of building up the dairy industry on proper lines near about big cities and on co-operative basis in the rural areas in Sind, are very great indeed. In order to make available assured supply of pure milk, cream butter etc., at a reasonable rate and within the reach of the majority of people it is necessary to develop this line of work on sound and safe basis. For attaining this aim, it is necessary to have a whole time Dairy Development Officer with adequate staff. Without such an officer it is futile to talk of developing the dairy industry in Sind.

(b) IMPROVEMENT OF URBAN AND RURAL MILK SUPPLY:

Improvement of urban and rural milk supply can be brought about if the general dairy industry is well organised on proper lines. The local bodies - particularly Municipal Corporation of Karachi and Municipalities in big towns can do a lot in this direction by granting subsidies in the earlier stages of development and stabilisation work. To prevent diseases and malnutrition in cities, it is necessary that the municipalities should take a lead in this matter as early as possible. In fact each municipality must have a model up to date dairy of its own as an object lesson for those who intend to ~~take up this valuable object~~ ^{humanitary work as a profession. Those who come forward to take up this} take up this valuable object, reasonable subsidies should be given ~~be given~~ to them during the early stages. The standard of general health of the town population, mortality ratio, and presence or absence of preventable disease as a result of impaired vitality and malnutrition are directly correlated to the availability or otherwise of wholesome, pure and uncontaminated milk, cream and butter etc. in a given town. The cure of disease can be dealt with by removing the cause. Much good money is being wasted by the municipalities on their health Departments but the results are not commensurate with the money spent. Instead of wasting money like that, part of ~~the~~ money should be



Form No. 3.

No. L 4800 of 190 5.

MUNICIPAL OFFICE,

Karachi, 14th April 190 5

MEMO.

With reference to his application dated 3rd April 190 5Mr. Chattomab Khilumab is informed thatthe plan submitted for building Third story his house on plotNo. 43. A25, Khilui Street, Ropar Quarter, is

approved, and permission to build in accordance therewith granted.

[Signature]
 D. P. H. (Laudu),
 M. I. C. E.,
 Chief Officer,
 Karachi Municipality.

NOTE—This pass does not give permission to occupy Municipal land with building materials. This can only be allowed when the street is wide enough to permit building materials being deposited on it without it being a source of danger to the public, and only then on a hoarding being placed round the land to be occupied, and on payment in advance of fees for occupation of Municipal land, at the following rates:—

				Rs. A. P.
(1)	For the 1st three months, per square yard per diem...	...	0	0 $\frac{1}{2}$
(2)	For the next three months " "	...	0	0 1
(3)	For any subsequent time " "	...	0	0 2



Form No. 6.

No. 41802 of 1905.

MUNICIPAL OFFICE,

Karachi, 14th April 1905
15th

Memo.

Inspector Of Dapir Quarter is informedthat Mr. Chaitanab Chinnab has been permittedto build a two story on his houseon plot No. 43. 25- Khicir Street, Dapir

Quarter. Report should be made to the undersigned when the house is completed.

D. P. H. Chaudhary,

M. I. C. E.,

Chief Officer,

Karachi Municipality.

Through
The Health Officer.

R703

8-4-08



Sir/

Chief Officer and Ag Engineer
Karachi Municipality.

With reference to the attached application dated 30th instant together with a plan of a house to be rebuilt on plot No 43 A 25. & pier quarters.

I beg to report that the applicant wants to build a third floor. on densely located room. It is rather ^{unsanitary} ~~dangerous~~ to allow so many rooms to be built on a plot. Health officer may kindly be asked to report

Yours obediently,

7-53
4

Nathani

Forwarded to the Health officer for favour report.

Respectfully

Chief Officer & Ag. Engineer,
Karachi, Municipality.

12
1674

Mr.

no objection

has

1674

and Bureau.

Have approved from.

permission

Secretary of the Board

of Chief Officer

Barack -

1674

Bob -

Karachi, 3 4 1905.

To

THE CHIEF OFFICER AND ACTING ENGINEER.

KARACHI MUNICIPALITY.

SIR,

I beg to inform you that I intend building

on plot No. 43, Survey Sheet No. A25, situate in Khulin

Street, *Nabeer* Quarter.

As required by the Rules of the Municipality I beg to submit herewith
a Plan of the same for your approval.

I beg to remain,


Sir,

Your most obedient Servant,

in Chatoonal Athlounal



The above application is forwarded to the Municipal Land Surveyor for full report regarding the particulars noted below.

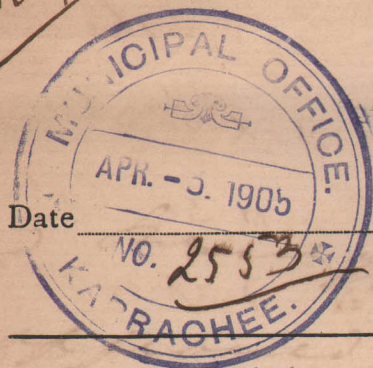

Date 190

Town Surveyor's Report.

M. I. C. E.,
Chief Officer and Acting Engineer,
Karachi Municipality.

Particulars.	Remarks.
Whether the applicant is the owner of the plot on which it is proposed to build.	The applicant is the owner of the plot.
State Privy accommodation and arrangement for removal of waste water.	Privy accommodation is proper & connected with the municipal drain.
Is ventilation sufficient.	Yes
Is light ditto.	Yes
It should be stated exactly the distance the proposed building is to be from an adjoining building.	Two sides are streets and two sides are double storied houses.
Other Remarks.	14/05/05 Nathaniel

Submitted to the Municipal Chief Officer and Acting Engineer with compliments.

14/05/05 Nathaniel
Land Surveyor,
Karachi Municipality.



5-3

3

MEMO.

Plan of proposed building on plot No. 43, Survey Sheet No. A25Kapis Quarter, is submitted to the Managing Committee

for approval.

The Chief Officer and Acting Engineer being of opinion that the plan is

SatisfactoryDated 14. April 1905Chief Officer and Acting Engineer,
Karachi Municipality.

M.I.C.E.,


Resolution of the Managing Committee.

MEMO.




Plan section & Elevation of
Proposed Building on Plot No 43 A 25.
Khilin Street
Napier Quarter
Scale 20 Feet to one Inch

27/3
3/4/05

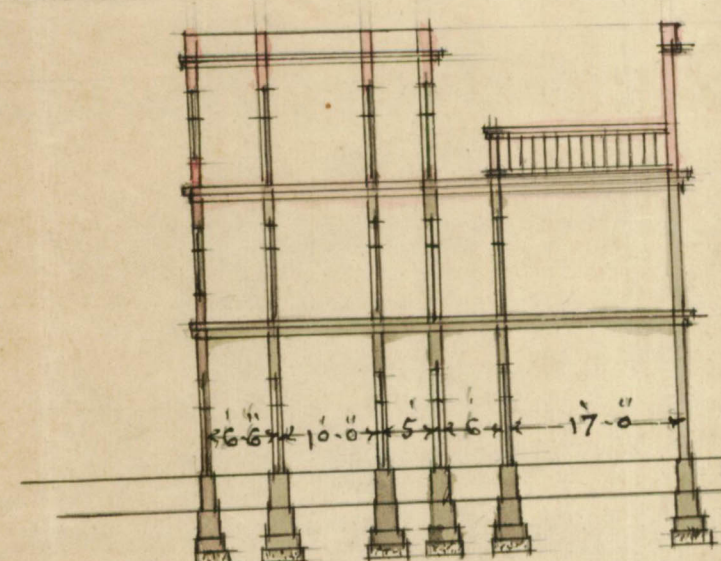


SECTION ON A.B.

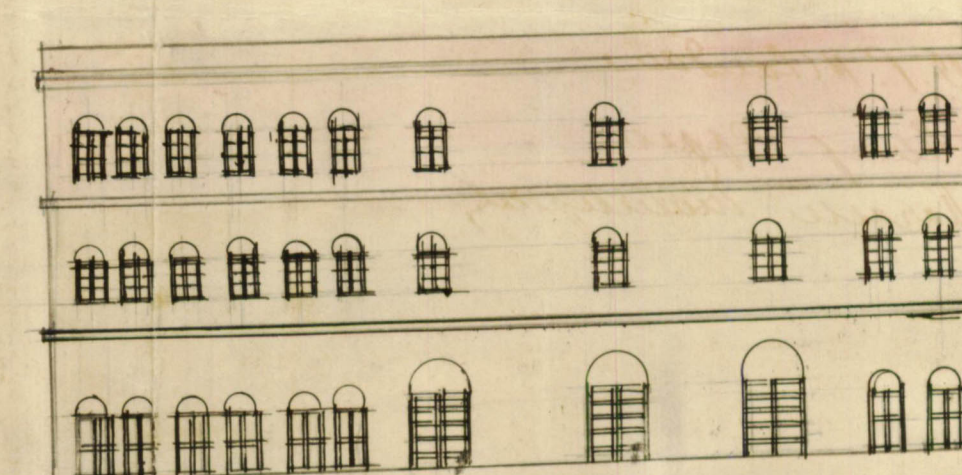


ELEVATION


Signature
D. P. H. (auditor)
Ag: Chief Officer
Karachi Municipality

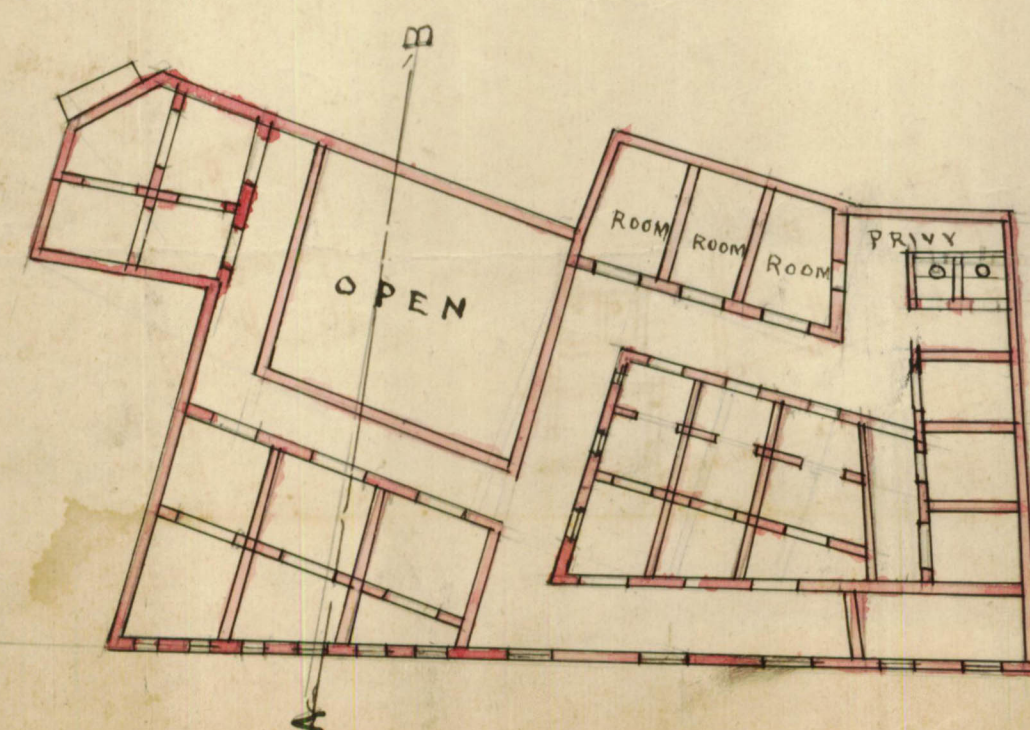

THIRD STORY

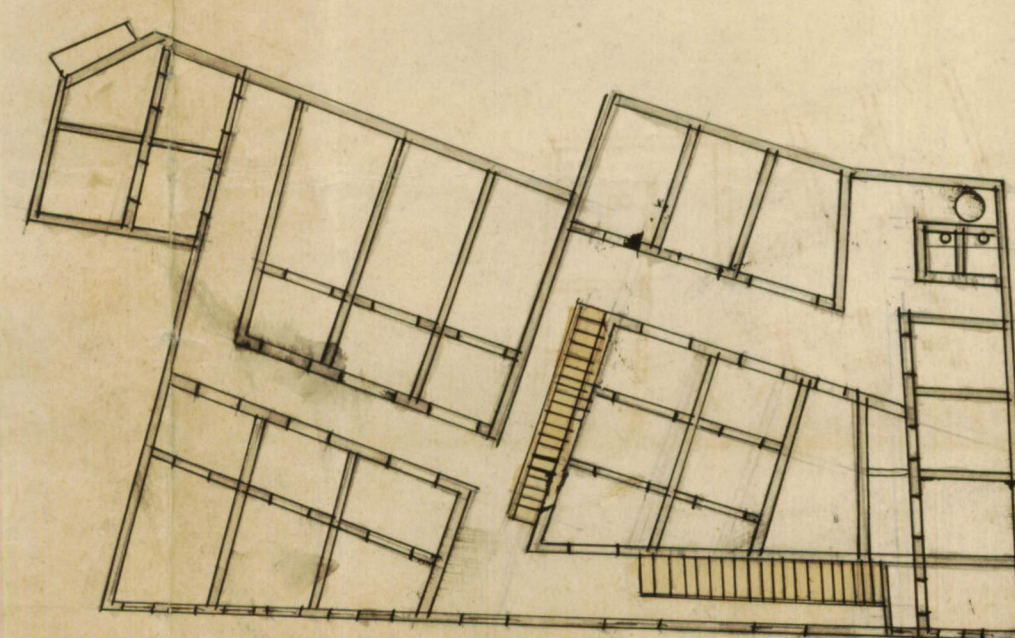


UPPER FLOOR

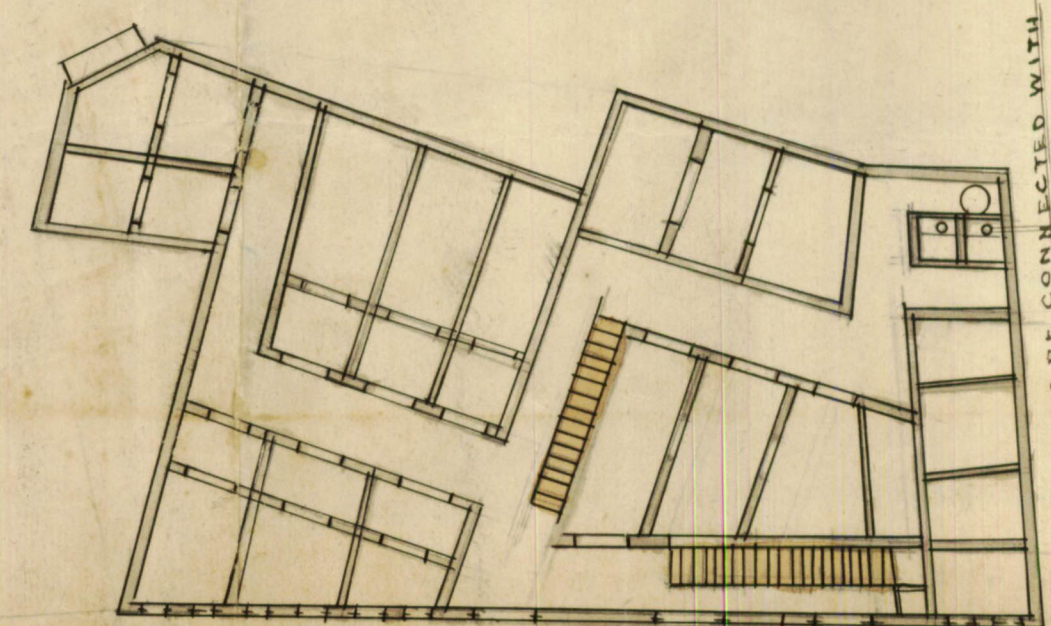

GROUNDPLAN

BLOCK PLAN
SCALE 20 FEET TO ONE INCH

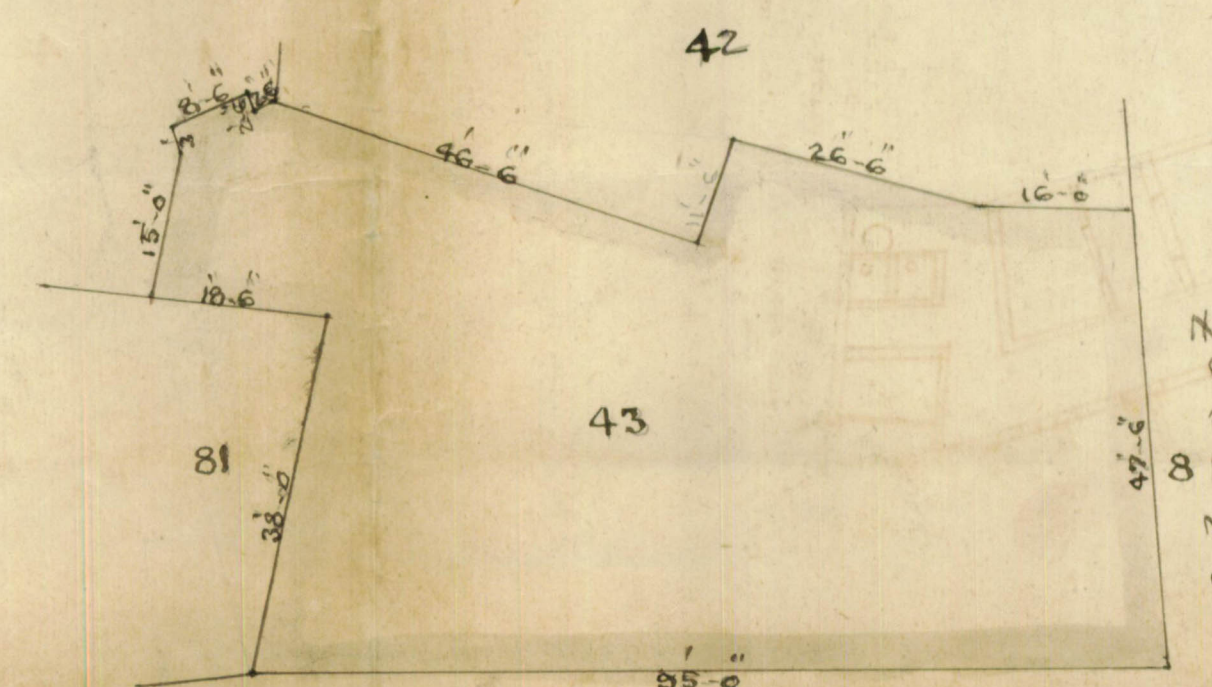

Khilin Street