



No. 101
Municipal Office
Karachi. 22nd May 1917.

0 / -
With reference to his application dated 7th instant with plans for plot No. 37, K-8 Lyari Quarter Mr. Mahomedali Alamgir is informed that permission to sub-divide the plot shown on the plan will not be permitted. The proposed and the existing buildings are dark and badly ventilated. The plans are disapproved and returned herewith for amendment.

The printed form is herewith sent which should be returned duly signed by all the registered occupants of the plot.

39

J. A. H. Verley

A. M. Inst. C. E.,

E N G I N E E R

KARACHI MUNICIPALITY.

216
This may be filed

24/11/20

Recd



2

No. E 9120 of 1917.

Municipal Office.

Karachi. 10th October 1917.

MEMO / -

With reference to his application dated 5th inst. with plans for plot No. 58, K-11 Lyari quarter Mr. Noor Mahomed Yacoub is informed that as instructed in this office No. E 8859 dated 3/4th October 1917 he has not properly amended the plans. A clear space of 15'-0" must be left between the shops and the godowns and the plans amended accordingly which are returned herewith.

J. M. Inst. C. E.
A. M. Inst. C. E.,Acting Chief Officer and Chief Engineer
Karachi Municipality.



Heritage

KMR.CDD.LyQ.1917-1918.01

5 October 1917

3-1

Re plans of Plot no 58. K-11

To Engineer
5/10The Chief Officer & Chief Engineer
Karachi Municipality

Sir.


15/10/17

In compliance with your memo
no E 8859 dated 3rd inst. I beg to submit herewith
a set of plans amended in accordance with your
instructions contained in the above memo. Now I hope
you will not delay in the approval of the same.

I beg to remain

Sir

Your most obedient servant

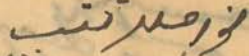

i.e. Naor Mahomed Yakub

c/o

Pallhak & Co
architects

824



Sci,

I enc attach and
beg to say that the plan
has not been answered
as suggested. So that it
can be forwarded to the
applicant for answer.

Respect your order

Yours truly

K. J. P.

8/10

The amount must be
asked for must be
carried out. a clear
of all 215's must be
left between the shops &
the go down



No. E 8659 of 1917.

Municipal Office.

Karachi. 3rd October 1917.

MEMO / -

With reference to his application dated 14th Sept. 1917 with plans for plot No. 58, K-11 Lyari Quarter Mr: Noor Mahomed Yakub is informed that an open space 15 feet wide should be left between the shops and the godowns.

Also the godowns should be further curtailed so as to provide space to permit the sanitary conveniences to be placed nearer to the houses and in a more convenient position from the road for the removal of the contents therefrom.

The plans are herewith returned disapproved.

M. Inst. C. E.,

Chief Officer and Chief Engineer

Karachi Municipality.

82

Mr. Montcho please type as
per Co. R. E. Smith.
AS

2/10



6-1

200-6-1-17.

Form No. 1.

Karachi, 14 September 1917.

NOTICE UNDER SECTION 96 OF ACT III OF 1901.

To

THE CHIEF OFFICER AND CHIEF ENGINEER.

KARACHI MUNICIPALITY.

SIR,

I beg to inform you that I intend building godown and
shops on plot No. 58

Survey Sheet No. K-11 situate in — — —

Street, Lynce Quarter.

As required by the rules of the Municipality, I beg to submit herewith a plan of the same for your approval.

I beg to remain,

Sir,

Your most obedient servant.

Submitted
 3 c/o
 Pattrick & Co
 architects

ce Noor Mahomed Yakub
 Signature of the applicant.

No. G. 11206 of 191

MUNICIPAL CHIEF OFFICER AND

CHIEF ENGINEER'S OFFICE.

Karachi, 14-9- 1917

Forwarded to the Municipal Engineer for favour of disposal.

*In Karachi
 Show to H.O.
 24/9/17*

Naunji~~M. INST. C. E.~~

m Chief Officer and Chief Engineer,
 Karachi Municipality.

6-2
No. E. ² 8356 A of 1917

MUNICIPAL ENGINEER'S OFFICE.

Karachi, 14th Sept: 1917.

MEMO.

The above application is forwarded to the Municipal Health Officer for
favour of report.

W. M. L. C. E.
A. M. I. C. E.,Engineer,
Karachi Municipality.

MUNICIPAL HEALTH OFFICER'S REPORT.

Returned to the Engineer, Karachi Municipality with the following
remarks—

*No objection**D. P. H.*
D. P. H. (London),
Health Officer,
Karachi Municipality.

Date 18-5-1917

No. E. ² 8356 A of 1917

MUNICIPAL ENGINEER'S OFFICE,

Date 18/5/1917.

Forwarded to the Building Surveyor for report.

W. M. L. C. E.
A. M. I. C. E.,Engineer,
Karachi Municipality.

Through

THE LAND SURVEYOR,

Karachi Municipality.



BUILDING SURVEYOR'S REPORT.

Applicant's name Norman Jacob
 Whether he is the owner of the plot on which it is proposed to build yes
 Plot under whose control Municipal
 Whether it is permanent or temporary Permanent
 The work proposed Build Shop & Living room

Building Surveyor's report See

I beg to report that there appears no objection to the plans & graph for no. Request order.

Date 21/9 1917.

S. H. N. S.
 Building Surveyor.

Submitted through the Land Surveyor.

LAND SURVEYOR'S REPORT

Does the plot come under Alignment no

Area of plot —

Area under Alignment —

Remarks See with reference to this I beg to report that there seems no objection to the plans but while providing the private street to the south east it will be too long to remove the dirt water etc. Request your order

Date 21-9- 1917.

S. H. N. S.
 Land Surveyor.

ORDERS OF THE ENGINEER.


A. M. I. C. E.,
 Engineer,
 Karachi Municipality.



4

No. E. of 191

MUNICIPAL ENGINEER'S OFFICE.

Karachi 191

Submitted to the Managing Committee with a recommendation that
the plan be approved.

A. M. I. C. E.,

Engineer,

Karachi Municipality

Through

The CHIEF OFFICER & CHIEF ENGINEER.

KARACHI MUNICIPALITY.

• RESOLUTION OF THE MANAGING COMMITTEE.

Resolution No. dated



7
No: L.S. 3144 of 1918.

Municipal Office

Karachi; 21st December 1918.

3rd January 1919

M E M O / _

With reference to his application dated 12th instant with amended plan for the proposed additional rooms etc: on plot No: 38, K-11 Lyari quarter Mr: Haji Abdullah Saboo is informed that the proposed additions will over-crowd the plot. Permission can only be granted to build to the extent of the present out-buildings to the North. The plans are herewith returned for amendment.

J. A. H. Verby

A. M. Inst., C. E.

E N G I N E E R

Karachi Municipality.



Municipal Office
Karachi. 24/12/18

Memo.

2

with reference to his application

D/- 12th instant with ^{amended} plan for the proposed
additional rooms etc on plot No. 38 K. H. Lyari Quarter
Mr Haji Abdulola Sabu is informed that
the proposed ^{addition} ~~building~~ will overcrowd
the plot. Permission can only be granted
to build to the extent of the present
out-building to the North. The plan
~~There is no objection~~
are herewith returned for amendment.



Heritage

KMR.CDD.LyQ.1917-1918.01

9-1

9

Mr. Kharwar for in medical Compliance.

S.H. Kharwar

21/12/18.



9-2
thereof. You are hereby directed to _____ the _____

within three days after the receipt of this notice.

If you fail to comply with this notice, the Municipality will execute
the said work and recover the cost from you in manner laid down in Act III
of 1901.



No: 249

10-1

200-30-9-18.

From No. 1.

Karachi, 12th Dec: 1918.

NOTICE UNDER SECTION 96 OF ACT III OF 1901.

To

THE CHIEF OFFICER AND CHIEF ENGINEER,
KARACHI MUNICIPALITY.

SIR,

I beg to inform you that I intend building Room 22
on plot No. 32Survey Sheet No. K. 11 situate in
Street, Hydrabad Quarter.As required by the rules of the Municipality, I beg to submit herewith a
plan of the same for your approval.

I beg to remain,

Sir,

Address:—

Jamia Masjid

Your most obedient servant,

Haji Abdulasabir

Signature of the applicant.

No. G. 16481 of 1918 .

MUNICIPAL CHIEF OFFICER AND

CHIEF ENGINEER'S OFFICE,

Karachi, 12th December 1918.

Forwarded to the Municipal Engineer for favour of disposal.

Jehman aur

M.INST.C.E.,

Chief Officer and Chief Engineer,

Karachi Municipality.

3370
13th Dec
14.0
85



2

No. E 717/18 of 1918

MUNICIPAL ENGINEER'S OFFICE,

Karachi, 13th Dec 1918.**Memo.**

The above application is forwarded to the Municipal Health Officer for favour of report.

A.M.I.C.E.,

for Engineer,

Karachi Municipality.

MUNICIPAL HEALTH OFFICER'S REPORT.

Returned to the Engineer, Karachi Municipality, with the following remarks:—

The place is overcrowded

D.P.H. (London),

Health Officer,

Karachi Municipality.

Date 16-12 1918No. E 7171 of 1918

MUNICIPAL ENGINEER'S OFFICE,

Karachi, 16/12/18 191

Forwarded to the Building Surveyor for report.

A.M.I.C.E.,

Engineer,

Karachi Municipality

Through

THE LAND SURVEYOR,

Karachi Municipality.



BUILDING SURVEYOR'S REPORT.

Applicant's name Sir Haji Abdoolah Sabir
 Whether he is the owner of the plot on which it is proposed to build yes on behalf of
 Plot under whose control Mahamaden Community
 Whether it is permanent or temporary Permanent
 The work proposed to build rooms.

Building Surveyor's Report Sir with reference to this I beg
to report that this Section showing the foundation
of some 7 rooms with 1st floor is not given.
2/ Room adjacent urinals is an insanitary

Date 18/12 1918.
Yours obediently
M. Hassan
 Building Surveyor.

Submitted through the Land Surveyor.

LAND SURVEYOR'S REPORT.

Does the plot come under Alignment no

Area of plot

Area under Alignment

Remarks Sir,

I beg to attach herewith the approved Plan &
notice served on the owner. The proposed addition
will make the plot overcrowded therefore should not
be allowed. The requirements of the notice have not yet
complied with. S.M. Hassan

Date 18/12 1918.
 Land Surveyor.

ORDER OF THE ENGINEER.

Show up on the ground.

11.20/12/18

The proposed bed will overcrowd the plot. Permission
can only be granted to build to the extent of the present
outbuildings to the north.

There is no objection to the deviation from the
original plan as now built.

11.20/12/18

A.M. INST. C.E.,
 Engineer,
 Karachi Municipality.



No. E. of 191

MUNICIPAL ENGINEER'S OFFICE,

Karachi, _____ 191

Submitted to the Managing Committee for information.

A.M.I.C.E.,

Engineer,

Karachi Municipality.

Through

THE CHIEF OFFICER & CHIEF ENGINEER,

Karachi Municipality.

RESOLUTION OF THE MANAGING COMMITTEE.

Resolution No. _____ dated _____



12

No. L.S.

2²⁶⁴

of 1918.

Municipal Office,

Karachi, 29th October 1918.

M E M O /-

With reference to his building under construction on plot No. 38.K-11 Lyari Quarter Mr. Haji Abdulah Sabu is informed it is observed that he is deviating from the approved plan as regards doors and windows and the partition walls on 1st floor. He is therefore requested to make the necessary changes on the plan at Undersigned's office.

M. I. M. E.,

E n g i n e e r

Karachi Municipality.

802



Karachi
Municipal Office 2/10/18

13

Memo.

With reference to his building
under construction on plot No 38 on Lyari
Rd. Haji Abdul Sabu is informed ~~that~~^{from the approved plan}
it is observed ^{that} he is deviating ^{as} regard
doors & windows & the partition walls on
1st floor. He is therefore requested to
make the necessary changes on the plan
at ~~with~~ the undersigned's Office

M. I. M. E.

M. I. M. E.

Engrs R. Municipal



(200-7.12.17.)

Form No. 6.

No. E. 93 191

128

MUNICIPAL ENGINEER'S OFFICE,

Karachi, 1st Aug. 1918.

MEMO.

Building Inspector _____ is informed

that Mr. Kap. Abdulah Saloo has been permittedto build room his houseon plot No. 38 K, Street, Lean

Quarter. Report should be made to the undersigned when the house is

completed.

L. A. H. Kerley

A.M. INST. C.E.,

Engineer,

Karachi Municipality.

152

Haji Abdulas Saboo

PLAN SHOWING PROPOSED ROOMS

ON PLOT NO. 38 SHEET NO. 11

LYAREE QUARTERLY


SCALE 1" = 10'

1" = 8' 11"



128

B.A.L.C.E.


ARCHITECT & SURVEYOR
BUNDER ROAD KARACHI

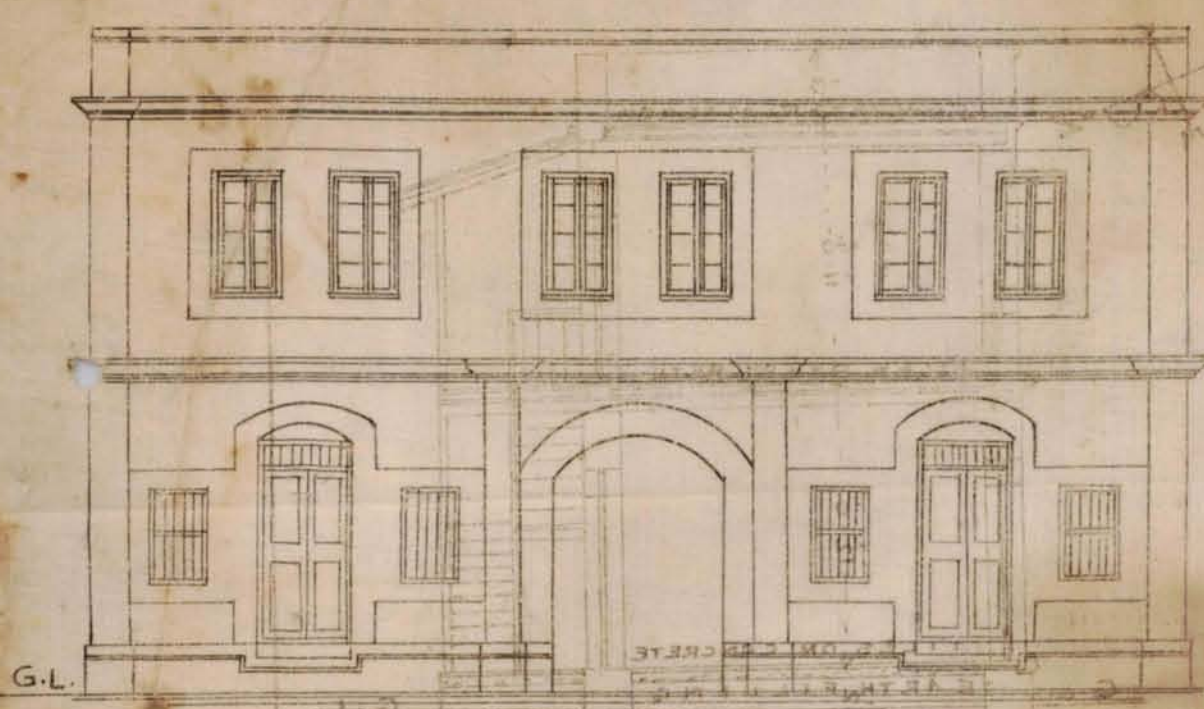

ELEVATION OF EAST

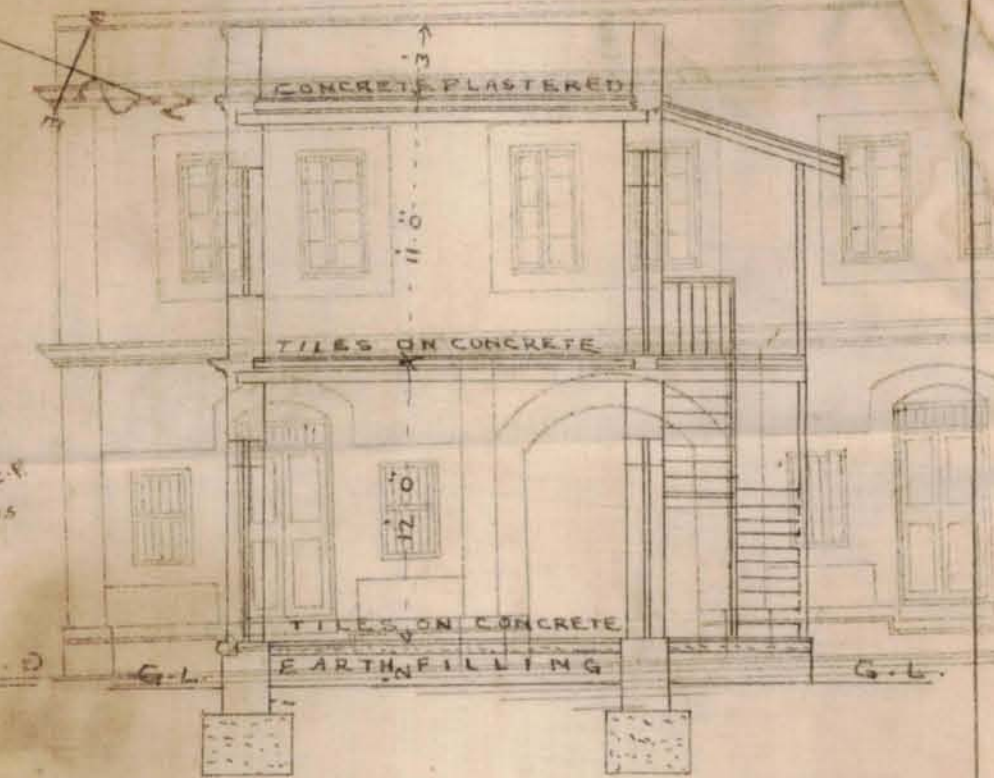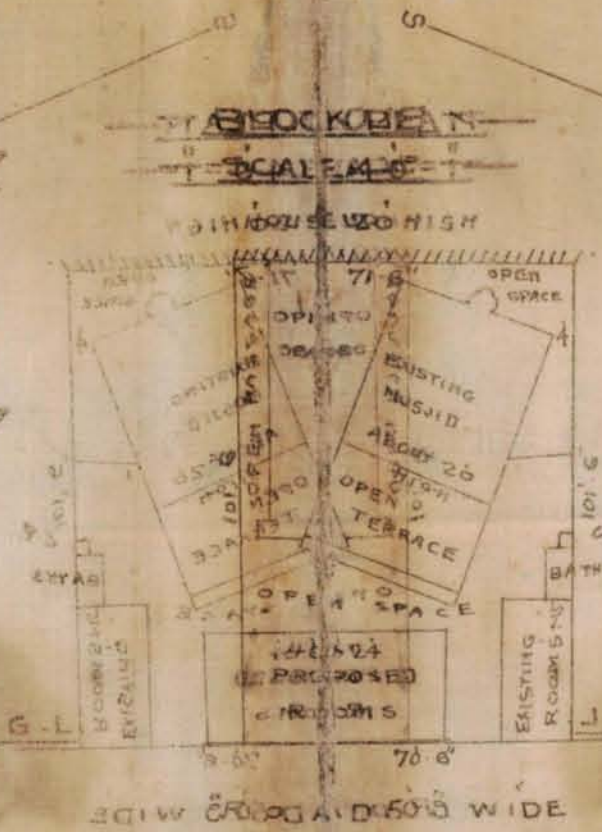



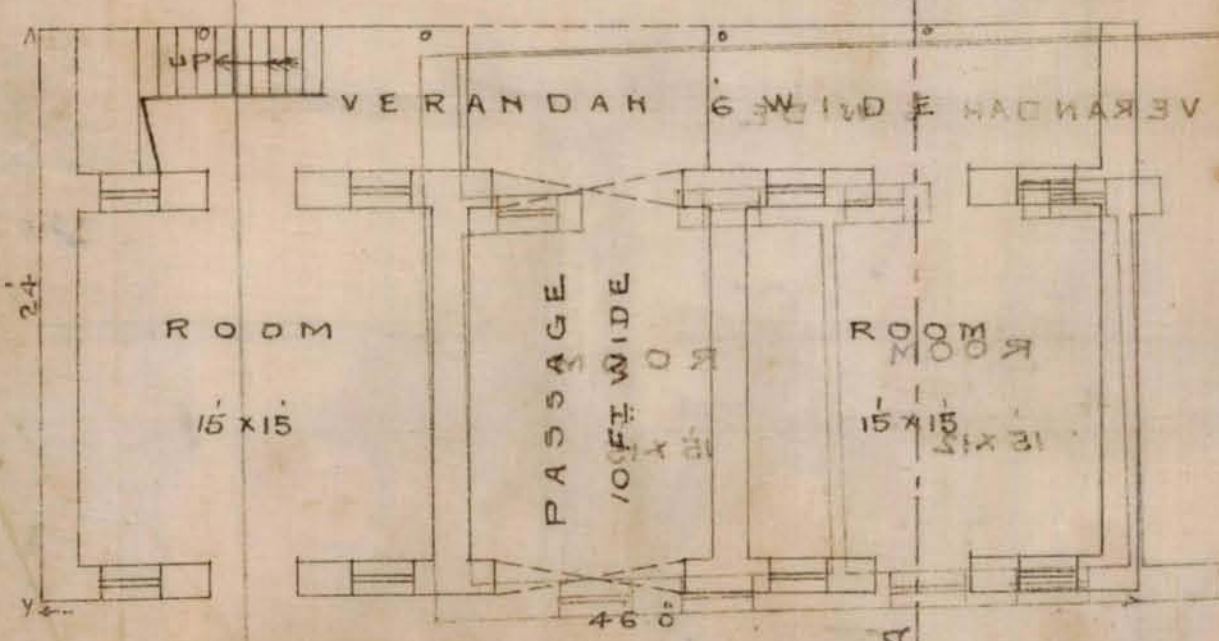

PLAN OF GROUND FLOOR

ROAD 50'-0" WIDE

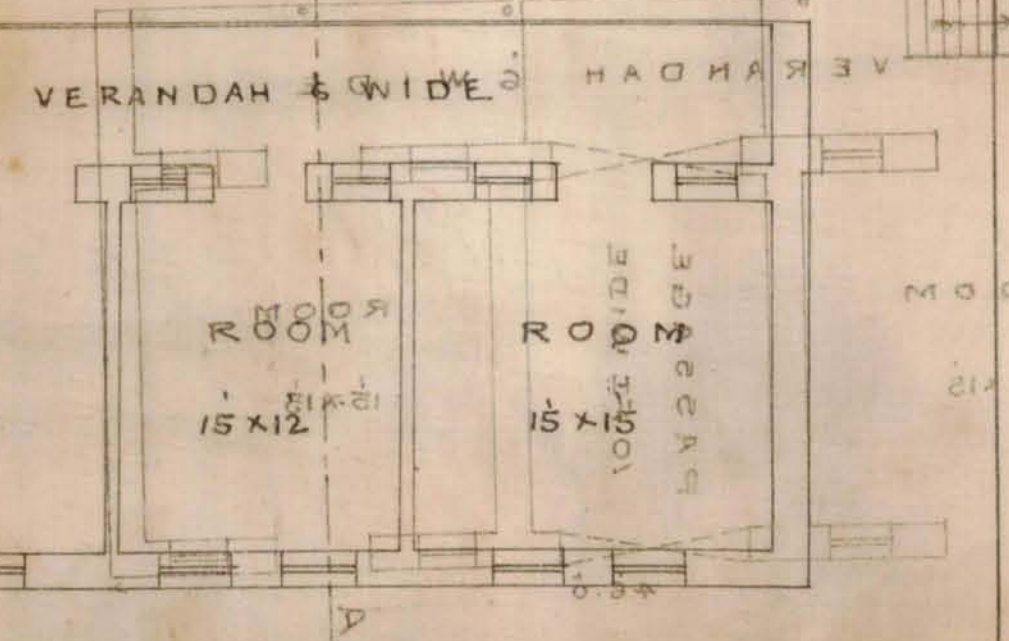

PLAN OF FIRST FLOOR

ROAD 50'-0" WIDE