

04



Heritage

1-1

KMR.CDD.OIQ.1903.04

1903

2316

3A4 OT



at _____ % above/below the schedule of rates has been accepted by the Chairman/Vice-Chairman. You are requested to please pay a sum of Rs. _____ being contract deposit.

The cost of stamps to be affixed on the agreement to be executed amounting to Rs. _____ will have to be borne by you.

Please comply with the above said requirements within a week from the receipt hereof failing which, the acceptance will be treated as time-barred and the amount of the tender deposited will be forfeited without any further notice.

Please note that in case the contract deposit is to be paid in Government paper or Public securities, extra stamps duty of Rs. 2/- will have to be paid by you

Yours faithfully,

Vice-Chairman/Dy. Chief Officer

Printed at K. M. C., Printing Press



no 174

21²

Permission granted to Mr.
Johannarumal Gadhama
for plate no 3. See enclosure.



Form No. 3.

No. L 7305 of 190 3

MUNICIPAL OFFICE,

Karachi, 11. Aug. 190 3

MEMO.

With reference to his application dated 30. July 190 3Mr Shaw arunal Padbonal is informed thatthe plan submitted for Building his house on plotNo. 3, Ar, wawaruna Street, elo Lora, Quarter is approved,

and permission to build in accordance therewith granted.

J. Forest BruntowM. S.M. I. C. E.,
Chief Officer,
Karachi Municipality.

NOTE—This pass does not give permission to occupy Municipal land with building materials. This can only be allowed when the street is wide enough to permit building materials being deposited on it without it being a source of danger to the public, and only then on a hoarding being placed round the land to be occupied, and on payment in advance of fees for occupation of Municipal land, at the following rates:—

		RS.	A.	P.
(1)	For the 1st three months, per square yard per diem ...	...	0	0 $\frac{1}{2}$
(2)	For the next three months " " " ...	...	0	0 1
(3)	For any subsequent time " " " ...	...	0	0 2

No. 73 08 of 190 3

Form No. 6.

MUNICIPAL OFFICE,

Karachi, 10th Aug. 190 320
11th

Memo.

Inspector of old town Quarter is informedthat Mr. Jhawarwal Padkornal has been permittedto build his houseon plot No. 3-A, Alawarwal Street, old town

Quarter. Report should be made to the undersigned when the house is completed.

J. Forest. Pruntou

M. I. C. E.,

Chief Officer,

Karachi Municipality.

M. J.

Through

The Health Officer.

204

5-1



The chief officer and Magistrate
Karachi Municipality

Sir/

With reference to the attached
application dated 30th ultimus together
with the plan of a house to be built
on plot no 3 A4 old town quarter
they to report that no portion of the
plot in question is to be acquired.

A report of the Health Officer may
kindly be asked.


P 1536
5/8/03

Yours obedtly

3/8/03 Nathaniel

The H.O. for favour
of what -

M. J. C. E.

Chief Officer, Karachi Municipality

4 8
1903

5-2
Sup. of the S.

Star G.H.O.

my

5/8

Sir

Complied with

pursued

Wm. W.

6/8/03

Inspector

No objection

my

6/8



T. Surveyor

Plan approved
grant permission

7/8/03

Y/B



Form No. I.

Karachi, 30th July 1903

Notice under Section 96 of the Municipality Act III of 1901.

To

THE CHIEF OFFICER AND ACTING ENGINEER,

KARACHI MUNICIPALITY.

Sir,

I beg to inform you that I intend building

Houseon plot No. 3, Survey Sheet No. A.4, situate in WazirabadStreet Old Town, Quater.

As required by the Rules of the Municipality I beg to submit herewith
a Plan of the same for your approval.

I beg to remain,

Sir,


Your most obedient Servant,

Jahangir B.



The above application is forwarded to the Municipal Town Surveyor for

full report regarding the particulars noted below.

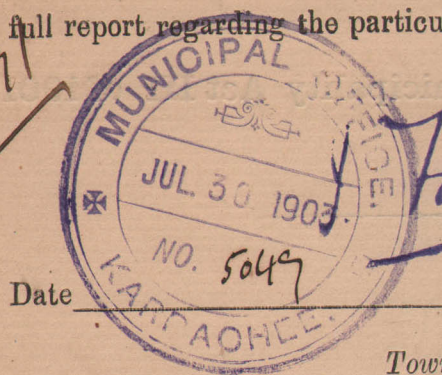

M. I. C. E.,
Chief Officer and Acting Engineer,
Karachi Municipality.

Date

Town Surveyor's Report.

Particulars.	Remarks.
Whether the applicant is the owner of the plot on which it is proposed to build.	The applicant is the owner of the plot.
State privy accommodation and arrangement for removal of waste water.	Privy accommodation is proper and connected with the Municipal drain.
Is ventilation sufficient.	Yes
Is light ditto.	Yes
It should be stated exactly the distance the proposed building is to be from an adjoining building.	The plot is open on one side and the adjoining buildings are adjoining plot.
Other remarks.	Yours obediently 10-8 10-3 Mohammed

Submitted to the Municipal Chief Officer and Acting Engineer with compliments.

Nathan
Town Surveyor,
Karachi Municipality.



MEMO.

Plan of proposed building on plot No. 3, Survey Sheet No. 14,and Town Quarter, is submitted to the Managing Committee

for approval.

The Chief Officer and Acting Engineer being of opinion that the plan is


SatisfactoryDate 10. August 03

M. I. C. E.,

Chief Officer and Acting Engineer,
Karachi Municipality.

Resolution of the Managing Committee.

MEMO.

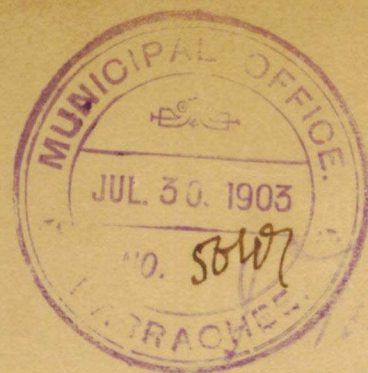

M. J. E.
Chief Officer & Agt. for
Karachi Municipality.


Plans showing the house to be rebuilt on

plot No 3 A4


OLD TOWN QUARTER

Scale 8 feet = 1 inch


3877/03

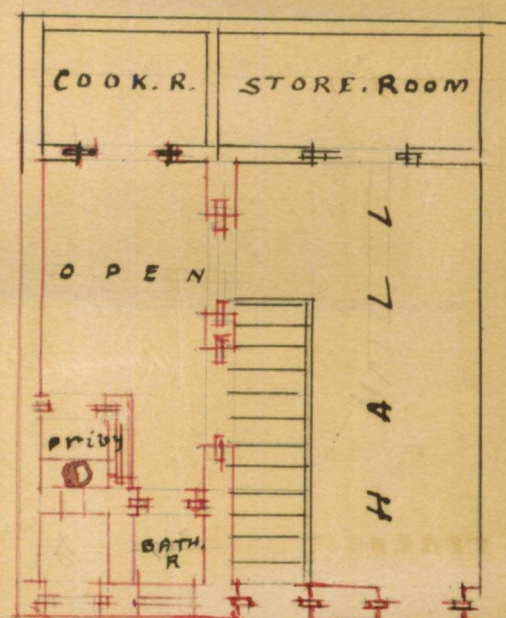


Ground plan

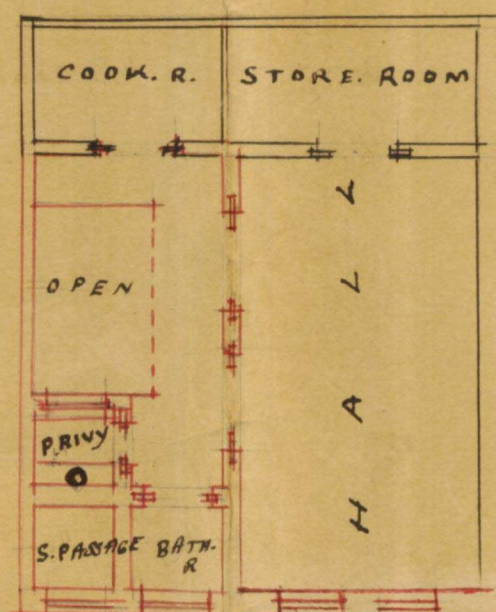

FIRST FLOOR

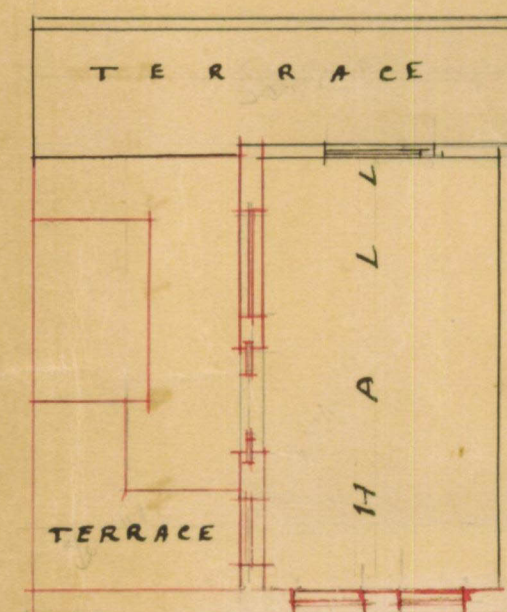

SECOND FLOOR

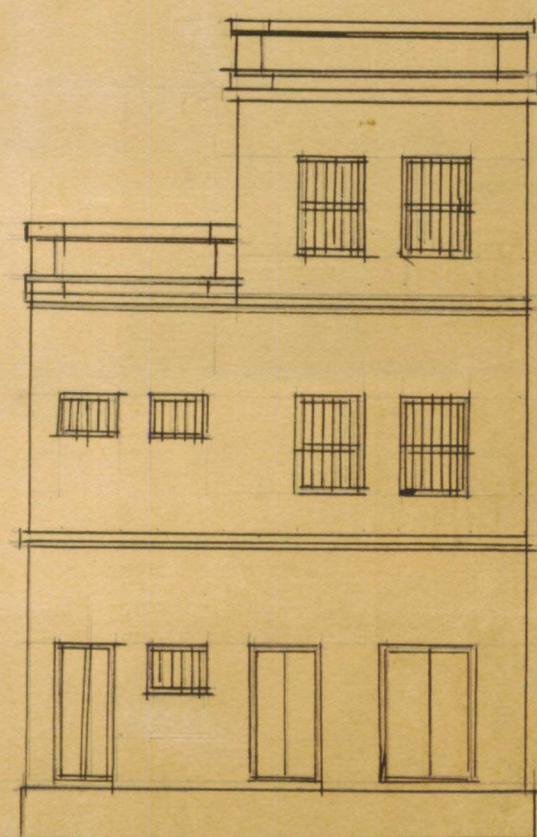


ELEVATION

Scale 10' = 1"

BLOCK PLAN
Scale 10' = 1"



WAVURIYAMAL LANE.

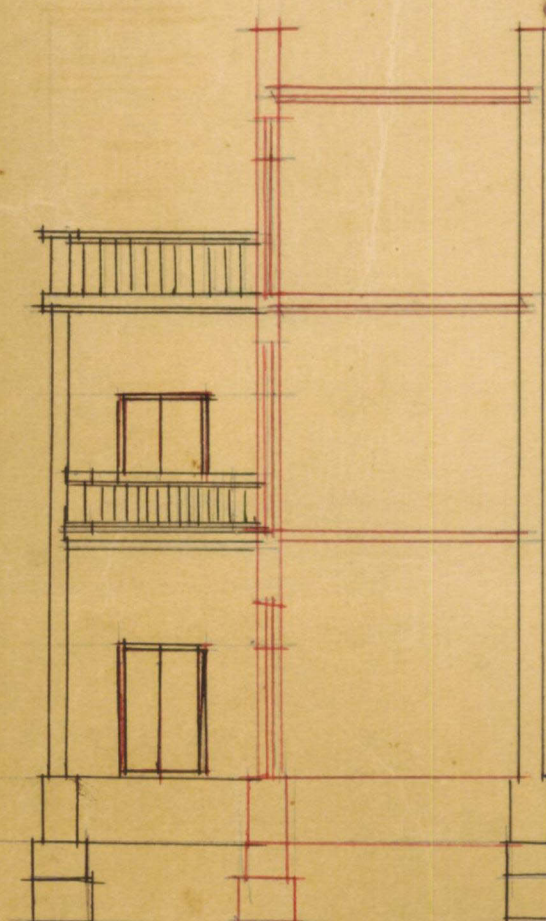

SECTION

Scale 10' = 1"



Heritage

KMR.CDD.OIQ.1903.04

200-1-9-1901.

No. 5314 of 1903

MUNICIPAL OFFICE,

Karachi, 18th June 1903

MEMO :

With reference to his application dated 9th June 1903 giving notice under Section 96 of Act 111 of 1901 of his intention to *build a room, and to make alterations* on plot No. *3-A*, *Wawarungah* Street, *also known as* Quarter Mr. *Jawarwal Lodhoomal* is requested to furnish the undersigned with a plan of intended work, showing the following information in accordance with clause 1 (b) of the said Section.

The information required is ;

- 1 Block plan giving width of roads, if any, in front, sides or rear, and stating height of surrounding houses, if such exist. Scale of not less than 20-feet to one inch.
- 2 Front elevation of proposed building.
- 3 Plan of each floor of building, showing all privies, bathing places, etc.
- 4 Sectional elevation.
- 5 Plans 2, 3 and 4 to be on a scale of not less than 8-feet to an inch.

The plan must contain full dimensions of rooms, passages, privies, bathing rooms, etc., the height of plinth above road level and the height of each story.

On the plan must also be statement of the materials proposed to be used.

Every plan submitted must bear the signature of the applicant and the date of signature.

Mr. *Jawarwal P. S.* should not proceed with the intended work until he has complied with this order and is informed that the Municipality approves of his proposals.

J. Forest. Brumton

M. I. C. E.

Chief Officer,
Karachi Municipality.*At. Sd.*

Served on _____ 190



Karachi 9

8/6/03

To

W 266

The Chief Officer
Municipality

Sir

I beg the favour of your
kindly granting me a
permission to build a
spring, repair & make some
alteration in front portion
of my house old Town Swater
Tawariond local in the map
marked Sheet A No: 4 at an
early date & oblige.

I beg to remain
SirYour most old servt.
Jhauhar Lal.

3-24



Heritage

KMR.CDD.OIQ.1903.04

10

Ch. Eng./A-3/62-63-3,000 (Accept. Letter form)

OFFICE OF THE CHIEF ENGINEER, K.M.C.

_____ Section
No. CE/ _____
Dated _____

To,

Messrs _____

_____ KARACHI _____

Subject:— _____

Dear Sir,

Yours

Signature