

06



Heritage

KMR.CDD.OIQ.1903.06

1-1

1903

2300

3A7 0.T



.....2.....

Item No. 12

Particulars.	Rate.	per.
1) Excavation of foundation.	3/-/-	%
2) C.C. 1; 3; 8: in foundation,	95/8/-	"
3) C.C. 1; 3; 6: cost in situ in plinth.	141/-/-	"
4) C.C. 1; 2; 4: in super.	154/-/-	"
5) C.C. Copping moulded to design and approved i/c neroo.	1/4/-	Rft
6) $\frac{1}{2}$ " Cement plaster 1:3:	19/-/-	%
7) Colour wash 3 cost i/c one coat white wash.	1/9/-	"

We/I hereby quote. above the estimated
below
rates.

TIME LIMIT:-

Signature of Tenderer.....

Full address

ADDL: CHIEF ENGINEER.
KARACHI MUNICIPAL CORPORATION.



No 158

2 5
Permission granted to Mr.
Humaran ~~Ram~~ ^{Naupha} ~~for~~
plot no 3 — A) also Lawu Guarte

No. L 6414 of 190 3

MUNICIPAL OFFICE,

Karachi, 20 July 1903

MEMO.

With reference to his application dated 7th July 1903

Mr William Haughauss is informed that

the plan submitted for Building his house on plot

No. 3. *By* *Leubaus* Street, *Adams* Quarter is approved,

and permission to build in accordance therewith granted.

cordance therewith granted.

J. Forest, Printers

M. I. C. E.,
Chief Officer,
Karachi Municipality.

NOTE—This pass does not give permission to occupy Municipal land with building materials. This can only be allowed when the street is wide enough to permit building materials being deposited on it without it being a source of danger to the public, and only then on a hoarding being placed round the land to be occupied, and on payment *in advance* of fees for occupation of Municipal land, at the following rates:—

					Rs.	A.	P.
(1)	For the 1st three months, per square yard per diem ...	...	0	0	½		
(2)	For the next three months " "	...	0	0	1		
(3)	For any subsequent time " "	...	0	0	2		

No. 6415 of 190 3

Form No. 6.

MUNICIPAL OFFICE,

Karachi, 20th July 190 3
21st July

Memo.

Inspector of old town Quarter is informed
that Mr. Ibrahim Khan has been permitted
to build his house
on plot No. 34, Embankment Street, Old Town

Quarter. Report should be made to the undersigned when the house is
completed.

J. Forest

M. I. C. E.,

Chief Officer,

Karachi Municipality.

Attest

Through

The Health Officer.



Chief Officer and an Engineer
Karachi Municipality

Sir/

With reference to the attached
application dated 7th instant together with
the plan of a house to be built on plot no
3 A 7. River Road, old Doron quarter, there
is no objection in granting permission with
the Health Officer's report.

R 1326
13-7-03

Yours obediently

10/7/03

Nathan Abraham

Mr H.O. for favor
of reporting I am, Sir,
Yours faithfully,
M. J. B. E.

Chief Officer,

Karachi Municipality

11 7/12/03

5-2
Sur. Sur 15th.

15/7

No objection on sanitary

grounds. but the

applicant intends

raising an upper

story on his existing

plinth. Improvements

might thereby be

instituted

Sur

14/7/1903



T. Suresh

As does not under
stand the Health Officer's
remarks re plinth.

A new house is shown
+ the plan being
approved the
applicant must
build accordingly

1503 h



Form No. I.

Karachi,

7th July

1903

Notice under Section 96 of the Municipality Act III of 1901.

To

THE CHIEF OFFICER AND ACTING ENGINEER,

KARACHI MUNICIPALITY.

SIR,

I beg to inform you that I intend^{Re} building

a house

on plot No. 5, Survey Sheet No. 47, situate in Rivers

Road

Street

Old Town

Quater.

As required by the Rules of the Municipality I beg to submit herewith

a Plan of the same for your approval.

I beg to remain,

Sir,


Your most obedient Servant,

Metharam Maughan



6-2

The above application is forwarded to the Municipal Town Surveyor for full report regarding the particulars noted below.

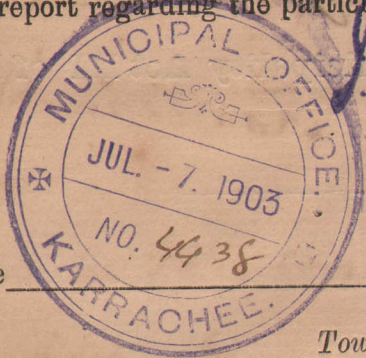

Date

Town Surveyor's Report.

Robert Primrose
M. I. C. E.,
Chief Officer and Acting Engineer,
Karachi Municipality.

Particulars.	Remarks.
Whether the applicant is the owner of the plot on which it is proposed to build.	<i>The applicant is the owner of the plot.</i>
State privy accommodation and arrangement for removal of waste water.	<i>Privy accommodation is proper and connected with municipal drain.</i>
Is ventilation sufficient.	<i>Yes</i>
Is light ditto.	<i>Yes</i>
It should be stated exactly the distance the proposed building is to be from an adjoining building.	<i>The plot is open on one side and the other three sides are adjoining plots.</i>
Other remarks.	<i>Yours obedient servant 20/7/03 H. A. Khan</i>

Submitted to the Municipal Chief Officer and Acting Engineer with compliments.

N. A. Khan
Town Surveyor,
Karachi Municipality.



MEMO.

Plan of proposed building on plot No. 3, Survey Sheet No. 47,Ad Town Quarter, is submitted to the Managing Committee

for approval.

The Chief Officer and Acting Engineer being of opinion that the plan is

SatisfactoryJ. Forest Bruntow

M. I. C. E.,

Date 20th July 1903Chief Officer and Acting Engineer,
Karachi Municipality.

Resolution of the Managing Committee.

MEMO.



7①



Plan showing the house to be rebuilt
on plot No 5 A7

OLD TOWN QUARTER


Scale 8 feet = 1 inch

L. T. M. S. S. S.


M. J. S. S. S.
Chief Officer & Agt. Engineer
Karachi Municipality

7/7/03


whenever you

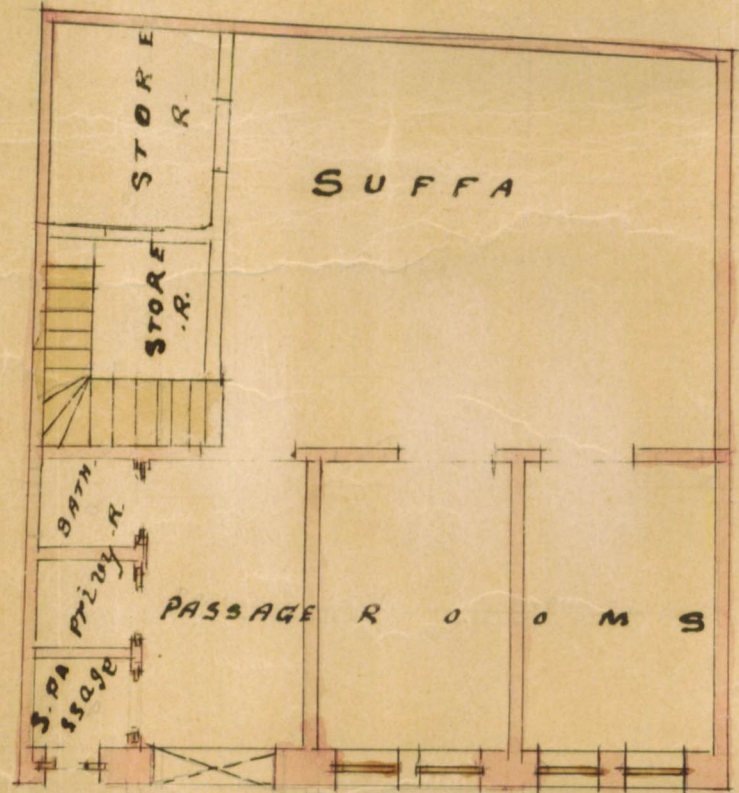


Ground plan

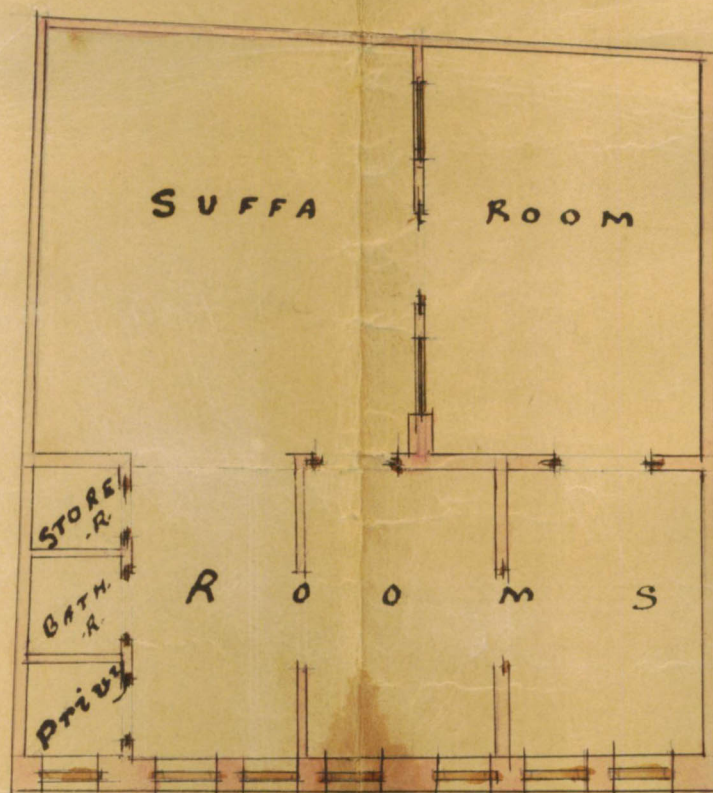

First floor

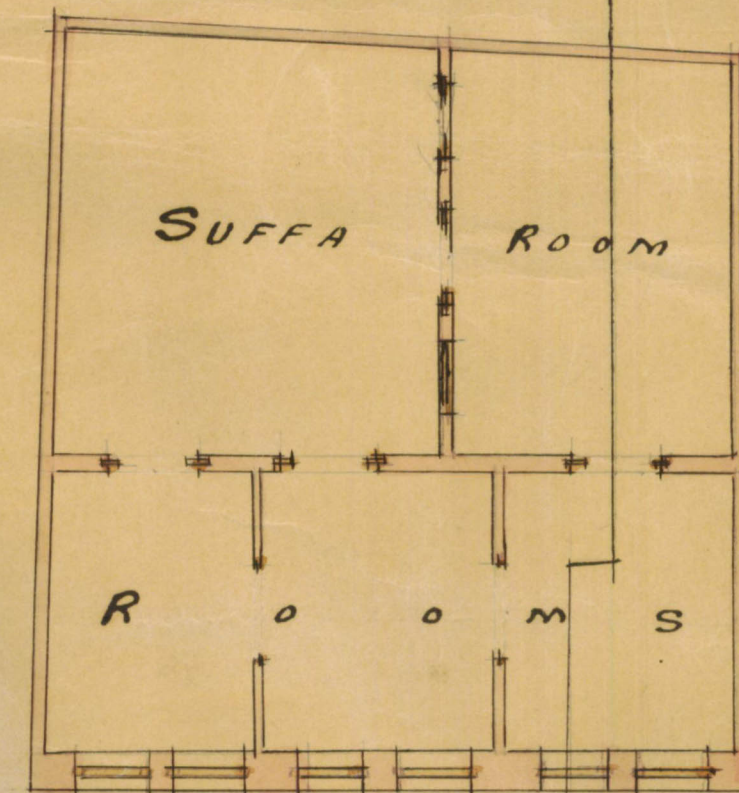

Second floor

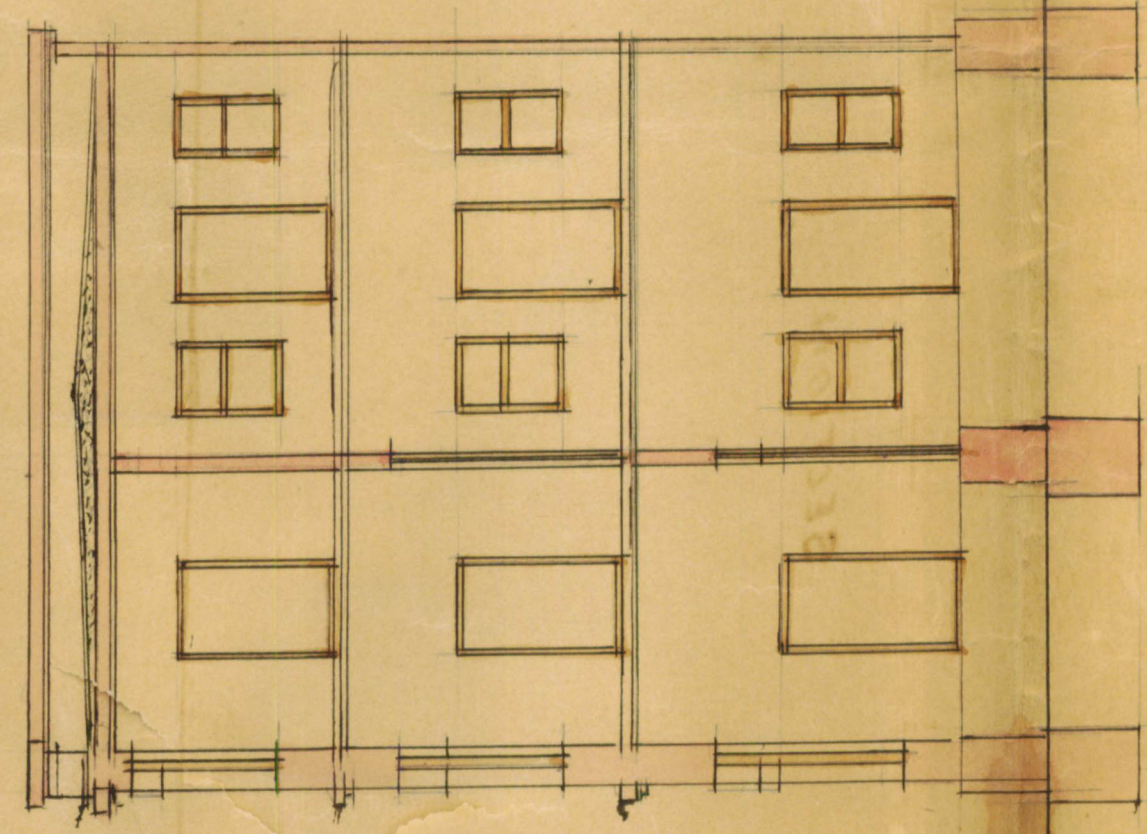

SECTION



ELEVATION

Block plan
Scale 20'-1

