




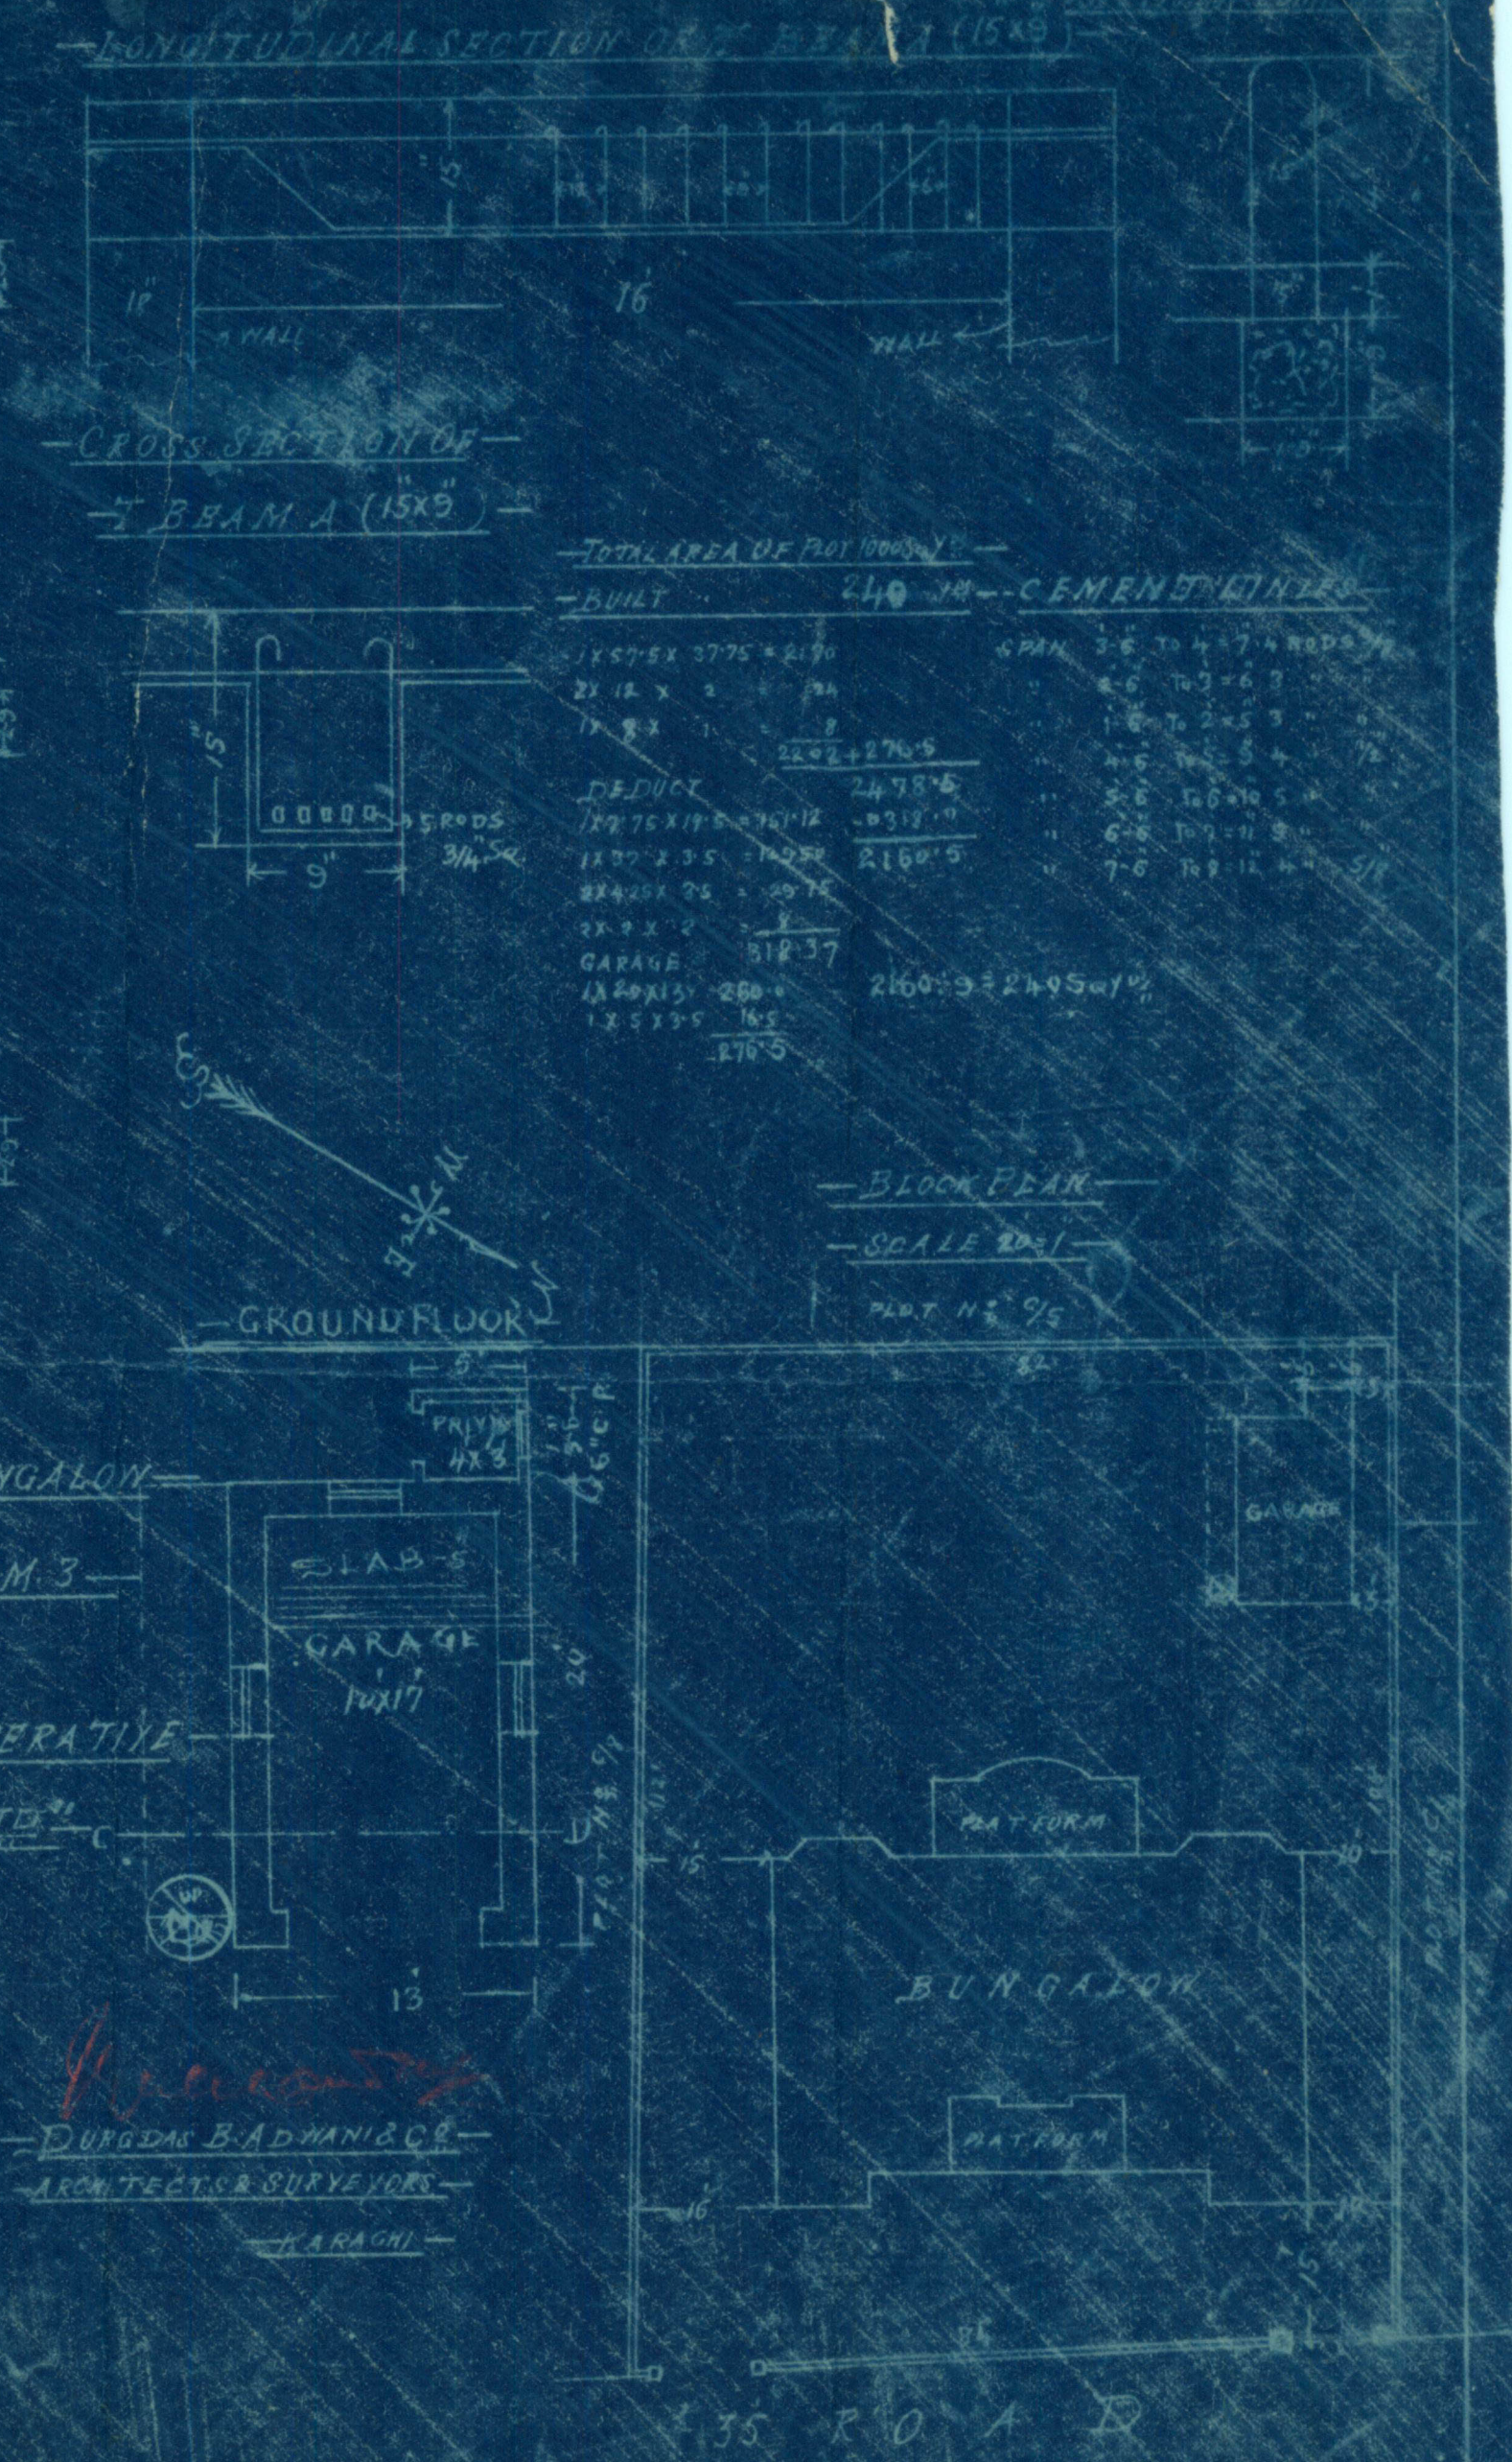

GROUND FLOOR

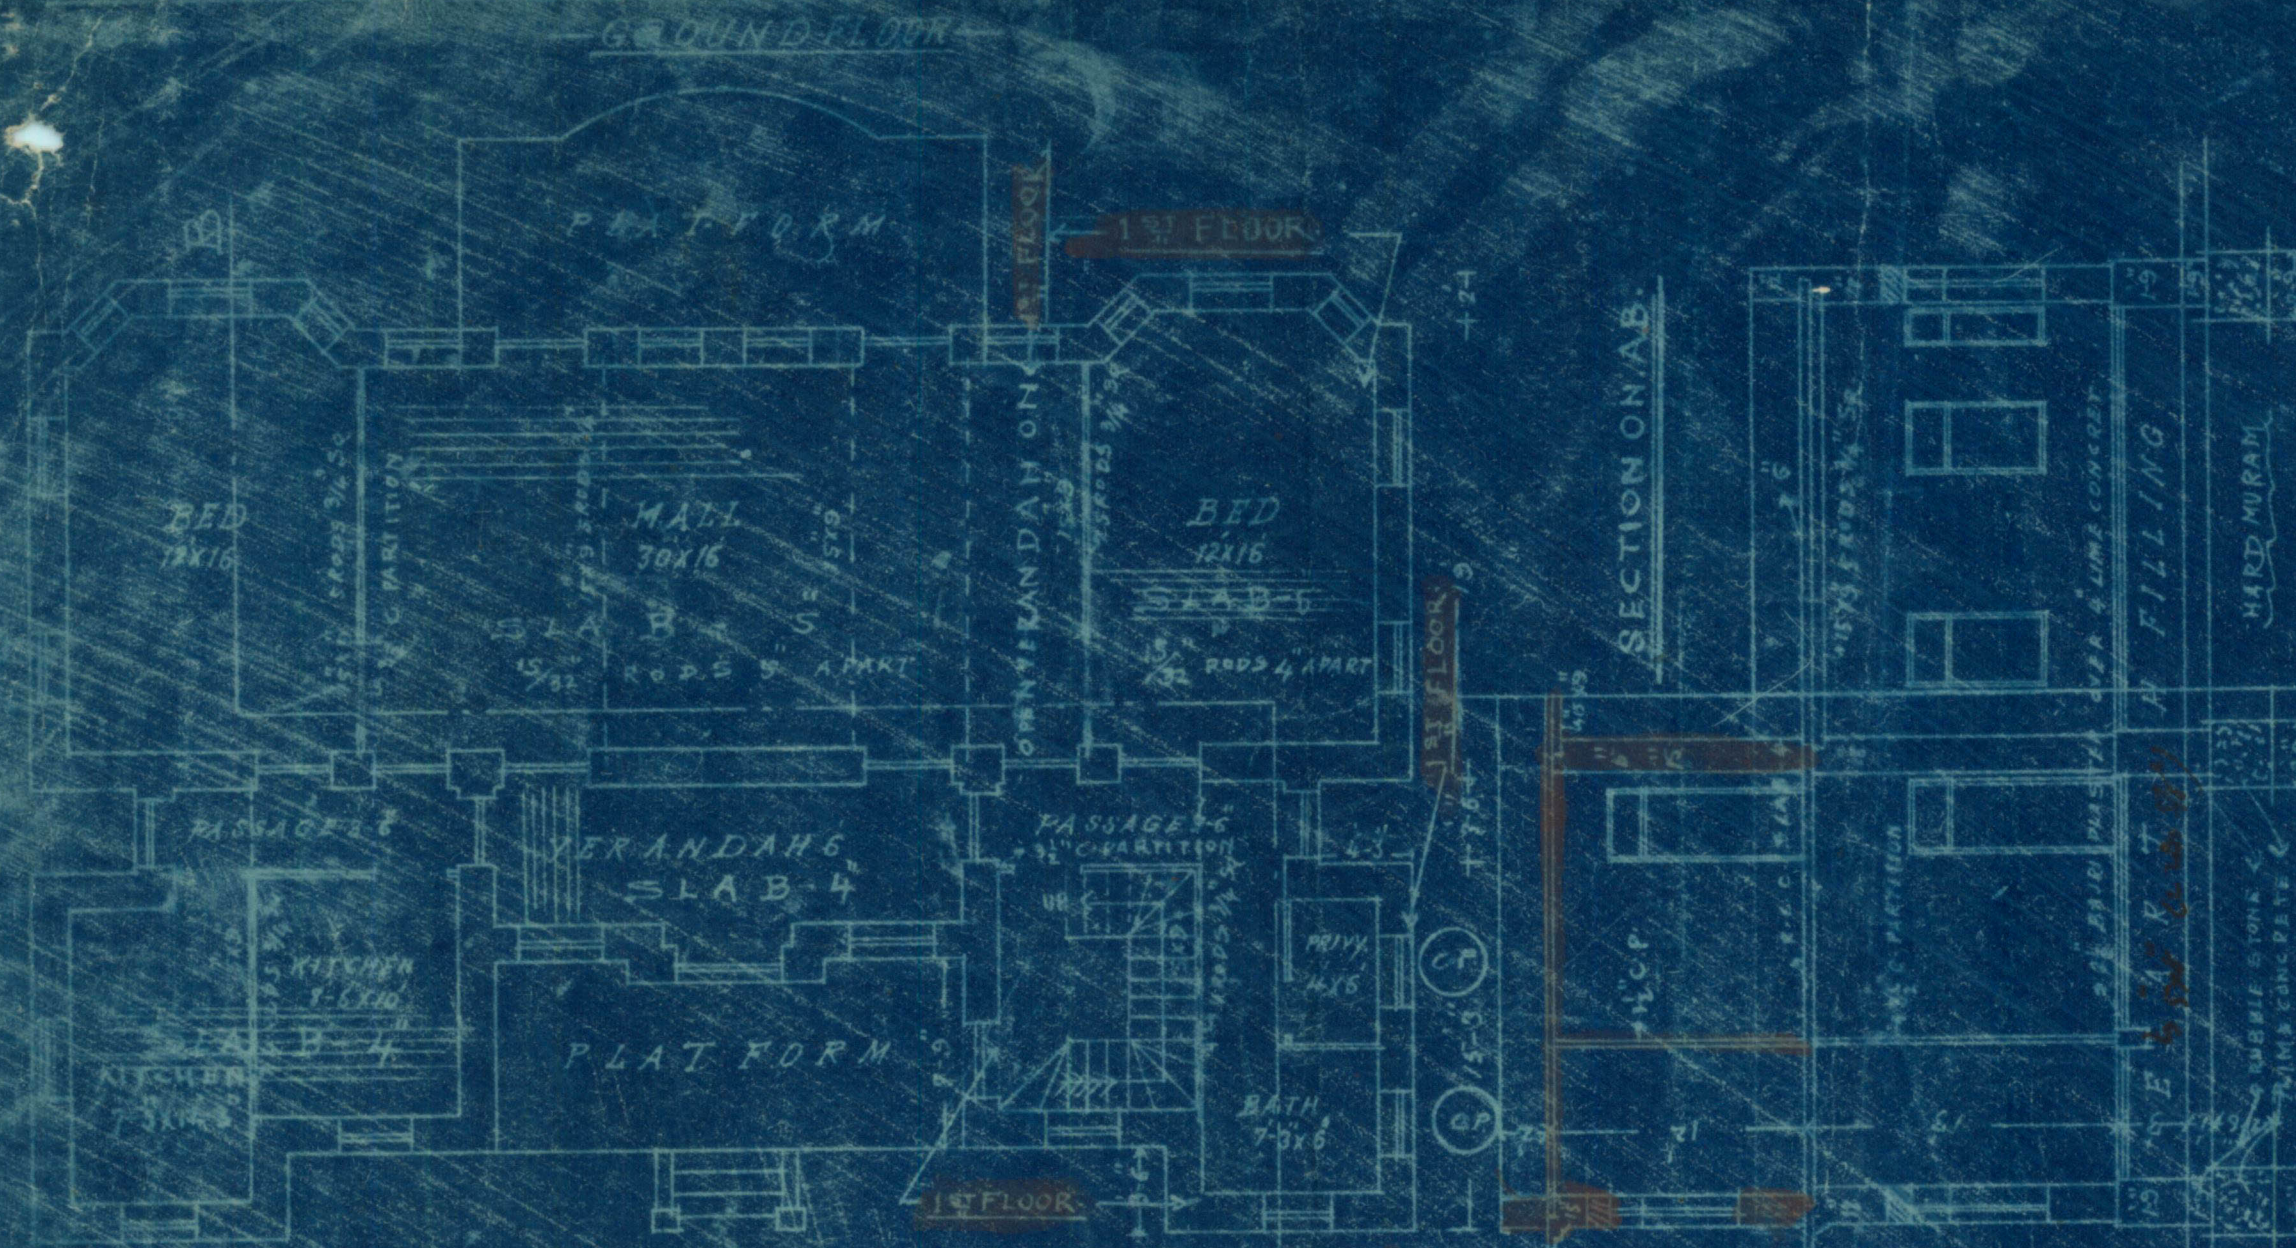


ELEVATION

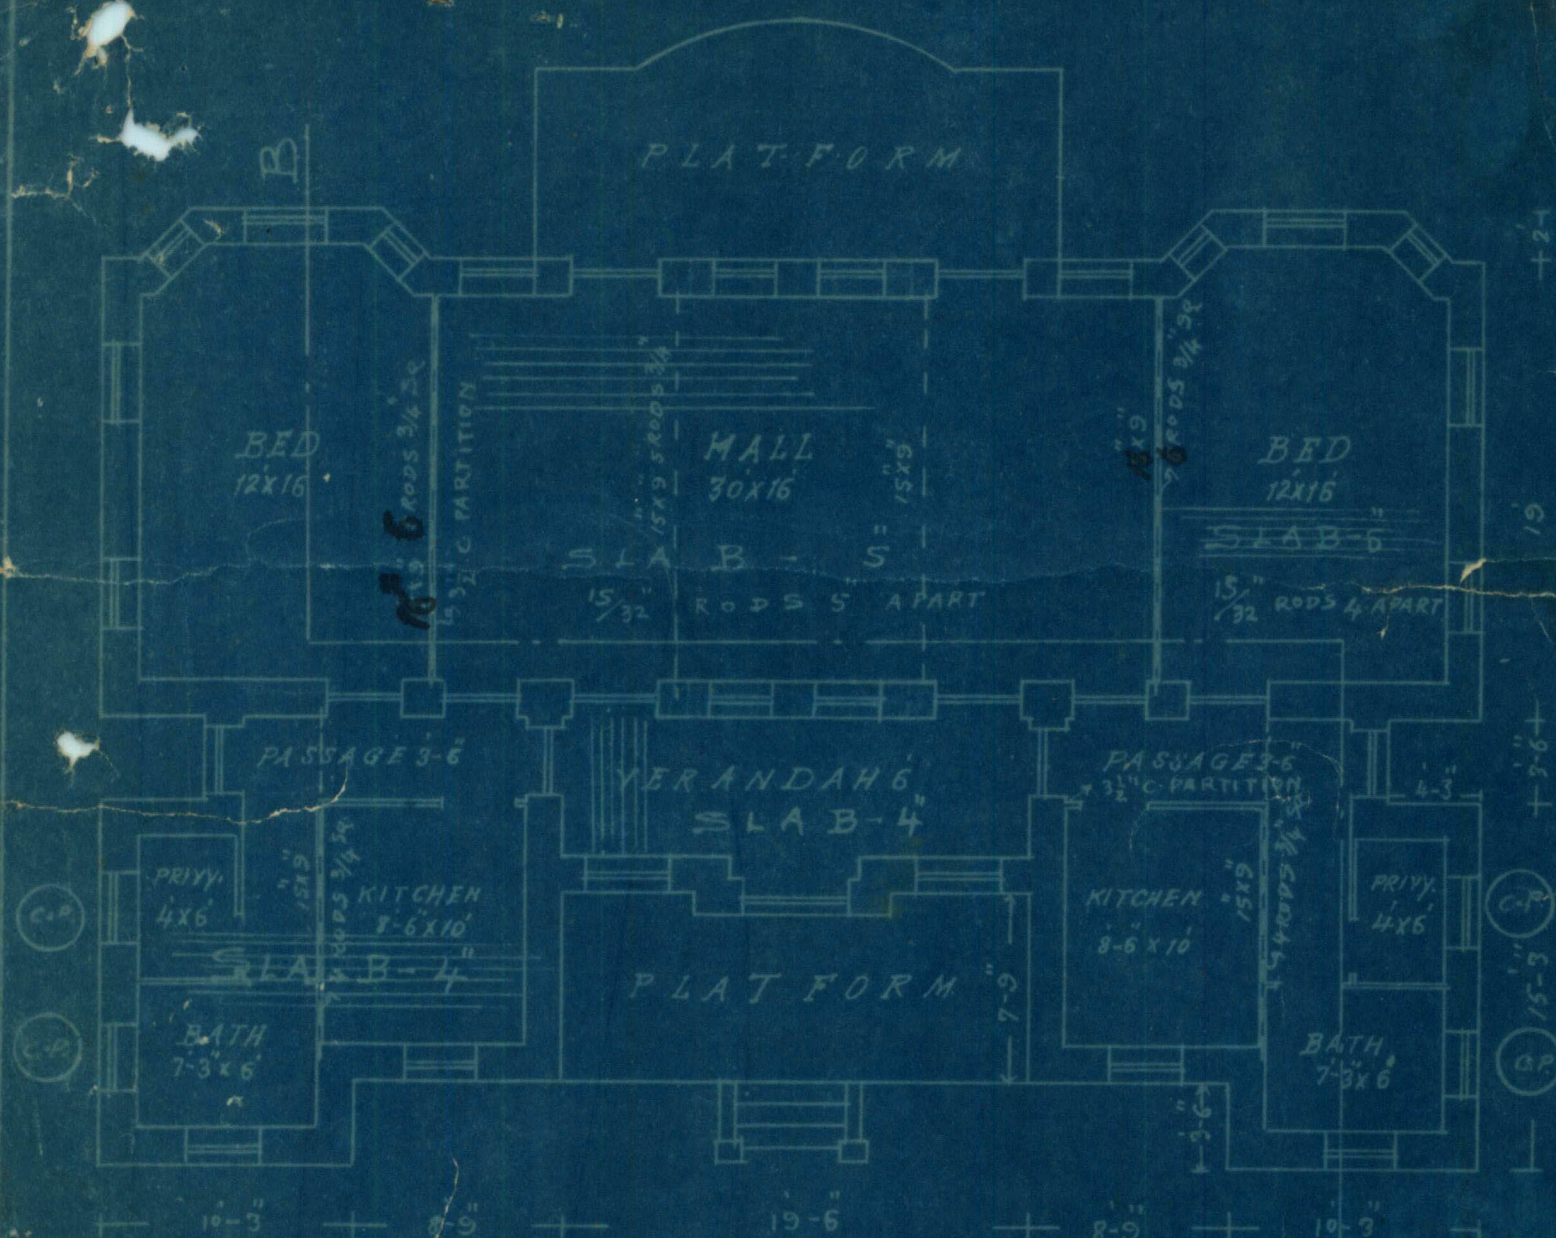

GROUND & FIRST FLOOR

SECTION ON A-B

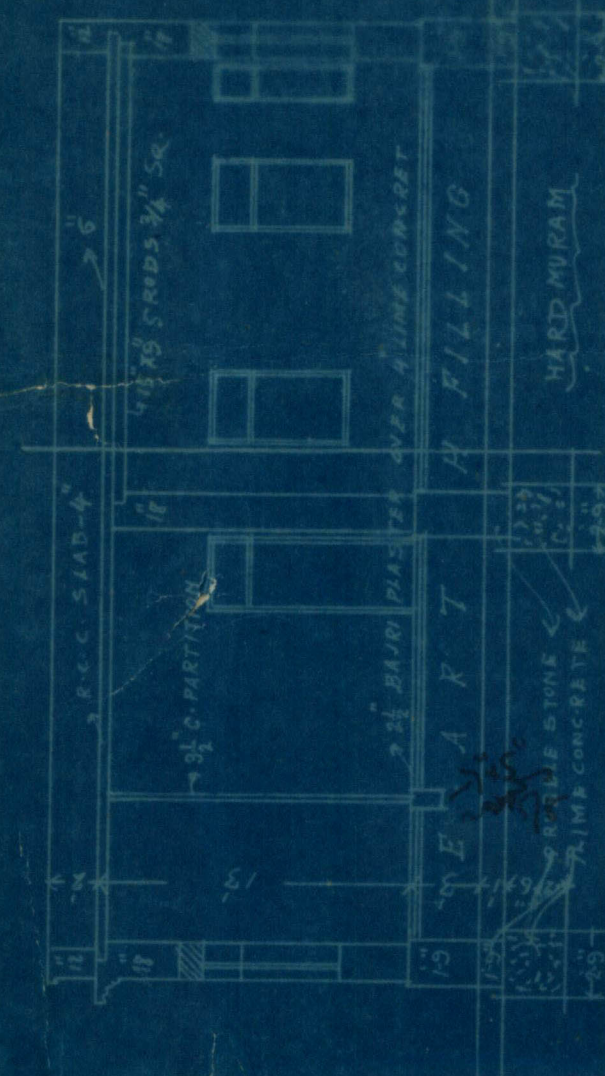

PLAN

SHOWING PROPOSED BUNGALOW

ON PLOT N^o 9/6 SHEET J.M. 3


FOR

THE COSMOPOLITAN CO-OPERATIVE


HOUSING SOCIETY LTD.

SCALE 8-1

LONGITUDINAL SECTION OF T BEAM A (15x9)

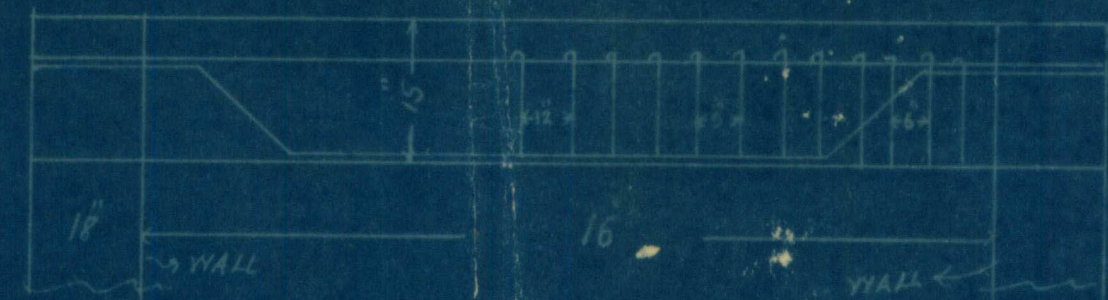

CROSS SECTION OF T BEAM A (15x9)

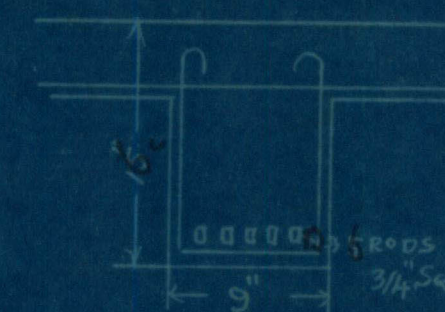

TOTAL AREA OF FOOT 1000 Sq. Yds.


BUILT 242 Sq. Yds. CEMENT LINDIES

1x 57-5x 37-75 = 2170	SPAN 3-6 TO 4-7 4 RODS 3/4"
2x 12 x 2 = 24	2-6 To 3-6 3 "
1x 7 x 1 = 7	1-5 To 2-5 3 "
22 02 = 295-5	4-6 To 5-6 4 "
DEDUCT = 2497	5-6 To 6-6 5 "
1x 7-75 x 17-5 = 137-12	6-6 To 7-7 5 "
1x 37 x 3-5 = 129-50	
2x 4-25 x 3-5 = 29-75	
2x 2 x 2 = 8	
GARAGE 318-37	
1x 15-5 x 17 = 270	
1x 5 x 3-5 = 16-5	
2555	

APPROVED

BLOCK PLAN - M. Inst. C. E.
Land 11.1.14 - 8 Architect
SCALE 20-1
PLOT N^o 9/5
GARAGE
PLOT N^o 9/6


GROUND FLOOR

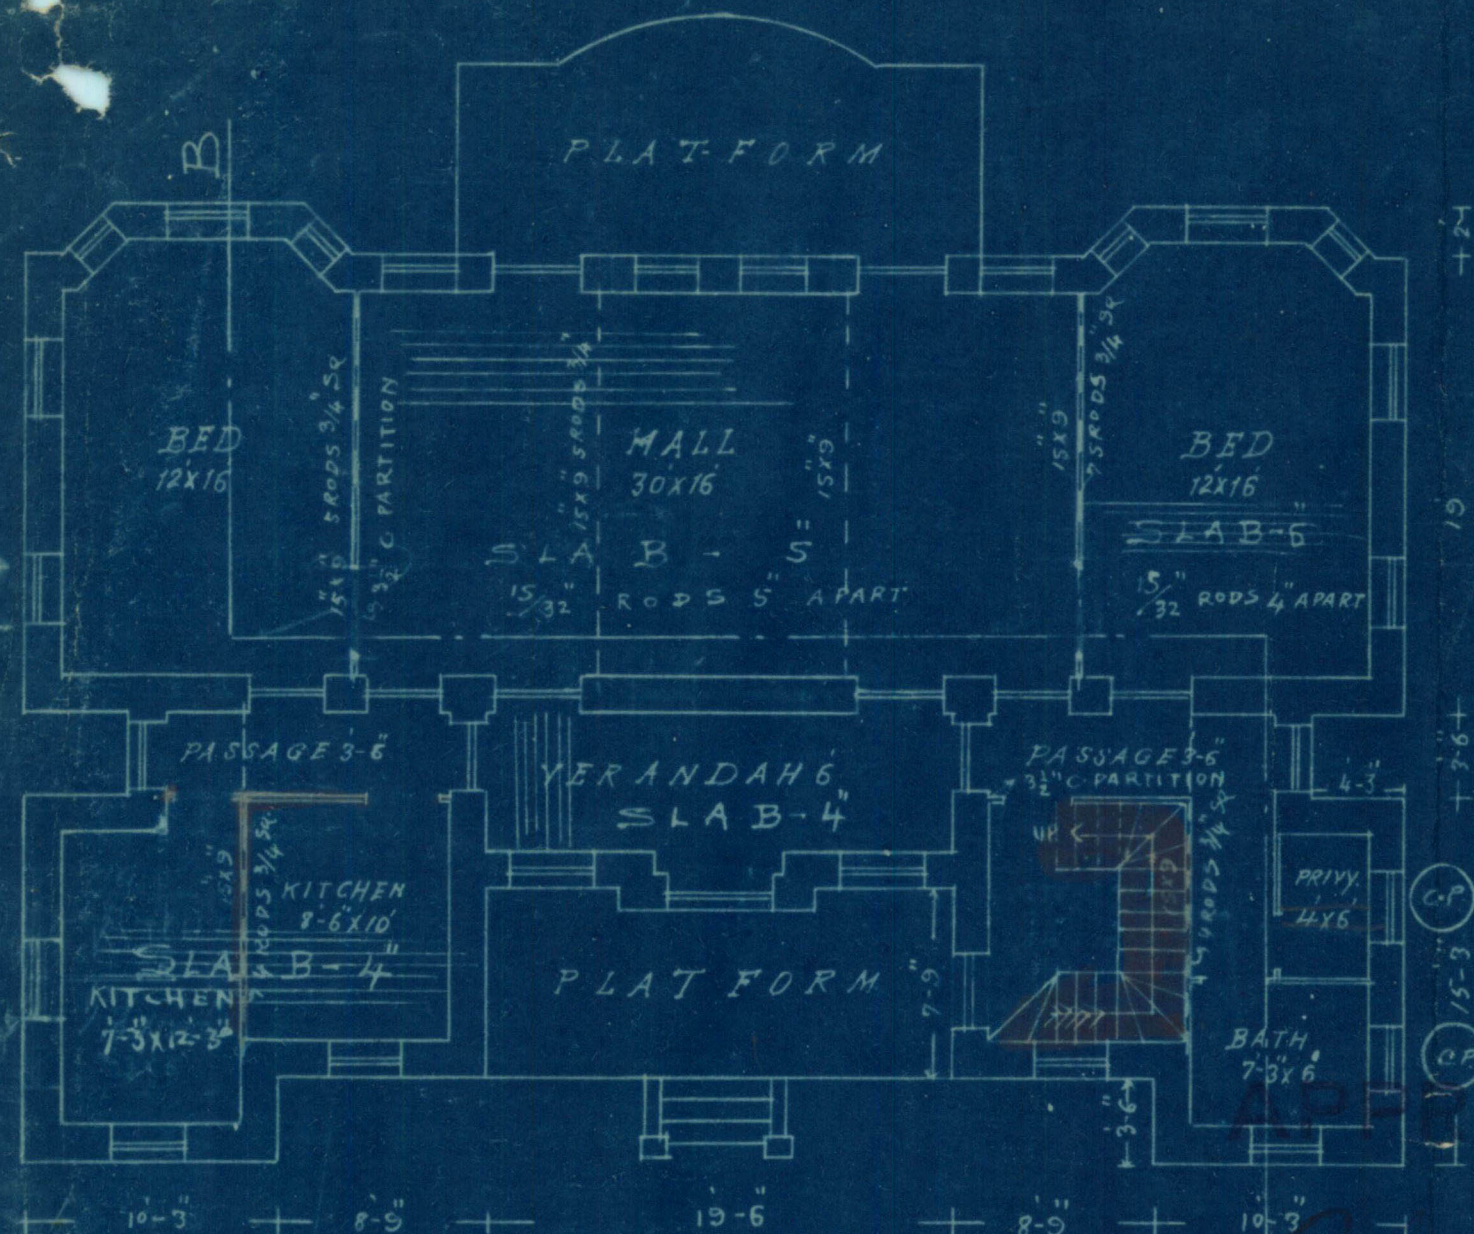


ELEVATION




FIRST FLOOR

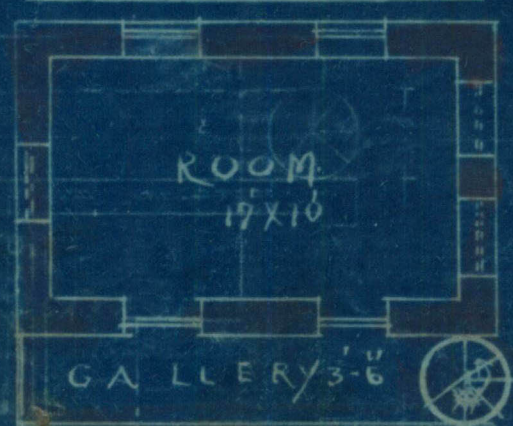

SECTION ON C.D.

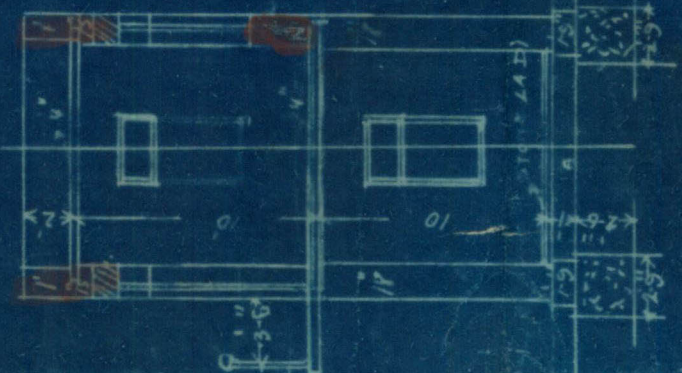

SECTION ON A.B.

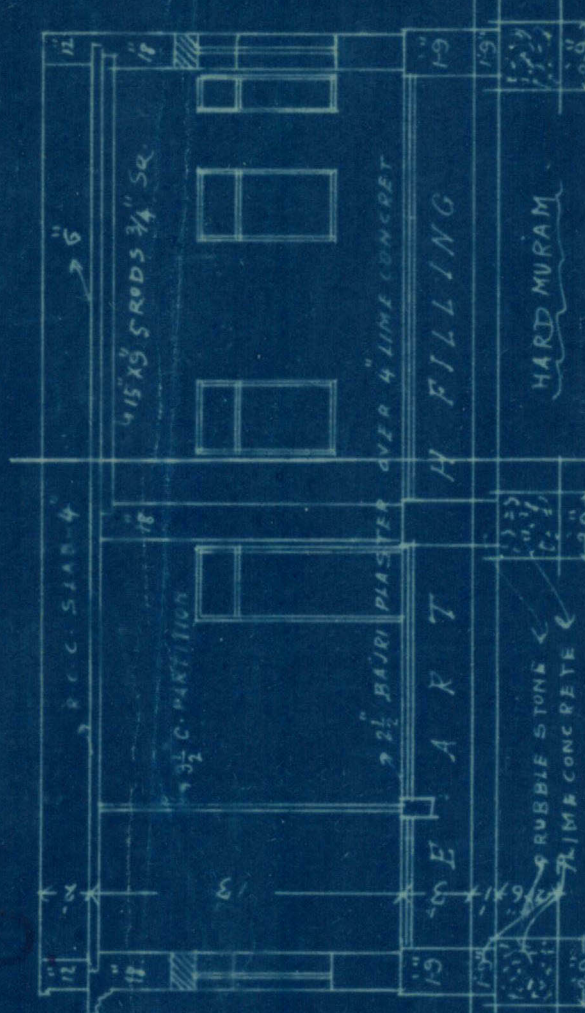


AMENDED

PLAN


SHOWING PROPOSED BUNGALOW
ON PLOT NO 96 SHEET J.M. 3
FOR
"THE COSMOPOLITAN CO-OPERATIVE
HOUSING SOCIETY LTD."

SCALE 8-1

LONGITUDINAL SECTION OF T BEAM A (15x9)

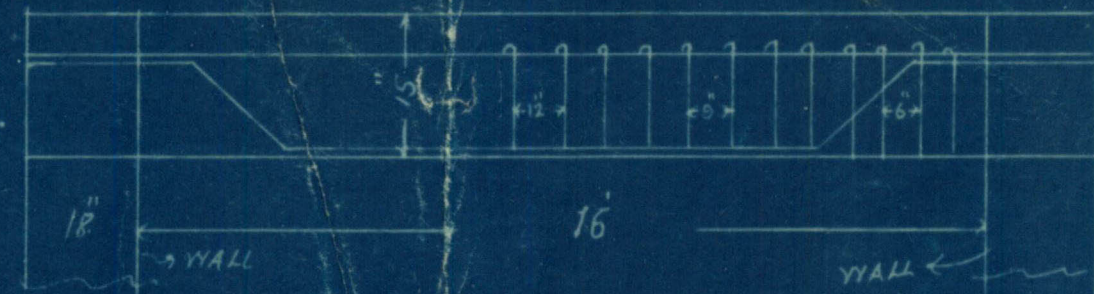

CROSS SECTION OF T BEAM A (15x9)

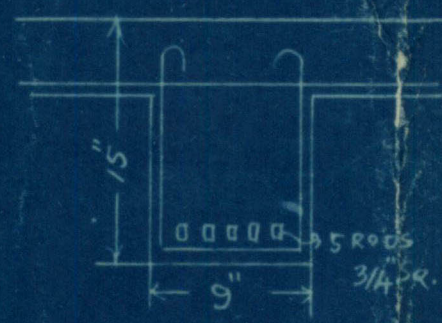

TOTAL AREA OF PLOT 1000 Sq. Yds.


BUILT 240 18

CEMENT LINES

1x57.5x37.75 = 2170	SPAN 3-6 To 4 = 7 4 RODS 3/4"
2x12 x 2 = 24	" 2-6 To 3 = 6 3 "
1x8 x 1 = 8	" 1-6 To 2 = 5 3 "
2202 + 276.5 = 2478.5	" 4-6 To 5 = 5 4 " 1/2
DEDUCT 2478.5	" 5-6 To 6 = 10 5 "
1x7.75x19.5 = 151.12	" 6-6 To 7 = 11 5 "
1x39 x 3.5 = 136.5	" 7-6 To 8 = 12 4 " 5/8
2x4.25x3.5 = 29.75	
2x2 x 2 = 8	
GARAGE 318.37	
1x20x13 = 260.0	2160.5 = 2405 sq. yds.
1x5 x 3.5 = 16.5	
276.5	

BLOCK PLAN
SCALE 20-1

GROUND FLOOR

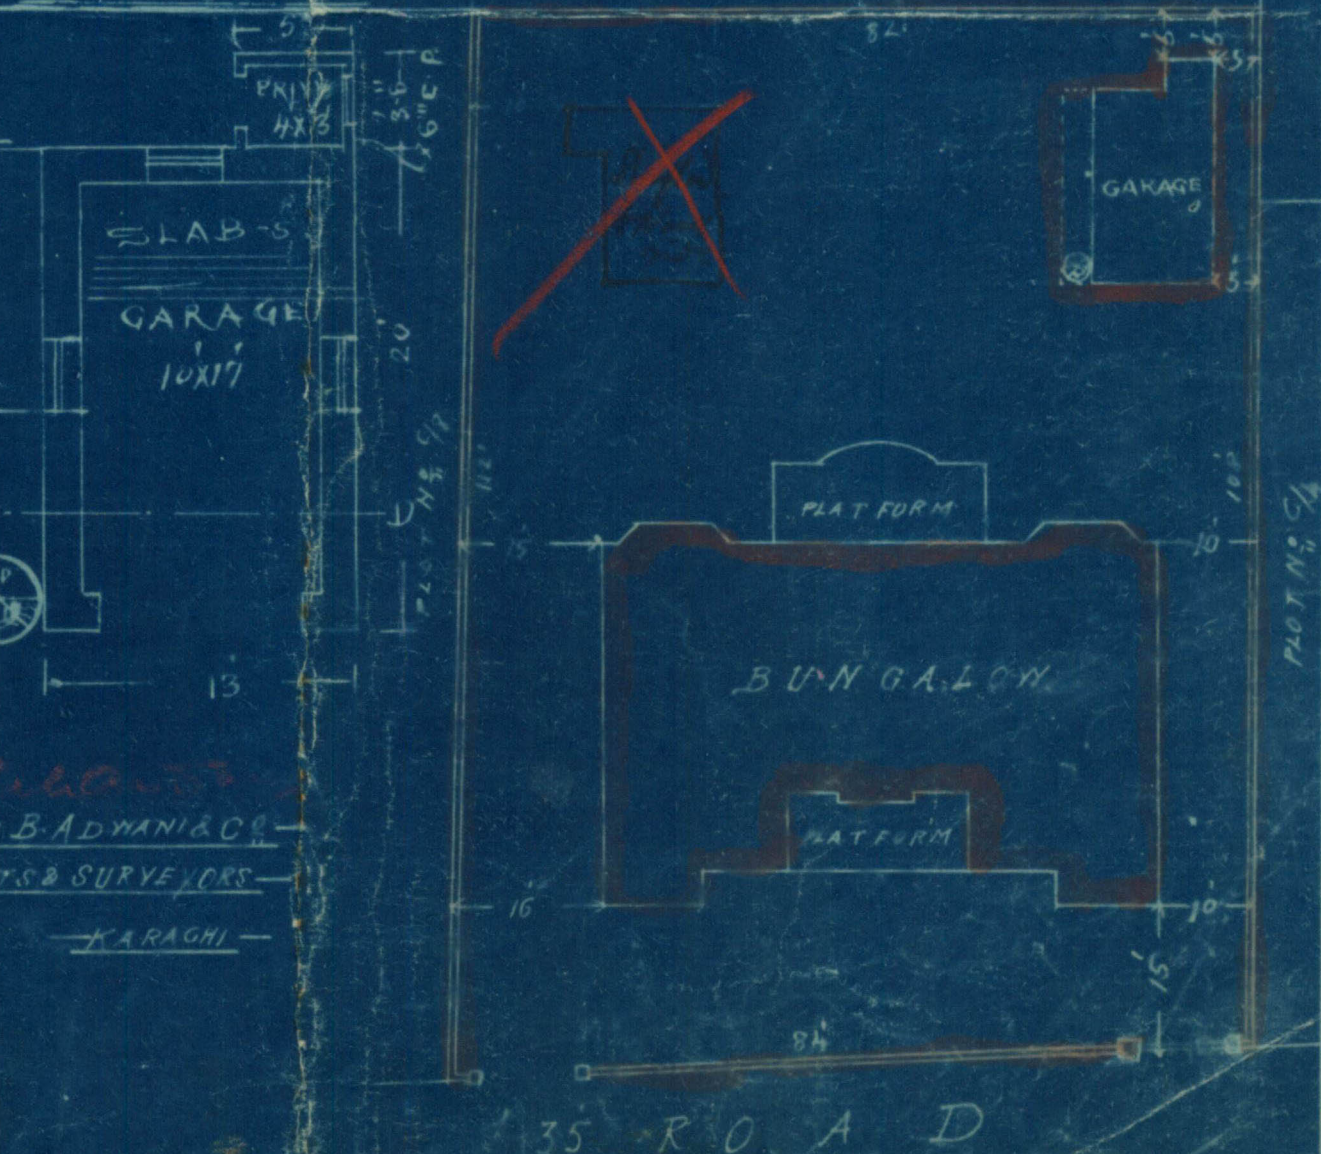

DURGAS B. ADYANI & CO.
ARCHITECTS & SURVEYORS
KARACHI

Umar Karaham

KARACHI MUNICIPALITY.

N. J. MODI.

B. Sc., (Engineering London.)

A. M. INST., C. E., L. C. E.

A. M. I. S. E., M. R. Soc. I.

Land Manager & Architect.

REFERENCE No. L.M.A./B.S.C.B. 232 of 193

LAND MANAGER & ARCHITECT'S OFFICE,

KARACHI, 2/9/1930

From,

THE LAND MANAGER & ARCHITECT,
KARACHI MUNICIPALITY.

To,

Messrs. D.B. Adrain & Co:
Architect - KARACHI.

Sir,

With reference to your application dated.....
with amended plans for the building on plot No. 46. Sheet. *for Jamshed*
Quarter, I have the honour to return herewith a copy of the plan duly signed
and approved.

I have the honour to be

Sir,

Your most obedient servant.

[Signature]
d B. Sc., A. M. INST., C. E.,
Land Manager and Architect.

No. W.GA/31 of 1930.

SUPERINTENDENT OF MACHINERY'S OFFICE,

Karachi 27th March 1930.

M e m o :-

Re. Drainage on plot Nos. E/4, E/9, G/2 & C/6,
J.M.3.

In returning the attached completion forms
Undersigned has the honour to inform the Land Manager
& Architect that plumbing work has not been carried
out satisfactorily.

sd/ E. A. Hilton,

Superintendent of Machinery,
Karachi Municipality.

No. 138. C.E. — of 1930.

Municipal Office,

Karachi, 7th April 1930.

Copy forwarded to Mr. N. M. Gidwani for
information and doing the needful.

SNT 4.4

MP
B.Sc., A.M. Inst. C.E., 5th W
LAND MANAGER & ARCHITECT.


1) ask the S.M. if the plumbing work has been
subsequently carried out to his satisfaction.
2) send reminder to the architect.

MP
28/4/30


GROUND FLOOR



LONGITUDINAL SECTION OF T BEAM A (15x9)

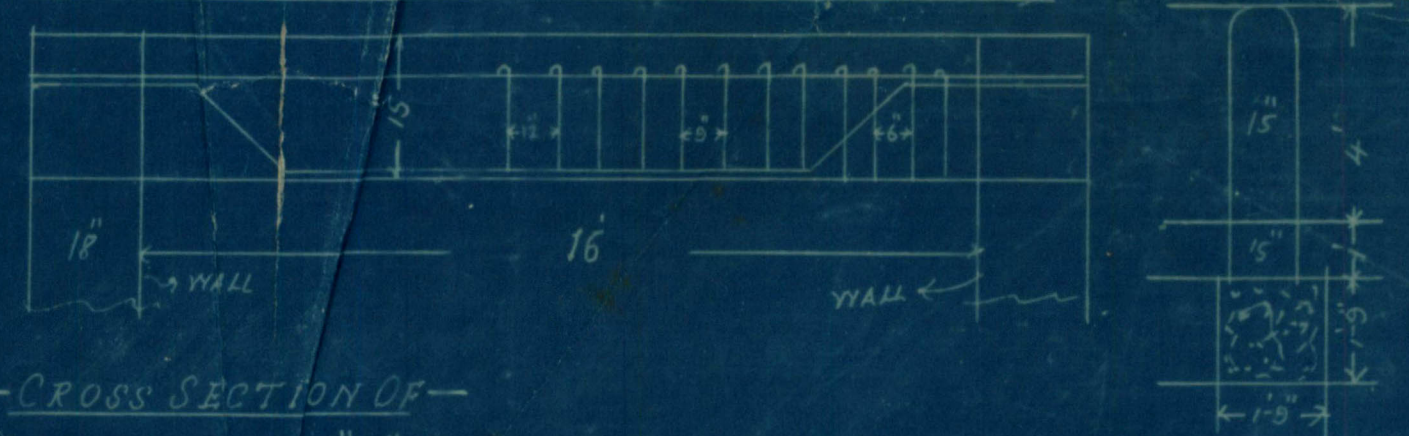


CROSS SECTION OF T BEAM A (15x9)

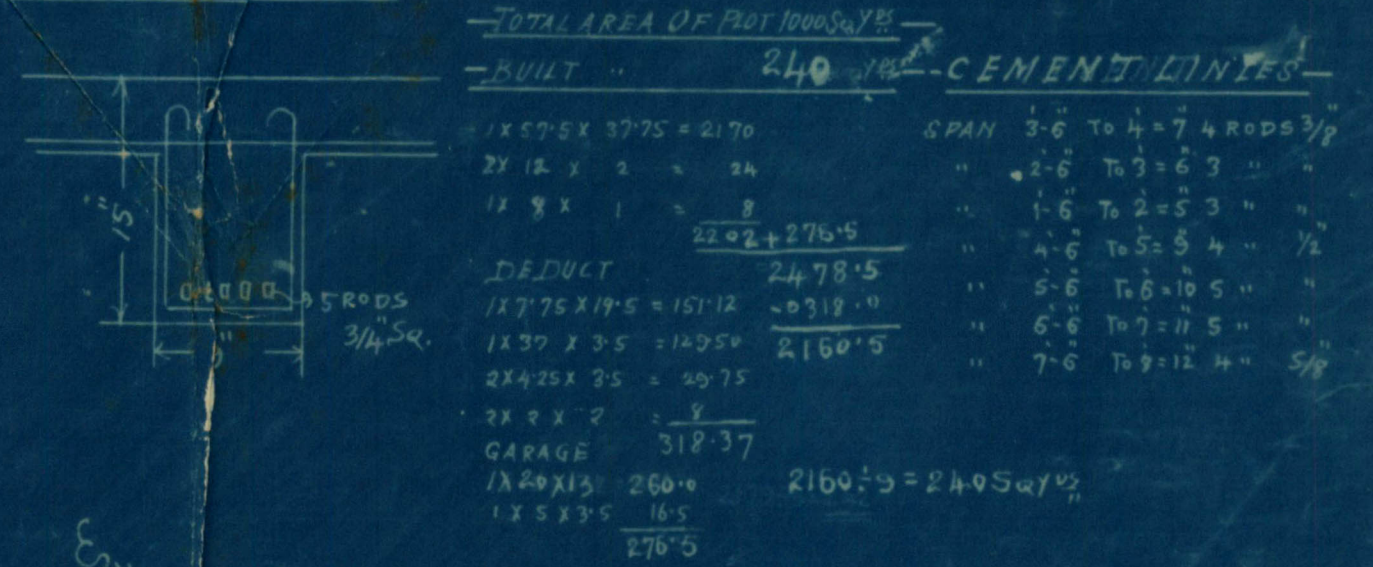

TOTAL AREA OF PLOT 1000 Sq. Yds.		CEMENT LINES	
BUILT	240	SPAN 3-6 To 4-7 4 RODS 3/4"	
1x57'5x37'75 = 2170		" 2-6 To 3-6 3 "	
2x12 x 2 = 24		" 1-6 To 2-5 3 "	
1x8 x 1 = 8		" 4-6 To 5-5 4 "	1/2
2202 + 276.5		" 5-6 To 6-10 5 "	
DEDUCT 2478.5		" 6-6 To 7-11 5 "	
1x7'75x19'5 = 151.12		" 7-6 To 8-12 4 "	5/8
1x37 x 3.5 = 129.5			
2x425x3.5 = 2975			
2x2 x 2 = 8			
GARAGE 312.37			
1x20x13 = 260.0			
1x5x3.5 = 16.5			
276.5			
2160.5			
2160.5 = 2405 Sq. Yds.			

BLOCK PLAN
SCALE 20=1

GROUND FLOOR

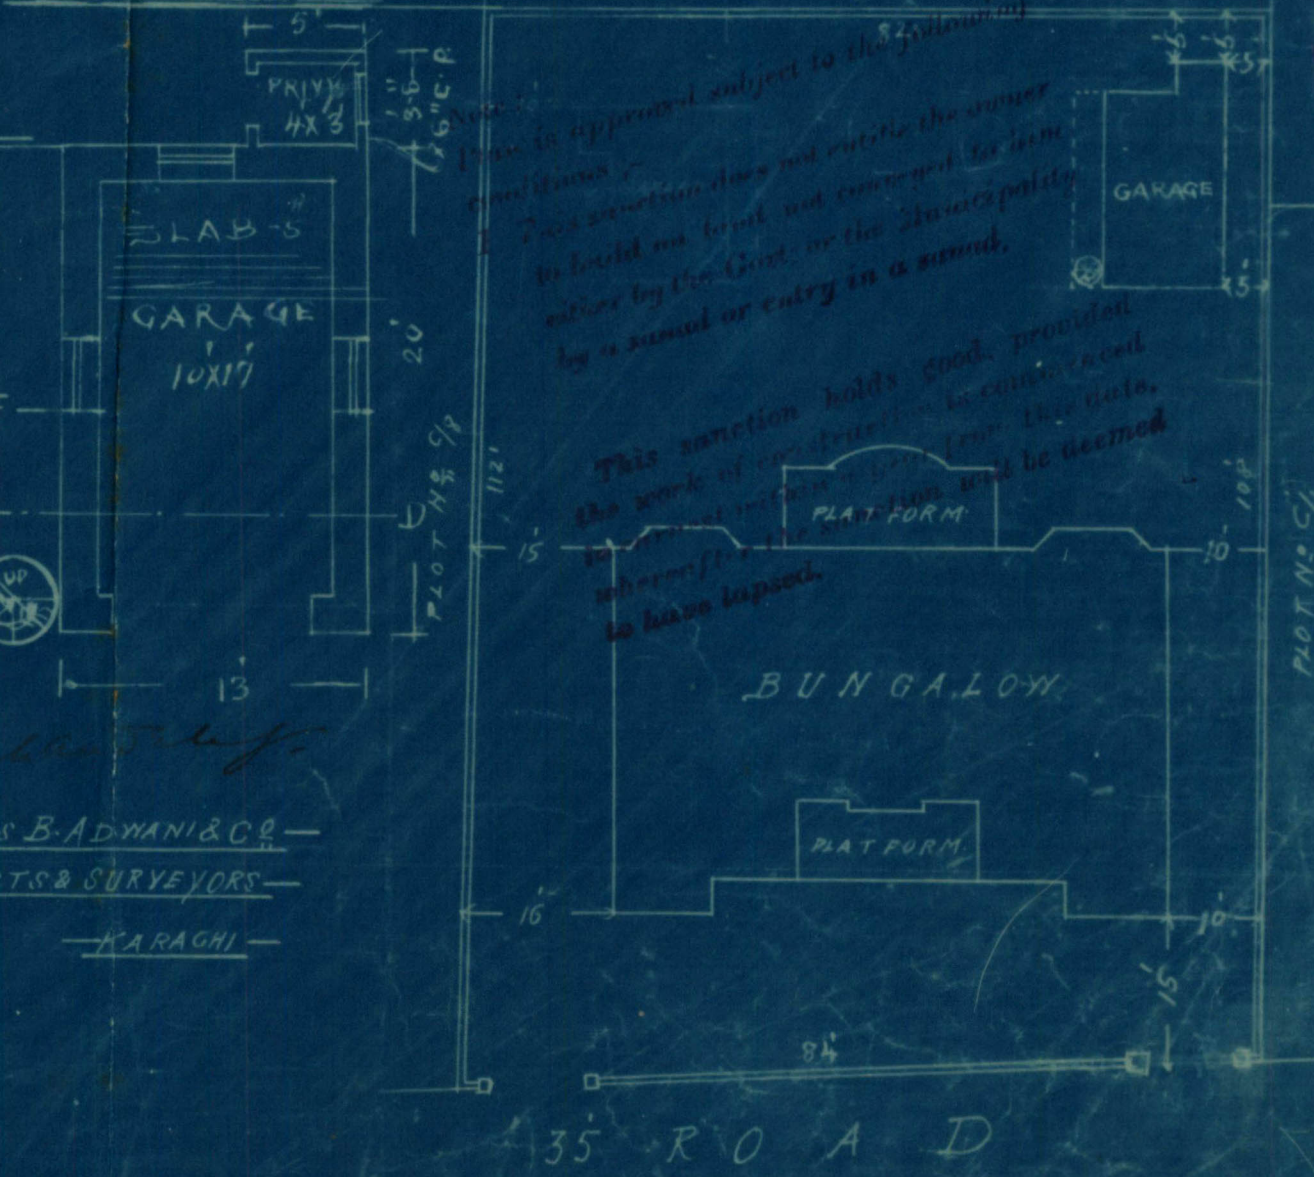

SHOWING PROPOSED BUNGALOW

ON PLOT NO. 9/6 SHEET J.M. 3

FOR

APPROVED BY THE COSMOPOLITAN CO-OPERATIVE HOUSING SOCIETY LTD.


SCALE 8=1

B. So. A. M. Inst. C. E.
Road Manager & Architect.


DURGAS B. ADWANI & CO.
ARCHITECTS & SURVEYORS
KARACHI

Umar Karaham


SECTION ON C-D

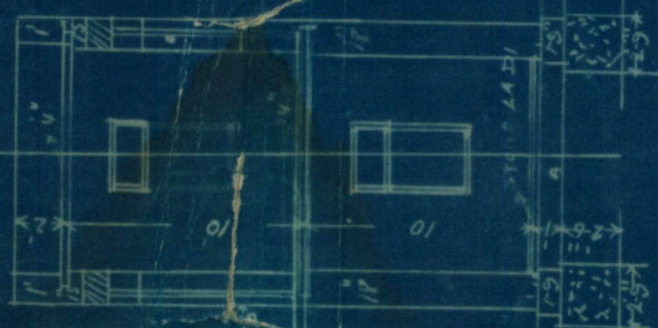


FIRST FLOOR

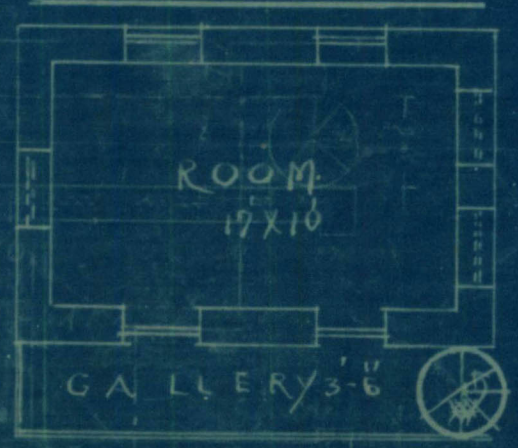


35 ROAD

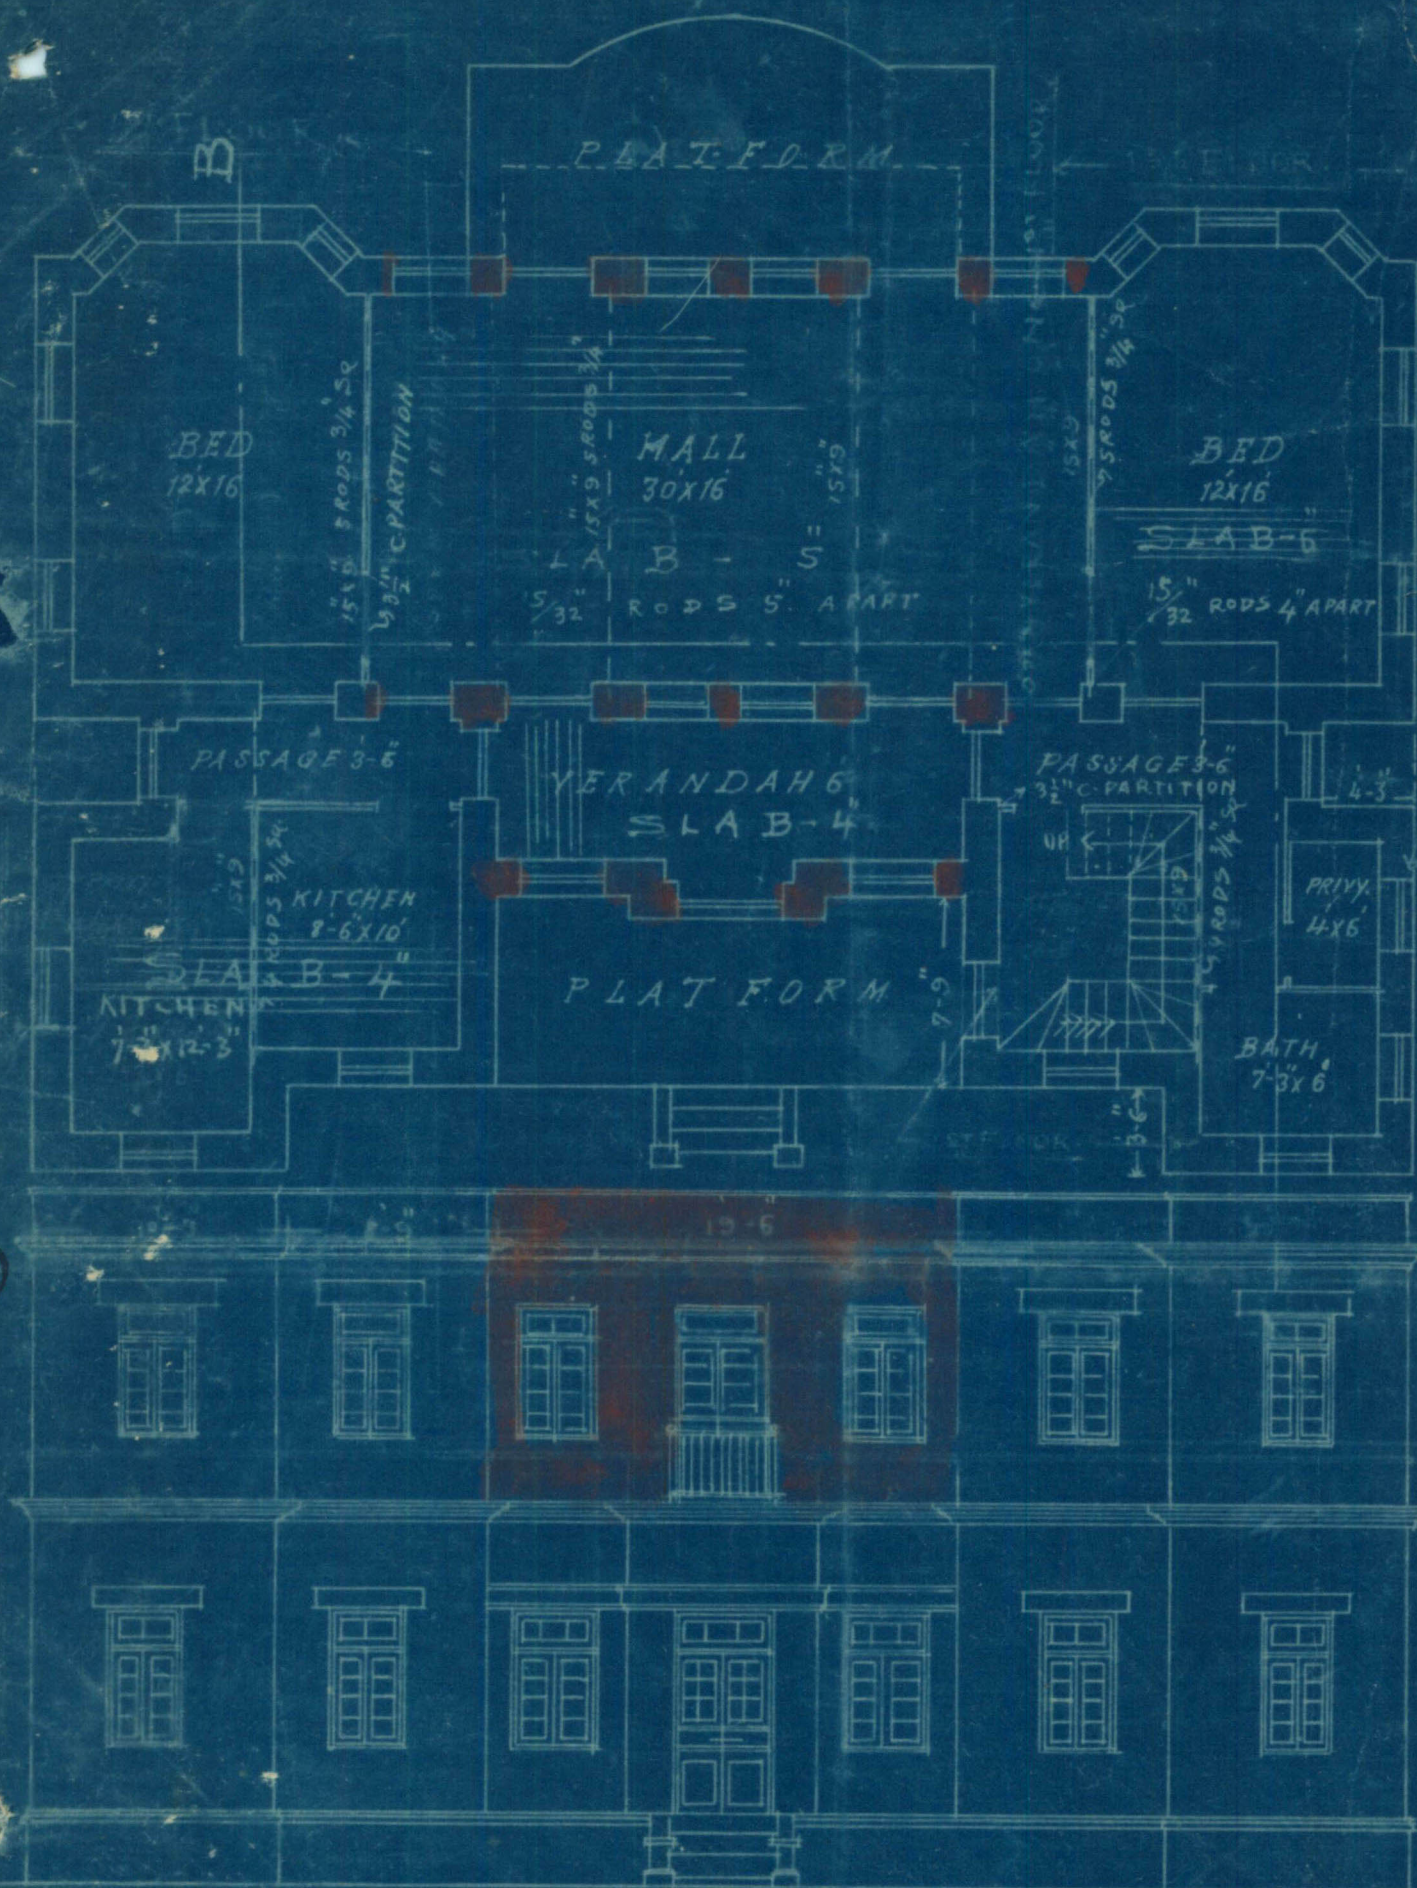GROUND & 1ST FLOOR

FIRST FLOOR ELEVATION

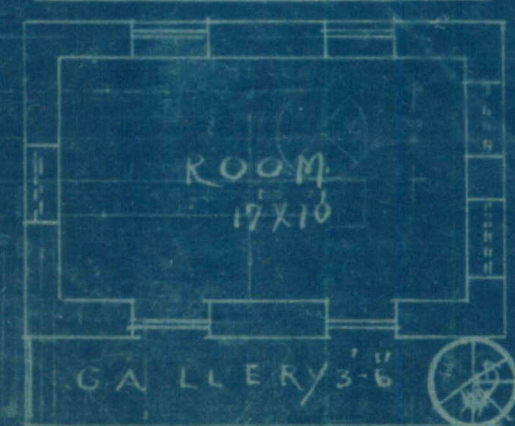

SECTION ON C.D.

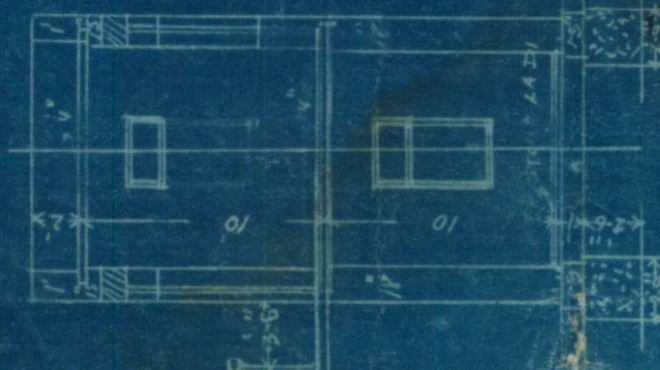

AMENDED PLAN

SHOWING PROPOSED BUNGALOW

ON PLOT NO. 9/6 SHEET J.M.3

FOR

THE COSMOPOLITAN CO-OPERATIVE HOUSING SOCIETY LTD.

SCALE 8"=1"


D. S. J. M. J. S. C. E.
Manager & Architect

Karam Karan


DURGAS B. ADWANI & CO.
ARCHITECTS & SURVEYORS

KARACHI

LONGITUDINAL SECTION OF T BEAM A (15x9)

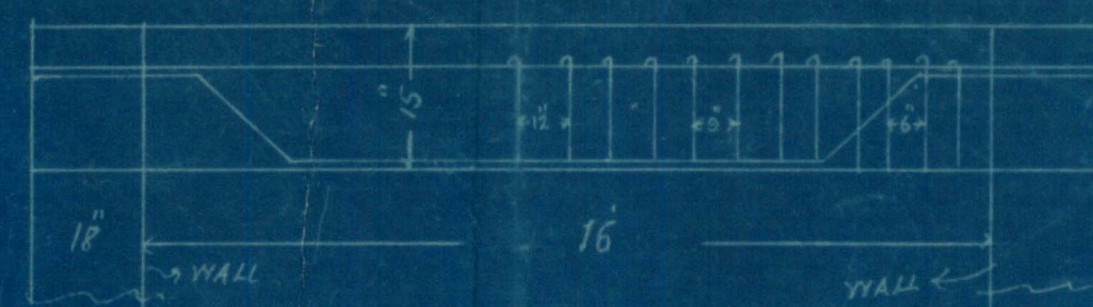

CROSS SECTION OF T BEAM A (15x9)

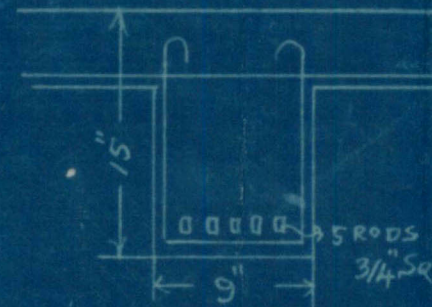

TOTAL AREA OF PLOT 1000 Sq. Yds.

BUILT 240

CEMENT LINES


1x57'5x37'75 = 2170	SPAN 3-6 To 4 = 7'4 RODS 3/4
2x12'x2 = 24	" 2-6 To 3 = 6'3 "
1x8'x1 = 8	" 1-6 To 2 = 5'3 "
2202 + 276.5 = 2478.5	" 4-6 To 5 = 5'4 "
DEDUCT 2478.5	" 5-6 To 6 = 10'5 "
1x7'75x19'5 = 151.12	" 6-6 To 7 = 11'5 "
1x37'x3'5 = 129.5	" 7-6 To 8 = 12'4 "
2x4'25x2'5 = 25.75	
2x2'x2 = 8	
GARAGE 318.37	
1x20'x15 = 260.0	2160.5 = 240 Sq. Yds.
1x5'x3'5 = 16.5	
276.5	

BLOCK PLAN

SCALE 20"=1"

PLOT NO. 9/6

GROUND FLOOR

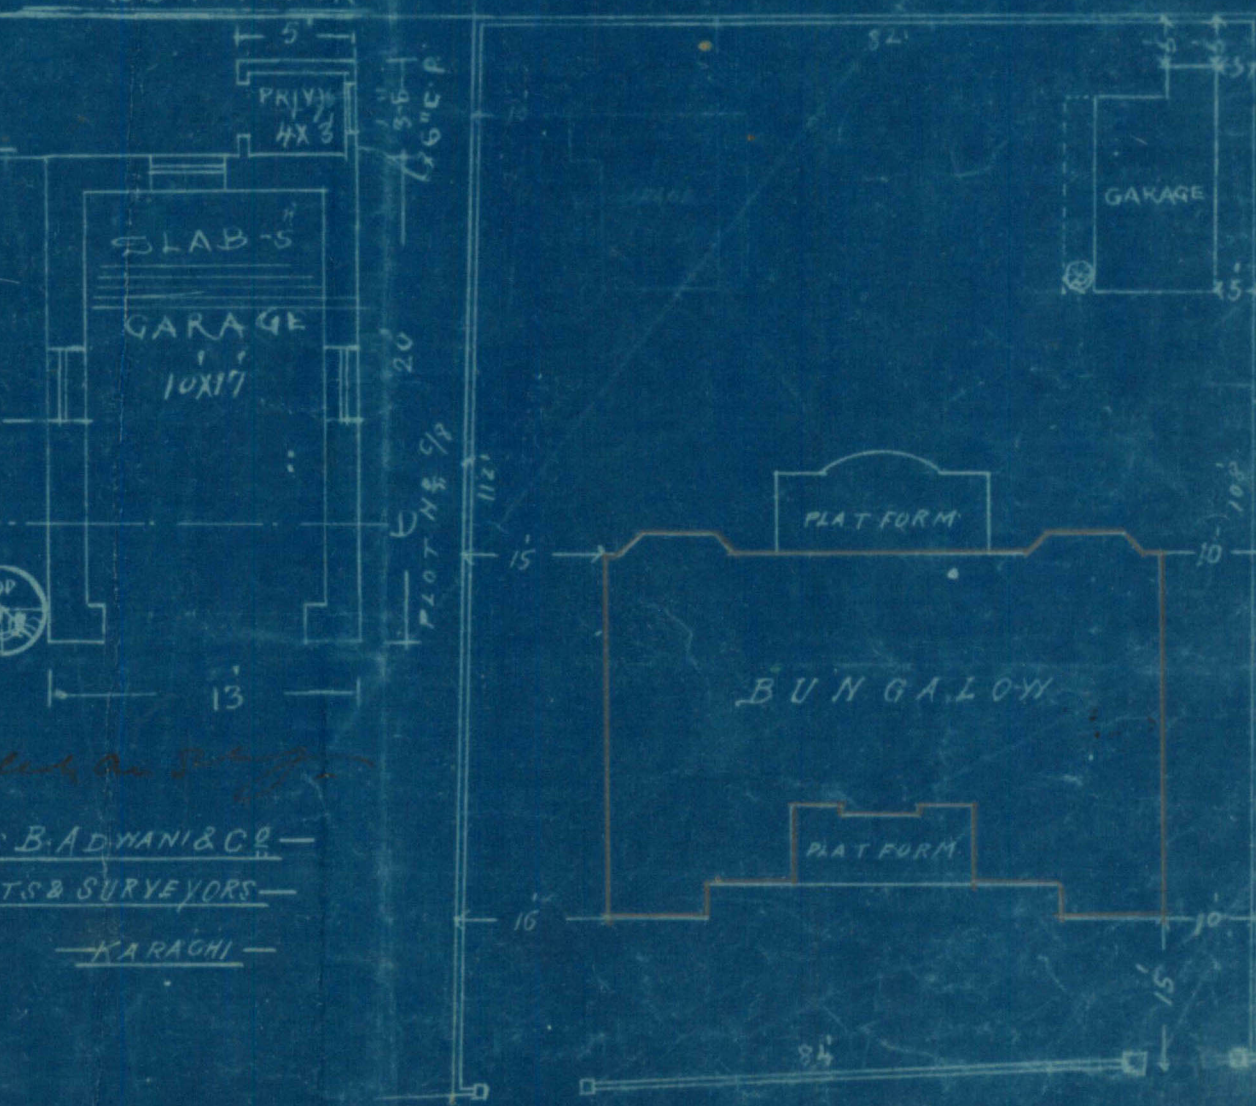

35 ROAD

BUILDING COMPLETION REPORT.

LAND MANAGER AND ARCHITECT'S OFFICE,

Karachi, _____ 19

To

THE LAND MANAGER AND ARCHITECT,
KARACHI MUNICIPALITY.

SIR

I beg to report that the building work on plot No. 9/6 Sheet J.M. 3,
Jamuna Quarter owned by M. Karachi Consolidated C. Housing Society, Ltd.
has been completed according to plans approved by the Municipality. Orders are
requested to file the correspondence.

Your obediently,

M. P. JeebhaniBuilding Surveyor "A" Section 29/11
Karachi Municipality. 29

No. L. M. A. _____ of 19

Karachi, _____ 19

Copy to the Assessor & Collector for information.

16/6

B. Sc. A. M. Inst. C. E.
Land Manager and Architect,
Karachi Municipality.69
29/11

Submittals

1) The level line is drawn through the existing portion and the portion proposed construction on 1st floor and so a portion of it is shown red in section.

2) The construction is proposed over the kitchen as well as bed rooms, means through the whole length.

3) Regarding the level 10' from the side the architect argues that the garage has already been sanctioned and so they are going to level 10'.

Approved plan as attached herewith.
F.O are request

[Signature]
26/8.

Plaz attch
[Signature]
27/8/30

KARACHI MUNICIPALITY.

KMR.CDD.JmQ.1929-1930.01

N. J. MODI.
B. Sc. Engineering London
A. M. INST. C. E., L. C. E.
A. M. I. C. E., M. E. Soc. I.
Land Manager & Architect.

REFERENCE No. L. M. A. B. S. *CB 232* OF 19

LAND MANAGER & ARCHITECT'S OFFICE,

KARACHI, *28/3* 19

FROM,

THE LAND MANAGER & ARCHITECT,

KARACHI MUNICIPALITY.

To,

Mr. D. B. Modi

Amulabhai Karach

Sir,
Gentlemen,

With reference to your application dated *19/6* 19*30*,
with a plan for the proposed building/additions and alterations on plot
No. *4/6*, Survey Shee No. *7m-3* *Jan Shad* quarter
I have the honour to inform you that until the following requirements
are complied with plans cannot be passed:—

- (1) *10' space must be left from the sides.*
- (2) *The section line is wrongly shown.*
- (3)
- (4)
- (5)
- (6)
- (7)
- (8)
- (9)

The plans are returned herewith for amendment.

I have the honour to be,
Sir/Gentlemen,
Your most obedient servant.

Modi

B. Sc. A. M. INST. C. E.,
Land Manager & Architect.

B.S.C. - 232

28/6/30


The Honorary Secretary,
Karachi Cosmopolitan co-op: Housing Society Ltd
Karachi.

Dear Sir,

Re. plot No. C/6, J.M-3, Jamshed Qr.

With reference to your building on
the above plot, I have to inform you that as
you want to construct the portion on 1st floor
the permission to occupy the building cannot
be granted. However, if you occupy, you will
do so at your own risk and cost.

Yours faithfully,

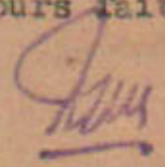

B.Sc., A.M.Inst., C.E.

LAND MANAGER & ARCHITECT.

SNT 26.6

*P. correct the
outward No. it
should be C.B.*

*Corrected
Jm*