




GROUND PLAN

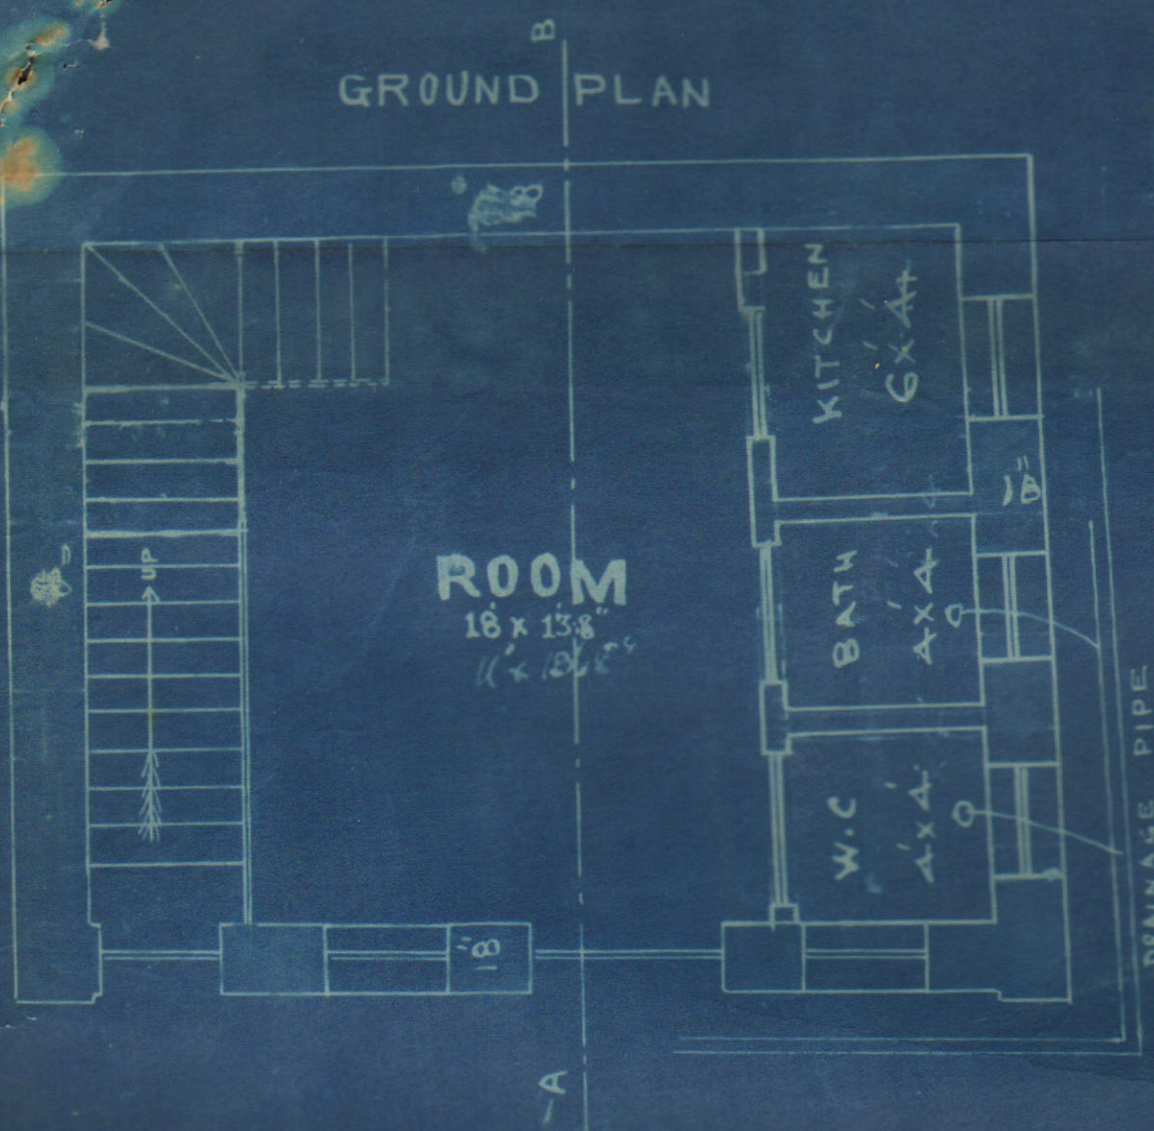

PLAN
OF BUILDING ON PLOT NO 39 B-A12
I.M.Q. SCALE 4=1"

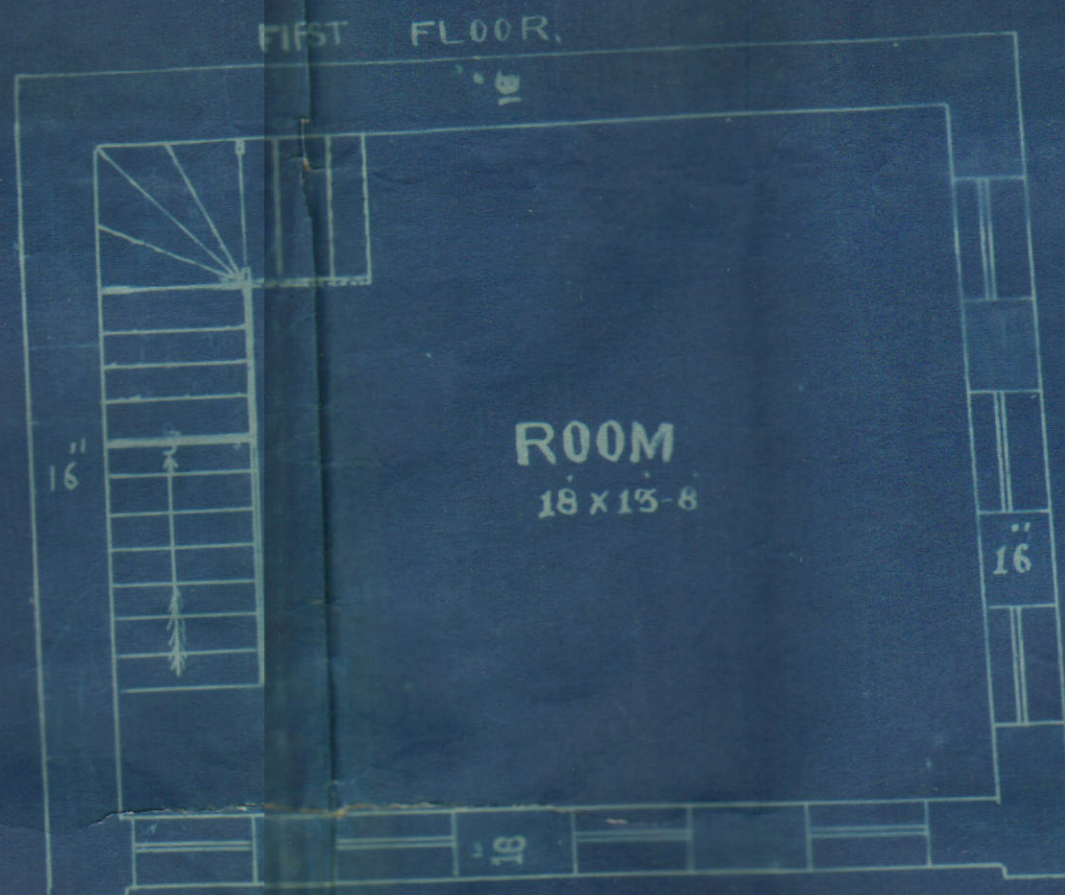


SECOND FLOOR

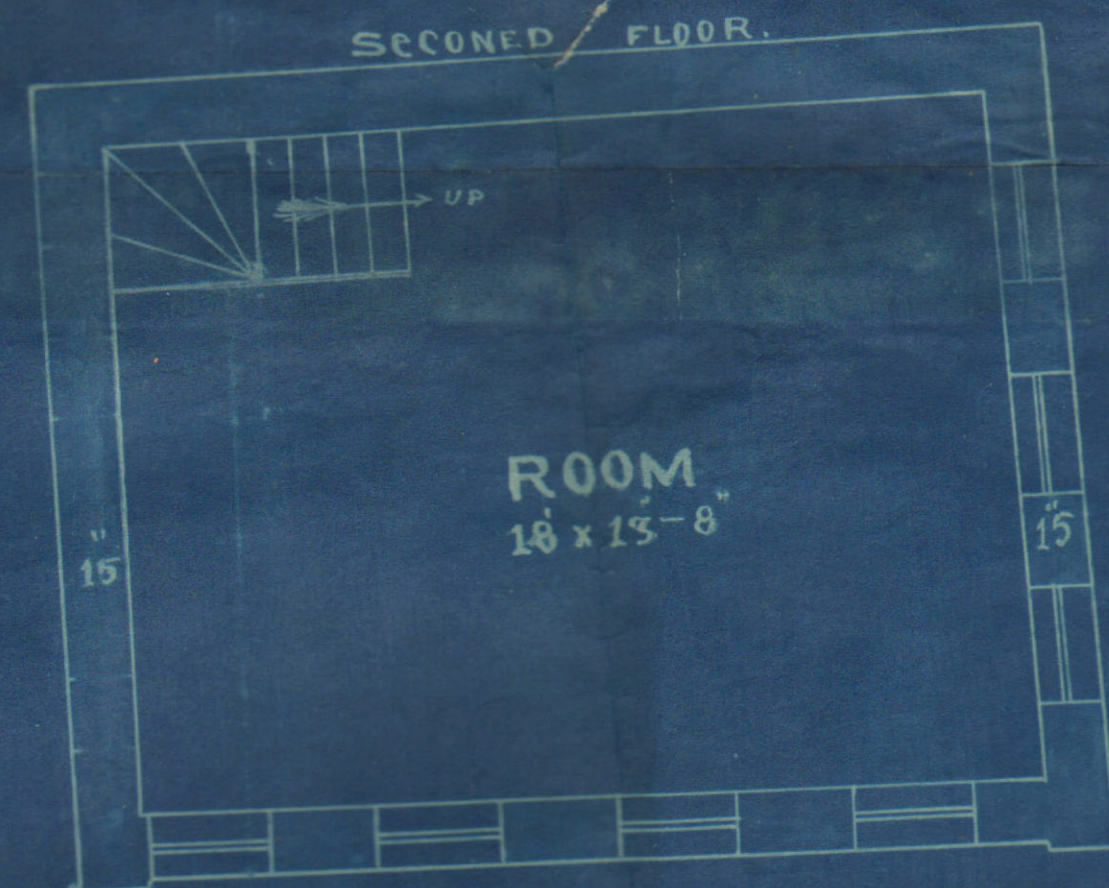


FRONT ELEVATION



SITE PLAN
SCALE 20=1"

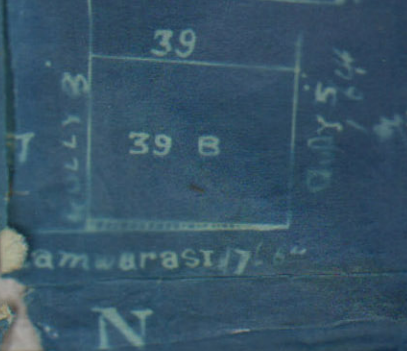

SECTION ON A B

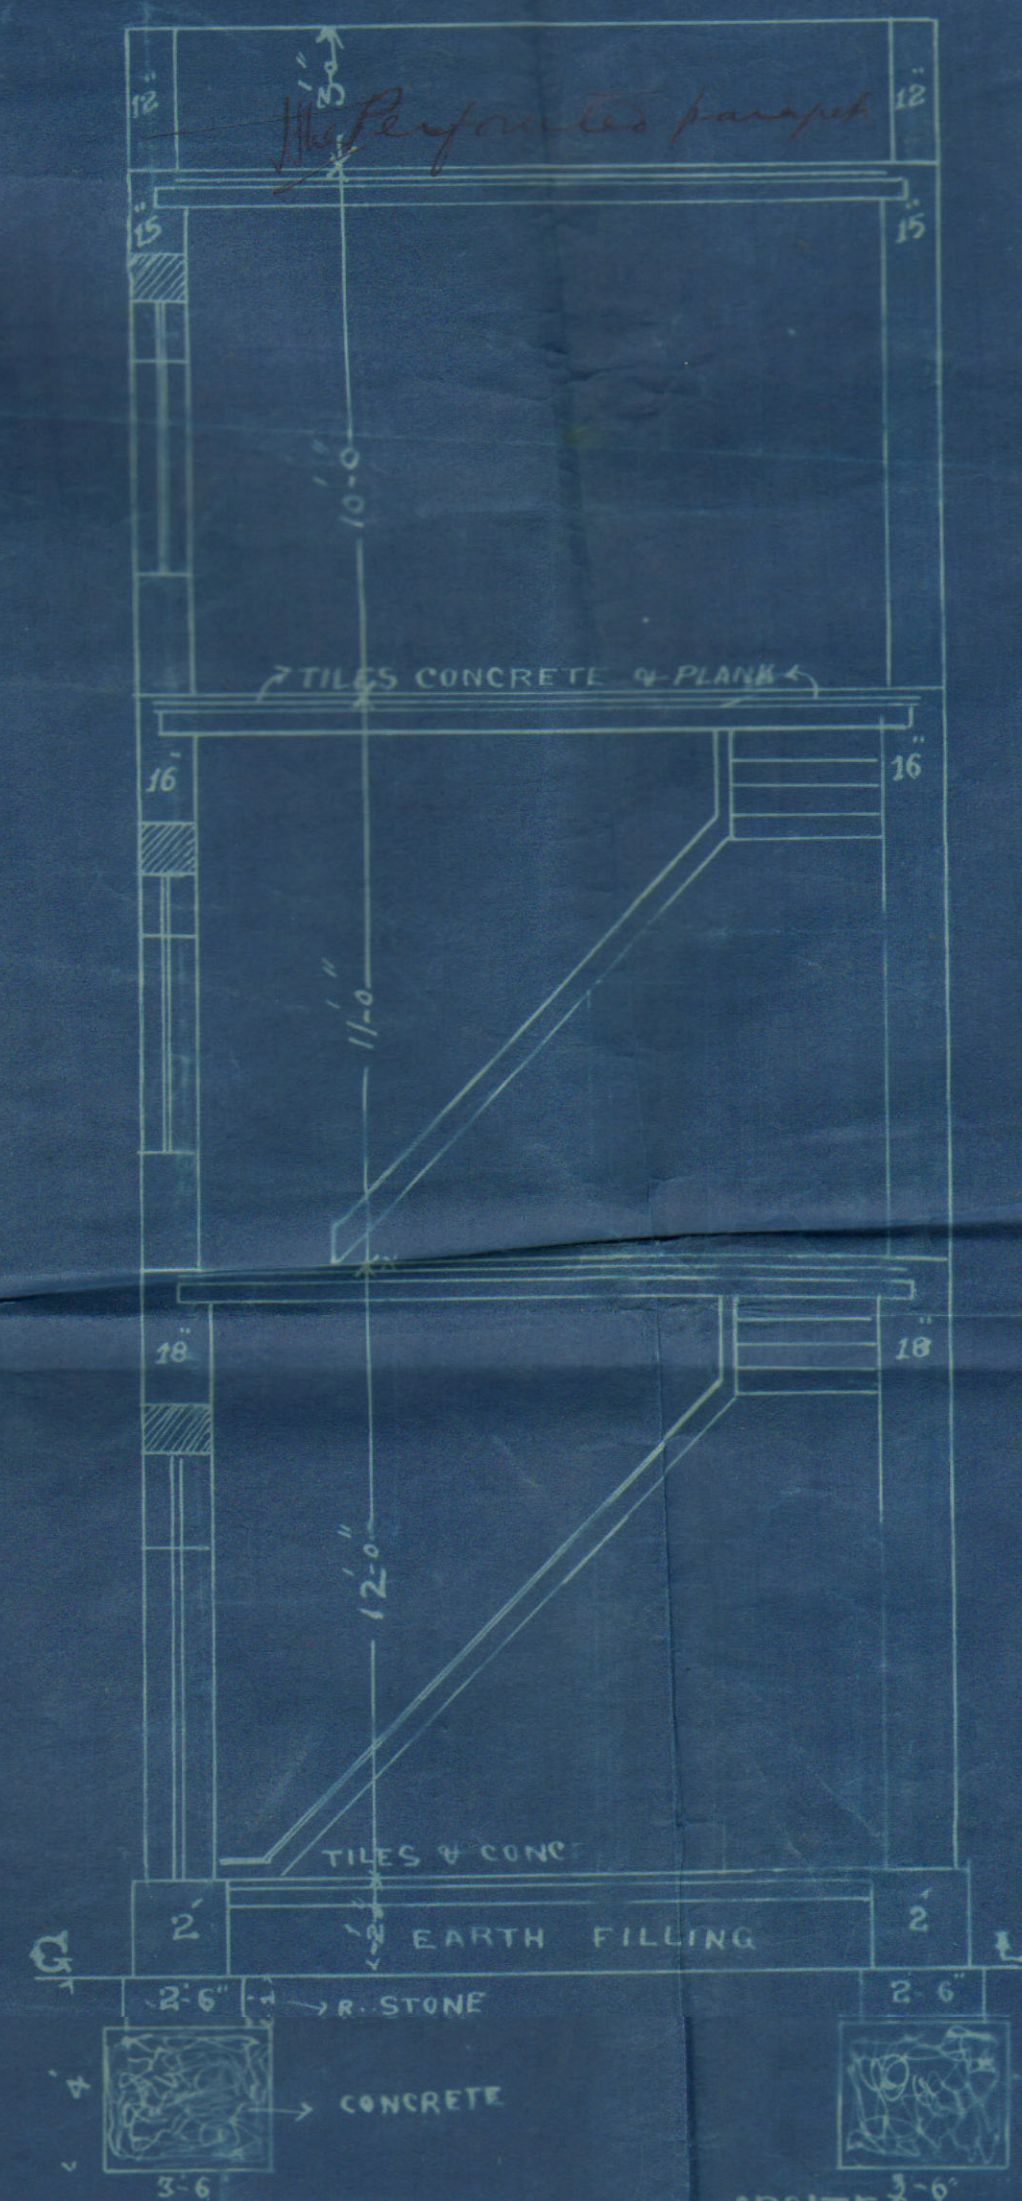

APPROVED
[Signature]
[Date]

Approved by
[Signature]
[Date]