


GROUND FLOOR

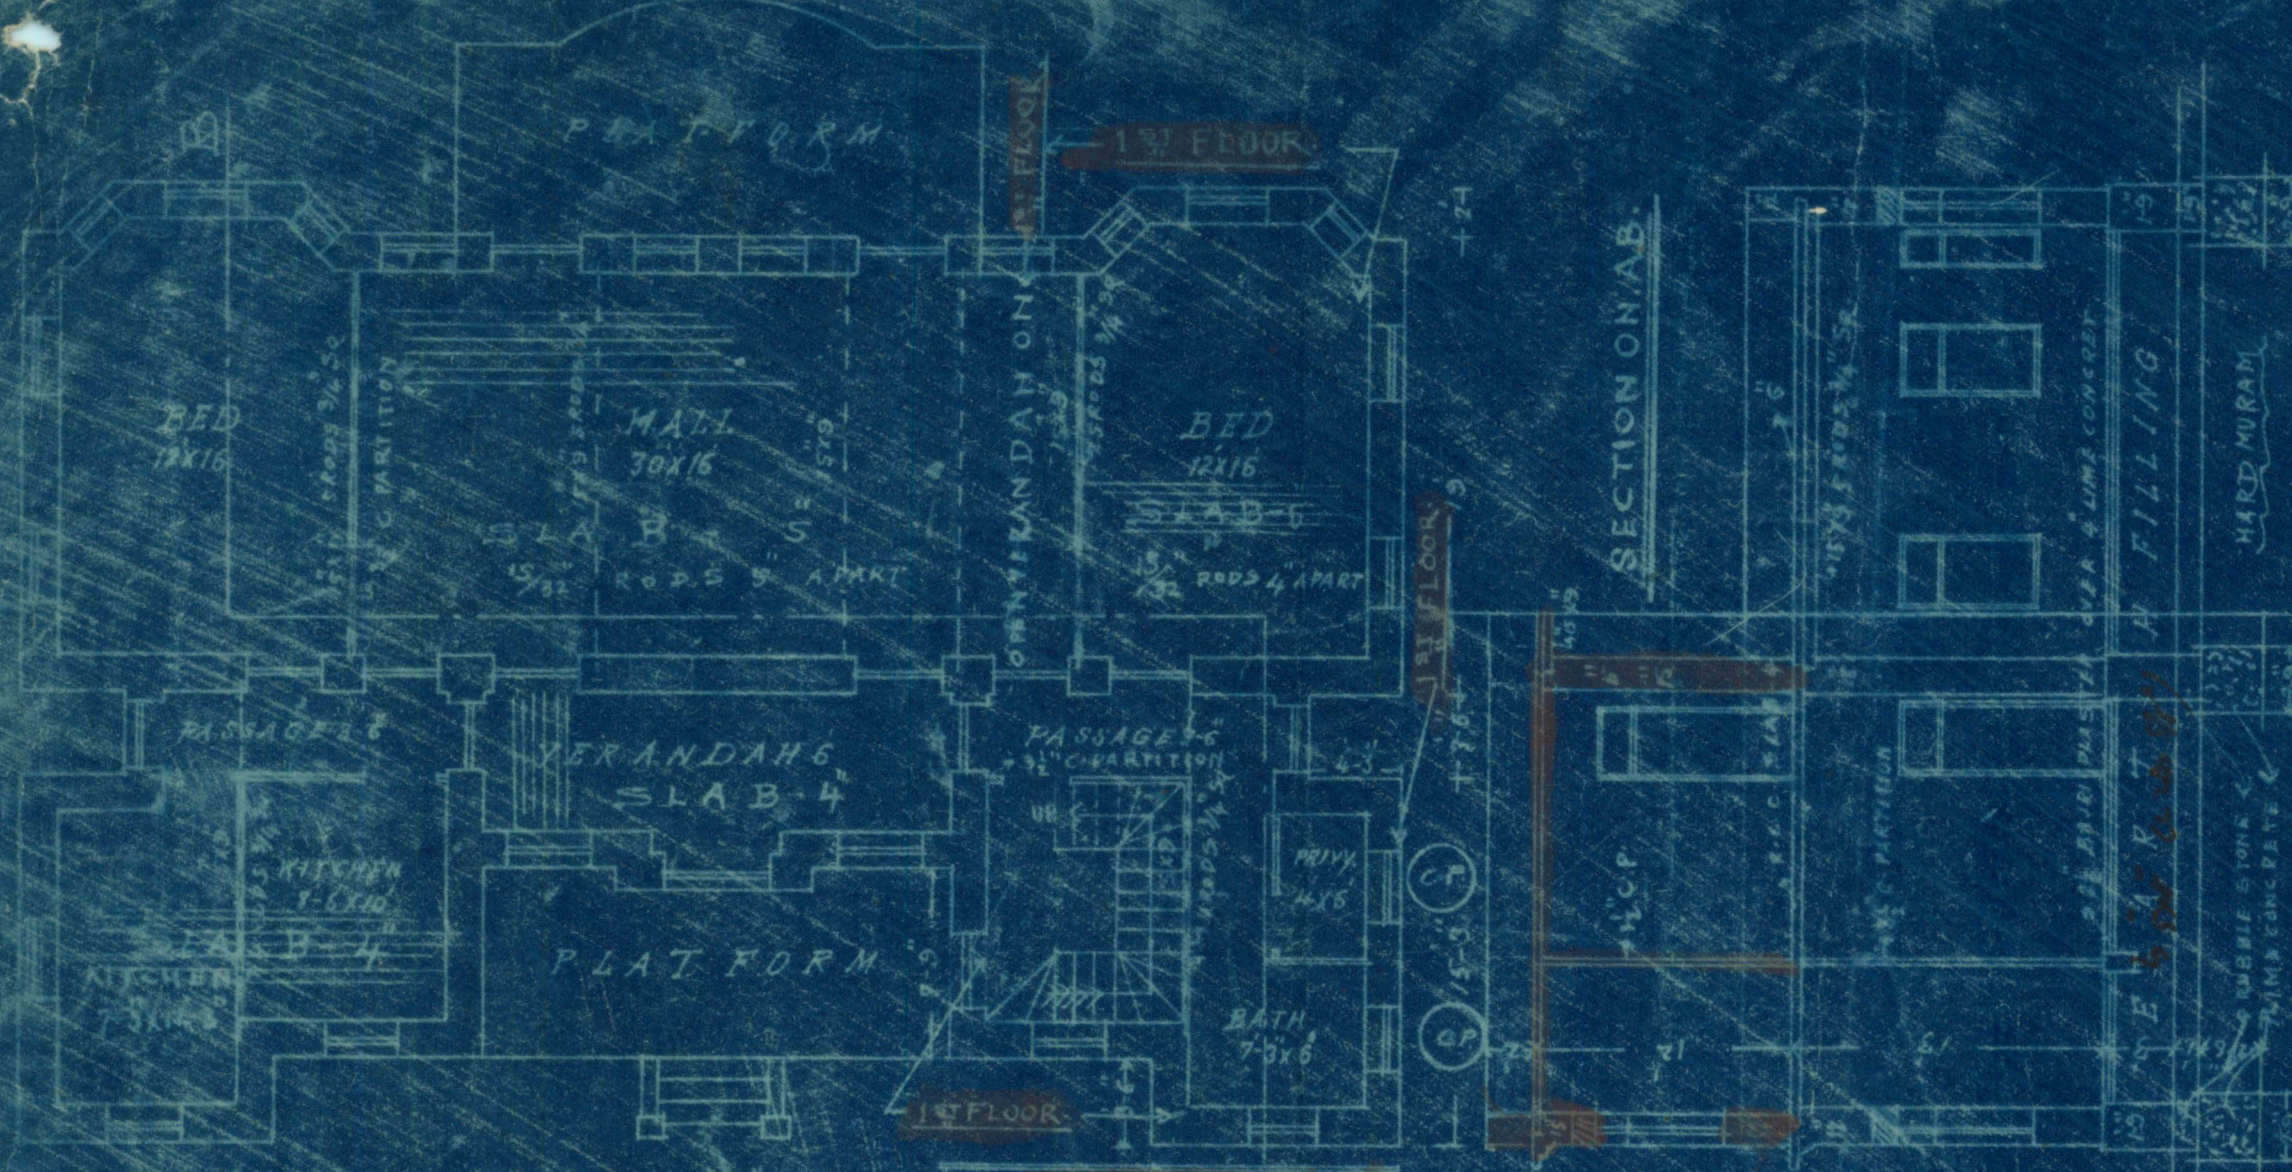

LONGITUDINAL SECTION OF BEAM A (15x9)

CROSS SECTION OF BEAM A (15x9)

TOTAL AREA OF PLOT 10000 S.F.

BUILT 240 S.F. CEMENT FINISH


1x57'5x37'5 = 2190	SPAN 3-6 TO 4-7 4 RDS
2x12'x2 = 24	4-6 TO 3-6 3 RDS
1x8'x1 = 8	1-6 TO 2-5 3 RDS
2x2'x2 = 8	4-6 TO 5-4 1/2 RDS
DEDUCT 2475.5	5-6 TO 6-10 5 RDS
1x7'5x14'5 = 109.12	6-6 TO 7-11 3 RDS
1x7'5x3'5 = 26.56	7-6 TO 8-12 4 1/2 RDS
2x4'2x2'5 = 20.75	
2x2'x2' = 8	
GARAGE 312.37	
1x20'x13' = 260	2160.5 = 2495.1%
1x5'x3'5 = 16.5	
276.5	

GROUND FLOOR

BLOCK PLAN

SCALE 20=1

PLOT N. 9/5

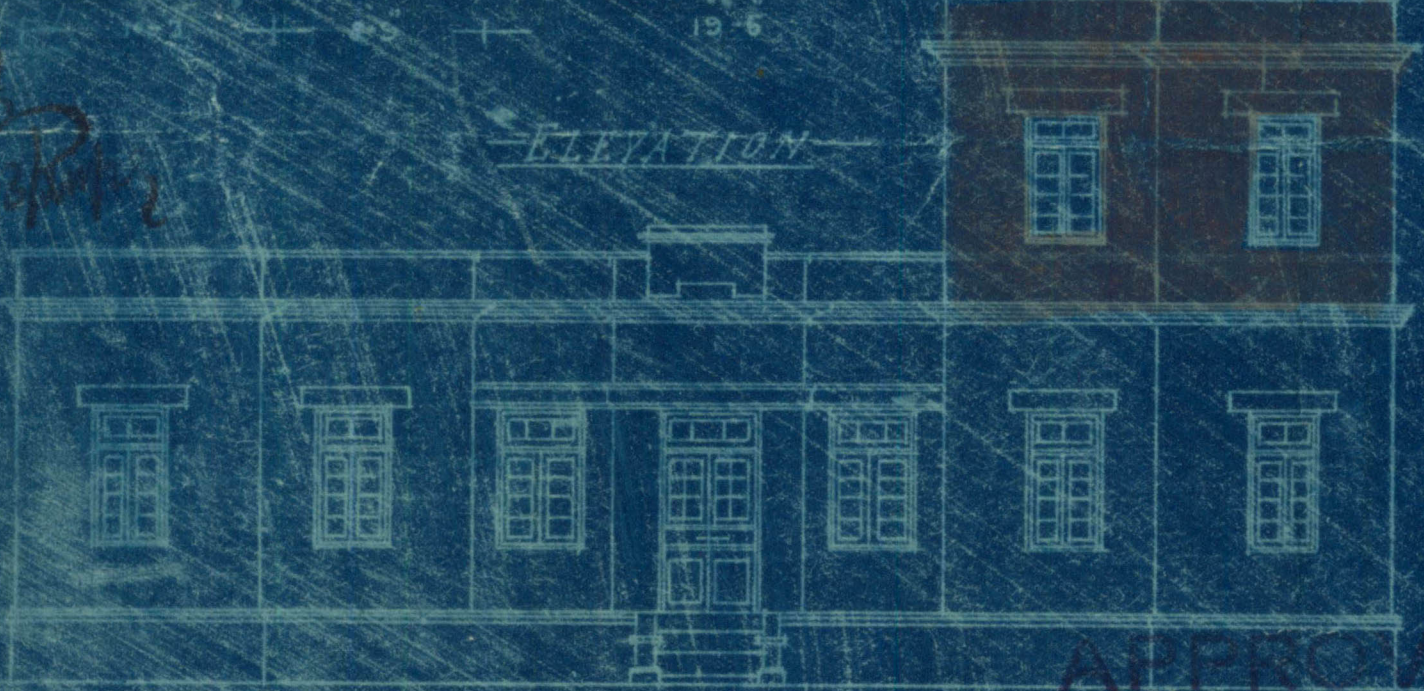

SHOWING PROPOSED BUNGALOW


ON PLOT N. 9/5 SHEET J.M.3

FOR

THE COSMOPOLITAN CO-OPERATIVE

HOUSING SOCIETY LTD.


SCALE 8=1

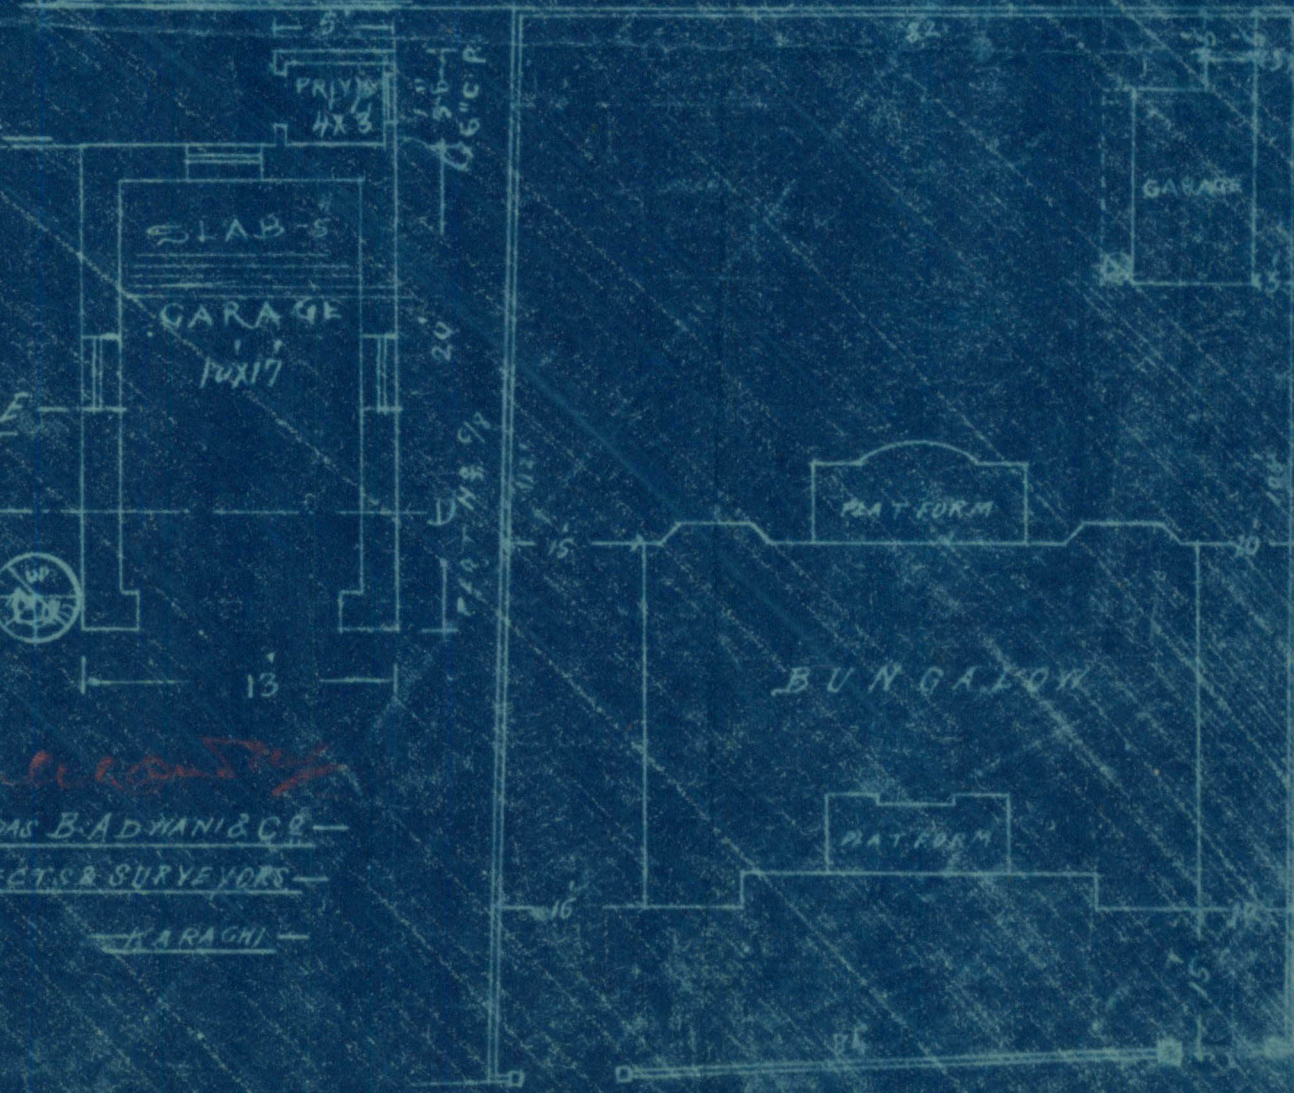

FIRST FLOOR



SECTION ON C

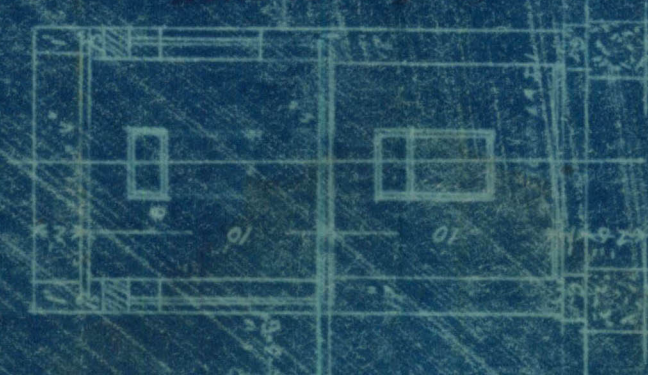

B. S. A. H. J. O. D. D.
Band Manager & Architect

DURGAS B. ADHANI & CO.
ARCHITECTS & SURVEYORS

KARACHI

35 ROAD

GROUND FLOOR

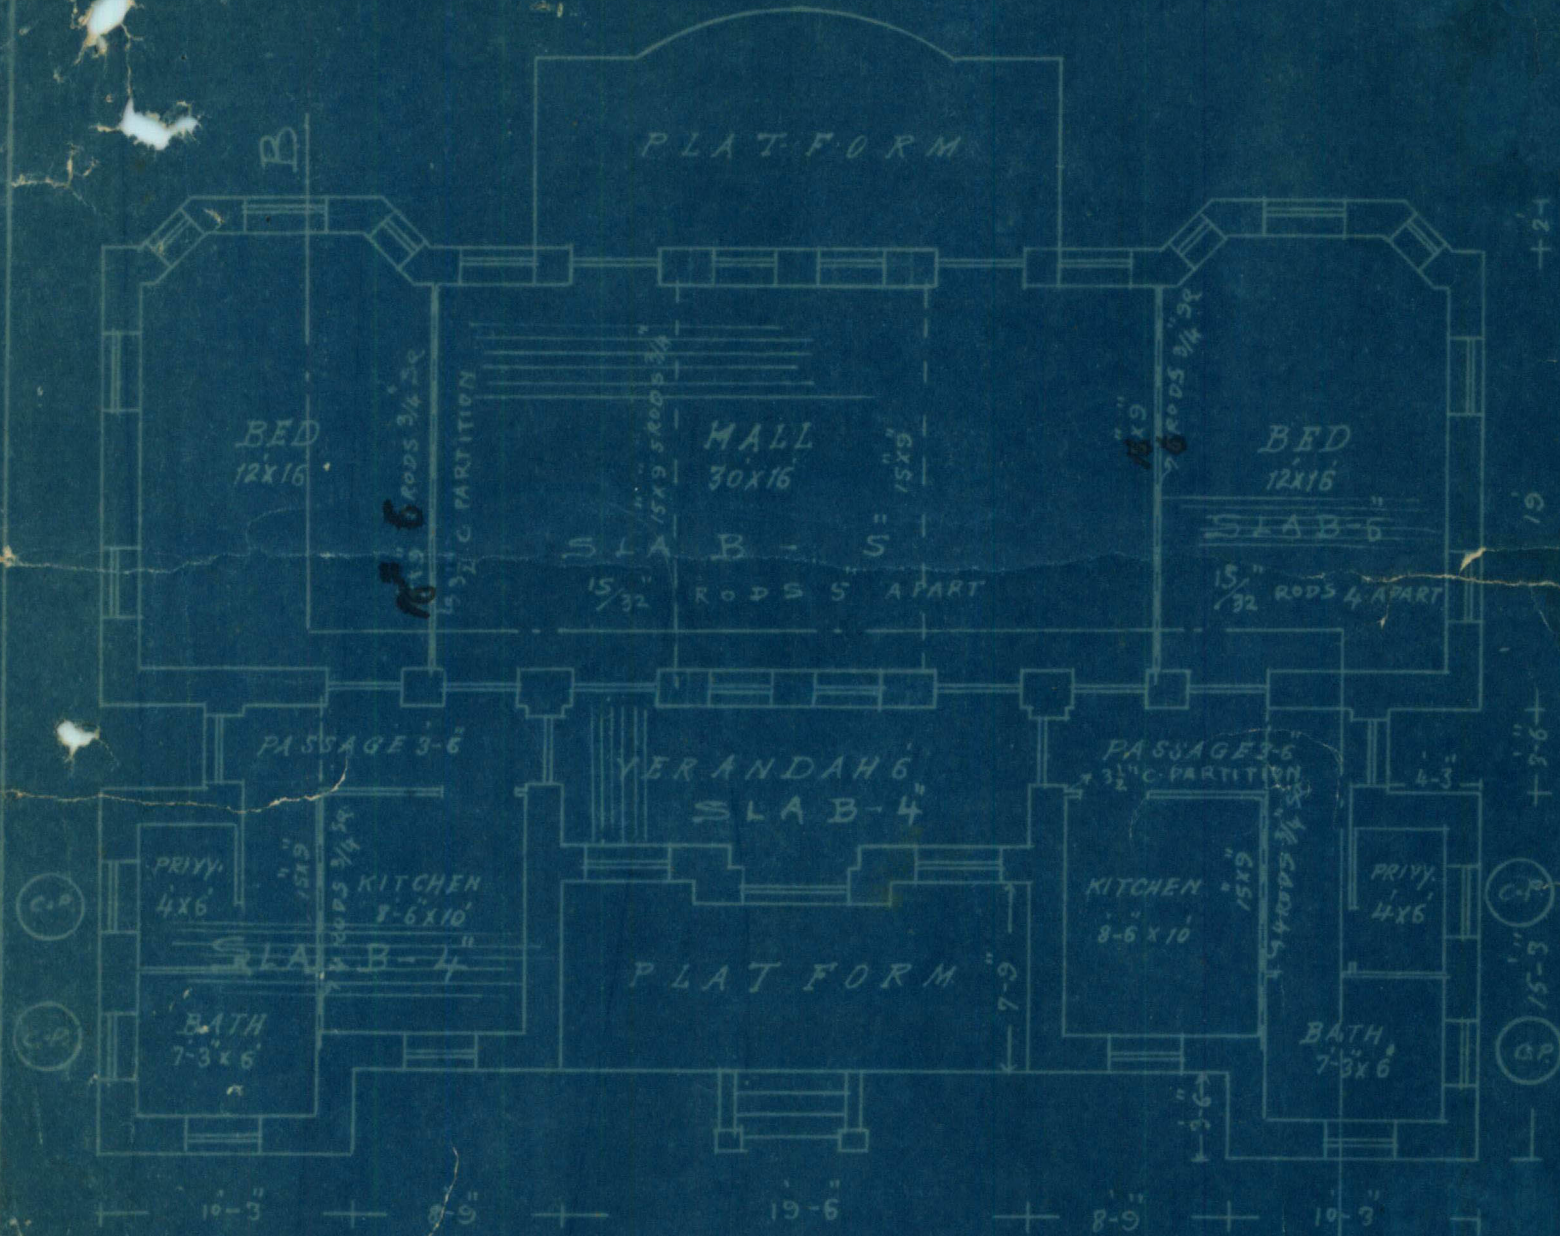


ELEVATION




GROUND & FIRST FLOOR


SECTION ON A-B

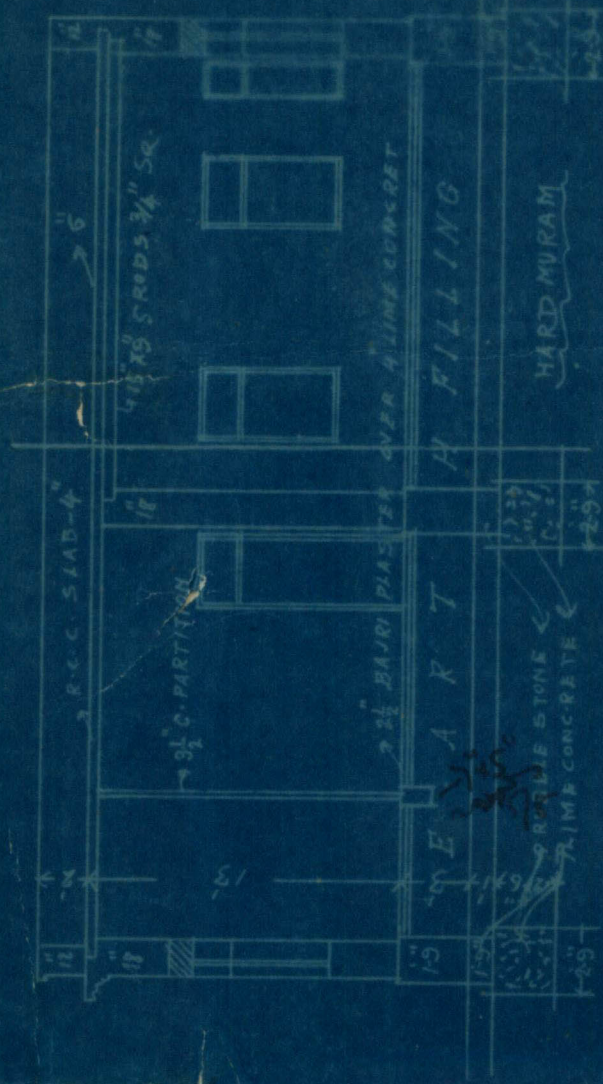

LONGITUDINAL SECTION OF T BEAM A (15x9)

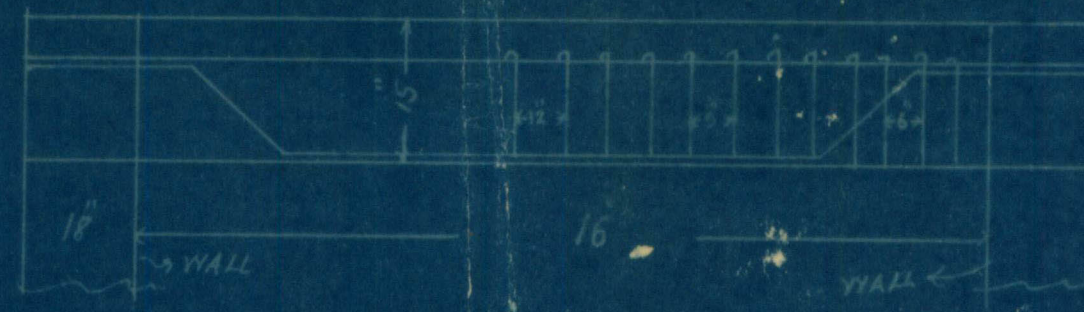

CROSS SECTION OF T BEAM A (15x9)

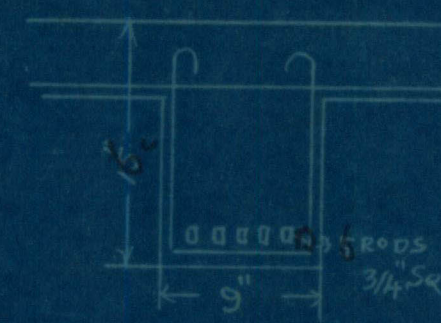

TOTAL AREA OF FOOT 1000 Sq. Yd.

BUILT	242.50	CEMENT LINES
1x57.5x37.25	= 2170	SPAN 3-6 TO 4-7 4 RODS 3/4"
2x12x2	= 24	2-6 To 3-6 3 "
1x9x1	= 8	1-5 To 2-5 3 "
	2202 + 295.5	4-6 To 5-5 4 "
DEDUCT	= 2497	5-6 To 6-5 5 "
1x7.75x19.5	= 151.12	6-6 To 7-5 5 "
1x37x3.5	= 129.50	7-5 To 8-5 5 "
2x4.25x3.5	= 29.75	
2x2x2	= 8	
GARAGE	318.37	
1x15.5x18	= 279	
1x5x3.5	= 16.5	
	2179.5 - 2497	
	2555	

APPROVED

[Signature]

BLOCK PLAN - M. Inst. C. E.
Land 111.140 - 8 Architect

SCALE 20=1

PLOT N° 9/5



SHOWING PROPOSED BUNGALOW

ON PLOT N° 9/6 SHEET J.M. 3


FOR

THE COSMOPOLITAN CO-OPERATIVE

HOUSING SOCIETY LTD.

SCALE 8=1

GROUND FLOOR

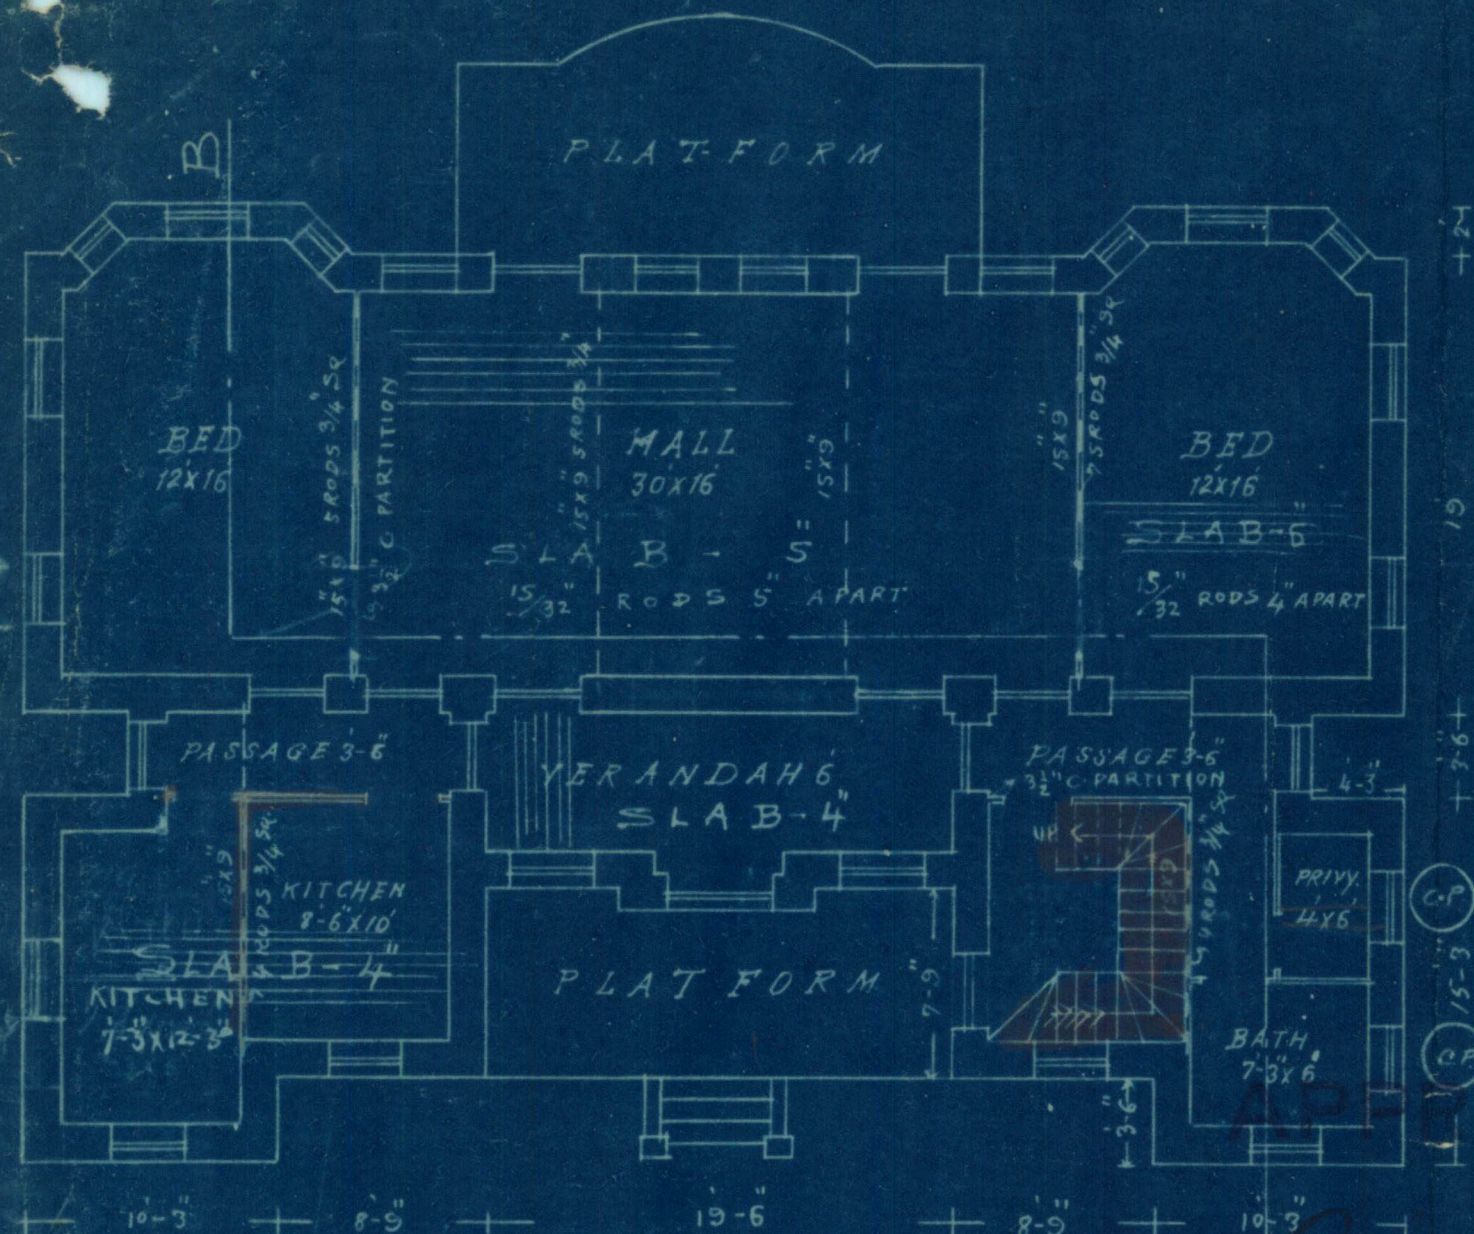


ELEVATION




FIRST FLOOR



SECTION ON C.D.

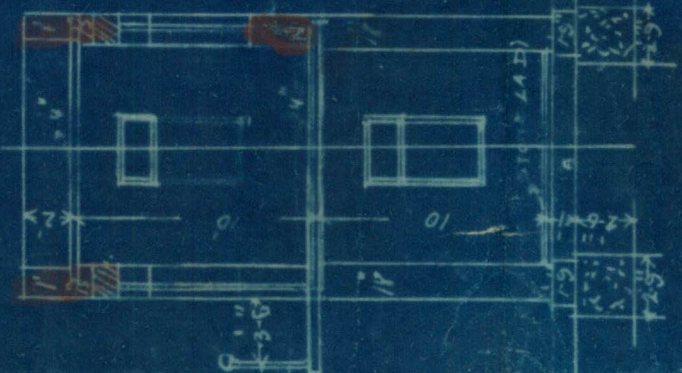

SECTION ON A.B.

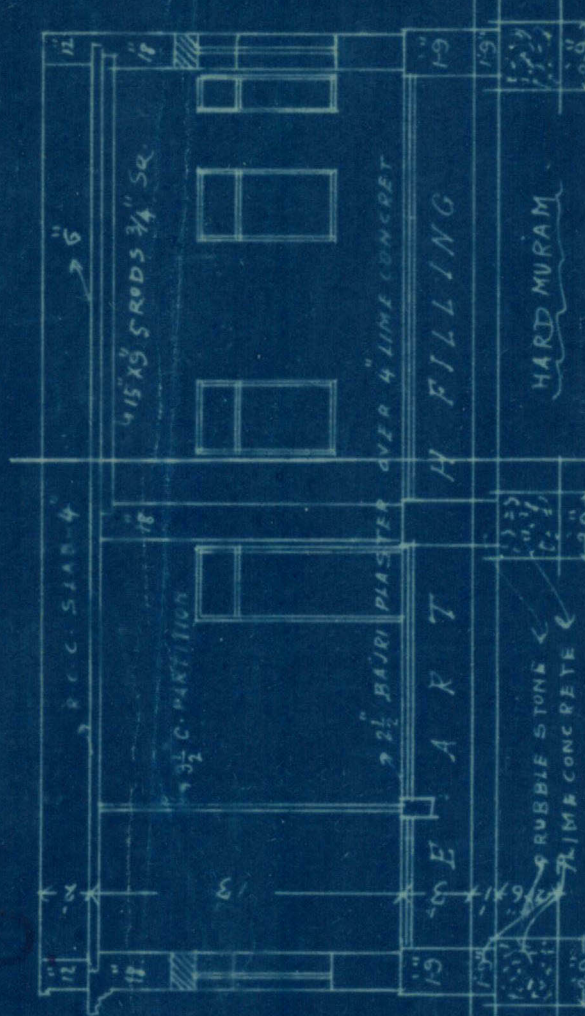


AMENDED PLAN


SHOWING PROPOSED BUNGALOW
ON PLOT NO 9/6 SHEET J.M.3
FOR
"THE COSMOPOLITAN CO-OPERATIVE
HOUSING SOCIETY LTD."

SCALE 8-1

LONGITUDINAL SECTION OF T BEAM A (15x9)

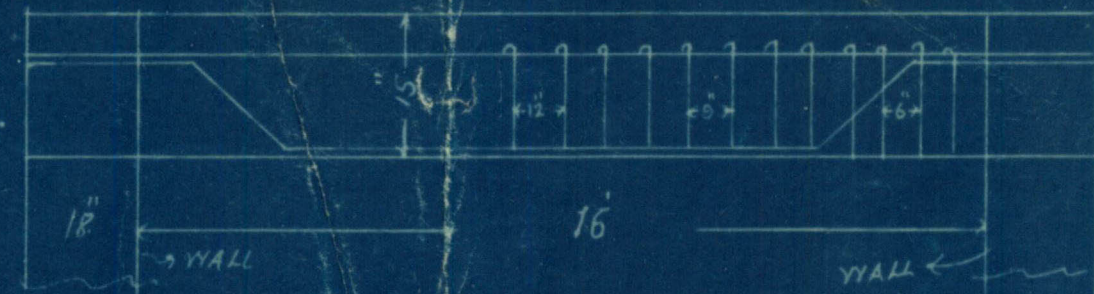

CROSS SECTION OF T BEAM A (15x9)

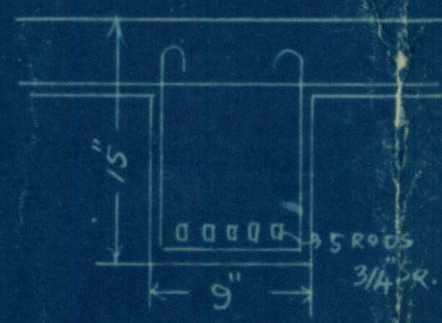

TOTAL AREA OF PLOT 1000 Sq. Yds.


BUILT 240 18

CEMENT LINES

1x57.5x37.75 = 2170	SPAN 3-6 To 4 = 7 4 rods 3/4"
2x12 x 2 = 24	" 2-6 To 3 = 6 3 "
1x8 x 1 = 8	" 1-6 To 2 = 5 3 "
2202 + 276.5 = 2478.5	" 4-6 To 5 = 5 4 1/2 "
DEDUCT 2478.5	" 5-6 To 6 = 10 5 "
1x7.75x19.5 = 151.12	" 6-6 To 7 = 11 5 "
1x39 x 3.5 = 136.5	" 7-6 To 8 = 12 4 5/8 "
2x4.25x3.5 = 29.75	
2x2 x 2 = 8	
GARAGE 318.37	
1x20x13 = 260.0	2160.5 = 2405 sq. yds.
1x5 x 3.5 = 16.5	
276.5	

BLOCK PLAN
SCALE 20-1

GROUND FLOOR

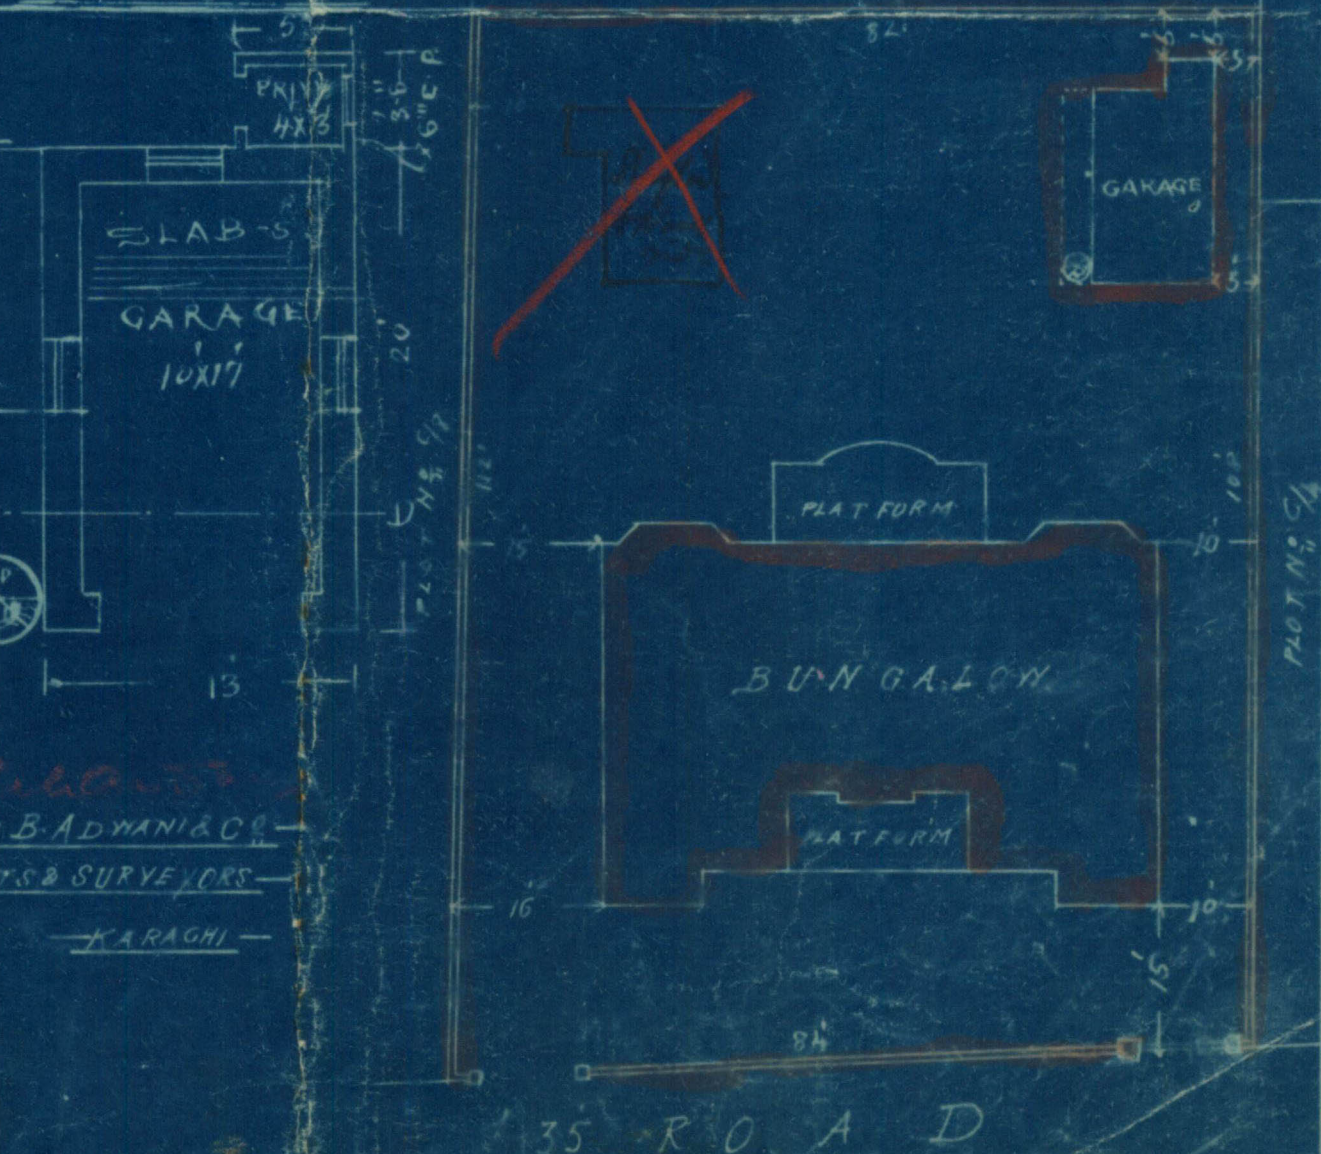

DURGAS B. ADYANI & CO.
ARCHITECTS & SURVEYORS
KARACHI

Umar Karahan

KARACHI MUNICIPALITY.

N. J. MODI.

B. Sc., (Engineering London.)

A. M. INST., C. E., L. C. E.

A. M. I. S. E., M. R. Soc. I.

Land Manager & Architect.

REFERENCE No. L.M.A./B.S.C.B. 232 of 193

LAND MANAGER & ARCHITECT'S OFFICE,

KARACHI, 2/9/1930

From,

THE LAND MANAGER & ARCHITECT,
KARACHI MUNICIPALITY.

To,

Messrs. D.B. Adrain & Co:
Architect - KARACHI.

Sir,

With reference to your application dated.....
with amended plans for the building on plot No. 46. Sheet. *for Jamshed*
Quarter, I have the honour to return herewith a copy of the plan duly signed
and approved.

I have the honour to be

Sir,

Your most obedient servant.

[Signature]
d B. Sc., A. M. INST., C. E.,
Land Manager and Architect.

No. W.GA/31 of 1930.

SUPERINTENDENT OF MACHINERY'S OFFICE,

Karachi 27th March 1930.

M e m o :-

Re. Drainage on plot Nos. E/4, E/9, G/2 & C/6,
J.M.3.

In returning the attached completion forms
Undersigned has the honour to inform the Land Manager
& Architect that plumbing work has not been carried
out satisfactorily.

sd/ E. A. Hilton,

Superintendent of Machinery,
Karachi Municipality.

No. 138. C.E. — of 1930.

Municipal Office,

Karachi, 7th April 1930.

Copy forwarded to Mr. N. M. Gidwani for
information and doing the needful.

SNT 4.4

MP
B.Sc., A.M., Inst., C.E., 5th W
LAND MANAGER & ARCHITECT.

1) ask the S.M. if the plumbing work has been
subsequently carried out to his satisfaction.
2) send reminder to the architect.

MP
28/4/30