

346/34

Mangal Puri Road

3

BUILDING SURVEYOR'S REPORT.

- ① Chokidar's room cannot be allowed less than 80' Sq. ft.
- ② Roof details for the various rooms must be shown clearly on plans.

S
20/11

Date _____

Building Surveyor,



Remarks of LAND MANAGER AND ARCHITECT.

M/s. Dyechan

12/10/16


Date _____

Land Manager and Architect.

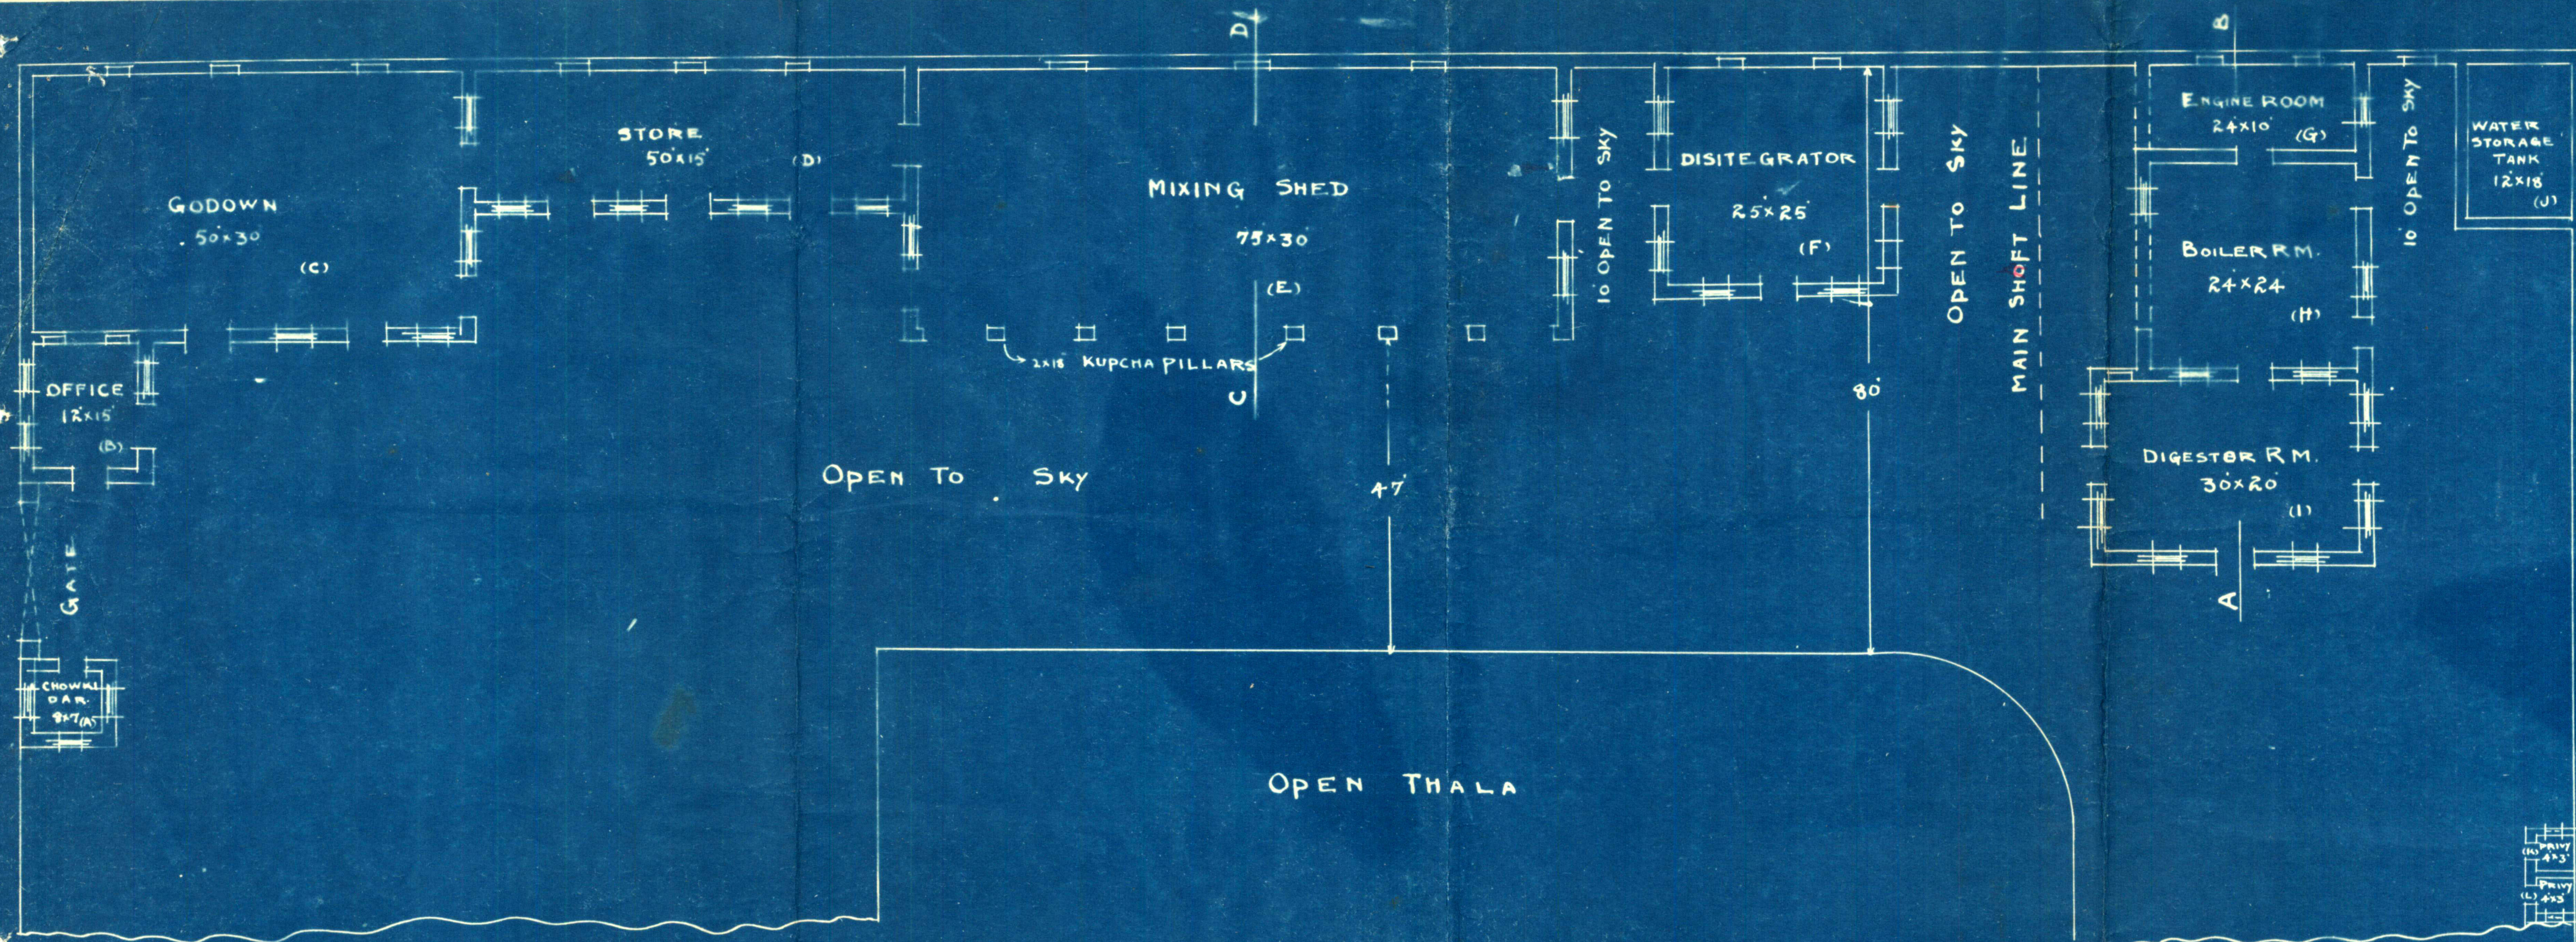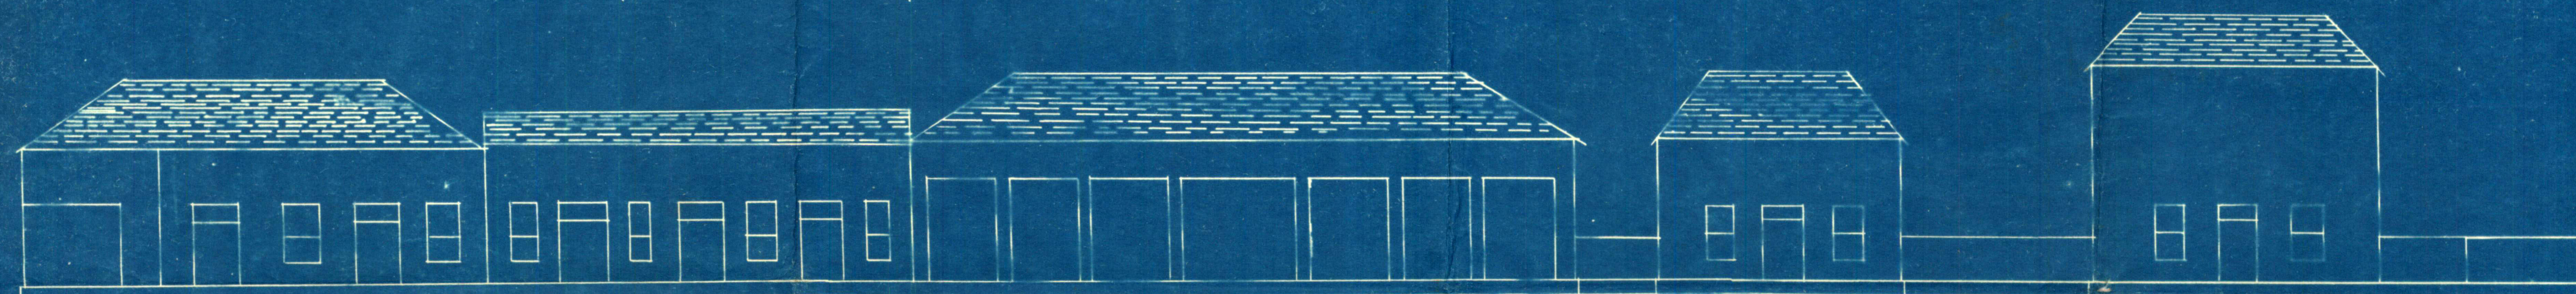

ELEVATION.


PLAN FOR PROPOSED FISH-MANURE FACTORY
ON MANGHA-PIR ROAD
SCALE 1/2"=1'

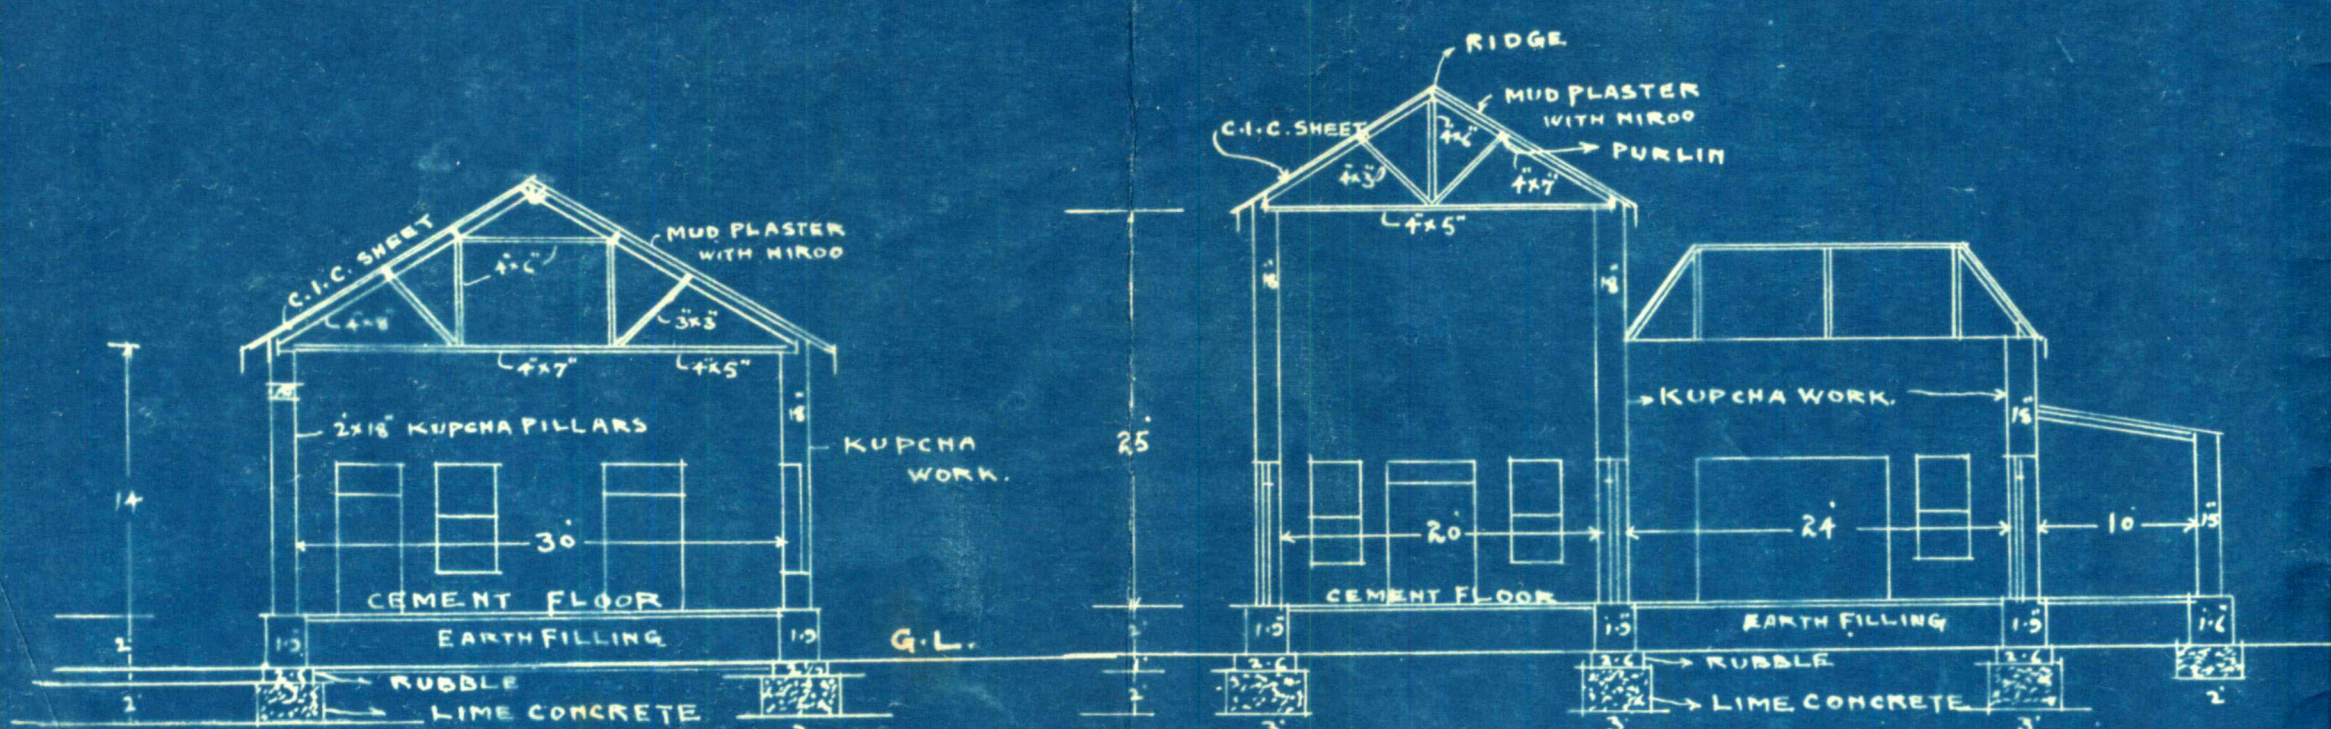

SECTION ON CD.

SECTION ON AB.

SECTION OF COMPOUND WALL.

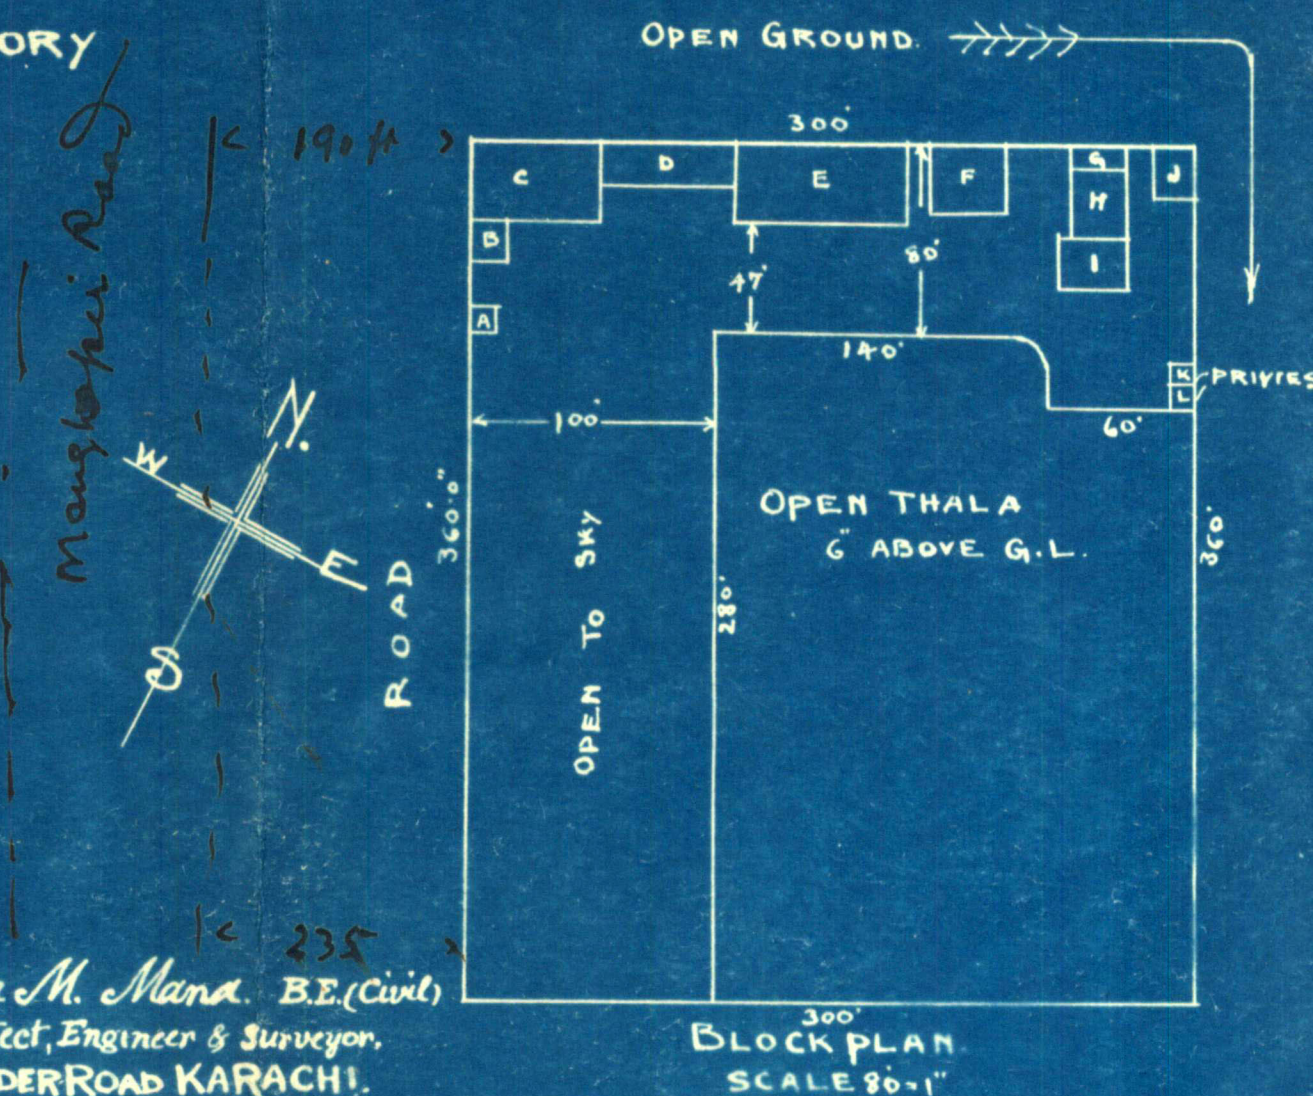

Office Telephone Nos. 1140 & 1141.

Reference " " 199.

KUMBERALI BHALEDINO,
L. C. E.,
LAND MANAGER & ARCHITECT



**MUNICIPAL CORPORATION,
KARACHI.**

Reference No. B. S. P. 346/34

22 JUN 1934

To,

Mr. Burjor Ardeshir Co.,

c/O Mr. Mana, architect

Dear Sir,

With reference to your application dated.....29-5-34.....
with a plan for the proposed building/additions and alterations on plot
No. Factory, Survey Sheet No. Mangho Pir Quarter
I have to request you to comply with the following requirements:—

- ✓ 1. Chokidar's room cannot be allowed less than 80 sq. ft.
- ✓ 2. Roof details for the various rooms must be shown
clearly on plans.

21-6-34. *Passes with comp. to L. & for remarks.* *favour.*

no objection. *Dr. 26/6/34*

Sub mits.

objections have been complied with
Man approved 24/7 *31/7*

The plans are returned herewith rejected.

Yours faithfully

Dr 20/6
Land Manager & Architect.