
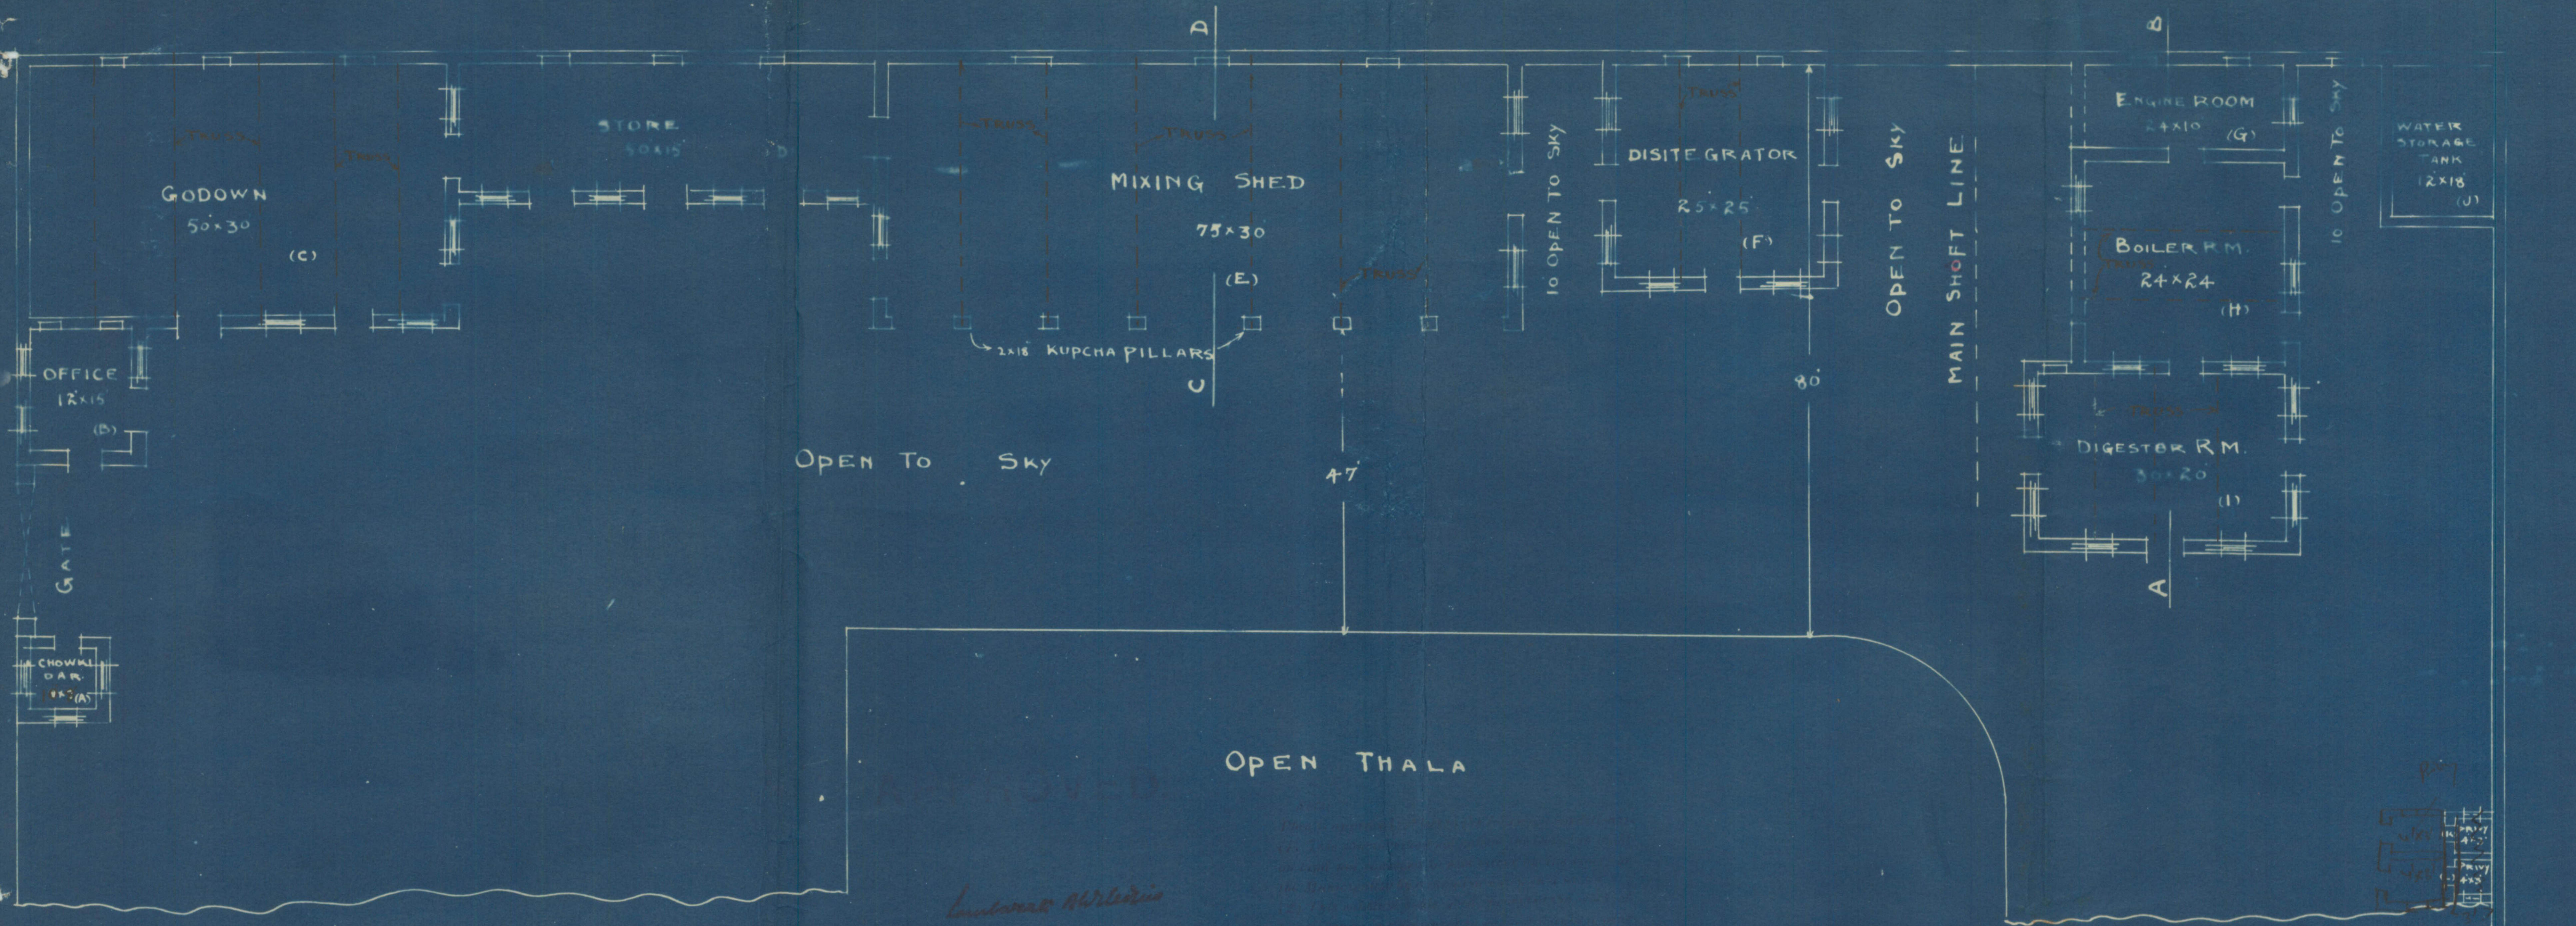


ELEVATION.


PLAN FOR PROPOSED FISH-MANURE FACTORY
ON MANGHA-PIR ROAD
SCALE 1/2"=1'

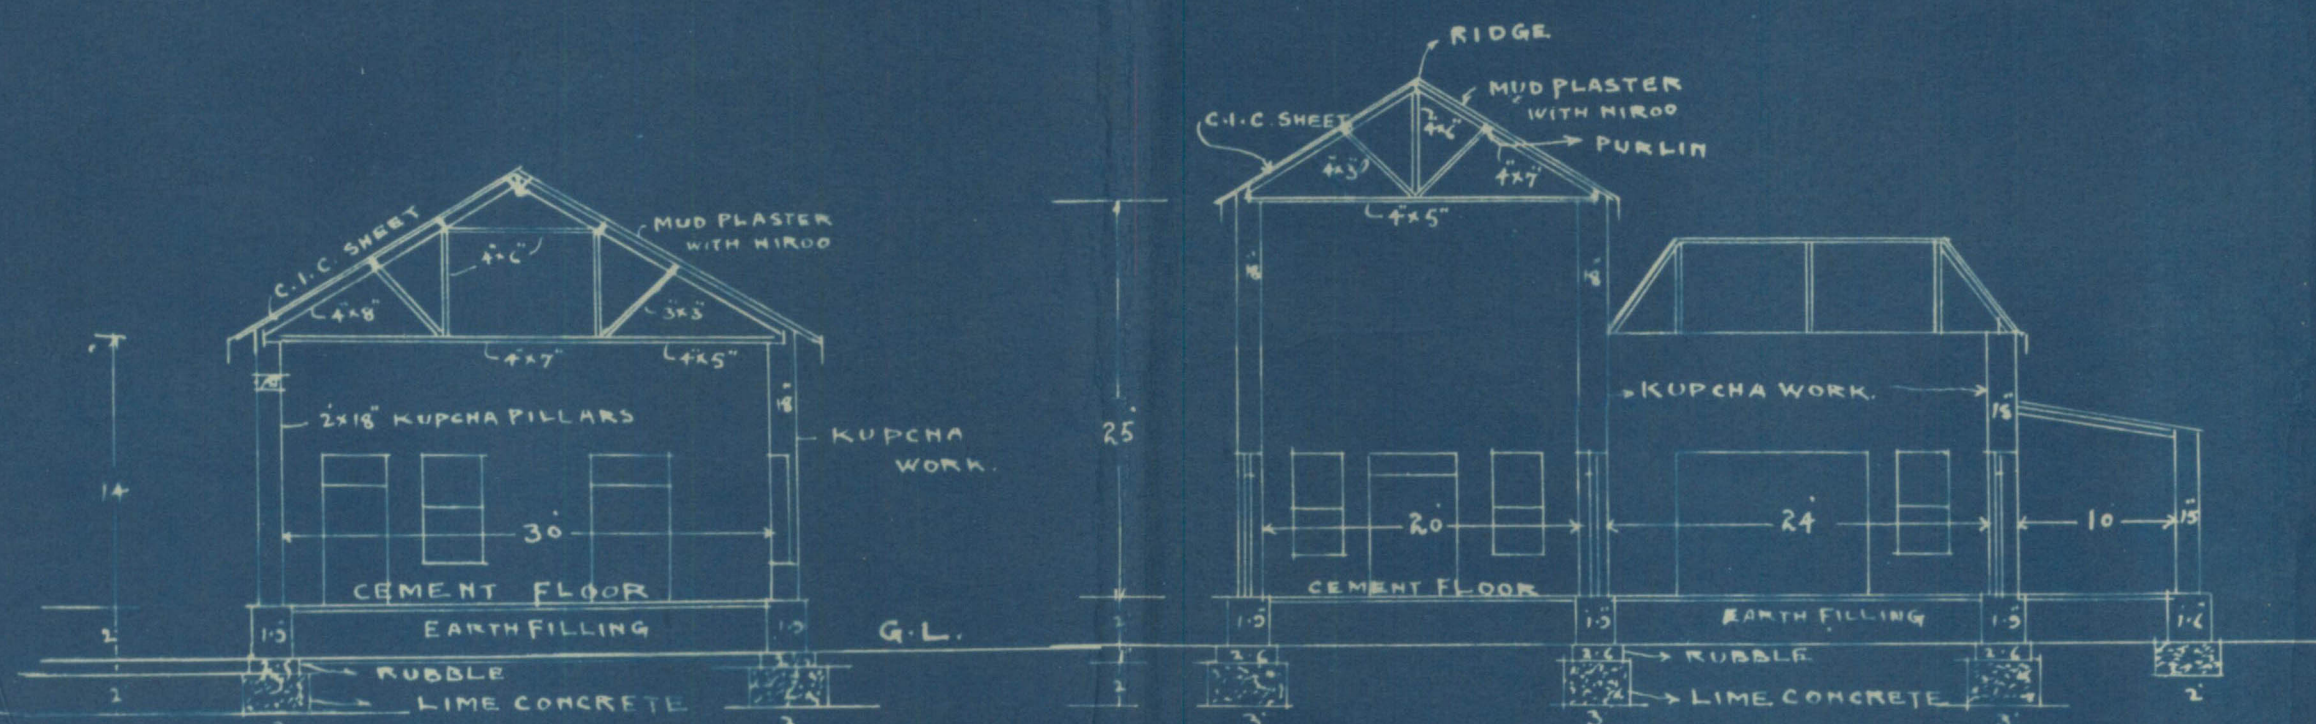


SECTION ON CD.

SECTION ON AB.

SECTION OF COMPOUND WALL.

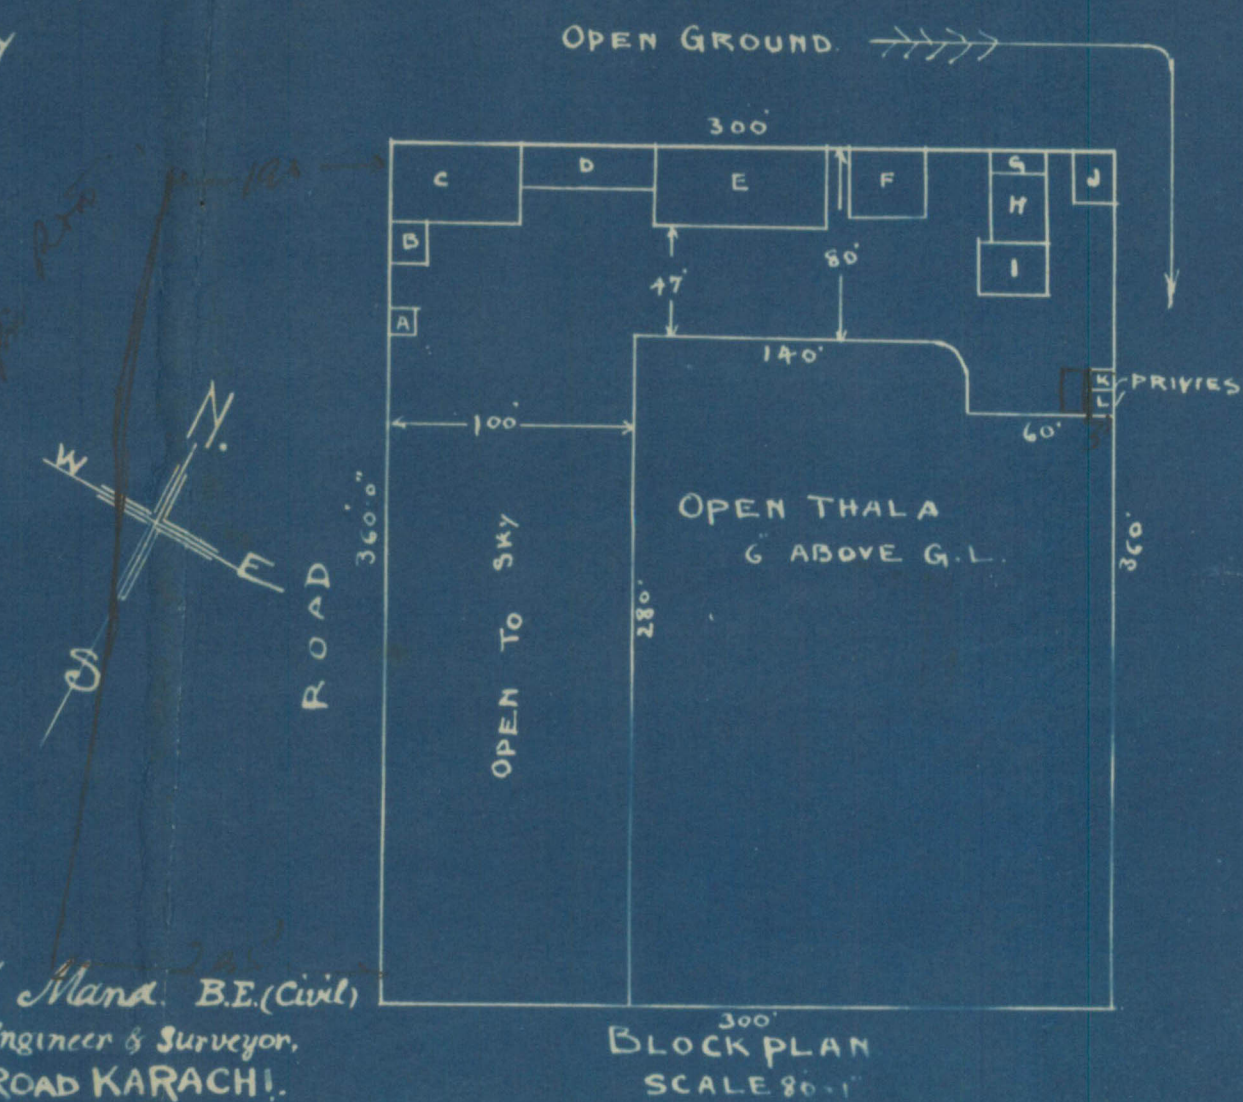

BLOCK PLAN

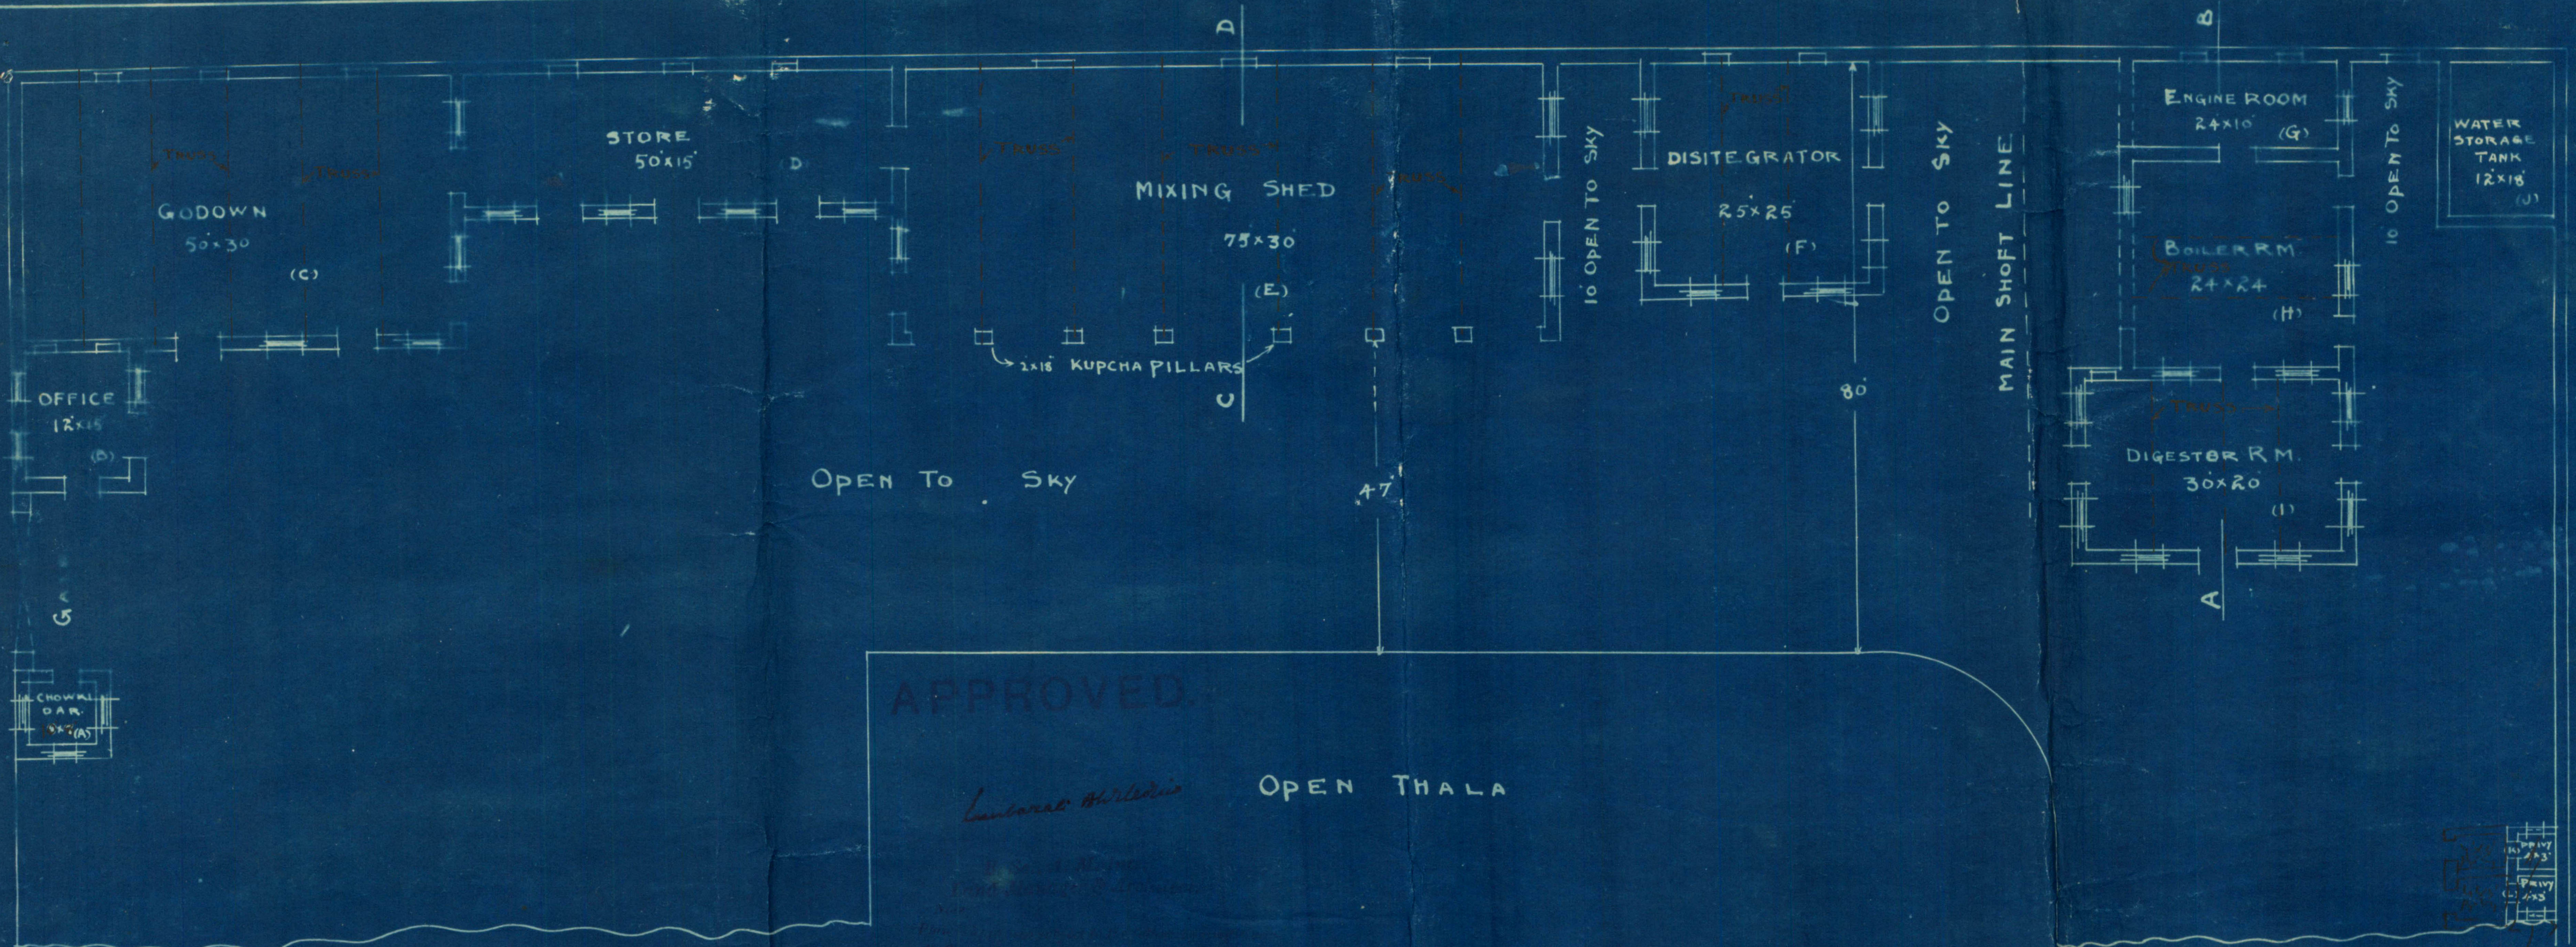


APPROVED.

Lamara Ardesheer


OPEN THALA

Bejoy M. Mana
Architect, Engineer & Surveyor,
BUNDER ROAD KARACHI.

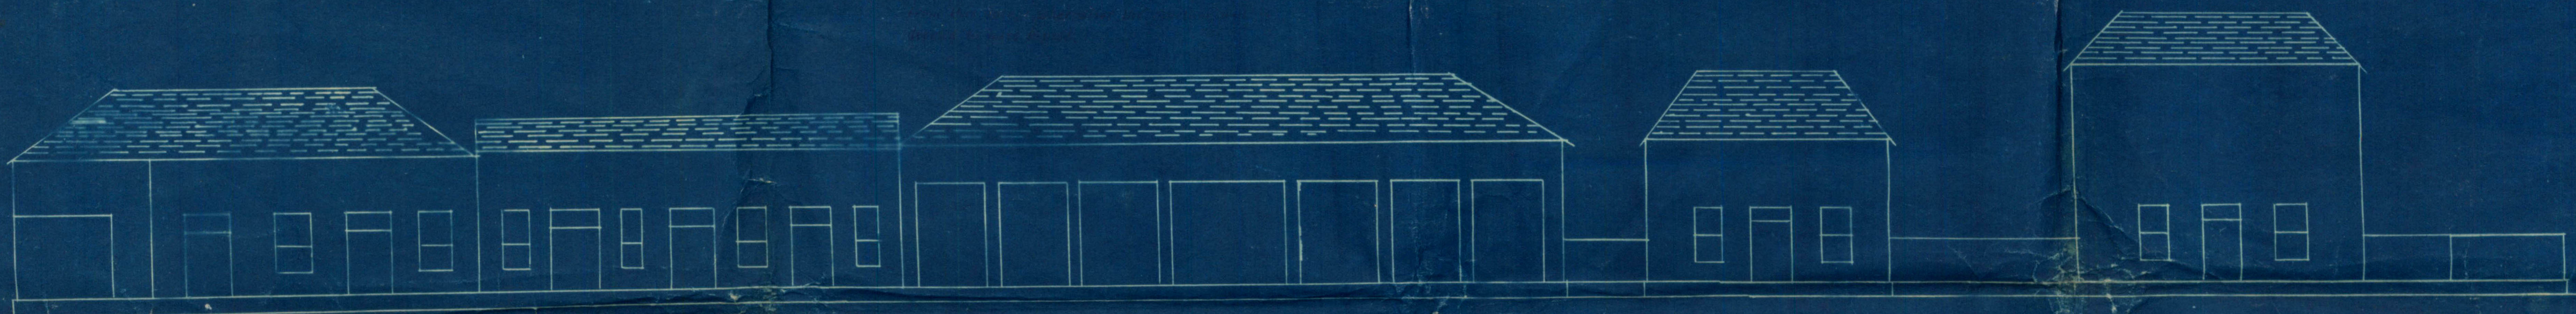

ELEVATION.


PLAN FOR PROPOSED FISH-MANURE FACTORY
ON MANGHA-PIR ROAD
SCALE 1/2" = 1'

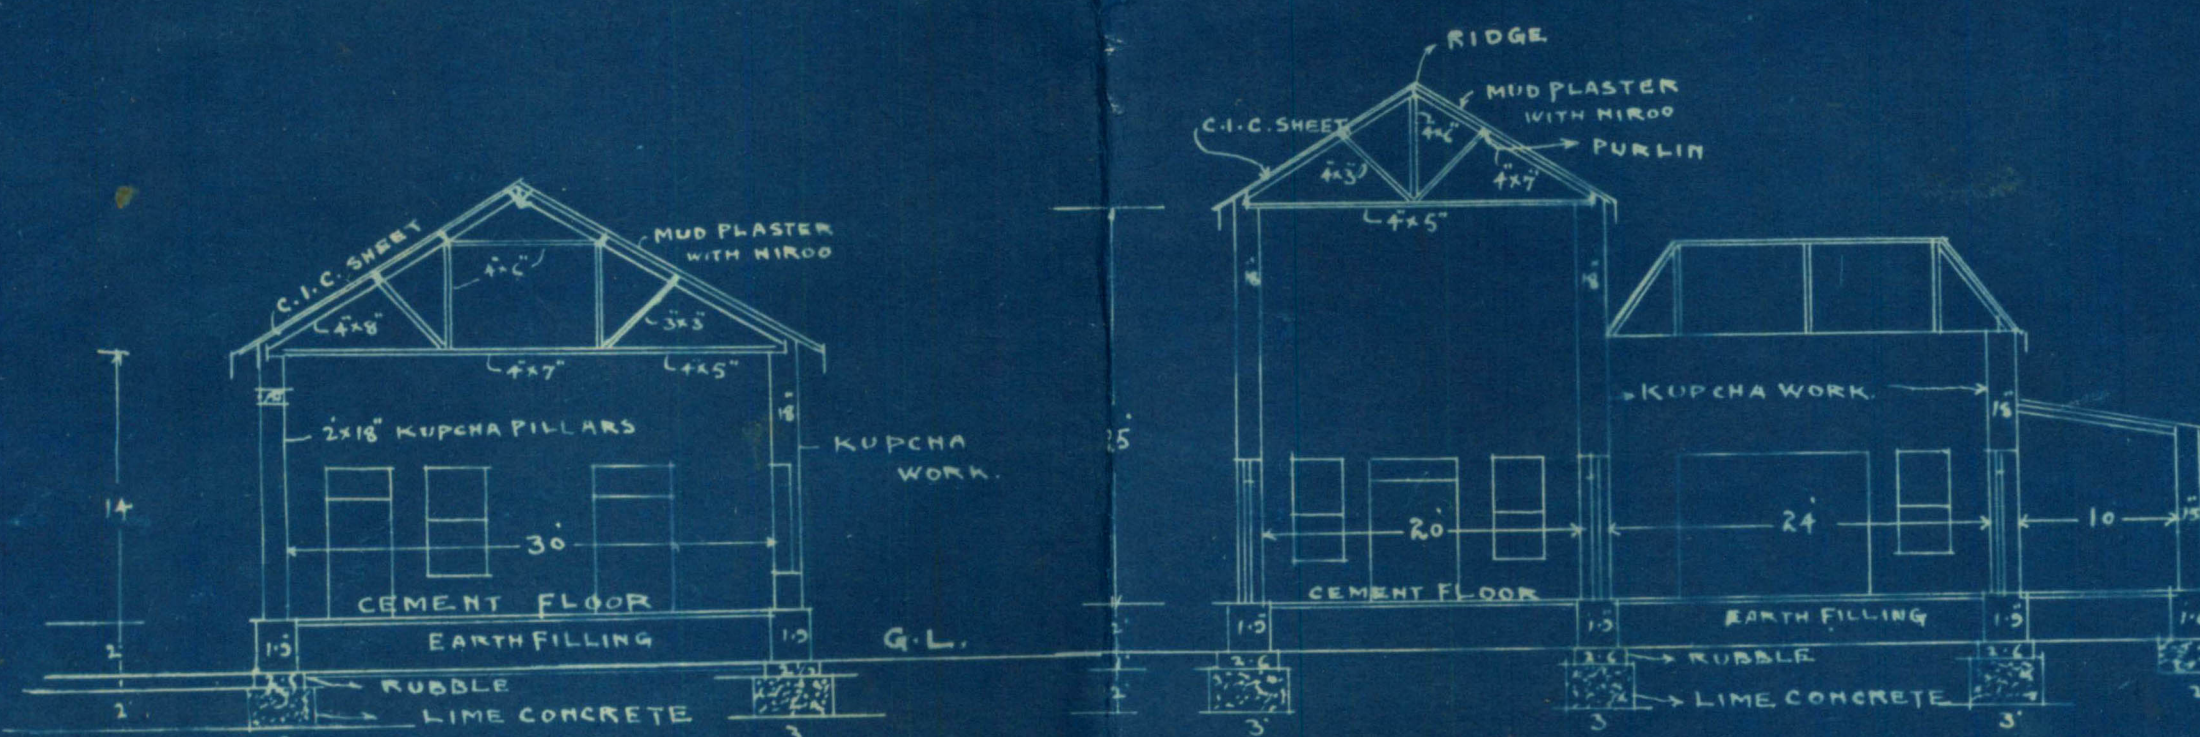

SECTION ON CD.

SECTION ON AB.

SECTION OF COMPOUND WALL.

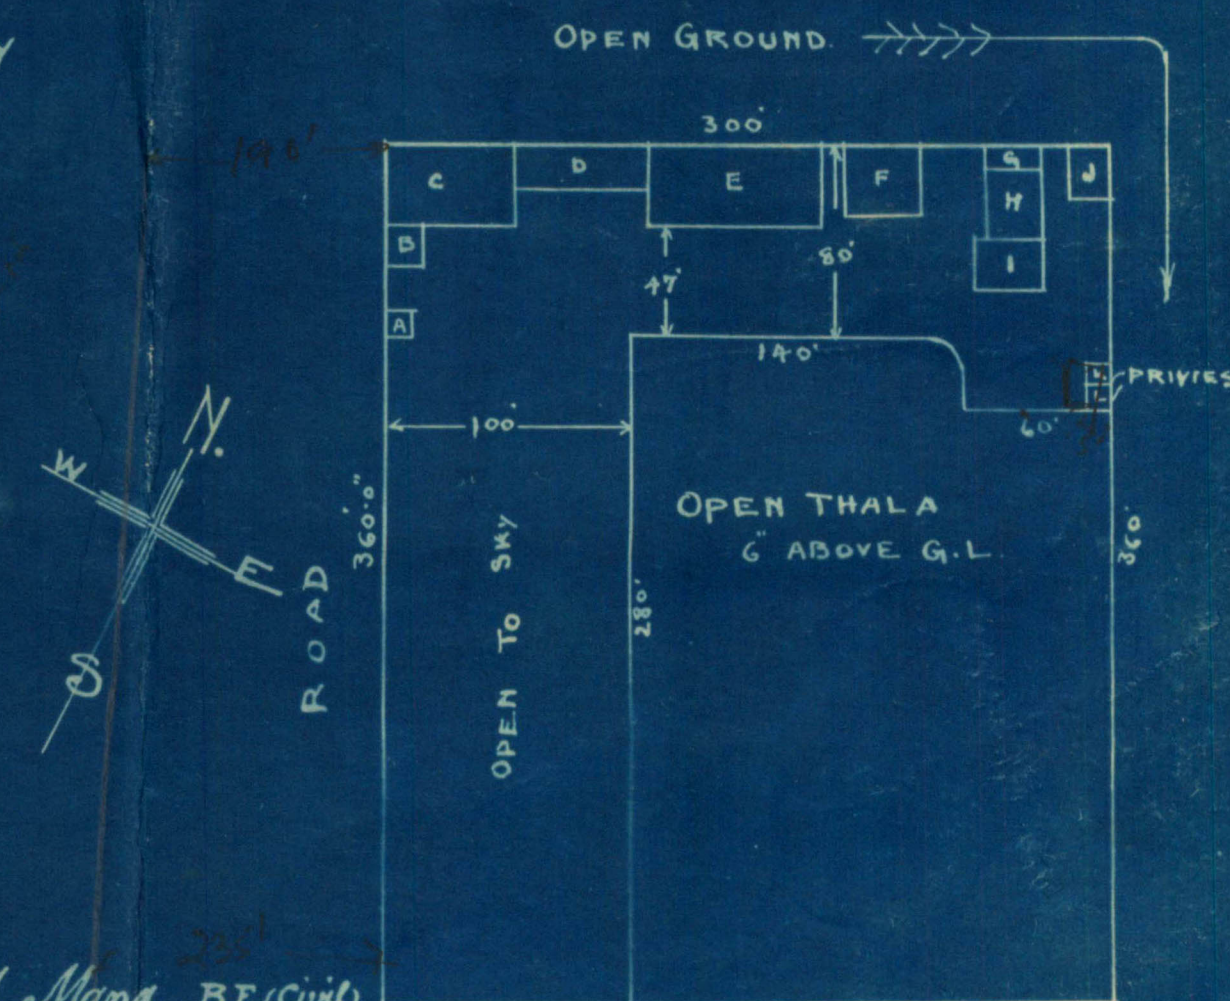

BLOCK PLAN.
SCALE 3/8" = 1'



9

Mr. Kothari

Why should these
mans be sent to C.D.P.
T.P. Dept or to C.D.P.
They have nothing to
do with it. (re)
9/7.

Will this plan go to

Mr. Desai and C.D.P.
L.C. to p. throw light on
the point.

1
77

Pls
5/7/34

346/20

5/11/32

No. B. S. P. 346/34



MUNICIPAL CORPORATION

KARACHI.

16 JUL 1934

From

KUMBERALI BHALEDINO Esq., L.C.E.,

Land Manager & Architect,

ORDER UNDER SCH. VI CHP. XI, RULE 5 (I) OF

ACT XVII OF 1933.

Mrs. Burjor Adeshwari & Co.

40 Mrs. Burjor In Mawla (Architects).
KARACHI.

With reference to your application with plan for building
on plot No. 29th May 1934 Quarter received in this
office on 29th May 1934, I have to inform you that the said plan is
approved and permission to build in accordance therewith is hereby granted.
The building must be erected in conformity with the Bye-laws and rules of
the Karachi Municipal Corporation.

A copy of approved plan is attached herewith.

Kumberali Bhaleddino
Land Manager & Architect,
Karachi Municipal Corporation.

NOTICE, 1 :—This sanction holds good, provided the work of constuction is
commenced in earnest within a year form this date, whereafter the sanction will be
deemed to have lapsed.

NOTICE, 2 :—This sanction does not entitle the owner to build on land not
conveyed to him either by the Government or the Municipality by a Sand or entry
in a Sand.

NOTICE 3 :—This pass does not give premission to occupy Municipal land with
building materials. This can only be allowed when the Street is wide enough to
permit building materials being deposited on it without it being a source of danger to
the public and only then on a hoarding being placed round the land to be occupied
and on payment in advance, of fees for occupation of Municipal land, at the following
rates.

(1) For first 12 weeks, per square yard per diem	...	Rs. 0	0	3 1/4
(2) For the next 12 weeks, " "	...	"	0	0 7
(3) For any subsequent time " "	...	"	0	1 2

NOTICE, 4 :—Windows, steps and doors of the building will not be permitted to
project on or overhang public street or Municipal land.

NOTICE, 5 :—Plinth cornice will not be allowed to projcet more than 2 inches
on any Public street for ornametal purposes.

NOTICE, 6 :—You are required to give timely intimation to the Land Manager
and Architect before filling in the foundation and before concrete is filled in for Re
inforced concrete work.

NOTICE, 7 :—In case of set back or set forward, the first course of Plinths must
be laid after the line is checked by the Land Surveyor.