


GROUND FLOOR PLAN

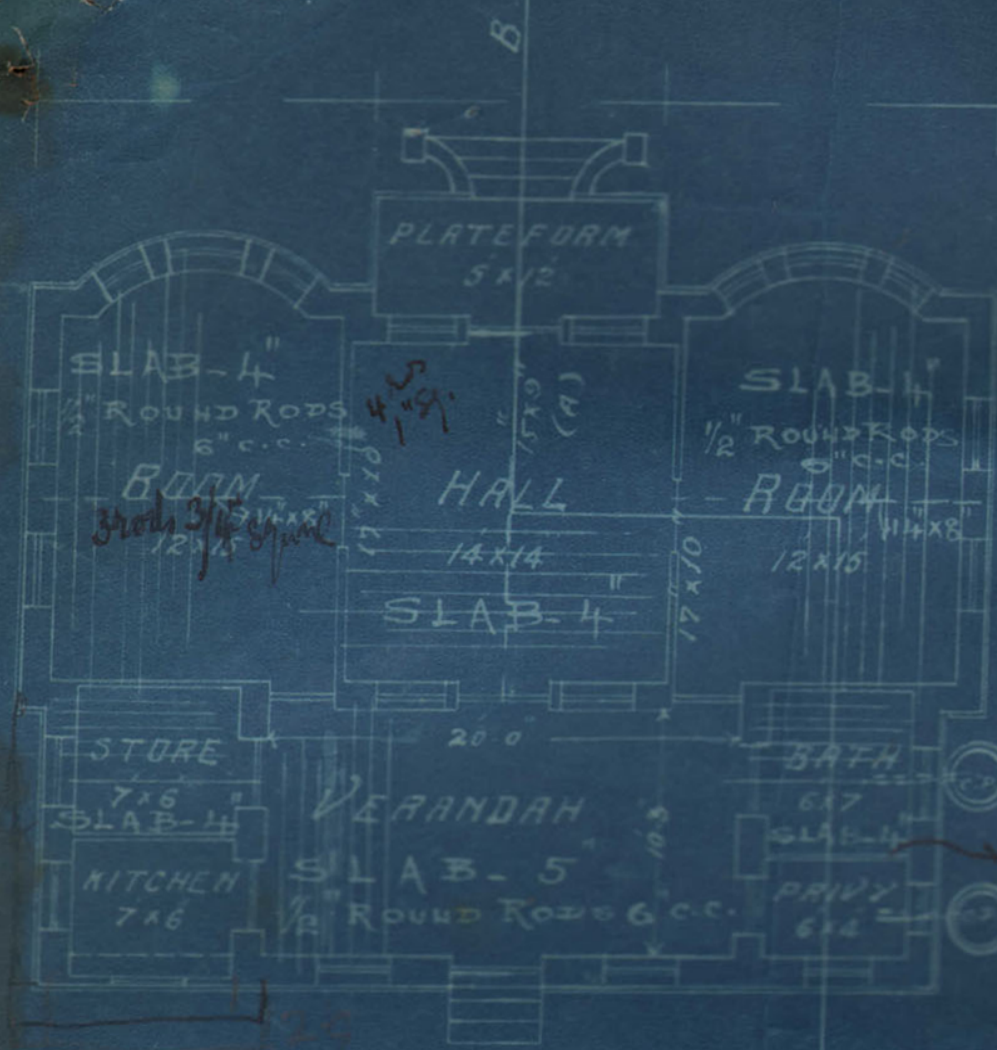

SECTION ON A-B.



EAST ELEVATION



LEVEL

SHOWING PROPOSED BUNGALOW
ON PLOT NO. 17 SHEET NO.

FOR
"THE COSMOPOLITAN CO-OPERATIVE
HOUSING SOCIETY LTD."

SCALE: 8' = 1"

APPROVED.


B. Sc., A. M. Inst. C. E.,
B. Sc., A. M. Inst. C. E.,
B. Sc., A. M. Inst. C. E.,

DURGA B. ADWARI & CO.
ARCHT. & SURVEYORS.


13-12-27.

NOTE: Heritance
TOTAL AREA OF PLOT: 1000 SQ YDS
BUILT AREA: 128 " "

LONGITUDINAL SECTION OF T.BEAM A (15x9")

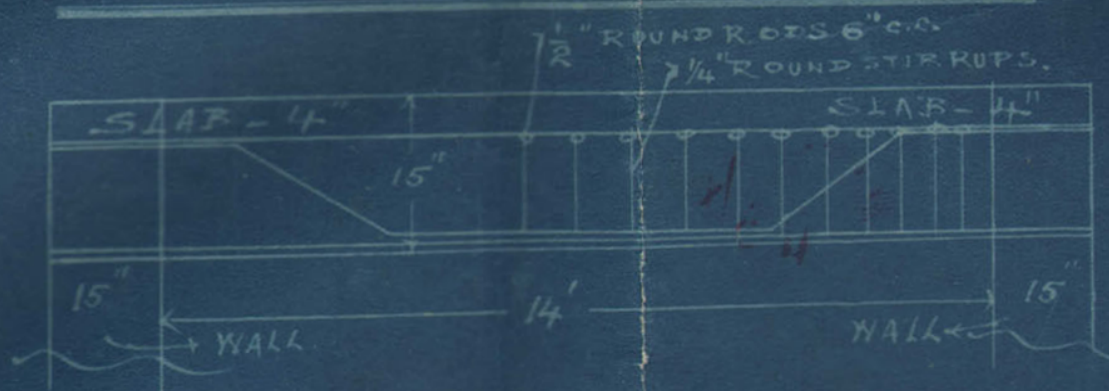


CROSS SECTION OF T.BEAM A (15x9")

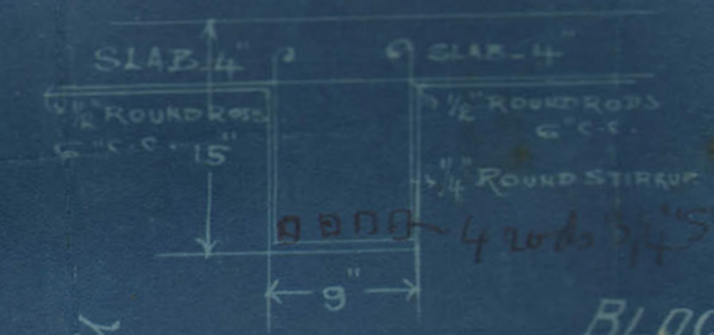

SECTION OF COMP.WALL.

SCALE: 4' = 1"

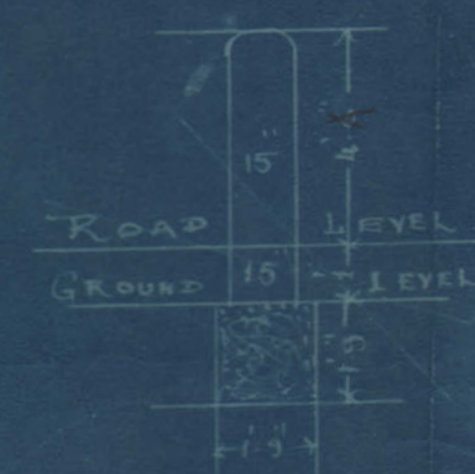

BLOCK PLAN

SCALE 20-1

