

No 33A

— PROPOSED BUILDING —

— ON —


— SITE PLAN —

— SCALE 20 FEET TO AN INCH —


— PLOT No 38 AND 38-B SHEET No G-2 —

— SUDDER BAZAR QUARTERS —

— SCALE 8 FT TO AN INCH —

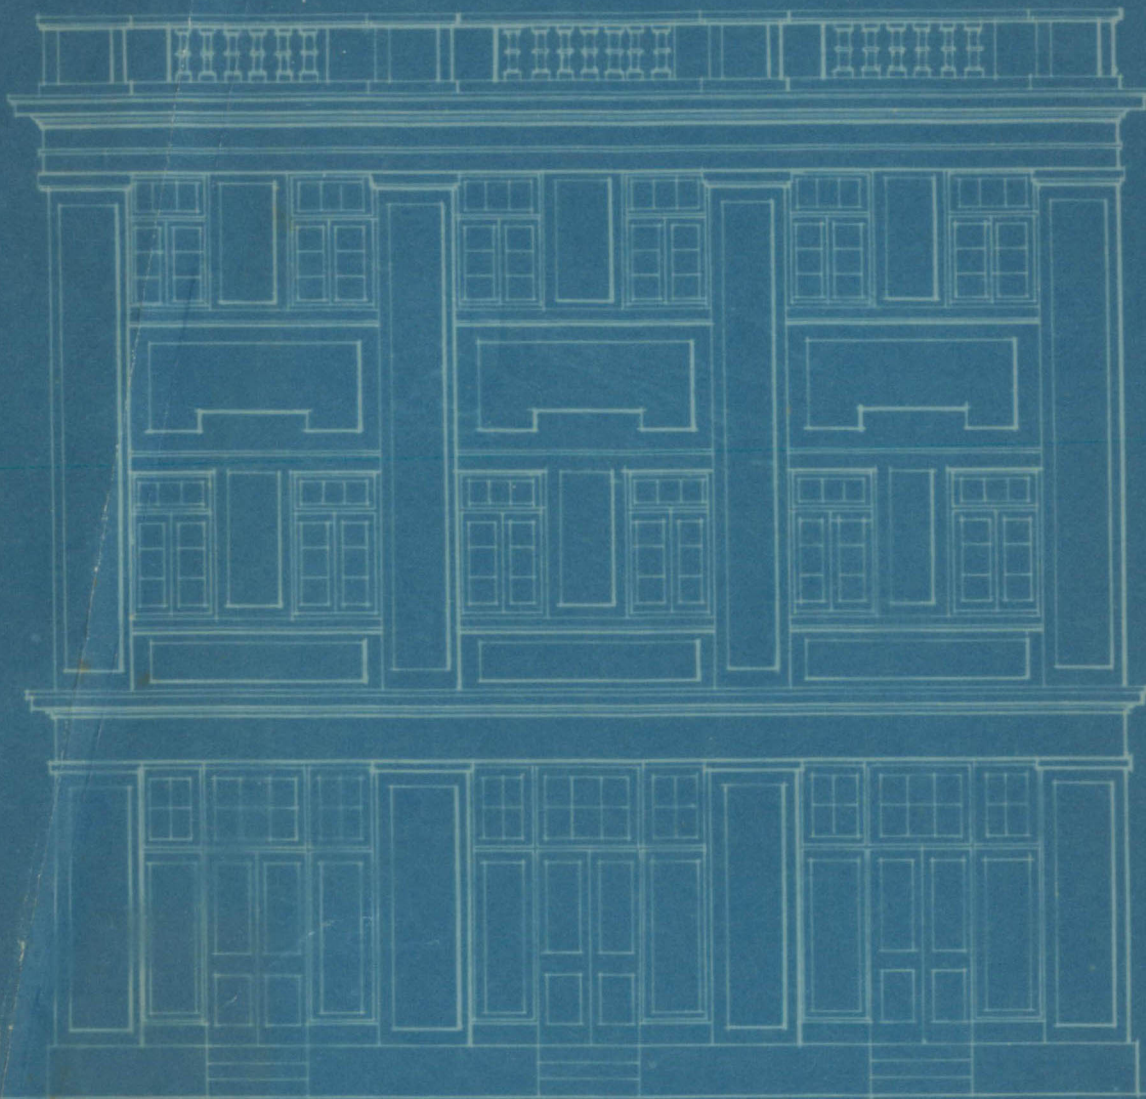

— FRONT ELEVATION —

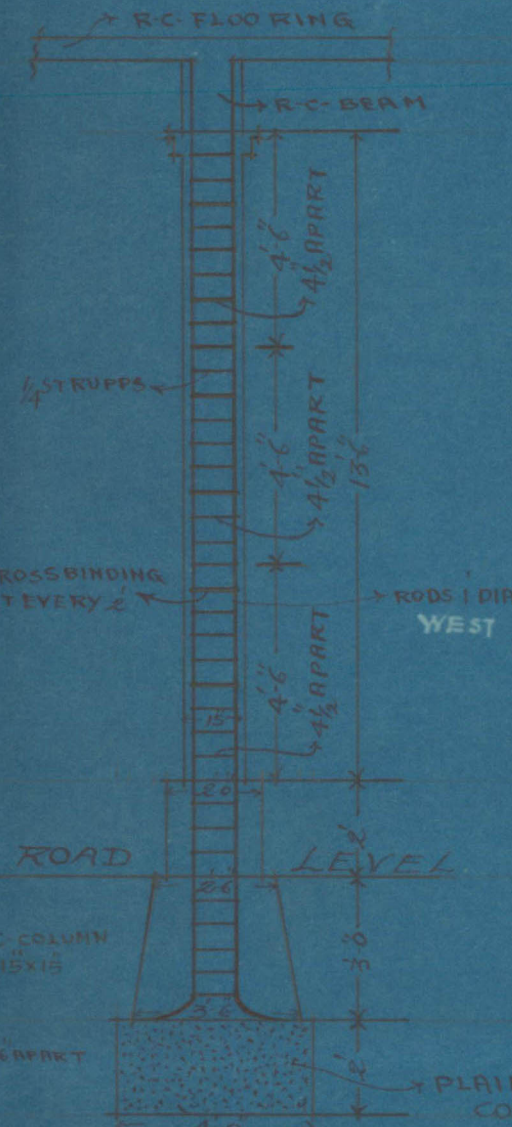

— SECTION —

PLOT No 38-A
BUILDING ABOUT 15 HIGH


PLOT No 38-B

DELETED.
PLOT No 38


OPEN PLOT

NAPIER STREET

SOUTH

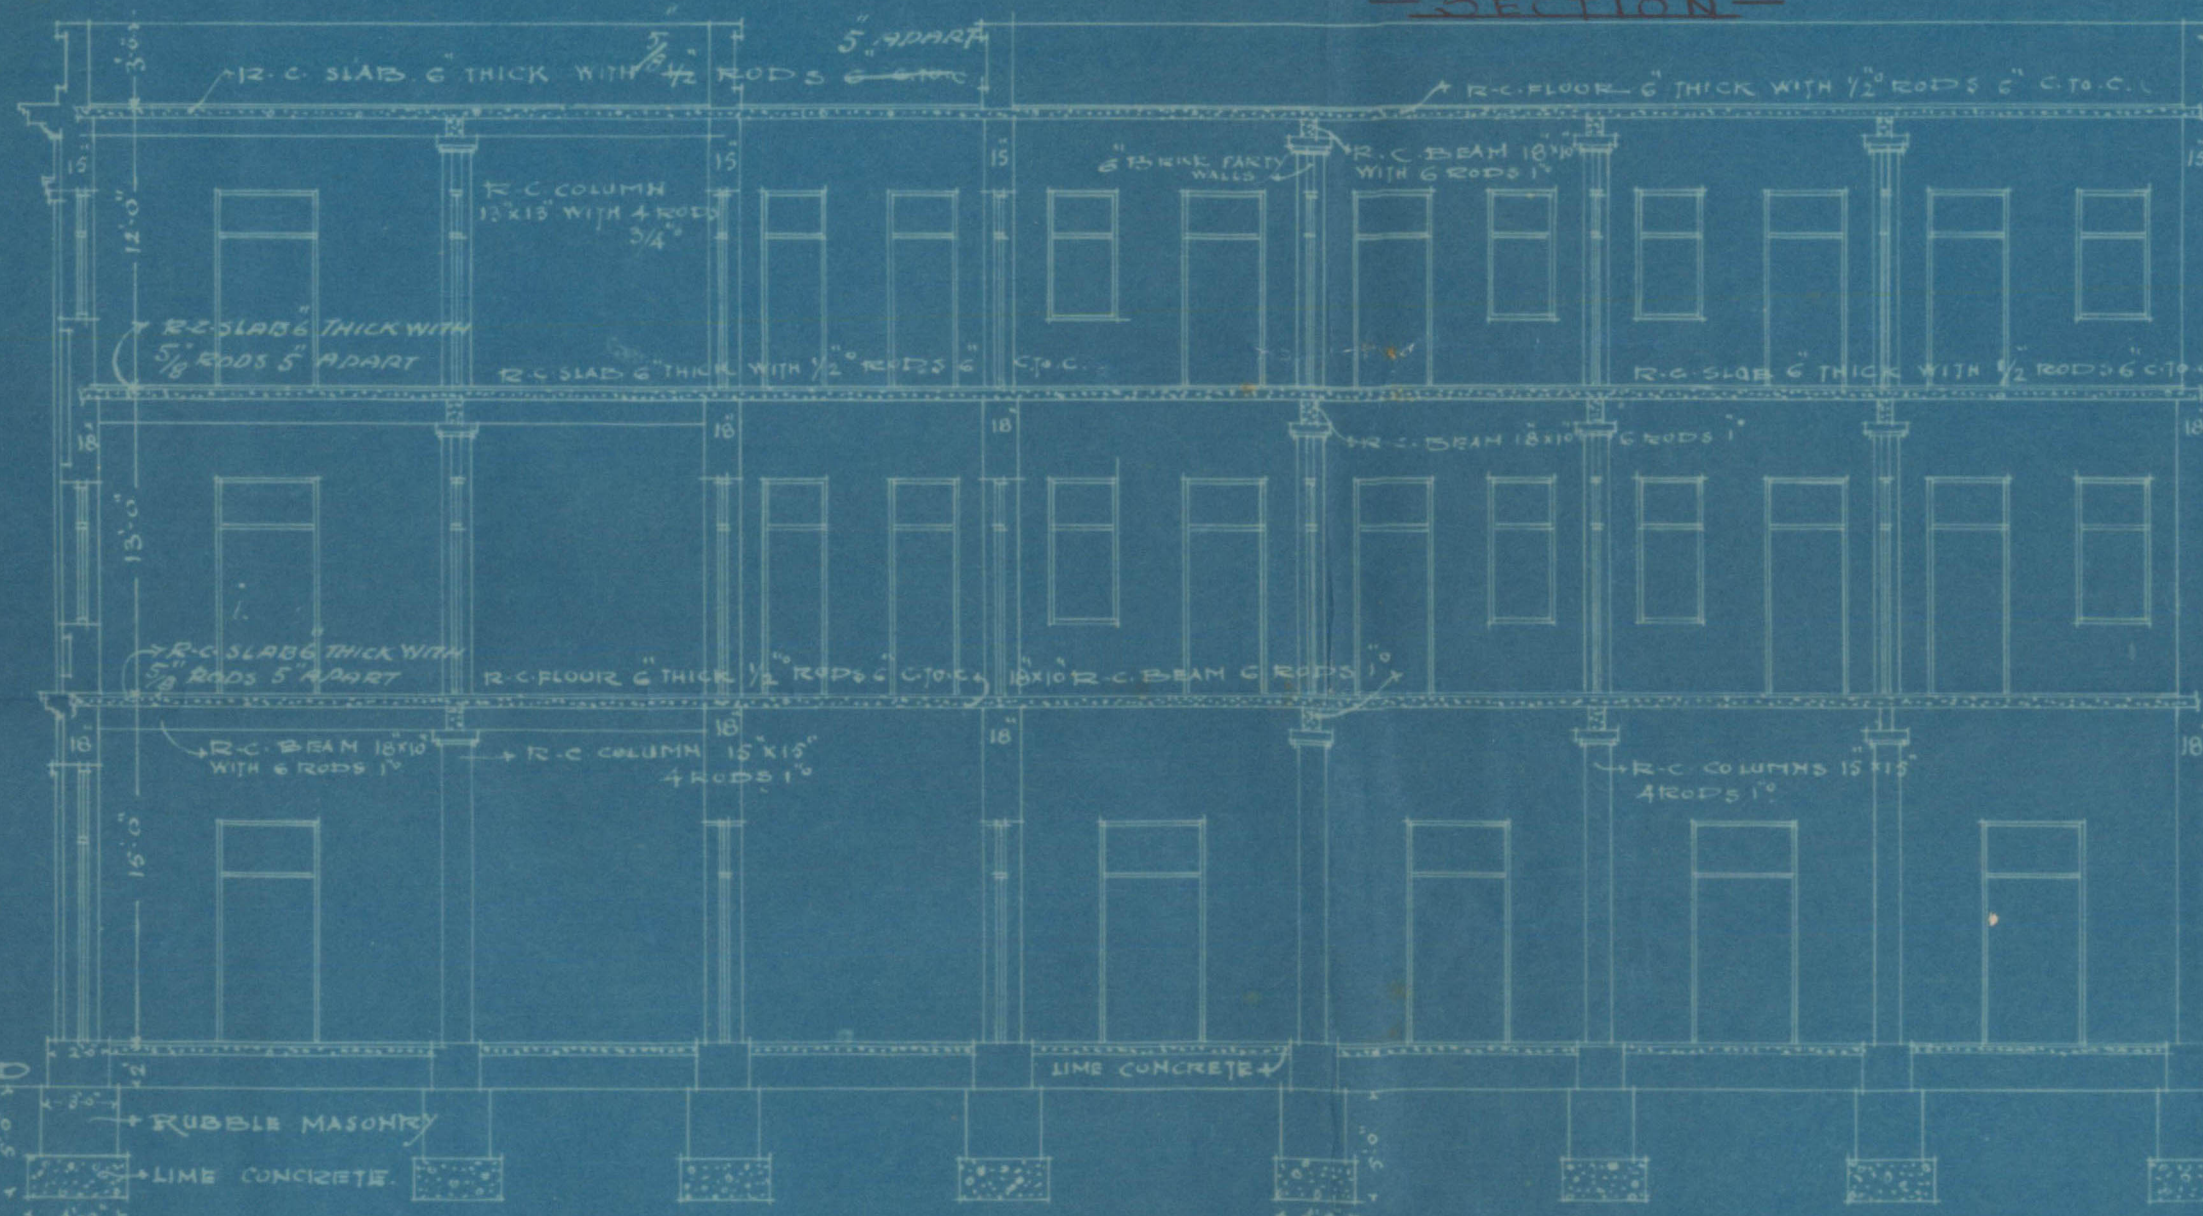


— SECTION ON LINE A-B —

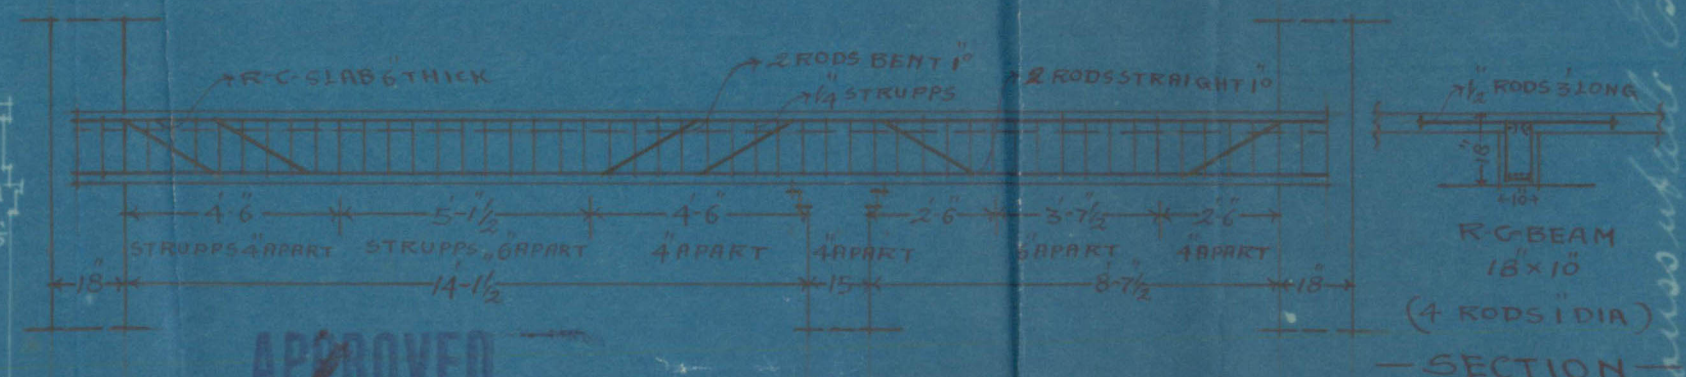


— SECTION —

APPROVED

Executive Engineer
Karachi Municipality

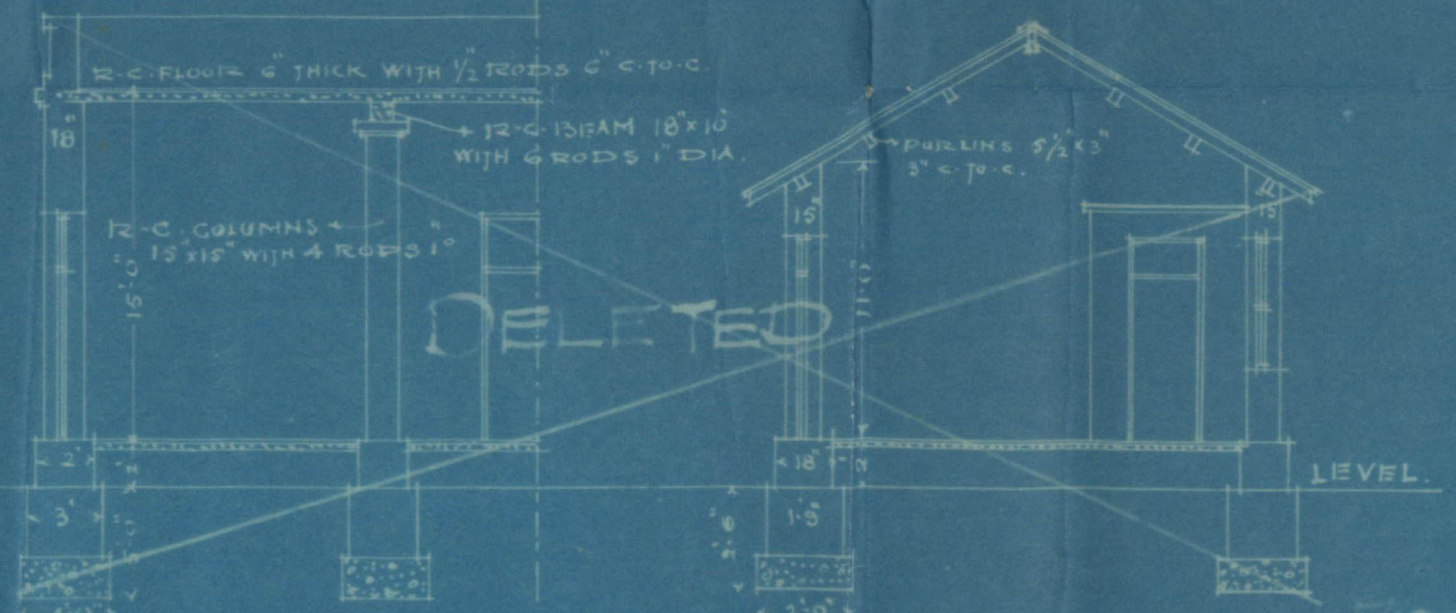


MISTRI AND BHEEDWAR
P. A. S. L. C. E. S.
ARCHITECTS AND ENGINEERS

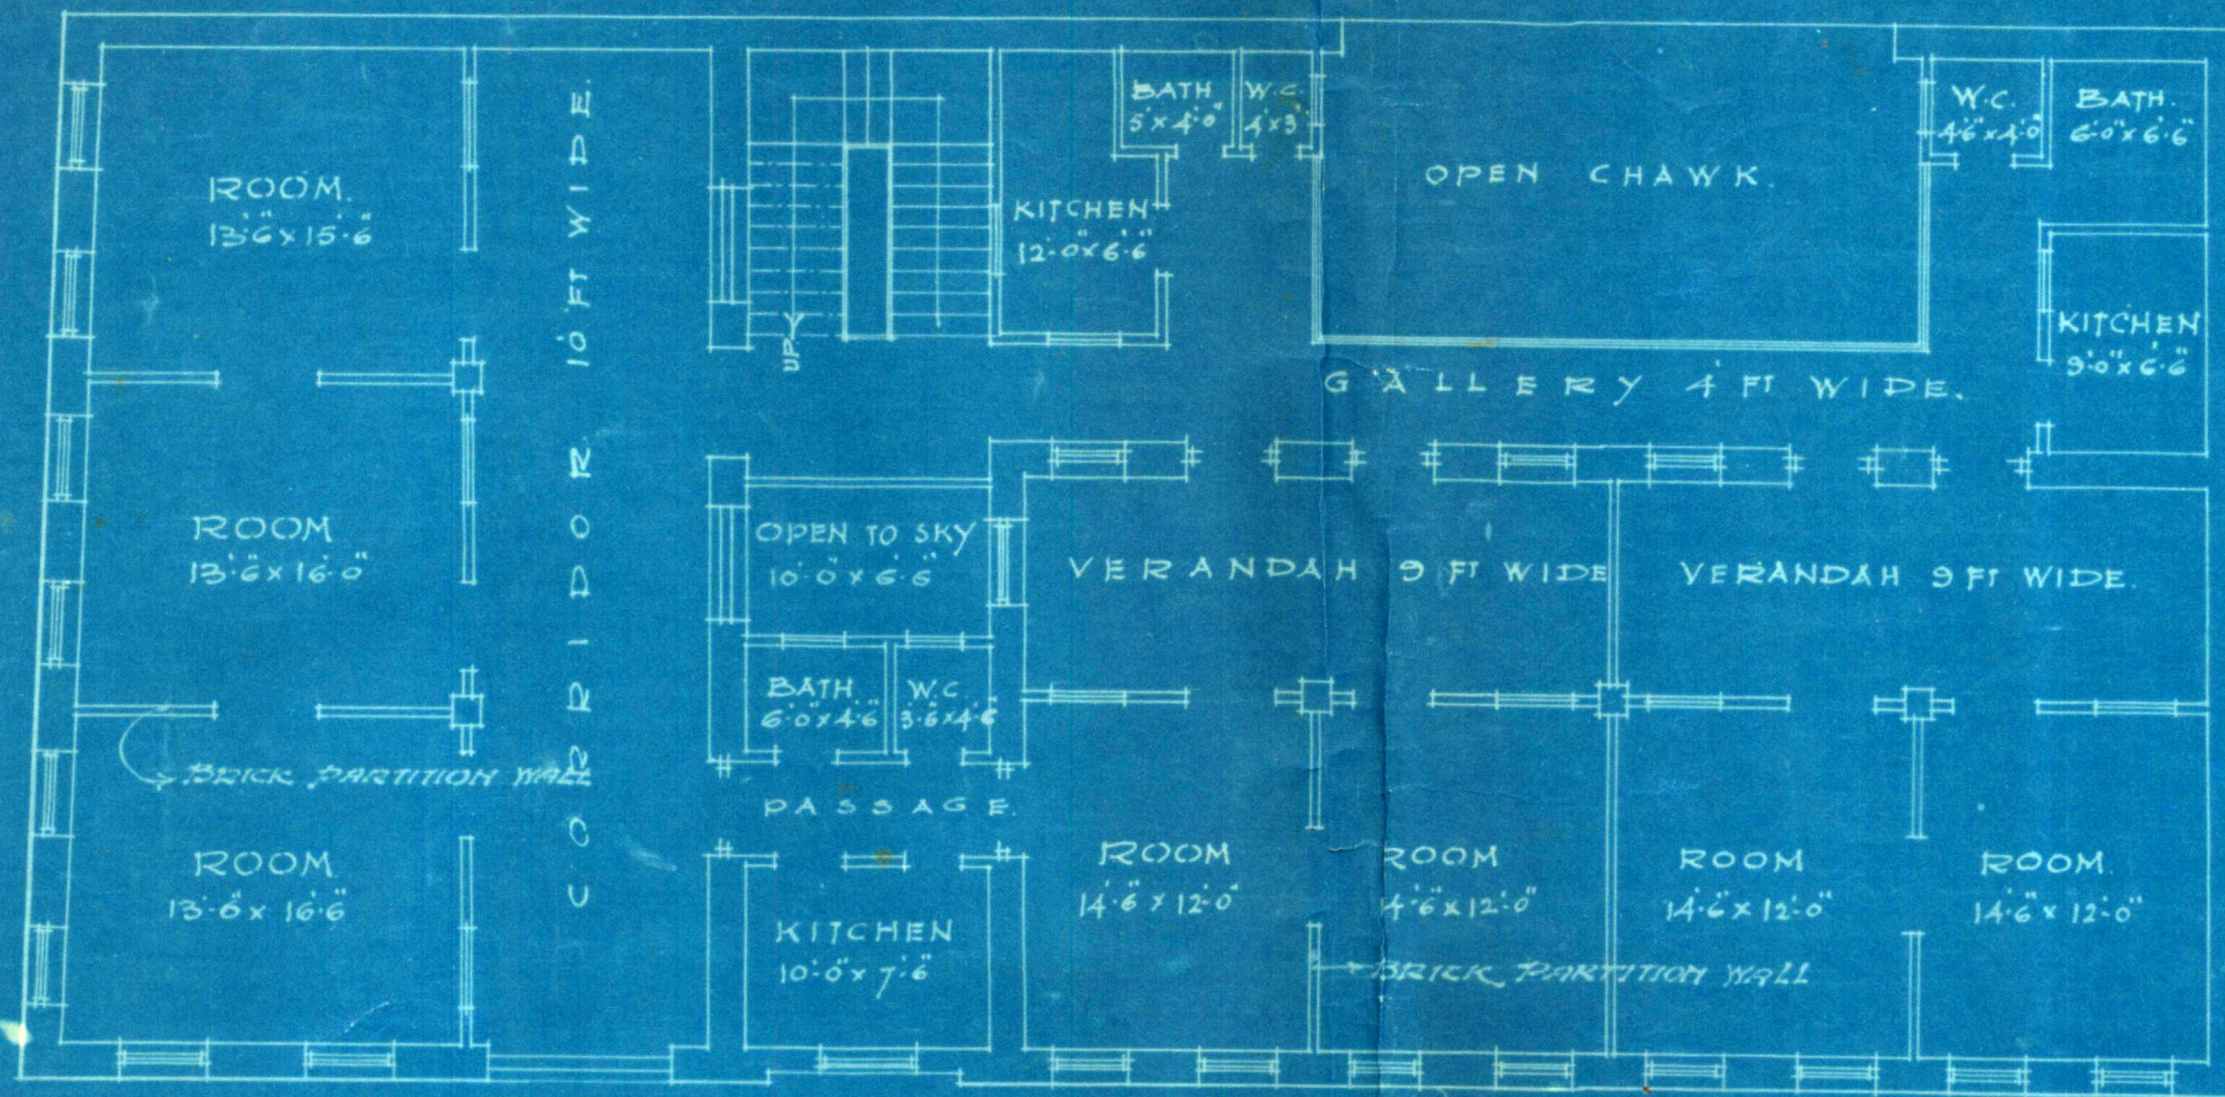

PLAN OF FIRST & SECOND FLOORS

APPROVED


Karnachi Municipality

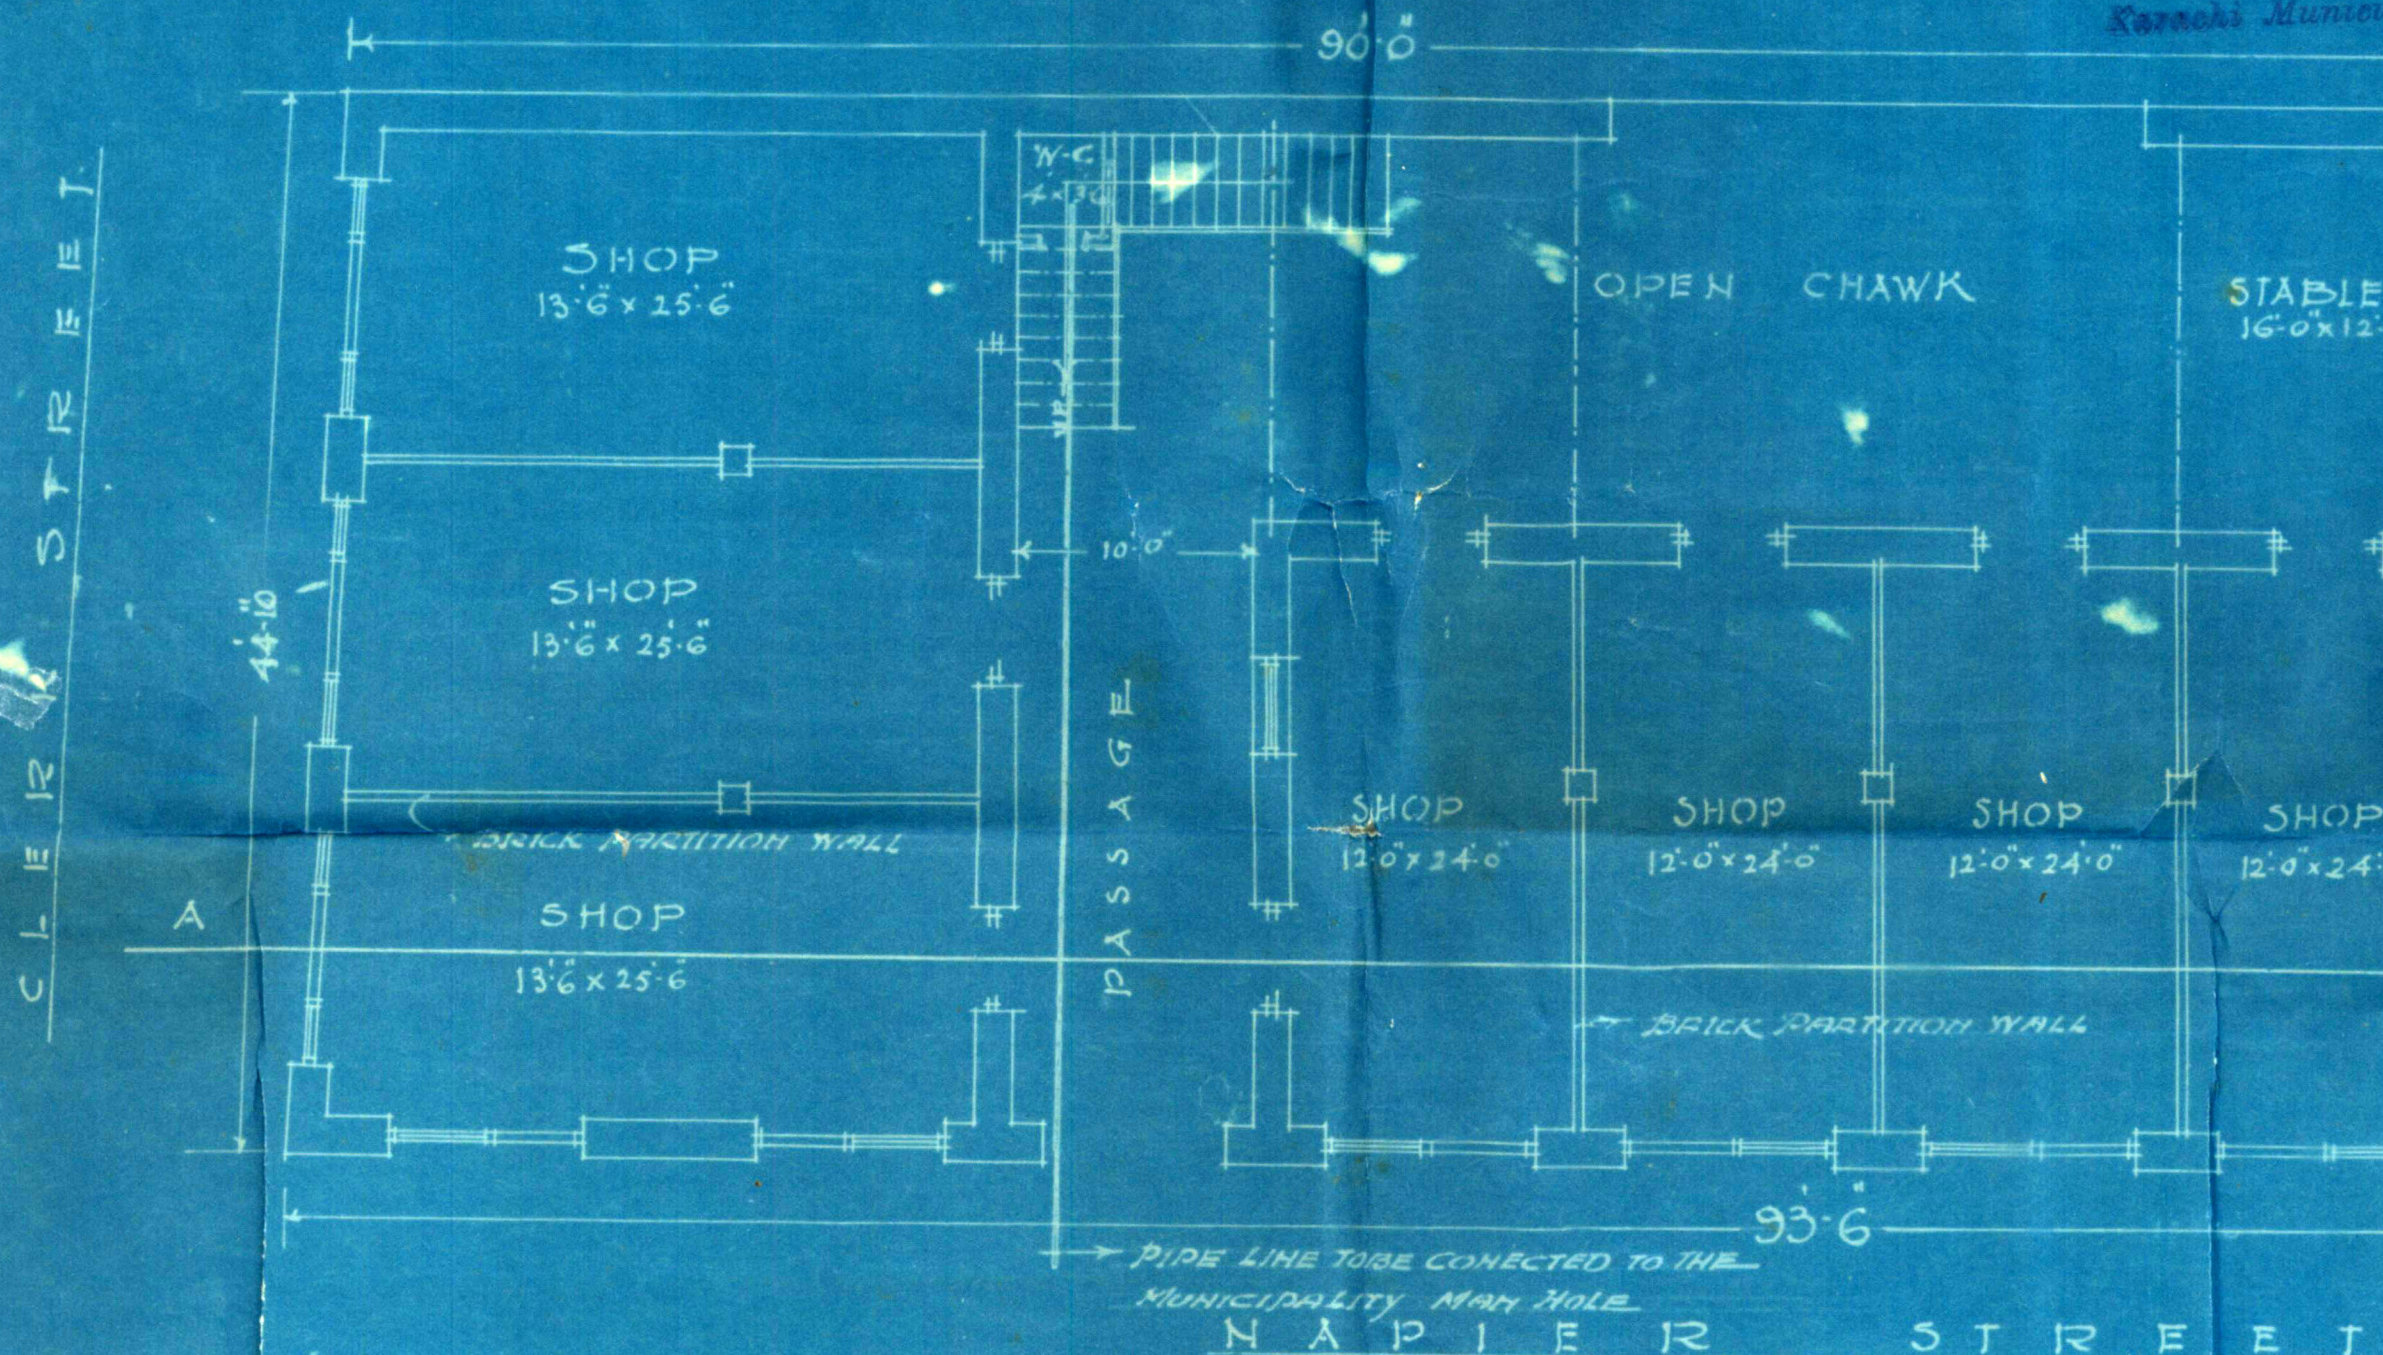

PLAN OF GROUND FLOOR

PROPOSED BUILDING
ON
PLOT NO 38 AND 38-B SHEET NO G-2
SUDDER BAZAR QUARTER

SCALE 8 FT. TO AN INCH

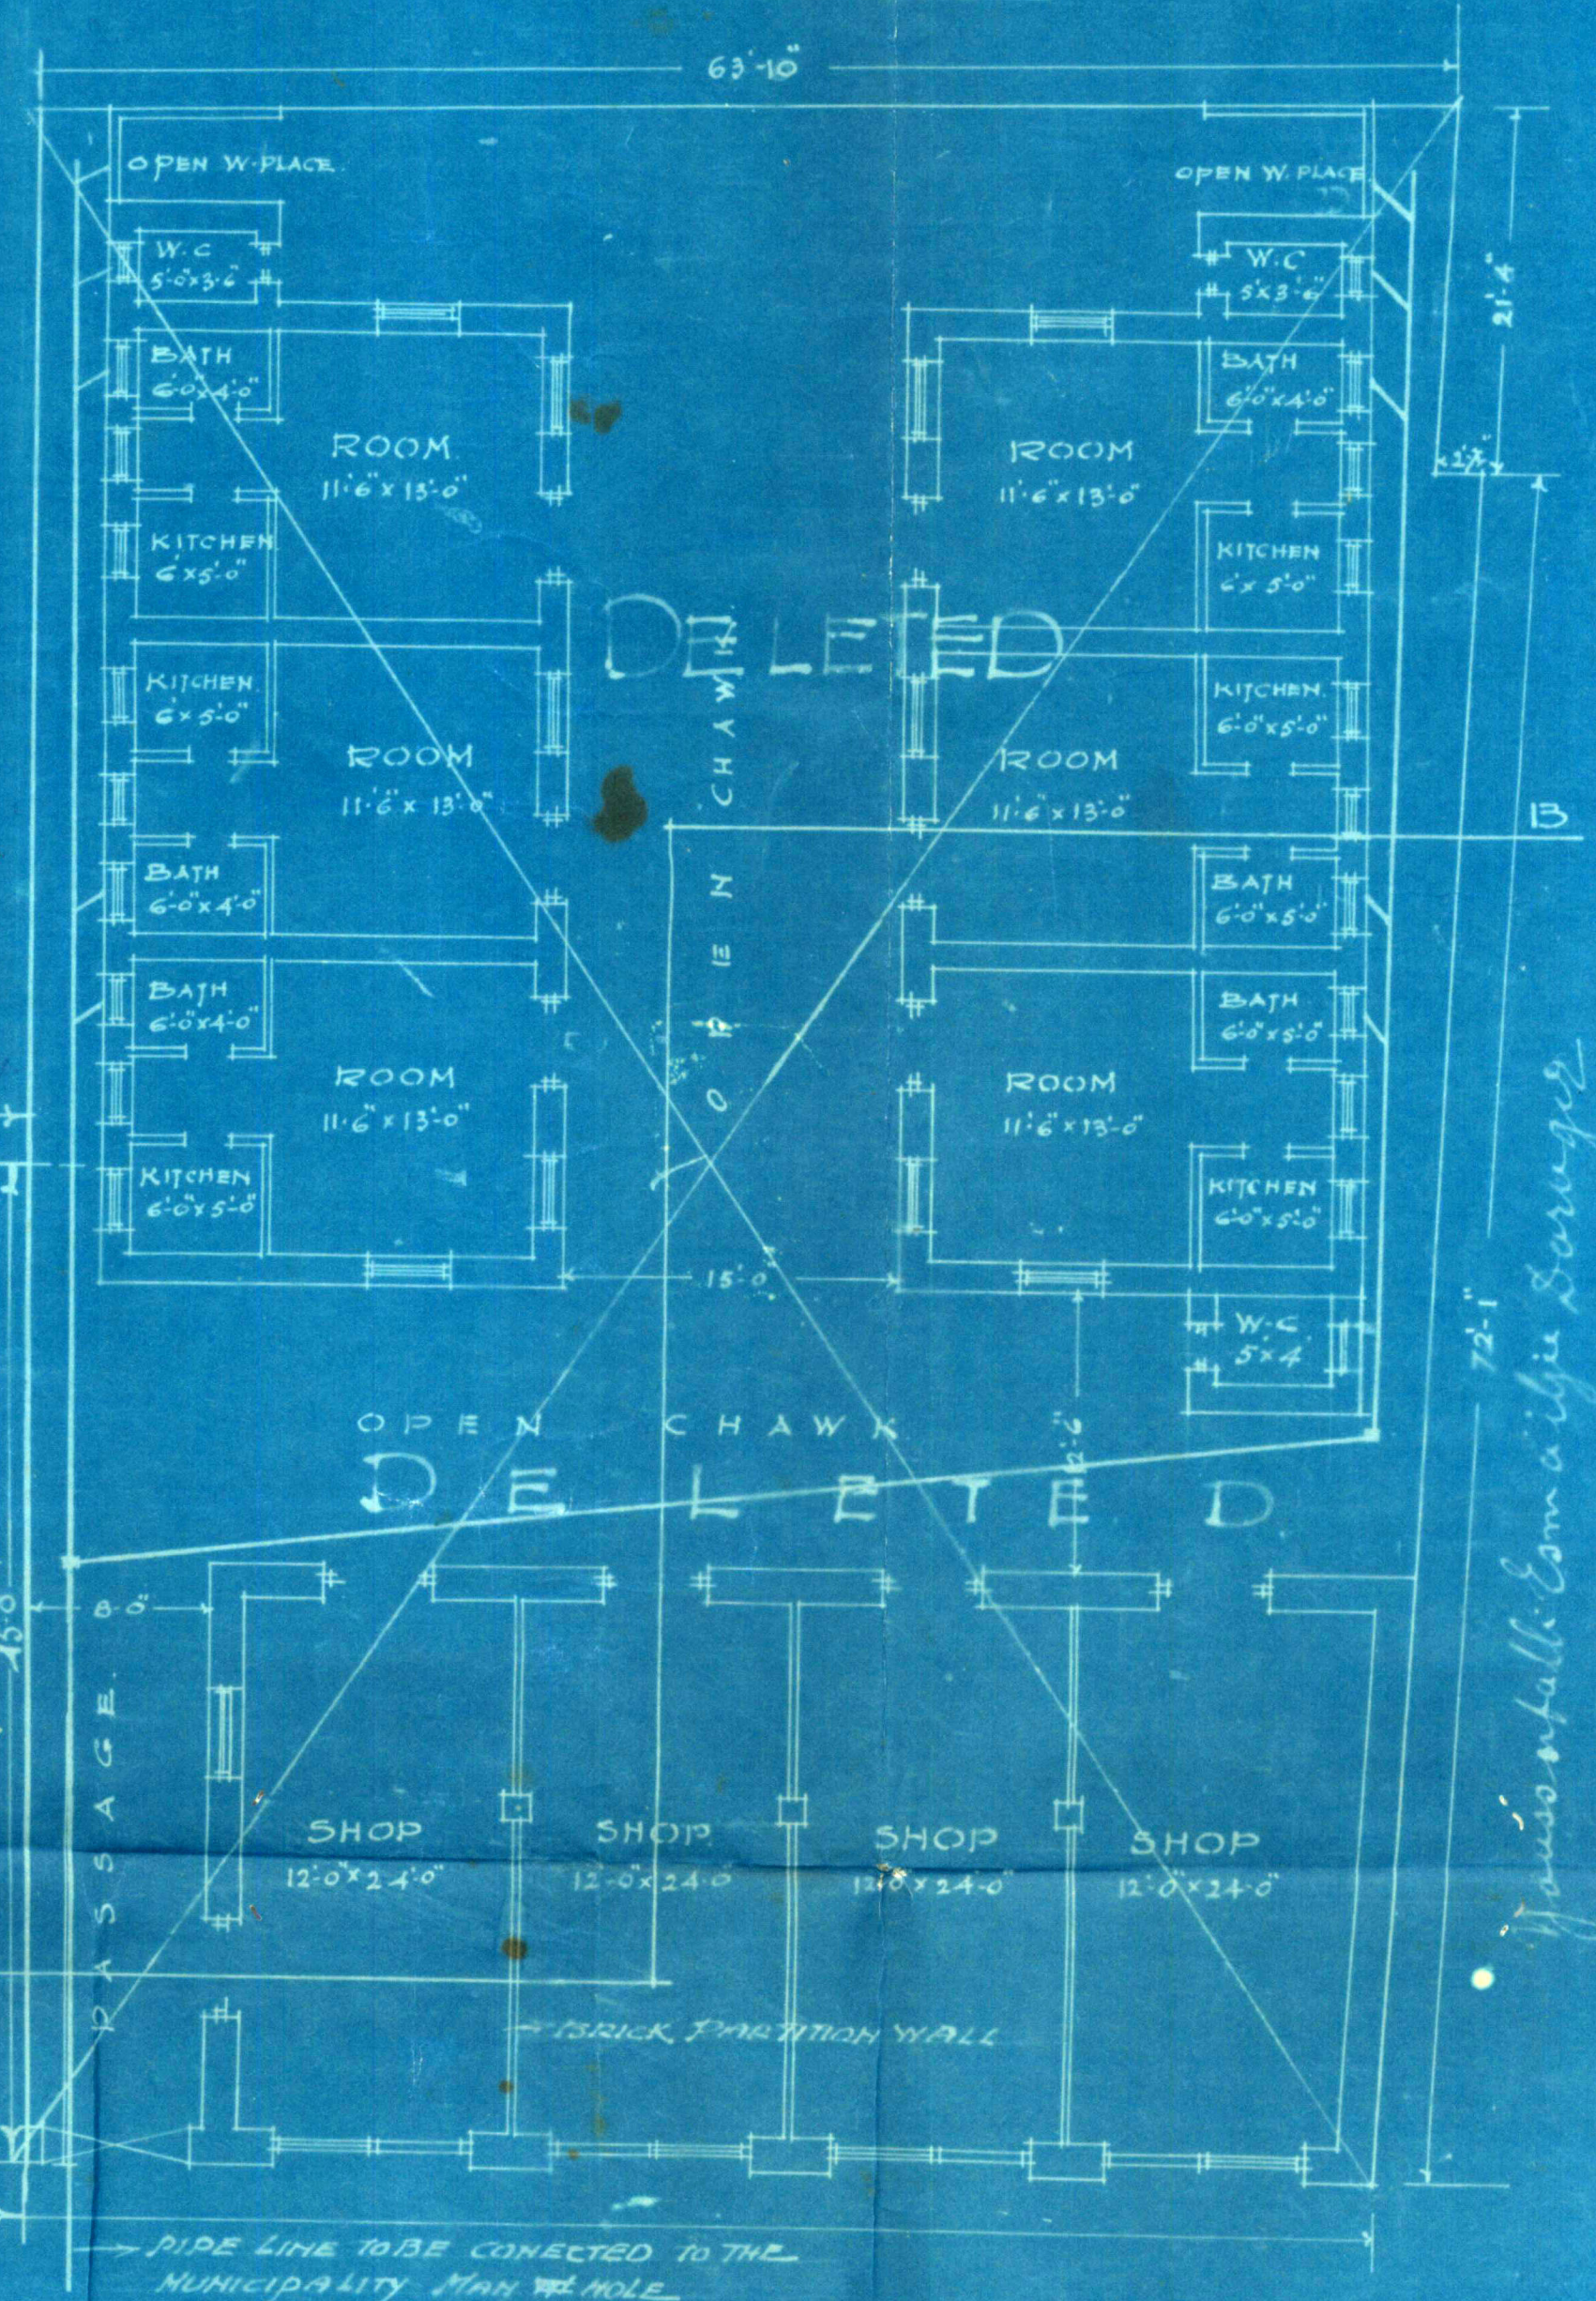

MISTRI C. SHEDWAL
B.A.S.L.C.E.S.
ARCHITECTS & ENGINEERS