

AMENDED
PLAN SHOWING PROPOSED BATHING GHAT.
ON PLOT NO 54 SHEET A.9.


AMENDED PLAN.

72

OLD TOWN Q.R.

SCALE 8-1"

M. Nazareth
22-8-18

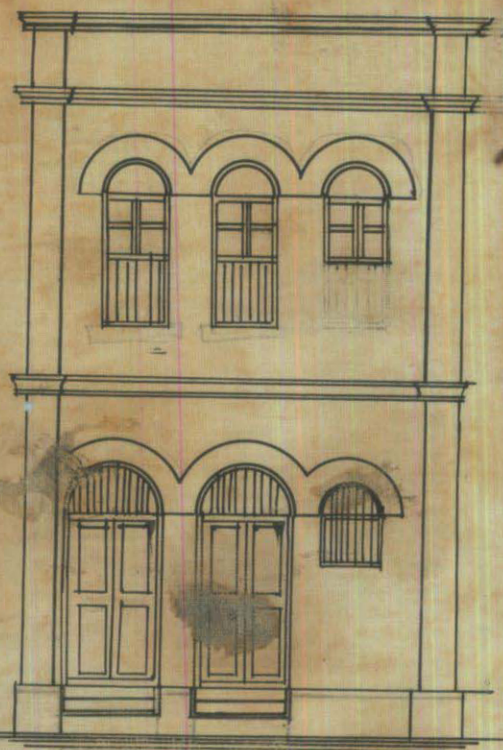

NORTH ELEVATION.


APPROVED.

L. G. L. Verley


L. G. L. Verley, O.E.

Engineer,

Karachi Municipality.

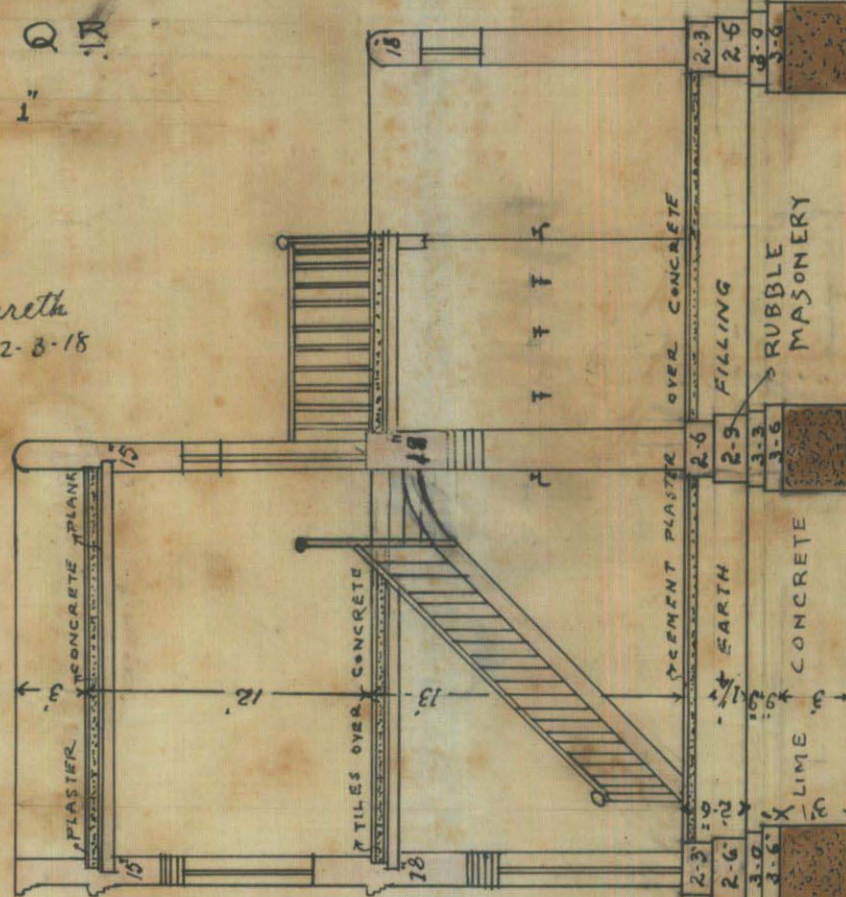


SECTION ON A.B.

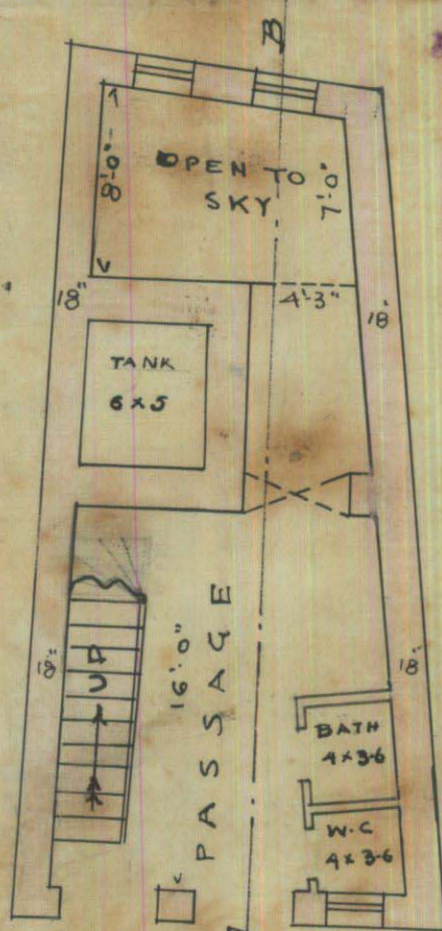


GROUND PLAN

PERMANAND LANE.

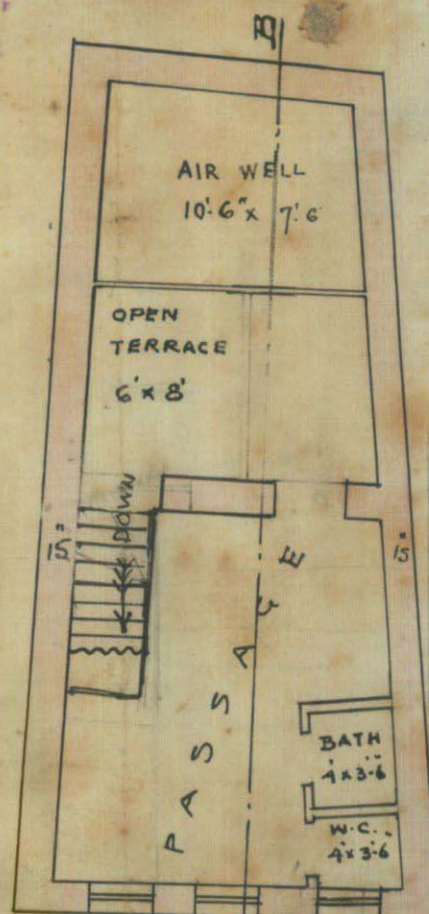

FIRST FLOOR PLAN

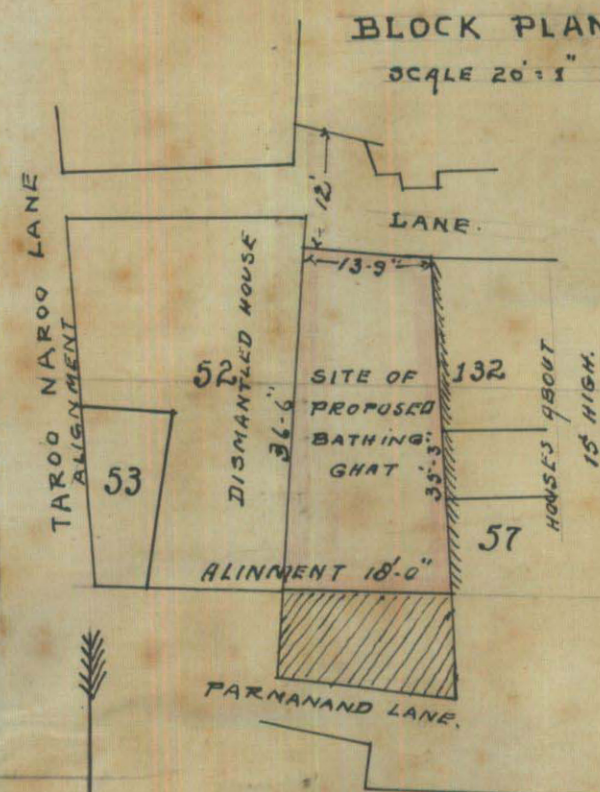

BLOCK PLAN

SCALE 20-1"

L. G. L. Verley
Seth Shevaran