



4

No. E.

of 192 .

MUNICIPAL ENGINEER'S OFFICE,

Karachi, _____ 192_____

Ex. Engineer's Orders.

Returned to Land Manager and Architect for necessary action and submission to Managing Committee.

Ex. Engineer,
Karachi Municipality.

No. L. M.

of 192 .

Submitted to the Managing Committee through the Chief Officer.

Land Manager and Architect.

RESOLUTION OF THE MANAGING COMMITTEE.

Resolution No. 150 dated 1958



38

332

Form No. 1-500 1-5-25.

Karachi, 13th November 1926

NOTICE UNDER SECTION 96 OF ACT III OF 1901.

THE CHIEF OFFICER,

KARACHI MUNICIPALITY.

Sir,

I beg to inform you that I intend building A Building
 on plot No. 104

Survey Sheet No. E7 Situate in Ranchore Line
 Street, Mauji Quarter. Ranchore

As required by the Rules of the Municipality I beg to submit herewith a Plan
 of the same for approval.

I beg to remain,

Sir,

Your most obedient Servant,

Address:—

Haji Nuk Mohammad Mithun ساجد محمد میٹھون
Contractor
Mauji Street
Ranchore Line
Karachi
 No. G. 13775 of 192

(i.e.) Haji Nuk Mohammad Mithun
 Signature of the Applicant

MUNICIPAL CHIEF OFFICER'S OFFICE,

Karachi, 13th November 1926.

Forwarded to the Health Officer for favour of passing on to the Land
 Manager and Architect after putting his remarks.

[Signature]
 for Chief Officer
 Karachi Municipality.

15/11

PROPOSED BUILDING ON


PLOT No. 104 SHEET E7

RUNCHORE QUARTER

SCALE 8 FT TO AN INCH



FRONT ELEVATION


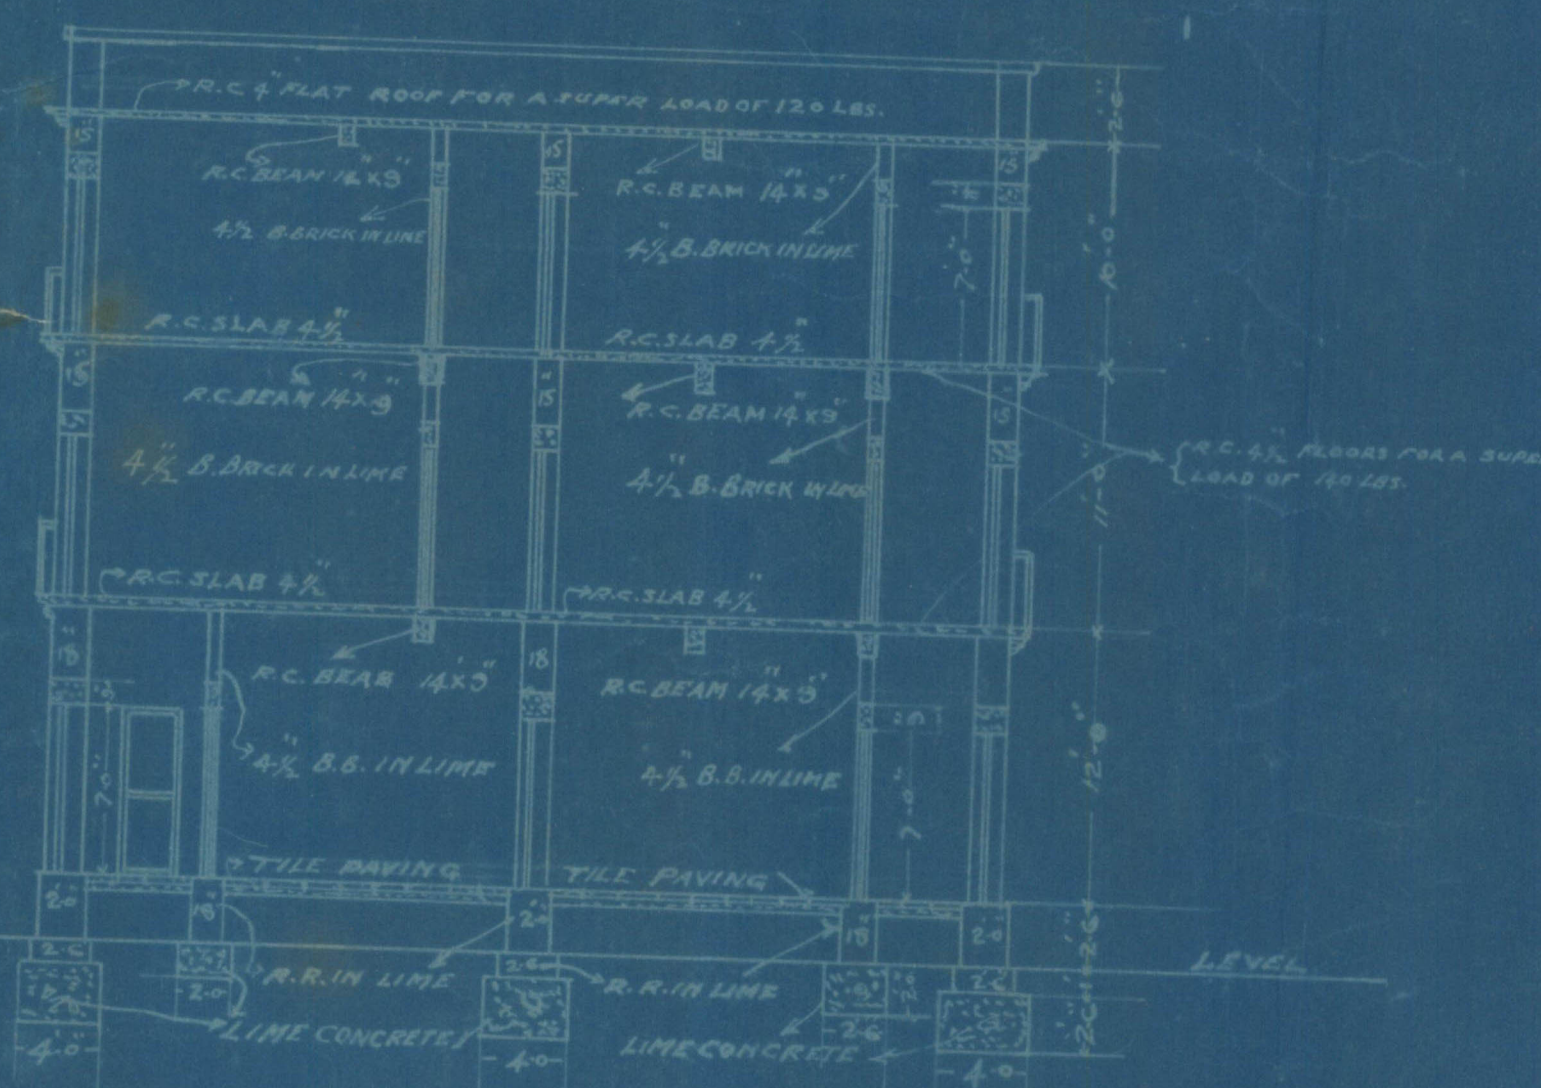


SECTION ON A-B


DETAILS OF R.C BEAMS & SLABS

LONG SECTION SCALE 1/2" = 1'

CROSS SECTION SCALE 1/2" = 1'

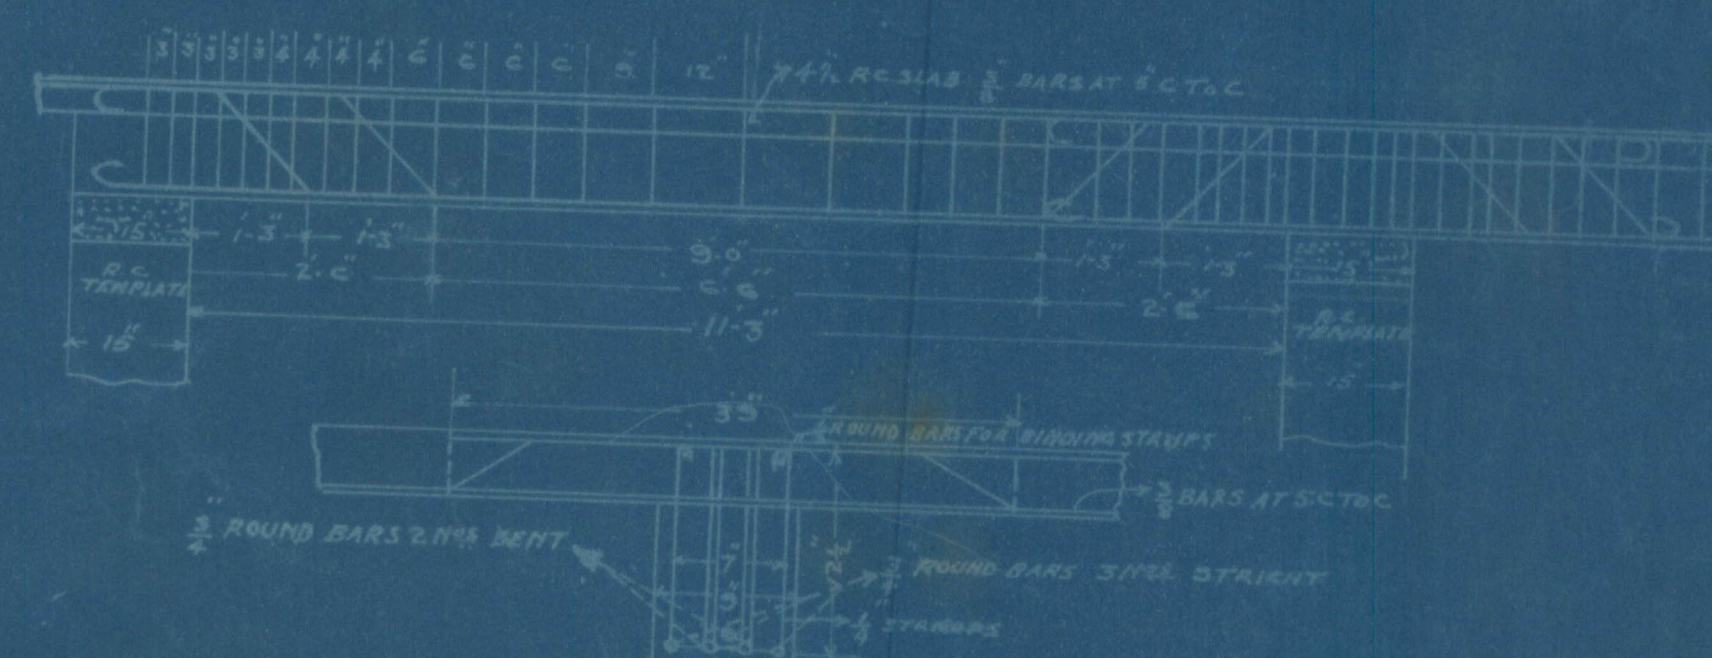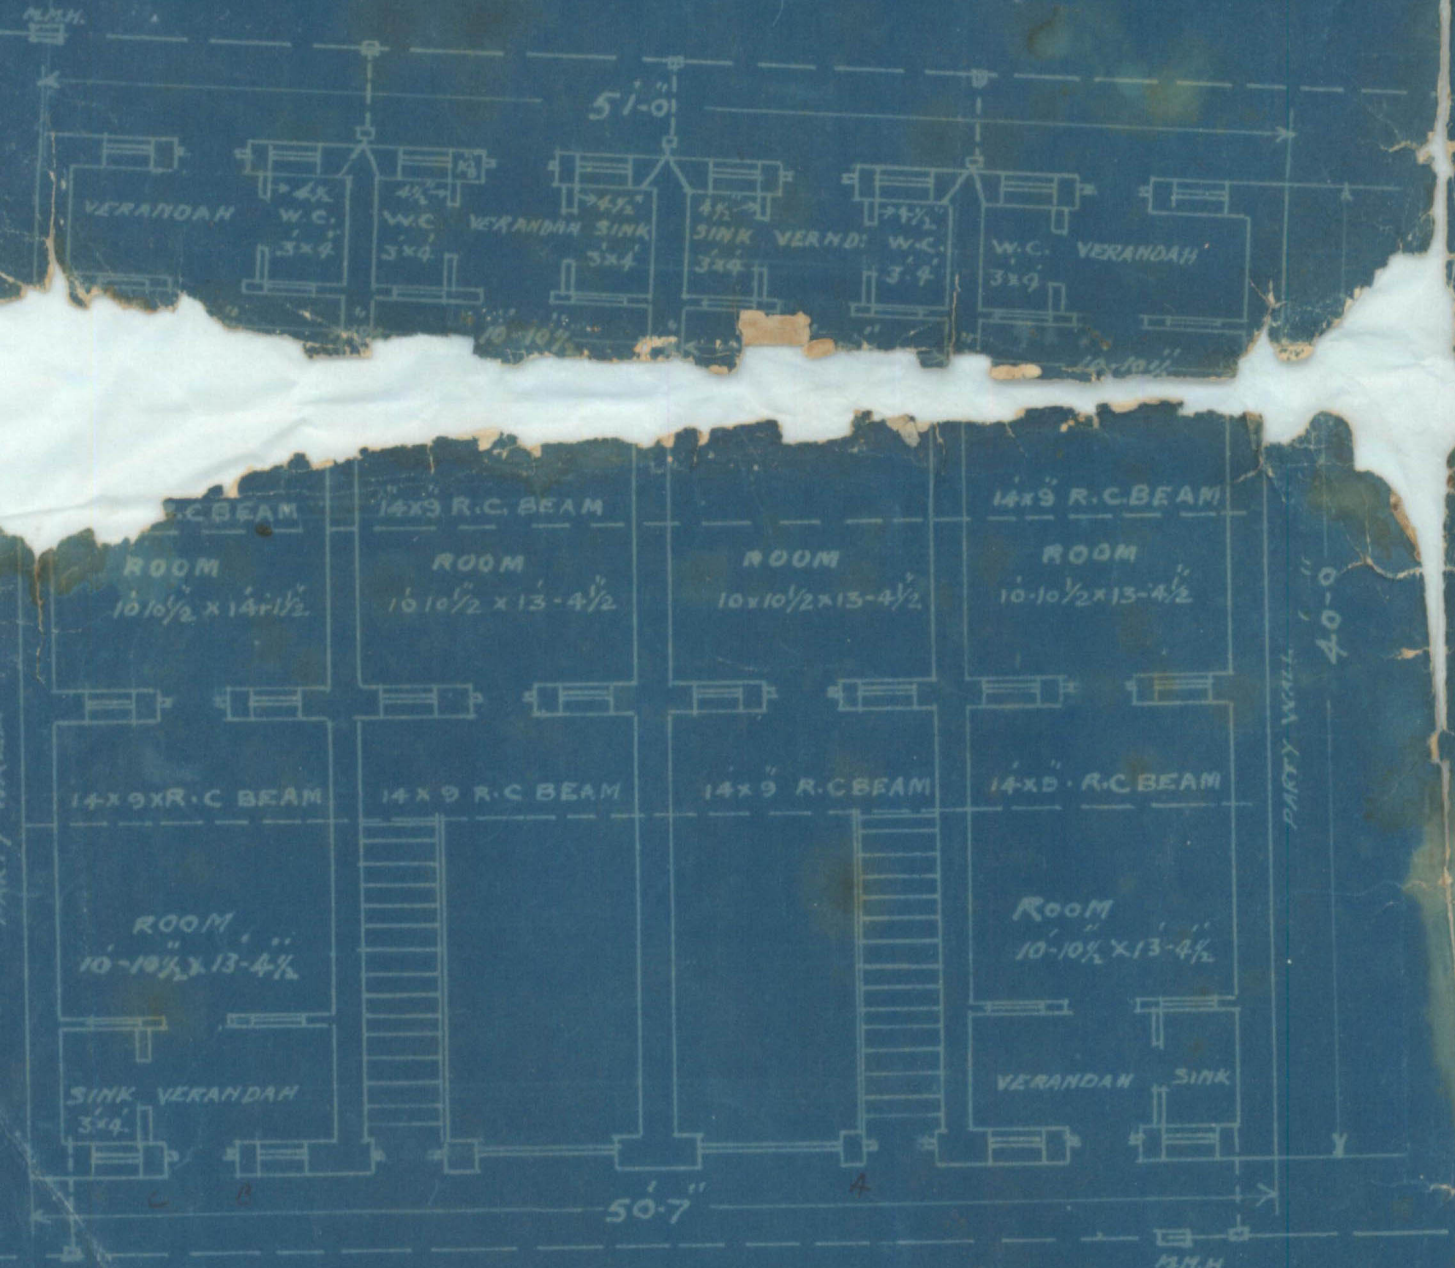


GROUND FLOOR

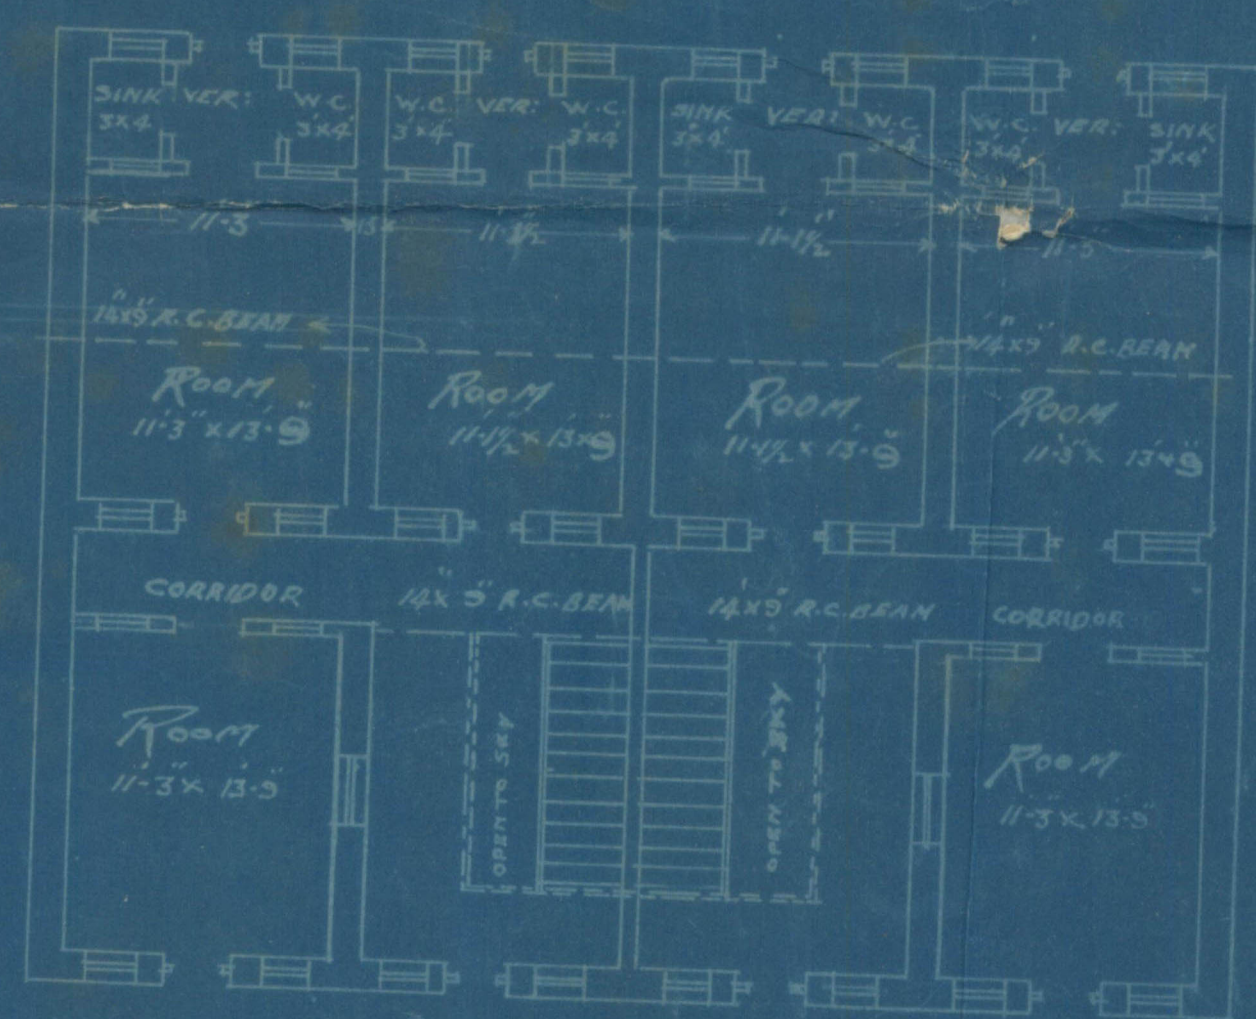

1ST & 2ND FLOOR

SITE PLAN

SCALE 40' = 1"

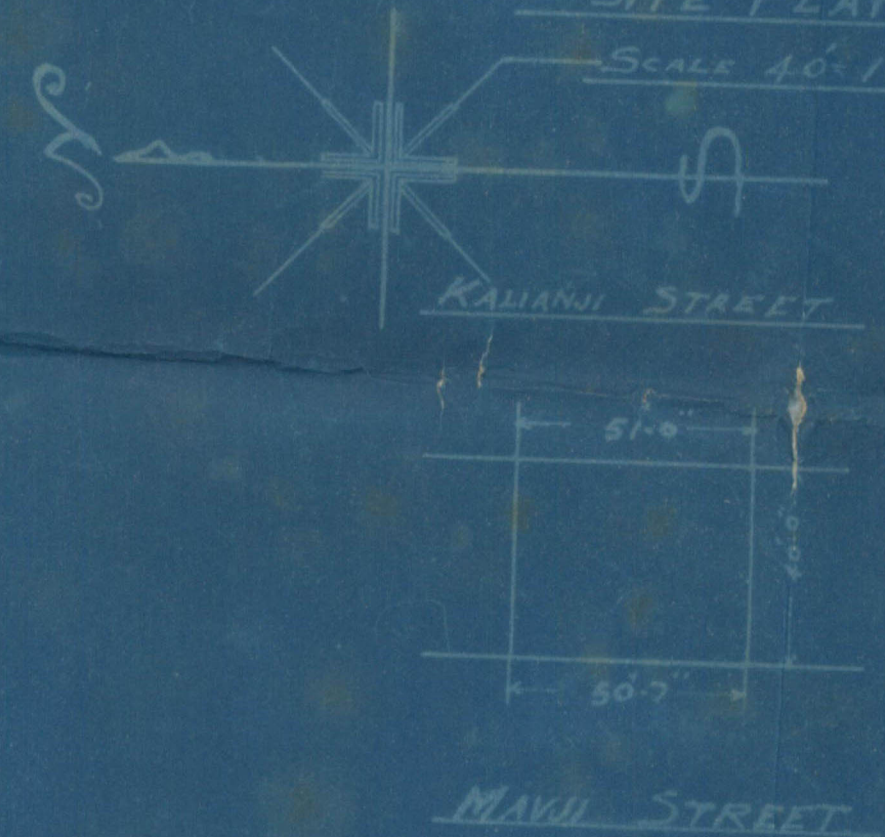

OWNER'S SIGNATURE


12 July 1938
10 R. (initials)
ARCHITECT A. J. JONES

PROPOSED BUILDING ON


PLOT No 104 SHEET E7

RUNCHORE QUARTER

SCALE 8 FT TO AN INCH

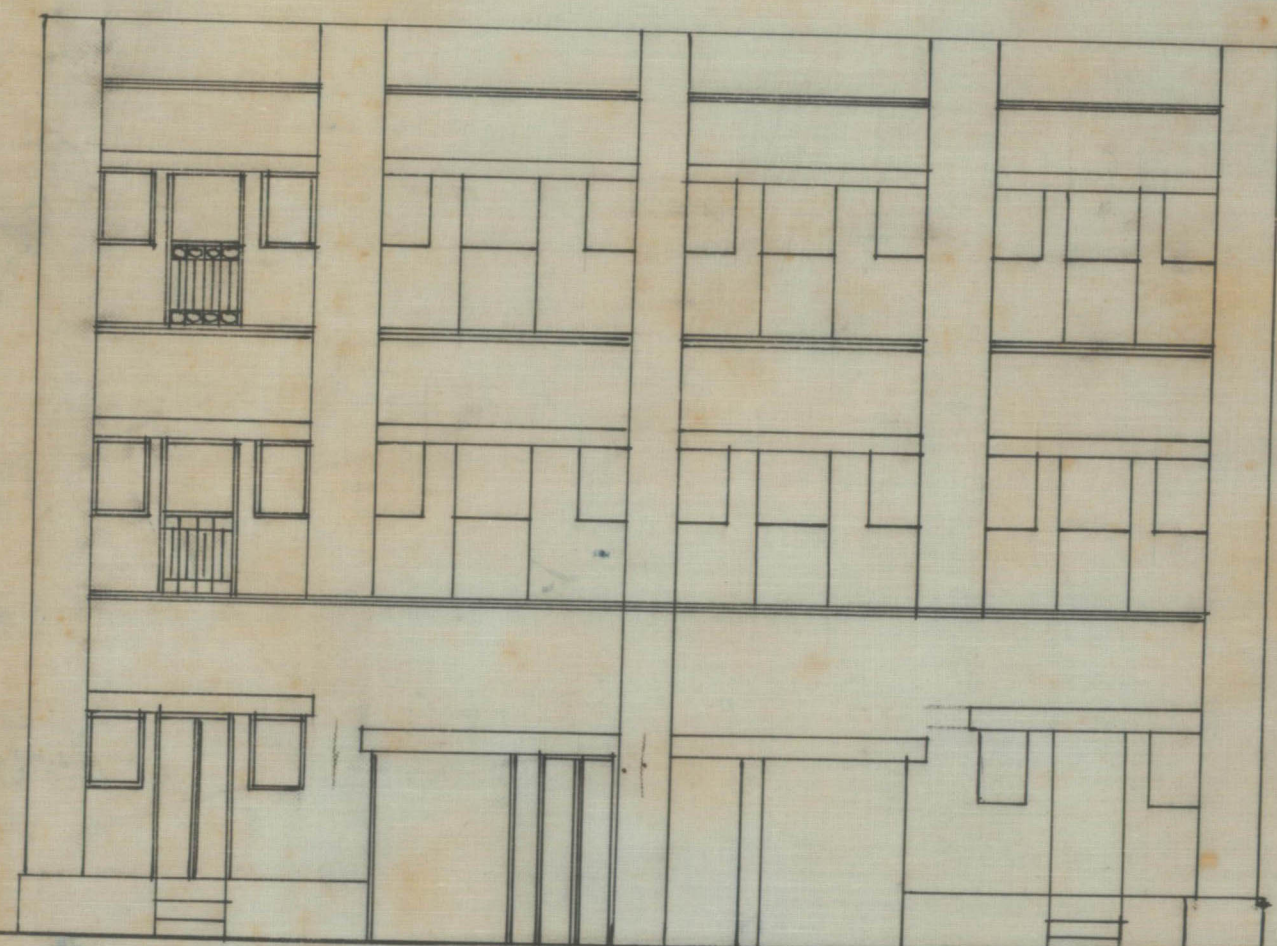

FRONT ELEVATION

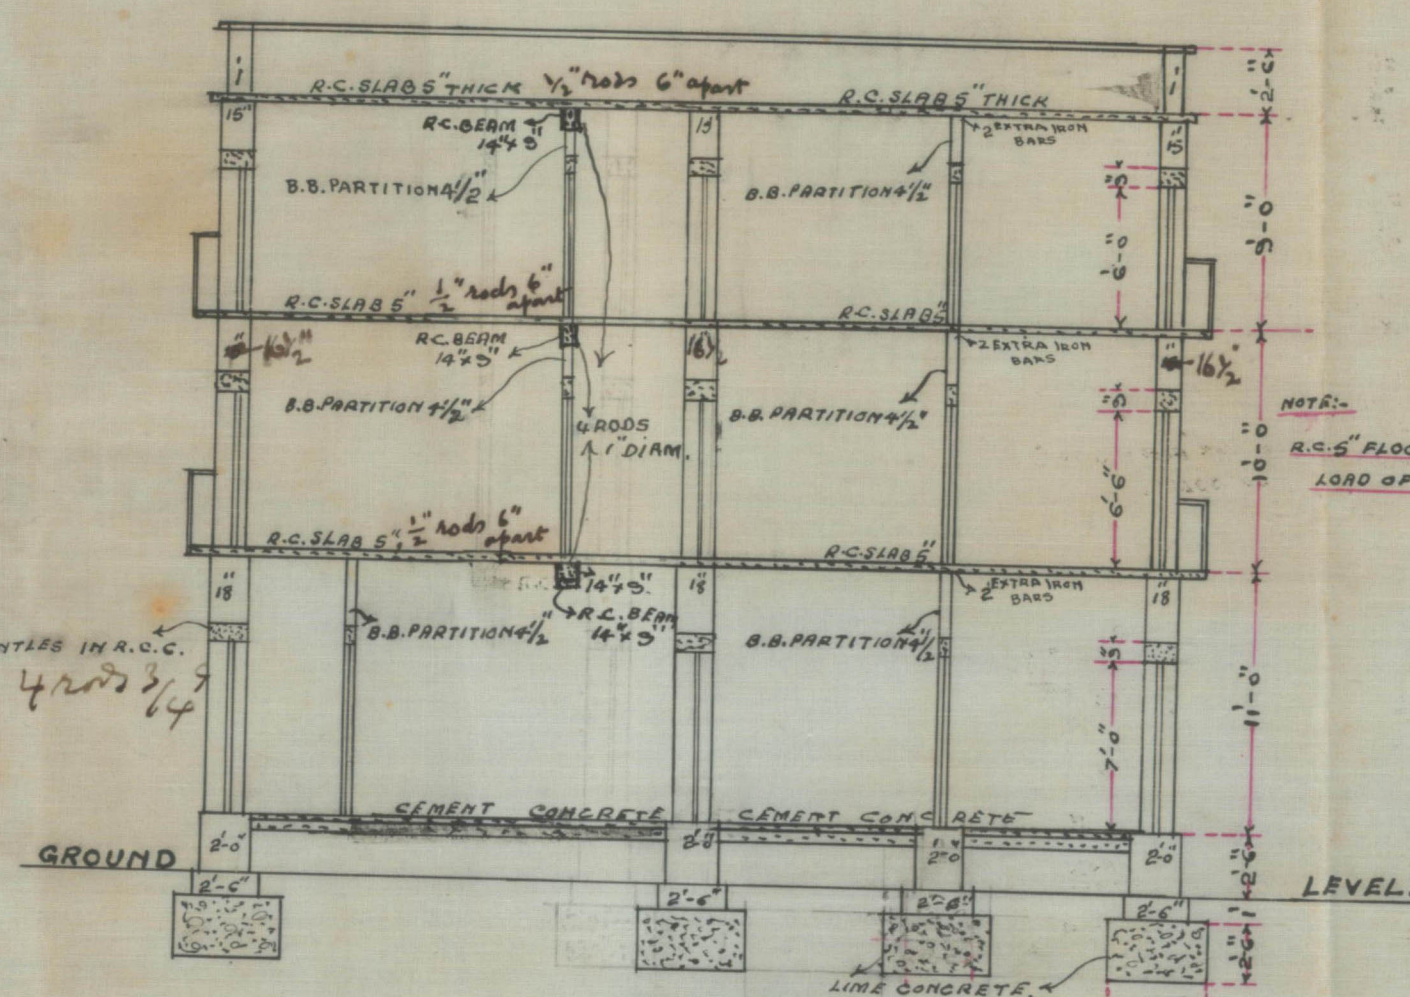


SECTION ON LINE A-B.


DETAILS OF R.C BEAMS & SLABS

LONG SECTION SCALE 1/2" = 1"

CROSS SECTION - 1" = 1"

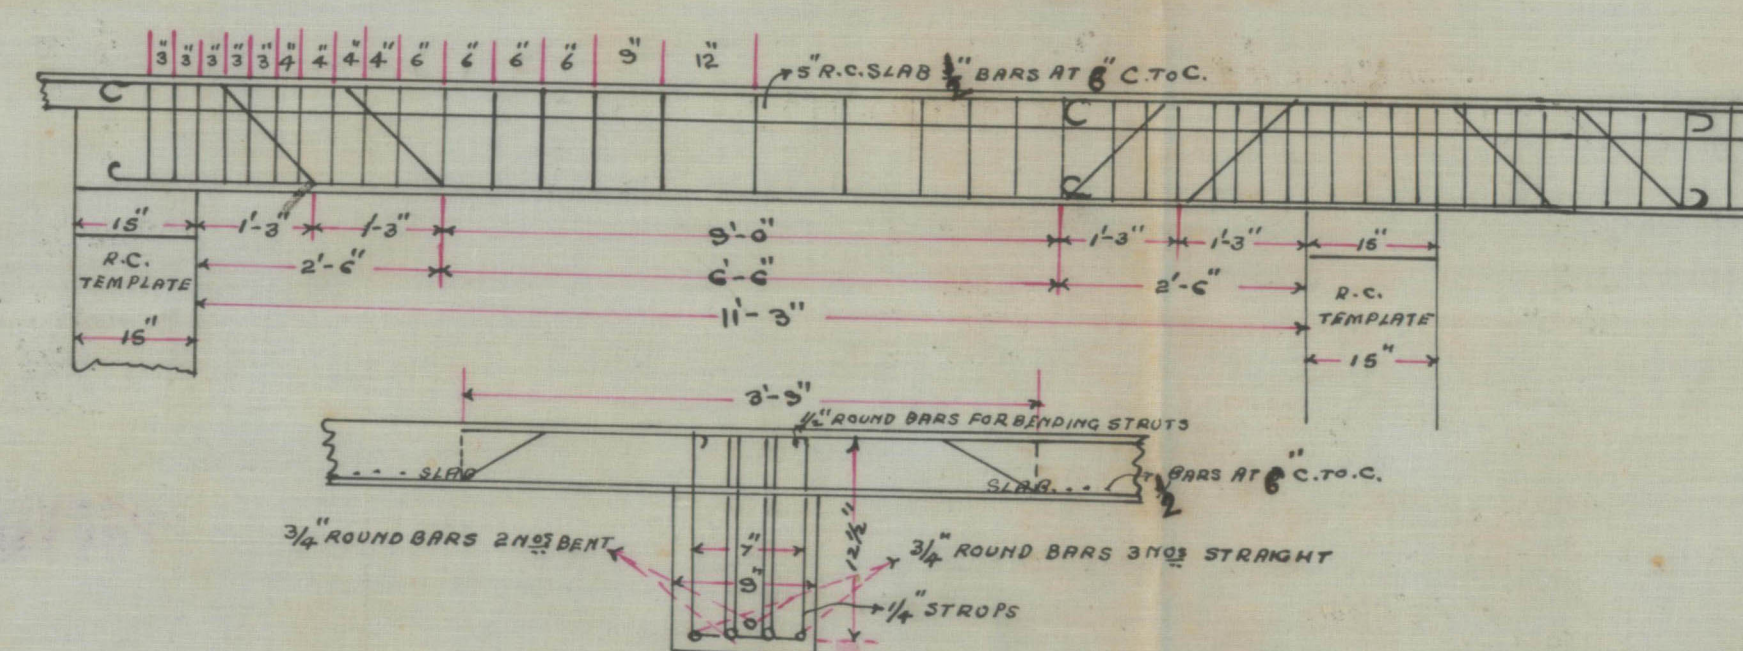


KULLINYANJEE STREET 30' WIDE

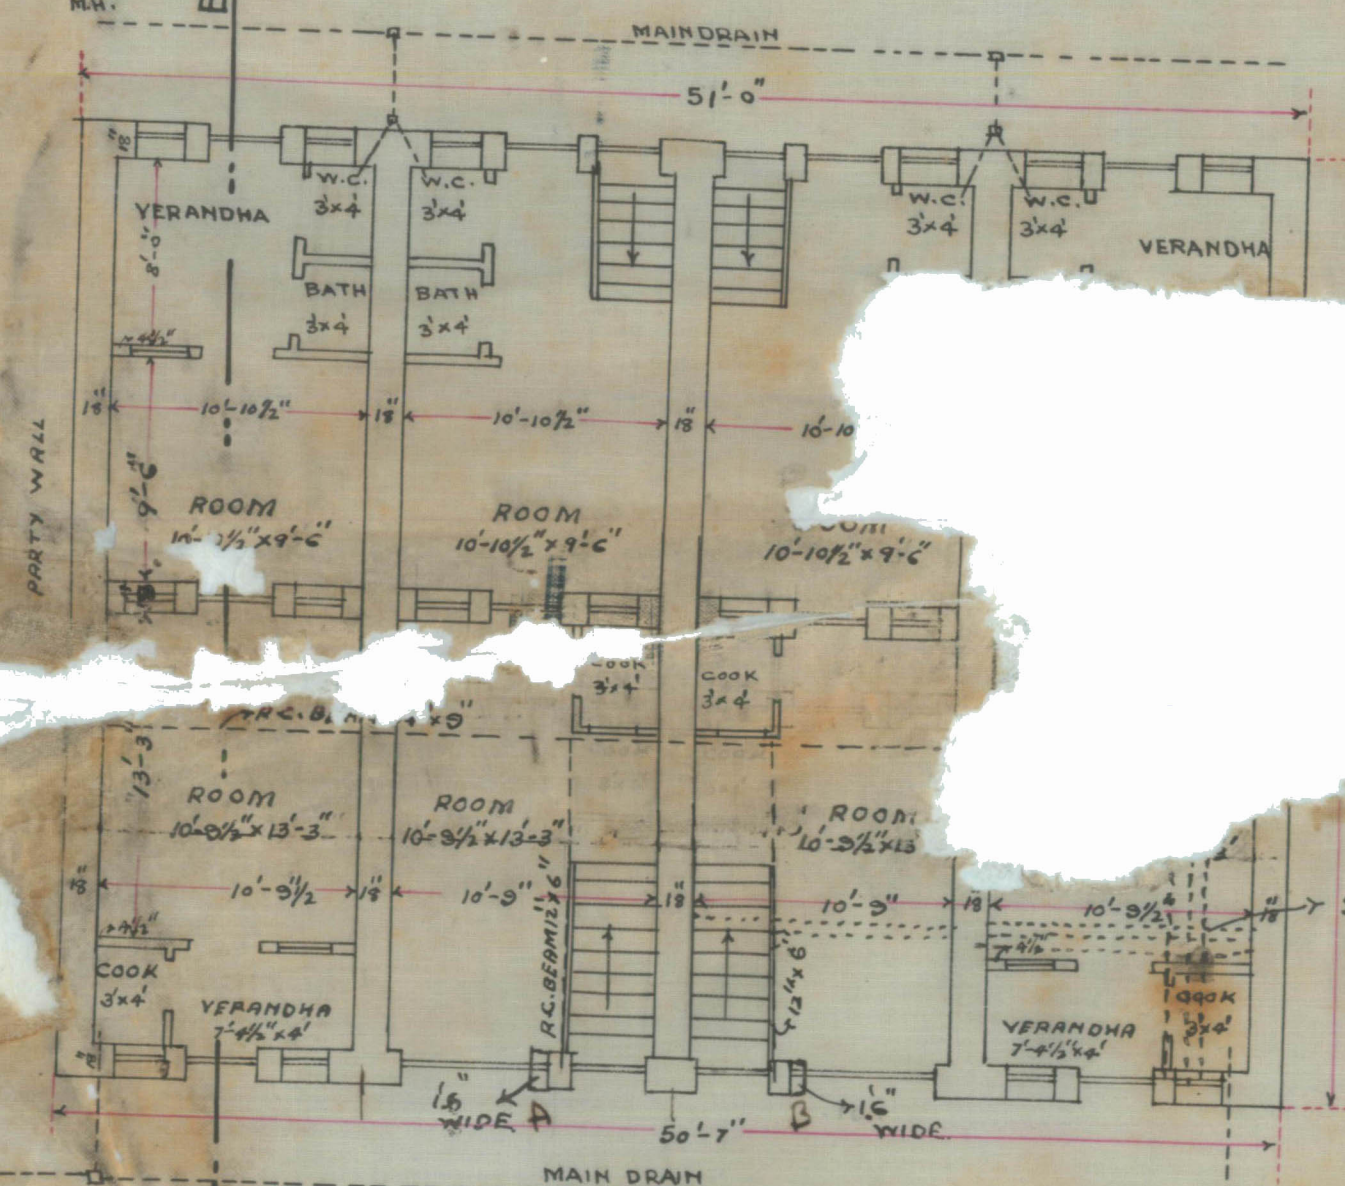

MAWJEE STREET 30' WIDE


GROUND FLOOR

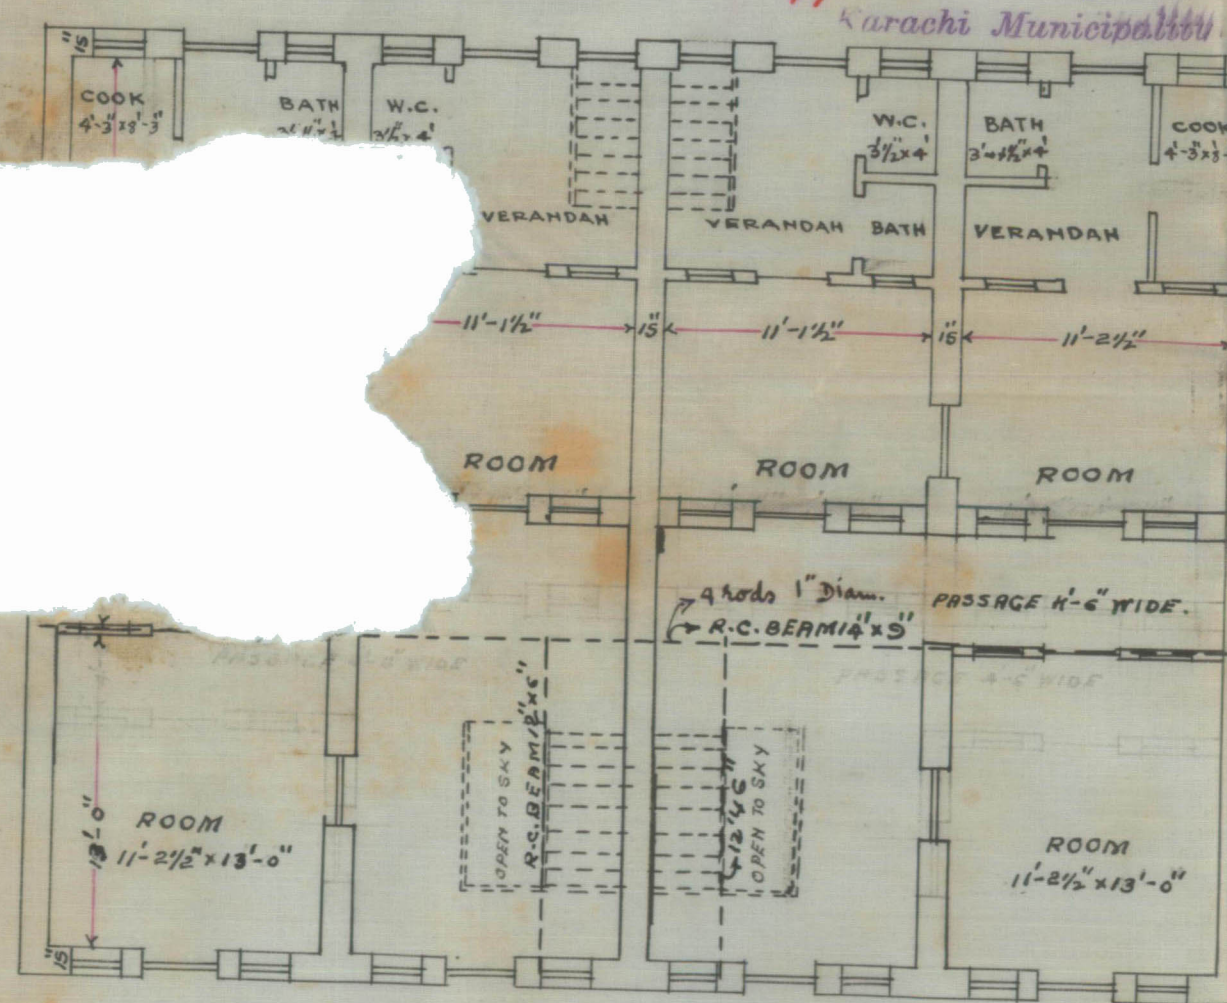

1ST & 2ND FLOOR

SITE PLAN

SCALE 40'

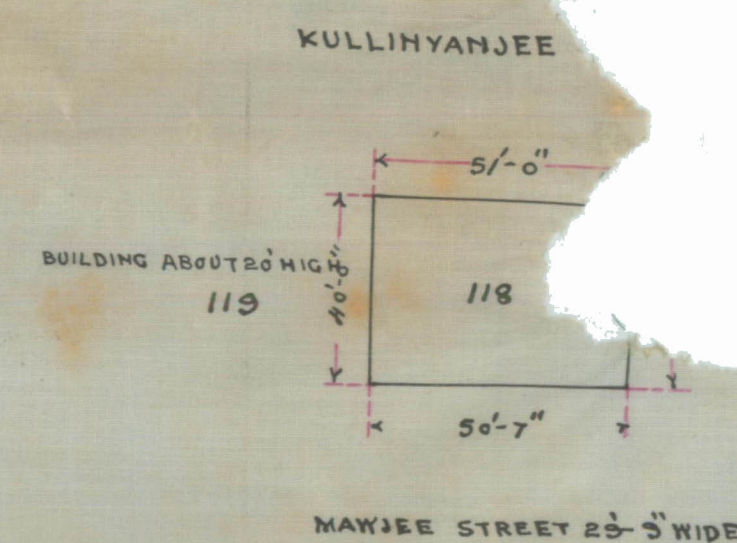

21/11/27


B. B. (Civil)

PROPOSED BUILDING ON


PLOT NO 104 SHEET E7

RUNCHORE QUARTER

SCALE 3 FT TO AN INCH

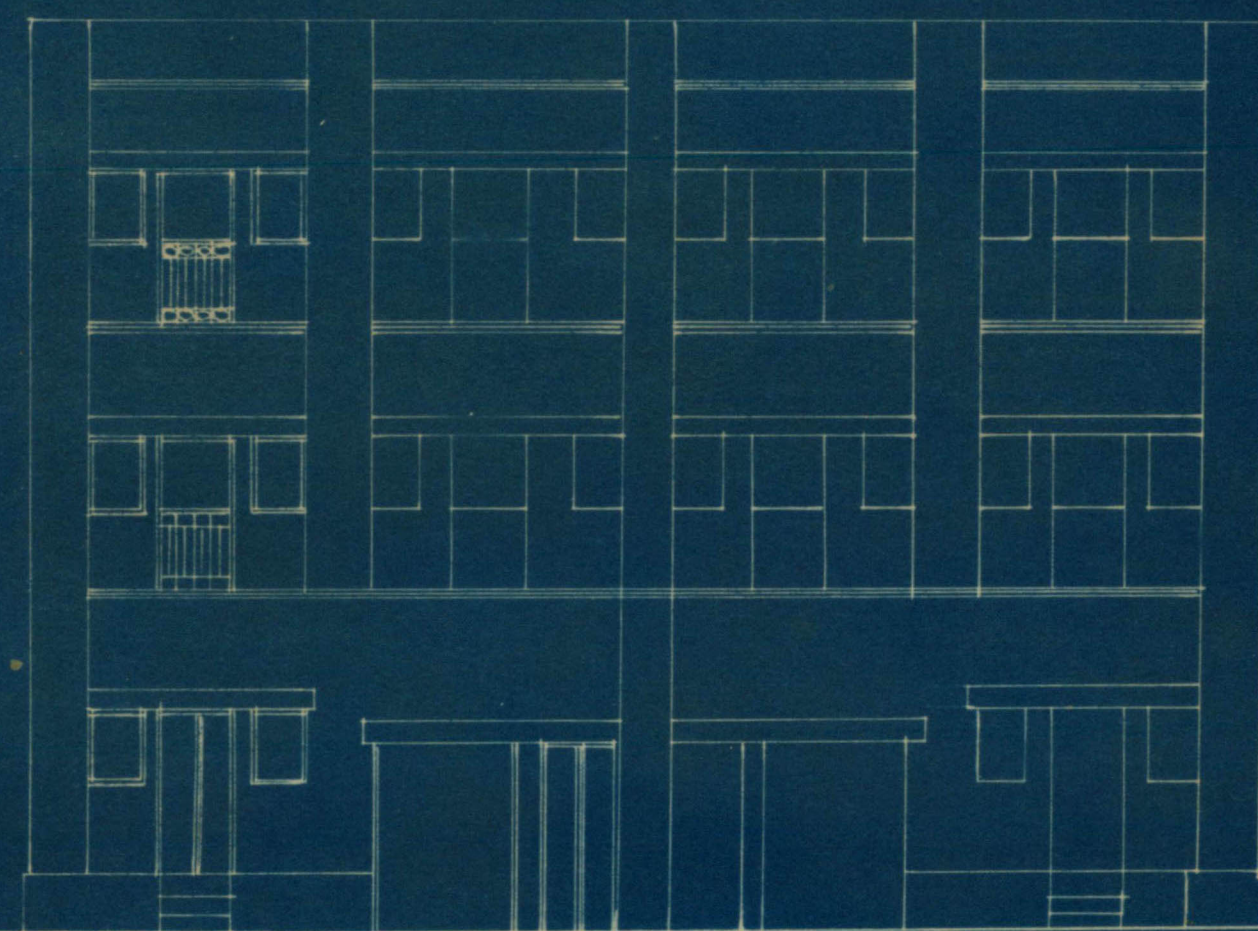

FRONT ELEVATION


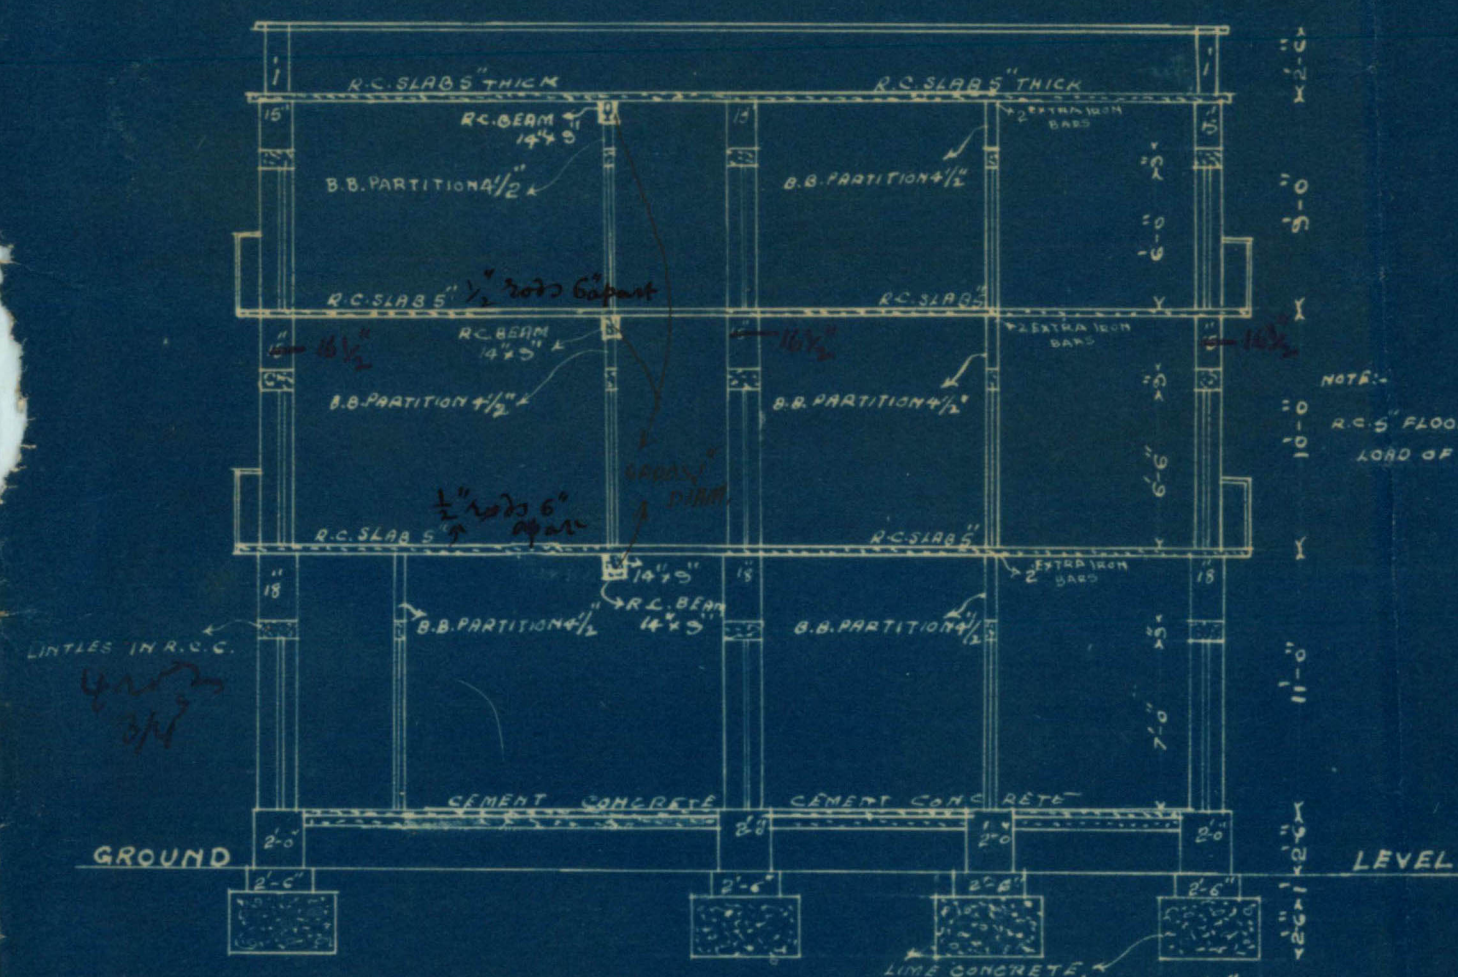


SECTION ON LINE A-B


DETAILS OF R.C BEAMS & SLABS

LONG SECTION SCALE 1/2" = 1'

CROSS SECTION - 1" = 1'

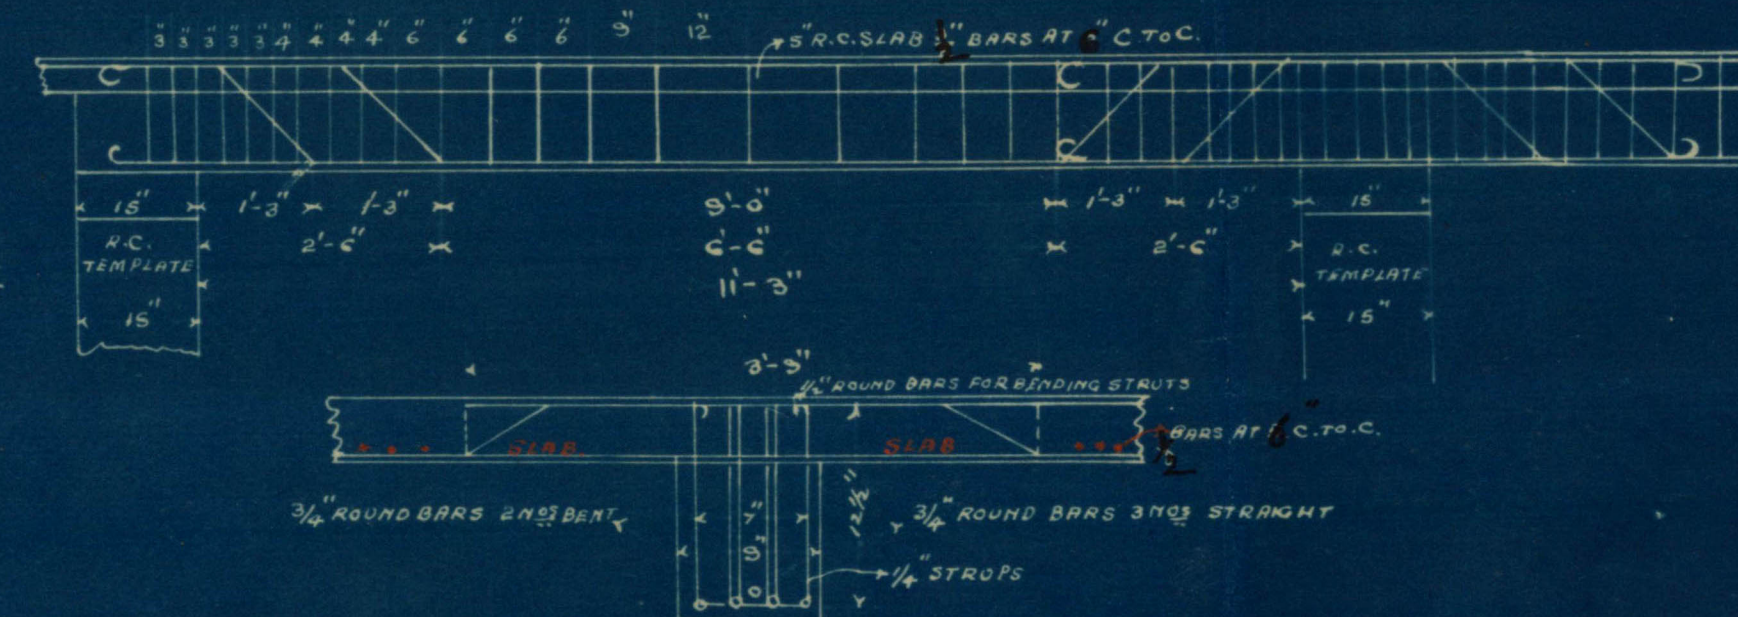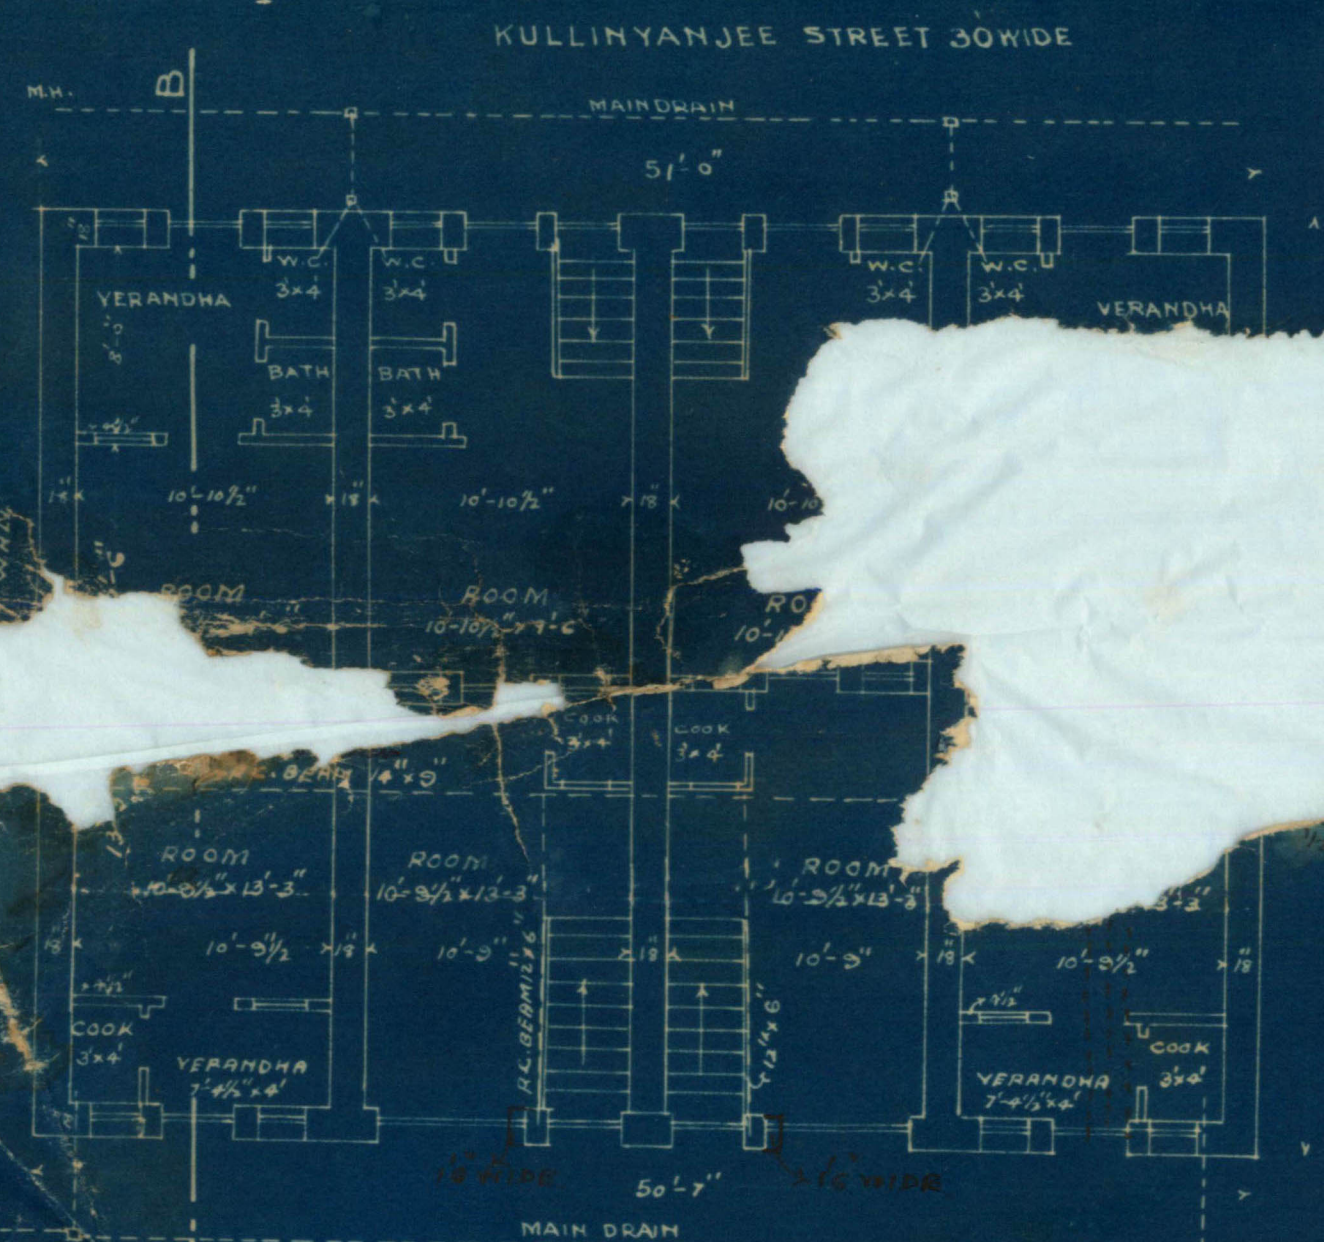


GROUND FLOOR

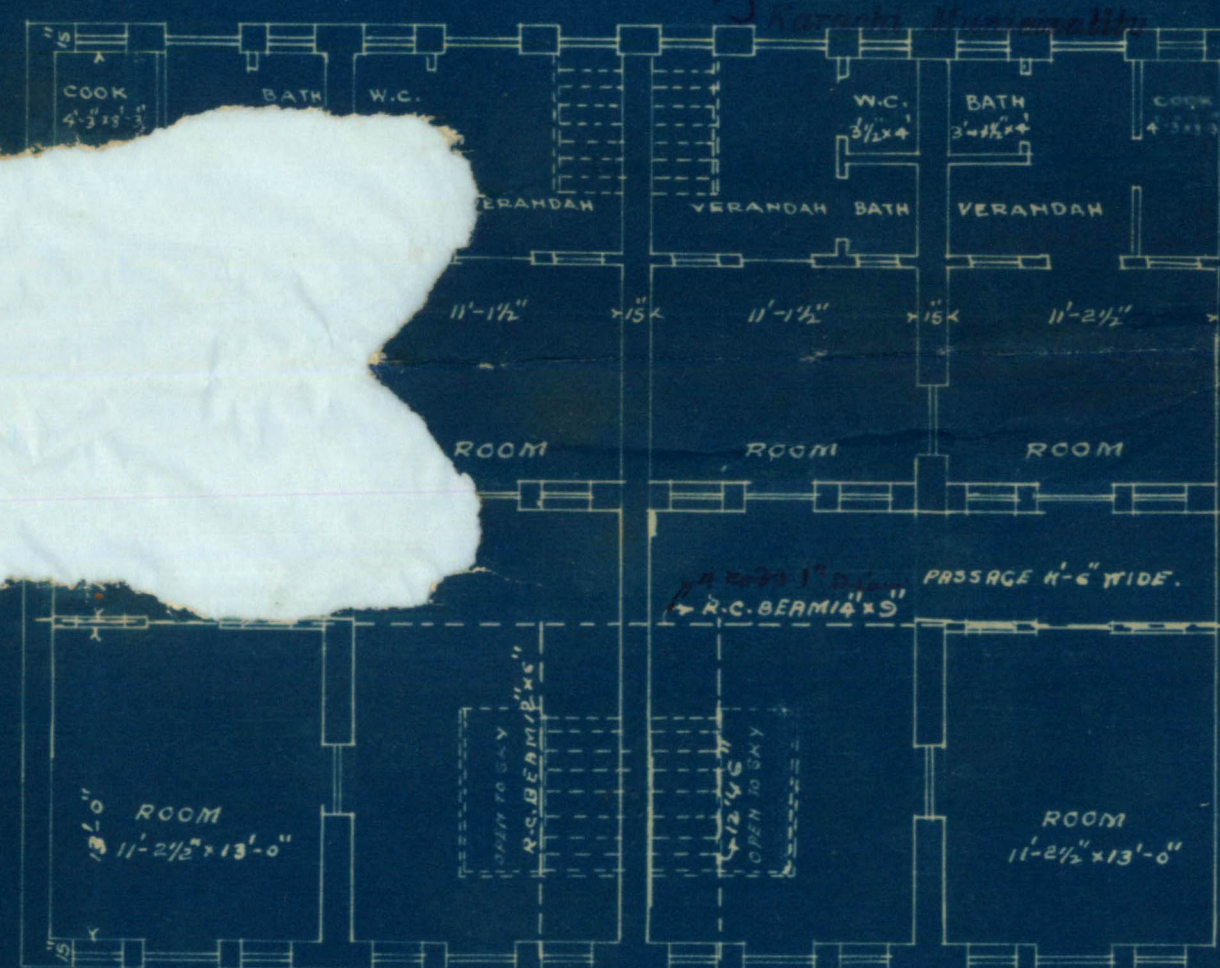

1ST & 2ND FLOOR

SITE PLAN

SCALE 40 FT

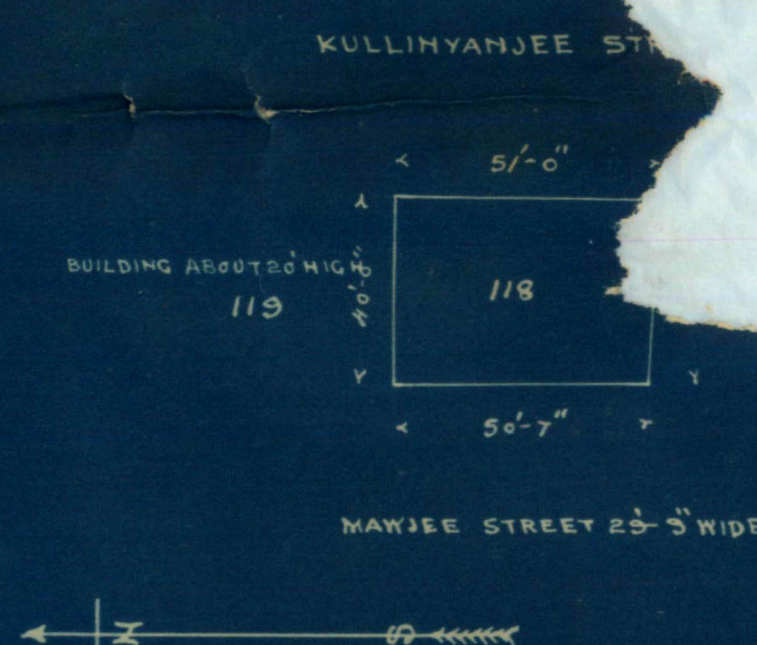


2nd mg 5/11
E: 1 5/11 mg 5/11
E: 2 13/11 mg 5/11

BUILDING FOUND IN BAD CON DITION.

Quarters)

Area: _____

Name of B.I. _____

ement _____

Asstt.Arch. _____

tenants	Condition of	Inspection	Final	5 day
families	Building,	of A.A.C.	Inspection	notice.
:	:	Dates.	:	Date of
:	:	:	:	issue of
:	:	:	!!	notice.