

SCALE 8-1"



Khinji Kharia 9.7.27

KHIMJI J. KARIA & CO
ARCHITECT

PRARTHNA SAMAJ ROAD
KARACHI

PLAN OF PROPOSED BUILDING


ON PLOT NO 35 SHEET K-2

LYARRE QR


SCALE 8"=1"

BLOCK PLAN


SCALE 20' = 1"

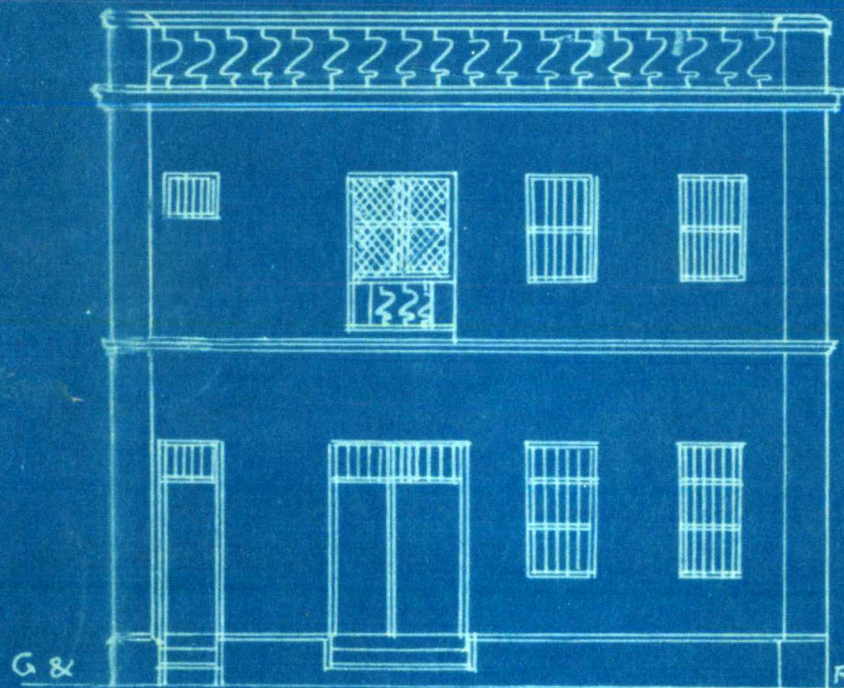

ELEVATION

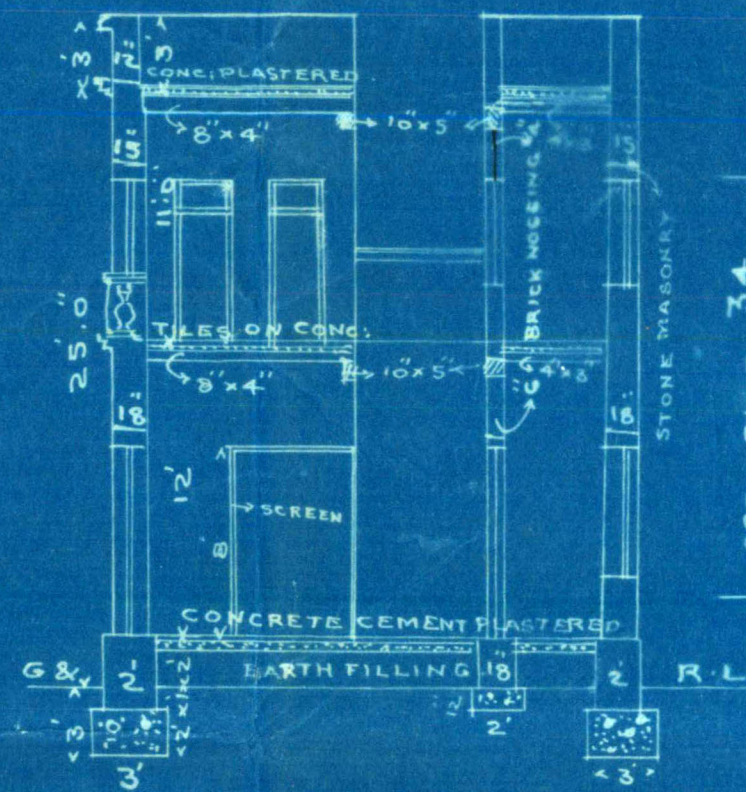


SECTION ON A.B.

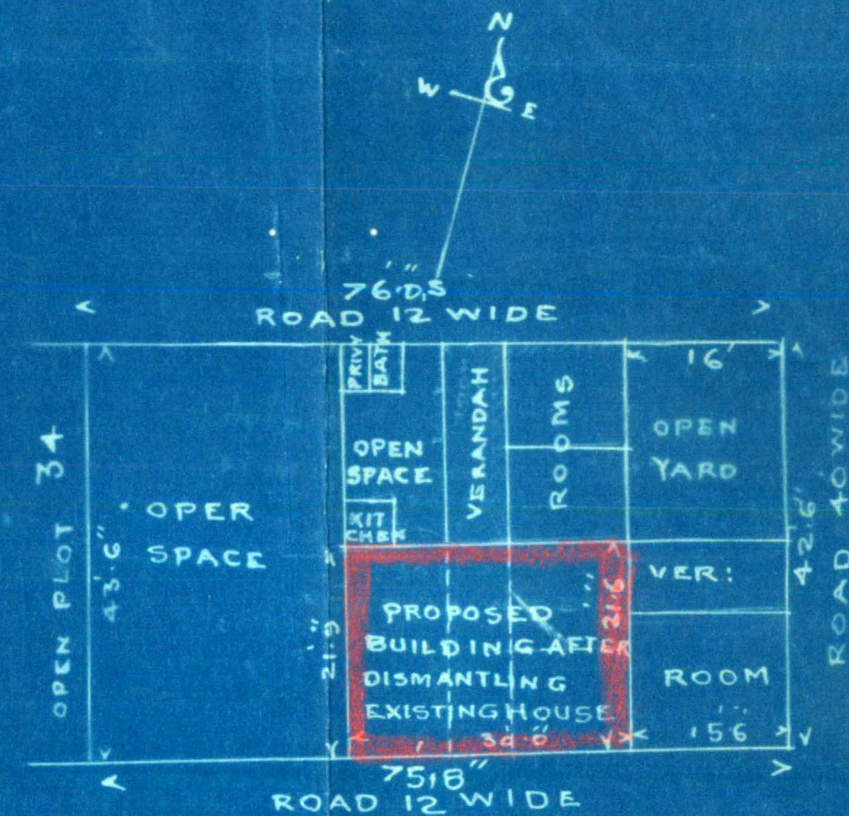


THIN WALLS ON GROUND FLOOR TO BE OF 6" BRICK NOGGING

DO FIRST DO DO 4 DO

R.C.C. LINTELS OVER DOORS & WINDOWS TO BE 6" DEEP WITH 3 RODS 3/4" DIA.

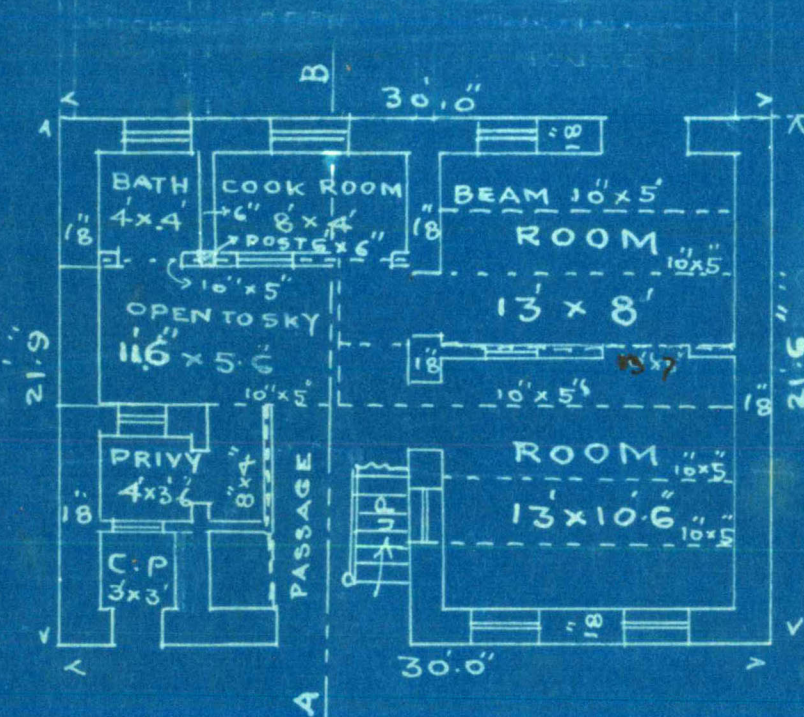

PLAN OF GROUND FLOOR

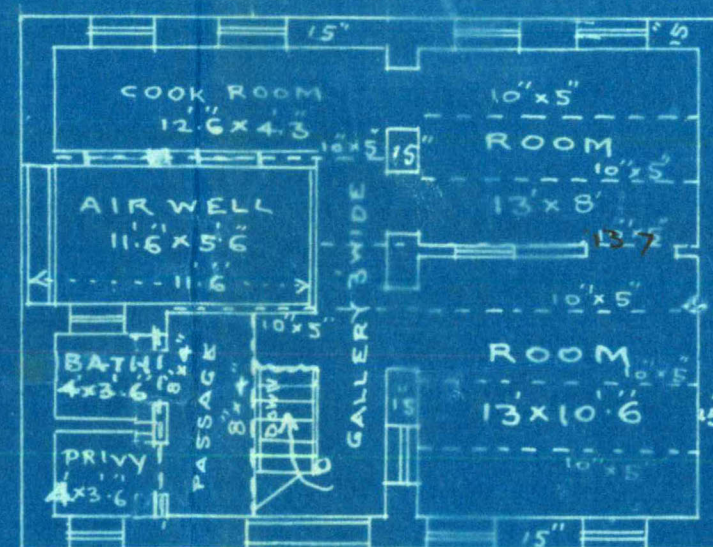

PLAN OF FIRST FLOOR

Khimji Karia 9.7.27.

KHIMJI J. KARIA & CO
ARCHITECT

PRARTHNA SAMAJ ROAD
KARACHI


عبدالمجید علی صاحب
i.e. Mahomed Abdulkhan Mahomed bin Khan
OWNER

PLAN OF PROPOSED BUILDING

ON PLOT N^o 55 & 56 SHEET K-2

LYAREE QUARTER


SCALE 8"=1"

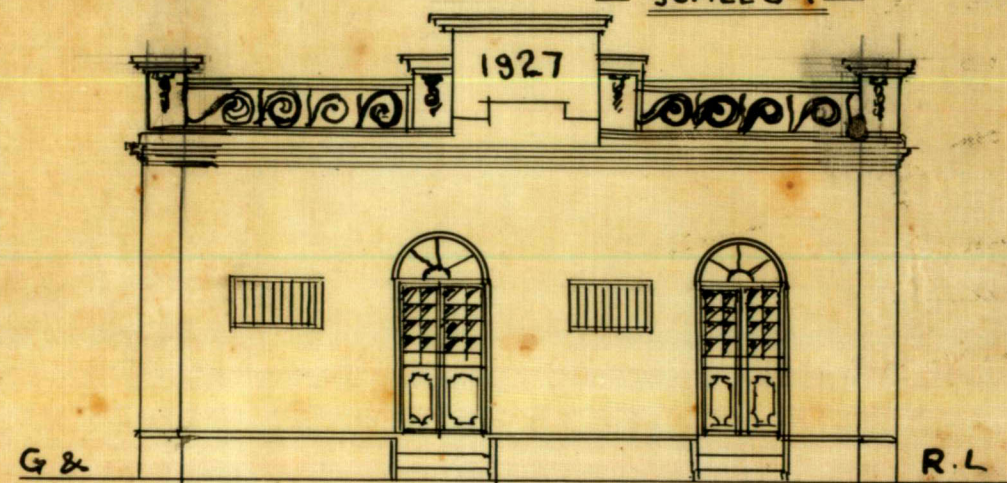

SOUTH ELEVATION


BLOCK PLAN

SCALE 40"=1"

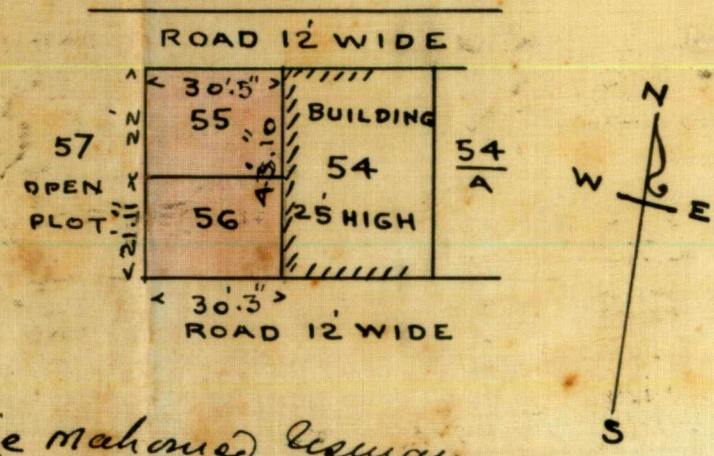


ie mahomed usman

OWNER

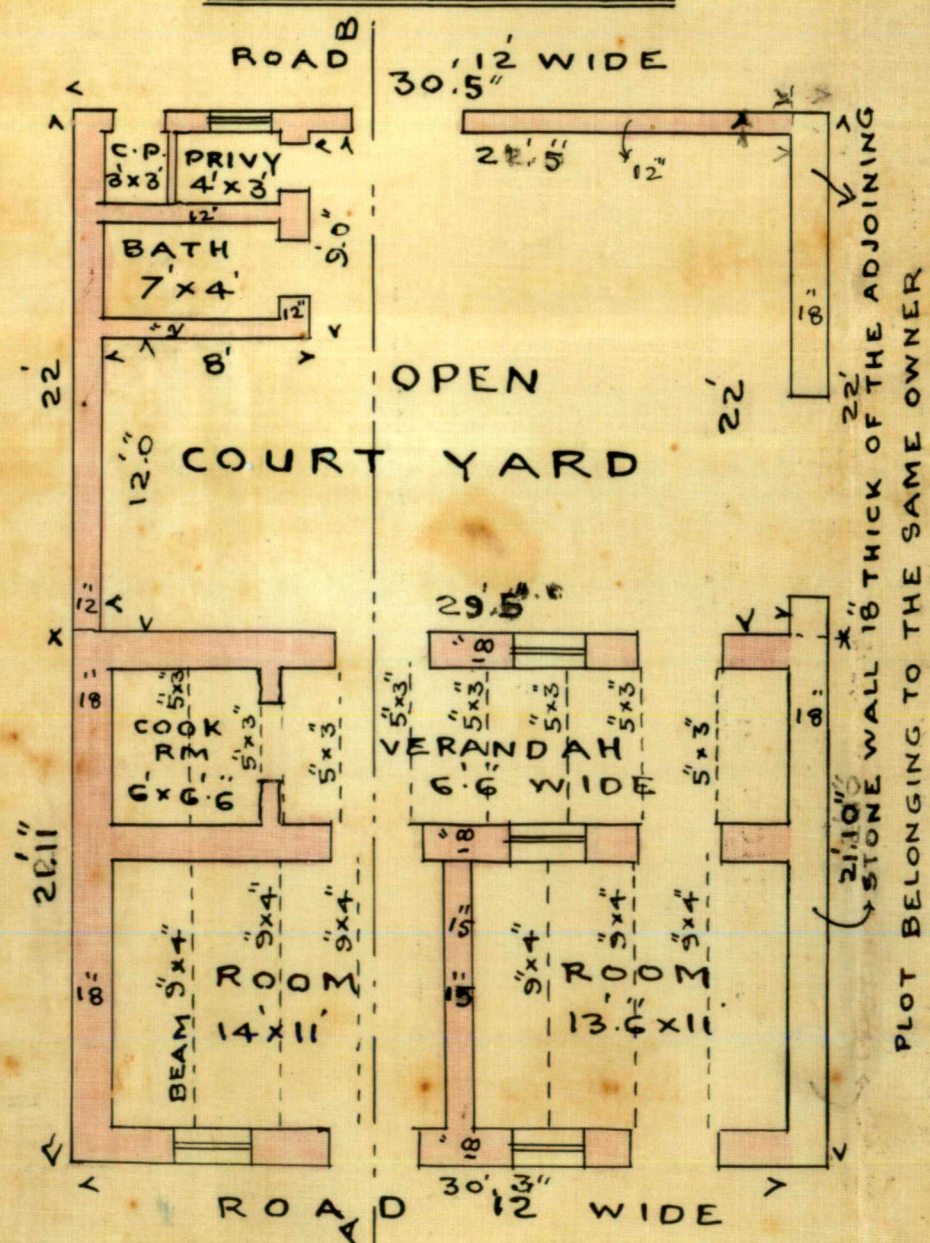


PLAN OF GROUND FLOOR

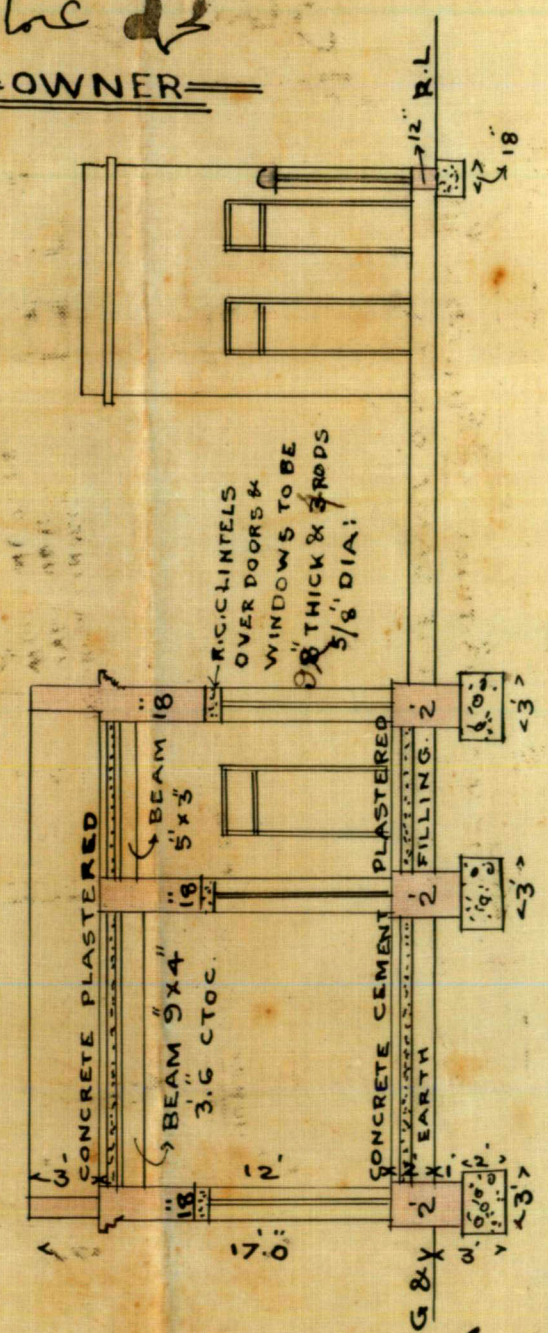


SECTION ON A-B

Architect & Surveyor
7.7.27.

SCALE 8" = 1"

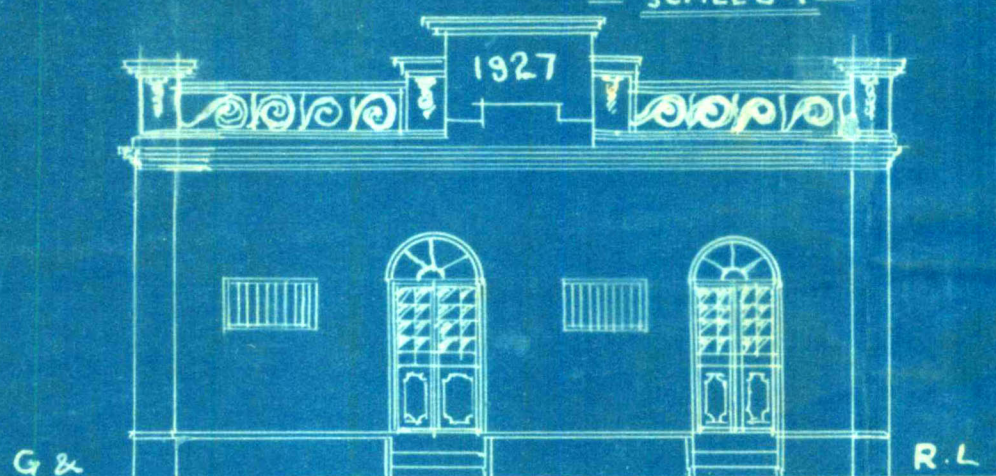

SOUTH ELEVATION

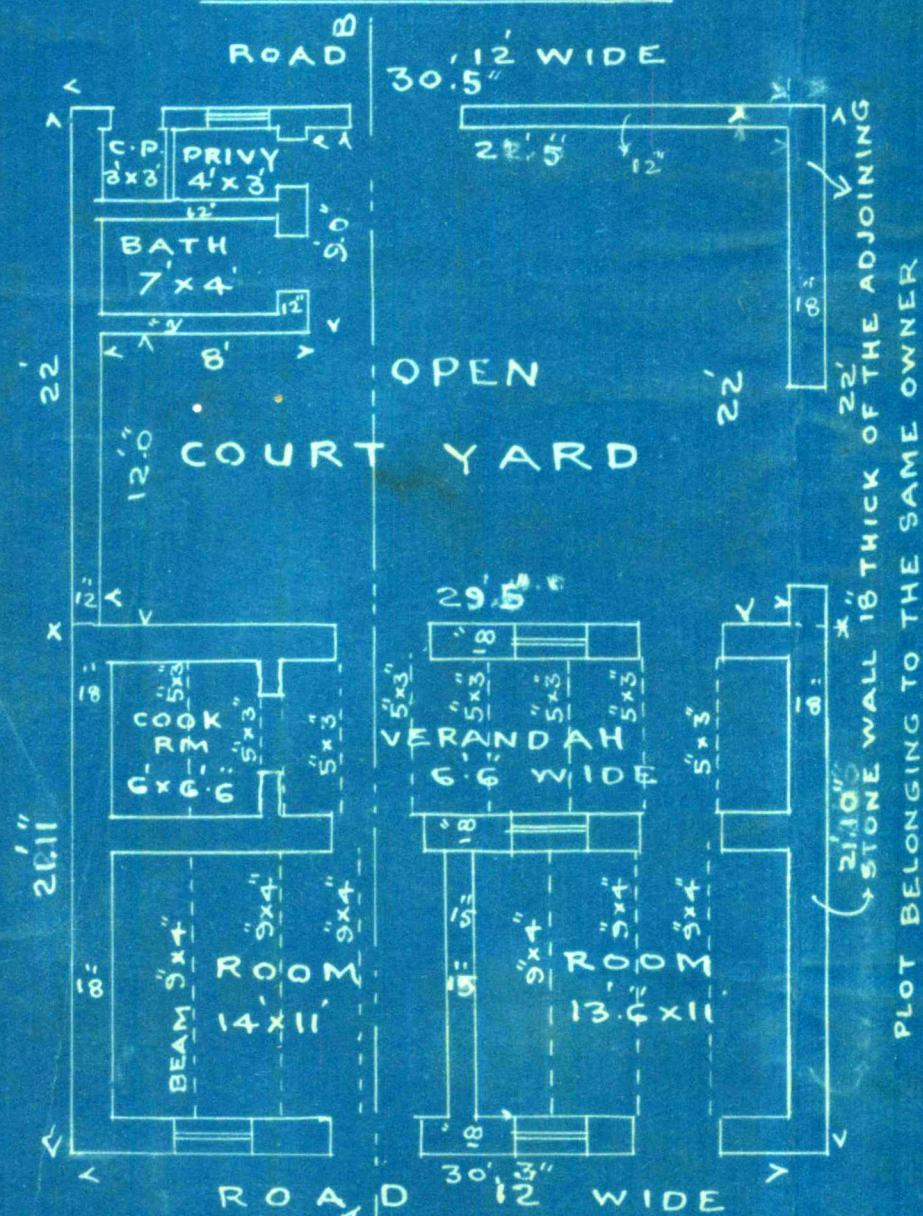

PLAN OF GROUND FLOOR


= SCALE 40:1



ie mahomed Usman

محمد عثمان

=OWNER

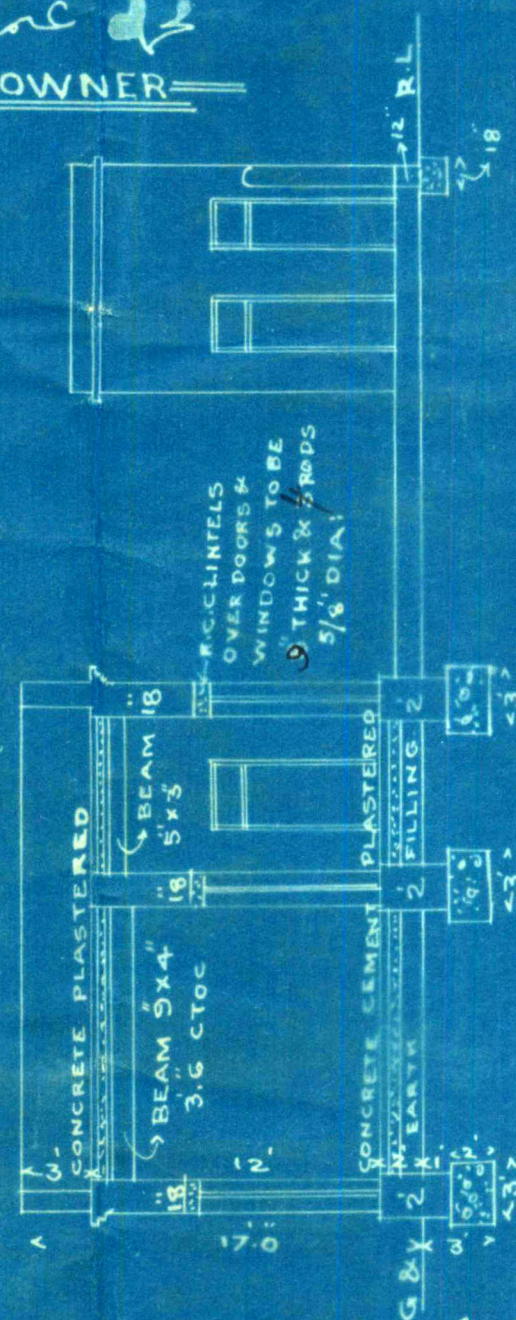

SECTION ON A.B.

Khimpri Jharla 7.


7.7.27

ARCHITECT & SURVEYOR

PLAN OF PROPOSED BUILDING
ON PLOT NO 55 & 56 SHEET K-2


LYAREE QUARTER

SCALE 8"=1"

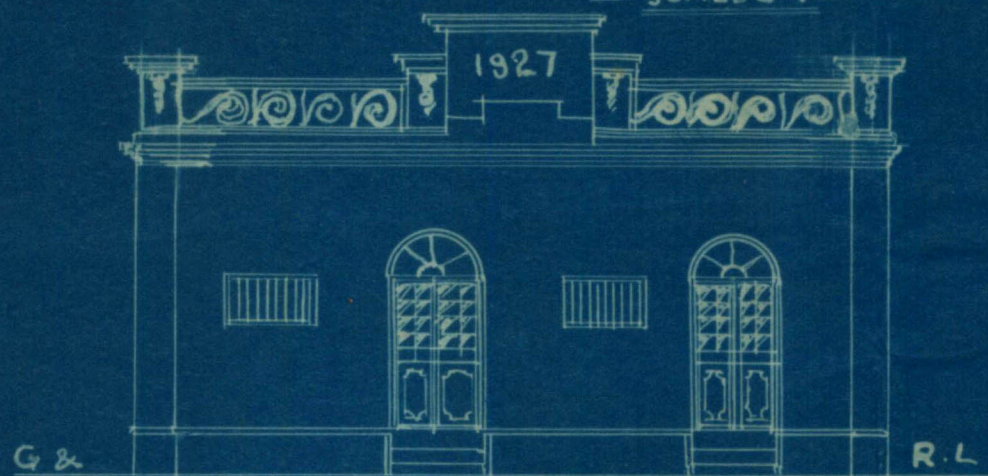


SOUTH ELEVATION

BLOCK PLAN
SCALE 40"=1"

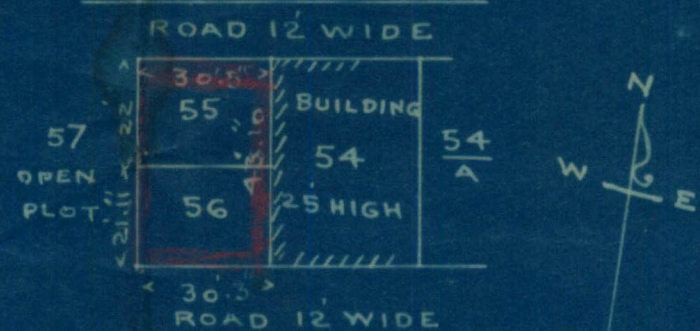


re Mahomed Usman

OWNER

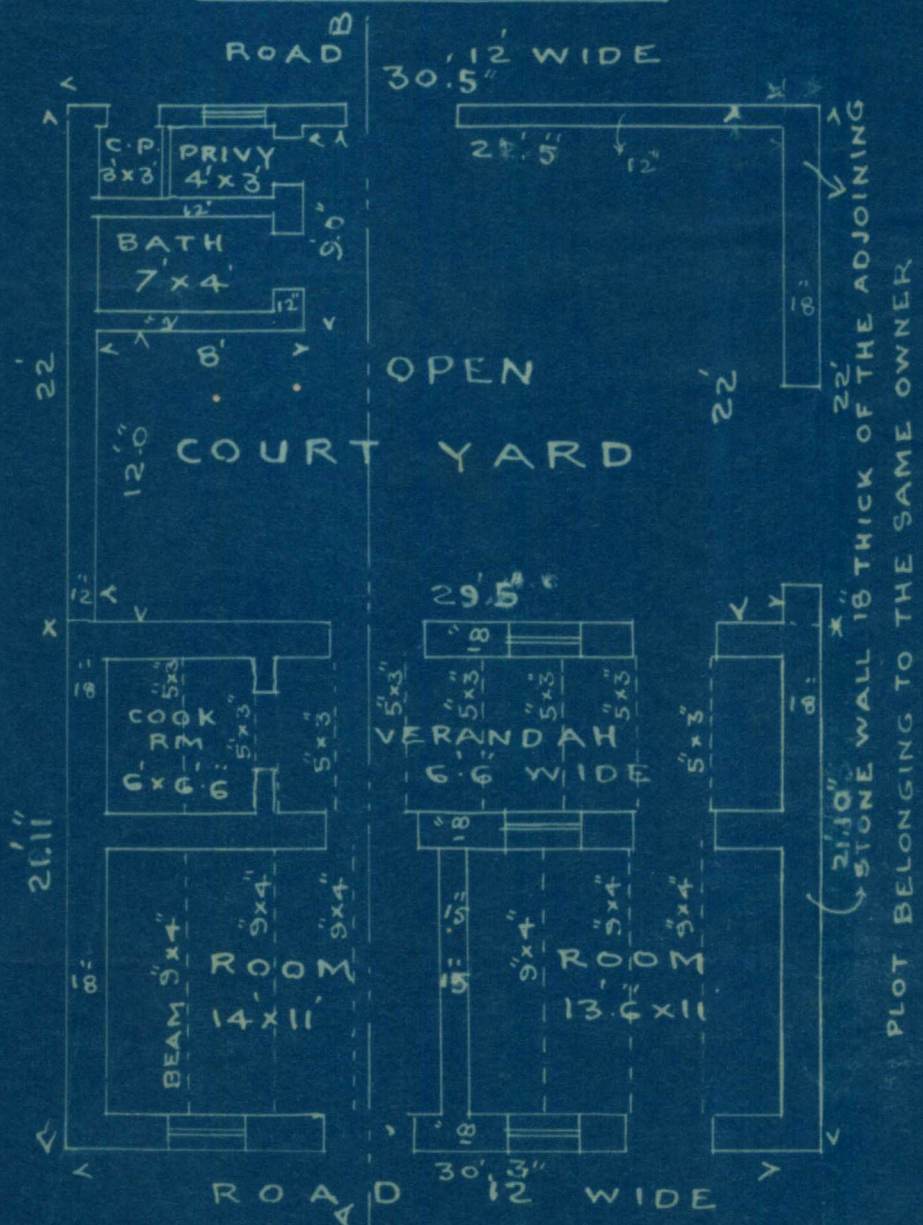

PLAN OF GROUND FLOOR

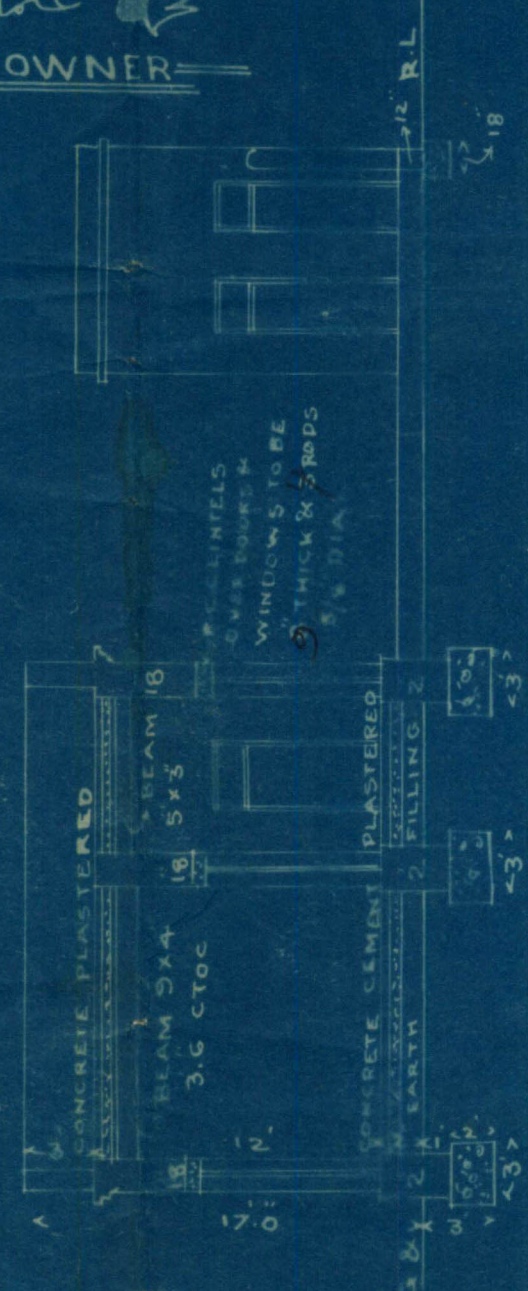

SECTION ON A-B

Khurshid Karia
7.7.27

ARCHITECT & SURVEYOR

KARACHI MUNICIPALITY.

1000—20-1-27.

N. J. MODI.

B. Sc., (Engineering London.)

A. M. INST., C. E., L. C. E.

A. M. I. S. E., M. R. San. I.

Land Manager & Architect.

REFERENCE No. L. M. A.

9181 OF 1927.

LAND MANAGER & ARCHITECT'S OFFICE,

KARACHI, 6. 9. 1927.

MEMO:—

With reference to ^{his}~~their~~ application dated 10-8-27 with a plan for the proposed ^{Building}~~additions~~ on plot No. 35 Survey Sheet No. 11.2. ^{Superior} Quarter Mr. Khimji J. Karia is informed that until the following requirements are complied with the plans cannot be passed.

- (1) The plans cannot be passed until all the objections communicated in this office no. 7457
- (2) dated 30.7.27 are complied with.

(3)

(4)

(5)

(6)

(7)

(8)

(9)

URGENT

The plans are returned herewith for amendment.

Please send for an builder's signature.

B. SC., A. M. I. C. E.,

Land Manager & Architect.

6/9/27

19

KHIMJI J. KARIA & CO.,

Engineers, Architects & Surveyors.



KMR.CDD.LyQ.1927-1929.01

No. — of 192 .

PRARTHANA SAMAJ ROAD,

Karachi, 10th Aug. 1927



URGENT

To,

The Land Manager and Architect,
Karachi Municipality.

B.S.
10/8/27

Sir,

URGENT

With reference to your No.L.M.A.7959, dated 30th ultimo, I have the honour to resubmit herewith fresh plans (in complete set of 4) of house on plot No.35 sheet K -2 Lyaree Quarter duly amended in the light of your remarks 1 to 7.

As regards your remark No.8 I beg to state that the ground near this plot is already higher than the other part of K-2 and the plinth of the proposed building will be kept to the level of that of the police lines in the east of the plot or to a level may be specified by you.

The plan may now kindly be approved at an date.

Thanking you.

Yours the Plans
Camille Pans
Install all the
Compld
I have the honour to be,
sir,
Your most obedient servant,

3/8/27 Khimji Karia

Submit the for
further orders. C.
10/8/27
11/8


Heard 12/8 1927



— PLAN OF PROPOSED BUILDING —
— ON PLOT N^o 55 & 56 SHEET K-2 —

— LVAREE QUARTER —

SCALE 8"=1"

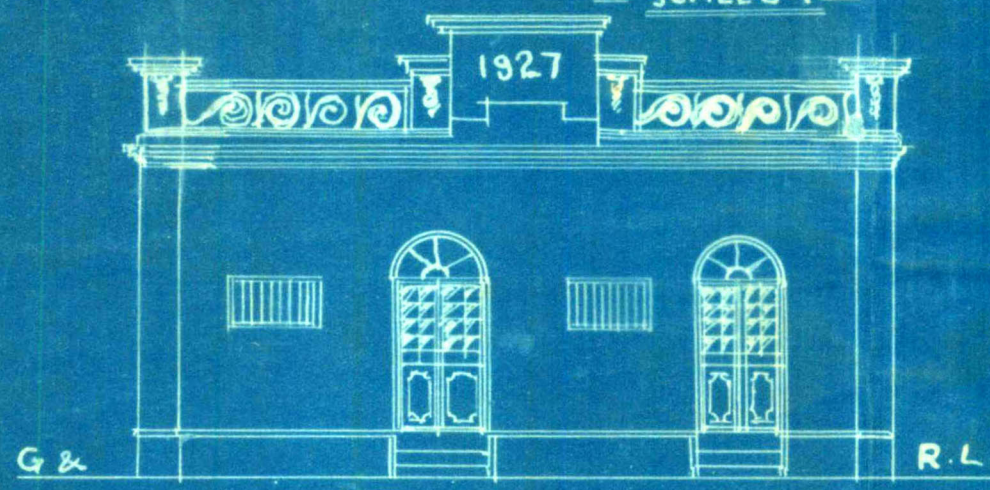


— SOUTH ELEVATION —

— BLOCK PLAN —
— SCALE 40"=1" —




ie Mahomed Usman

— OWNER —

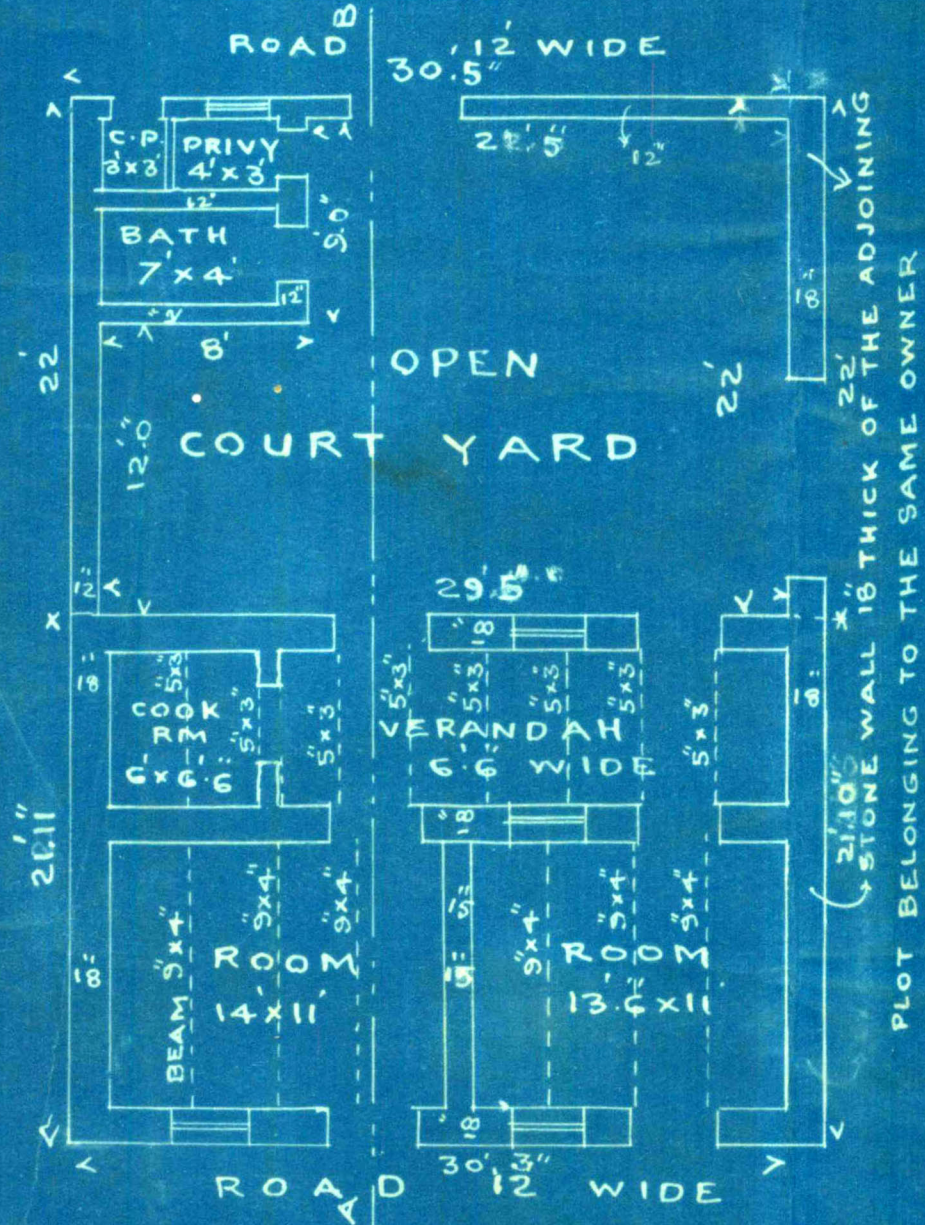

— PLAN OF GROUND FLOOR —

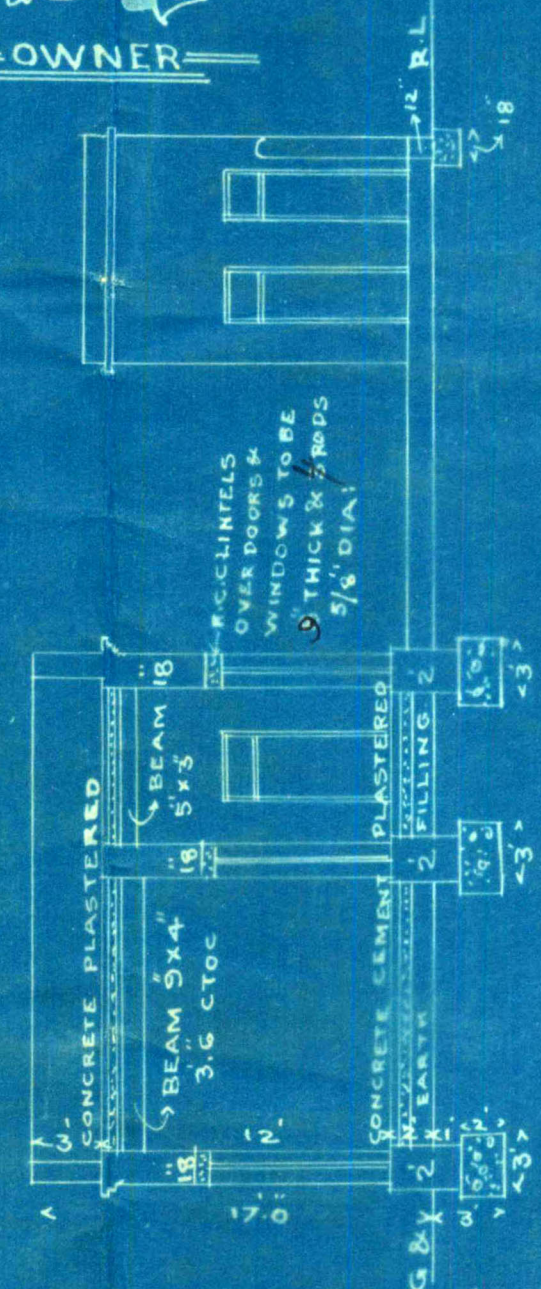

Khimji Karia
7.7.27.

ARCHITECT & SURVEYOR.