


PLAN OF PROPOSED BUILDING


ON PLOT N^o 239 SHEET N^o E. 4

RUNCHORE Q.R.


SCALE 8"=1'

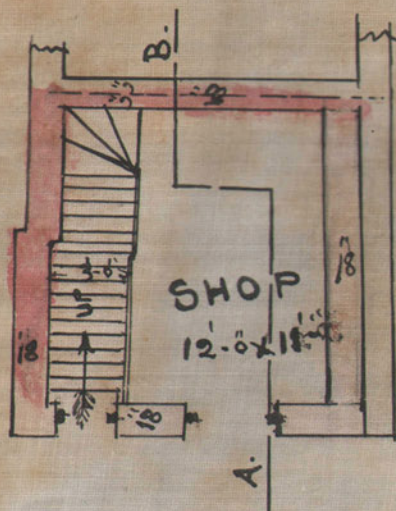

GROUND PLAN

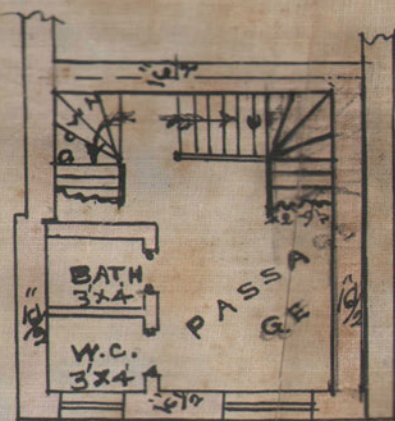


FIRST FLOOR PLAN

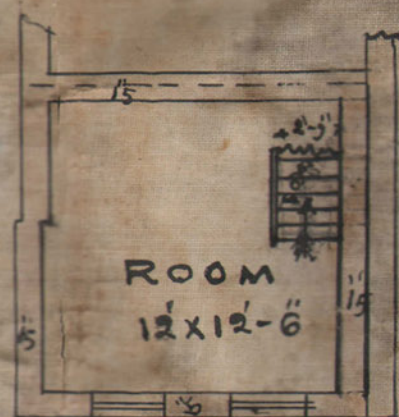


2ND FLOOR PLAN

APPROVED

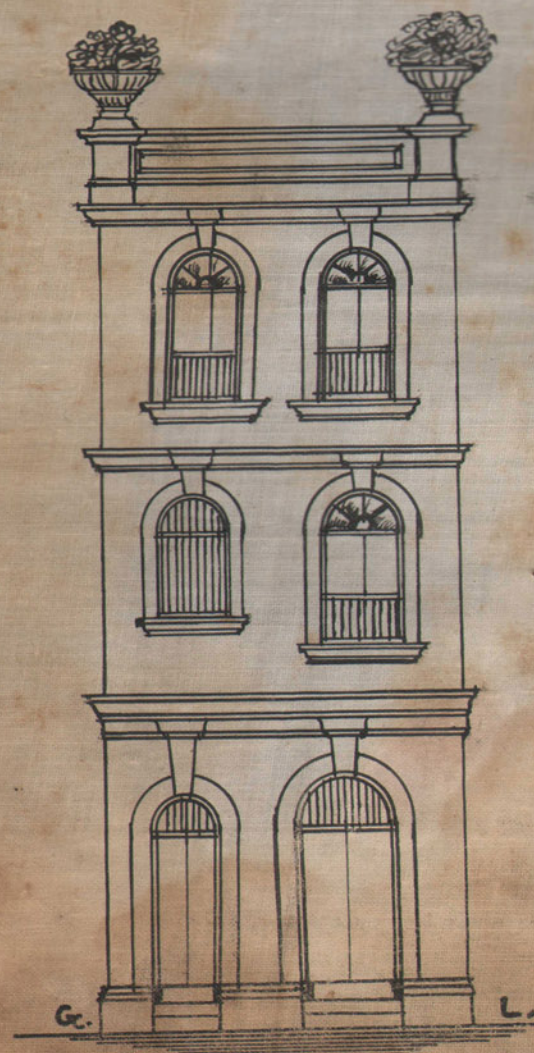

FRONT ELEVATION

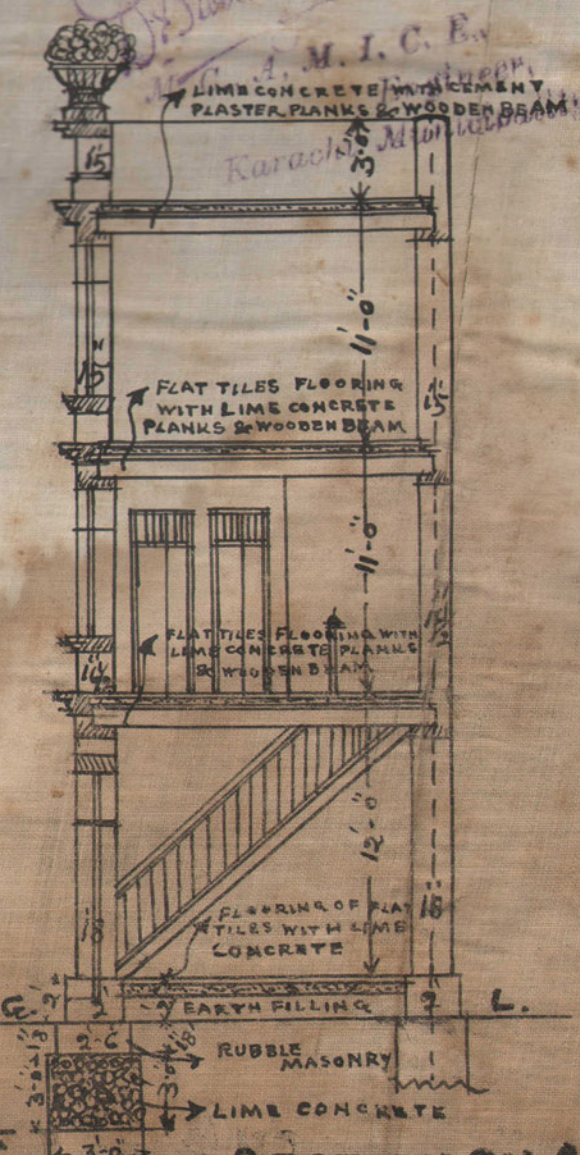


SECTION ON A.B.

L. E. VIRJI MOWJI

BLOCK PLAN

SCALE 20"=1'

POLICE CHOWKEY STREET 24' WIDE

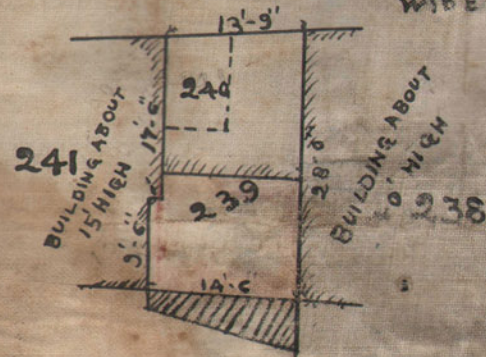

ALLIBODDA STREET 28' WIDE

T. N. Shivachandran, Architect & Surveyor



8
NO: L. S. 1507 of 1922

Municipal Office.

Karachi 18th March 1922

MEMO: -

With reference to his application dated the 7th Instant, with a plan for the proposed building on plot NO: 239, B-4 Runchore Quarter, Sutar Virji Mawji is informed, that he should construct a wall to the building to the east of his plot.

The plans are returned herewith for amendment.

M. C., A. M. I. C. E.

ENGINEER.

KARACHI MUNICIPALITY.

P.L.V.
16.3.22

En



Memo: —

with ref to his app dated the 7th
inst. with plan for the proposed Buildg
on plot no 239 S.4 Ranchore gr. Sutar
Virji. Manji is informed that he should
^{construct} a ^{to the building} wall to the east of
his plot.

The plans are returned herewith
for amendments.

14/3.
15

Eng

Form No. 1—500—24-12-21.

Karachi, 6th March 1922

Notice under Section 96 of Act III of 1901.

THE CHIEF OFFICER & CHIEF ENGINEER,

KARACHI MUNICIPALITY.

Sir,

I beg to inform you that I intend building _____

_____ on plot No. 239Survey Sheet No. E.4 situate in Alli BoodaStreet, Runchore Quarter.

As required by the Rules of the Municipality, I beg to submit herewith a plan of the same for your approval.

I beg to remain,

Sir,

Your most obedient Servant,

M-4227-1149
in c Virji Manji
 Signature of the Applicant.

No. G.

of 192 .

MUNICIPAL CHIEF OFFICER AND

CHIEF ENGINEER'S OFFICE,

Karachi, _____ 192 .

Forwarded to the Municipal Engineer for favour of disposal.

For Chief Officer and Chief Engineer,

Karachi Municipality.

Please Communicate
 with me at the following
 Address:

C/o Mr. Manishankar Jagatkar
 Government Telegraphs
 Karachi

No. E. 81 of 1922.

MUNICIPAL ENGINEER'S OFFICE,

Karachi, 7th March 1922.

MEMO:

The above application is forwarded to the Municipal Health Officer
for favour of report.



*Inspector allg.
Shun to the
mm*

7/3

4384

8/3/22

[Signature]
W. C. M. L. C. E.,

Engineer,
Karachi Municipality.

MUNICIPAL HEALTH OFFICER'S REPORT.

Returned to the Engineer, Karachi Municipality, with the following

Remarks:—

No objection


Date 8-3- 1922.

[Signature]
D. P. H. (London),
Health Officer,
Karachi Municipality.

No. E. 81 of 1922.

MUNICIPAL ENGINEER'S OFFICE,

Karachi, 7th March 1922.

Forwarded to the Building Surveyor and Land Surveyor for report.

[Signature]
M. C. A. M. J. C. E.,
Engineer,
Karachi Municipality.

BUILDING SURVEYOR'S REPORT.

Applicant's Name

Virji InarajiWhether he is the owner of the plot on which it is proposed to build Yes

Plot under whose control

Gout

Whether it is permanent or temporary

permanent

The work proposed

Building.

Building Surveyor's Report

See.

The eastern wall is a party wall
The owner should make his own
wall on the south. But as the
plot is too small I don't see
any necessity to have his own
wall.

There does not appear any other
objection

Date

10/3/22

[Signature]
Building Surveyor.



11-3

3

LAND SURVEYOR'S REPORT.

Does the plot come under Alignment has been running under alignment
has been set back

Area of plot _____

Area under Alignment _____

Remarks Lis

There appears no objection to
approve the plan.

Date _____ 192 _____

Land Surveyor. 10/8

ORDER OF THE ENGINEER.

Wall must be provided to the Port.

13/9 DB

M. C., A. M. INST. C. E.,

Engineer,
Karachi Municipality.



No. L. S. 4707 of 1922.

MUNICIPAL ENGINEER'S OFFICE,

Karachi, 10th June 1922.

Submitted to the Managing Committee for information.

M. C., A. M. I. C. E.,

Engineer,

Karachi Municipality

Through

THE CHIEF OFFICER & CHIEF ENGINEER,

Karachi Municipality.

RESOLUTION OF THE MANAGING COMMITTEE.

Resolution No. _____ dated _____



