



①

Form No. 30—500—1.8.1921.

L. S.

of 192 .

MUNICIPAL OFFICE,

Karachi, 24th June 1921

MEMO:—

With reference to his ~~their~~ application with plan received on 28thMay 1921 for building on plot No. 9

(2)

657

③

47

4

57



Heritage

KMR.CDD.PrQ.1921.01



(5)

Building Completion Report.

MUNICIPAL OFFICE,

Karachi, 16th Feb 1921.
17

To

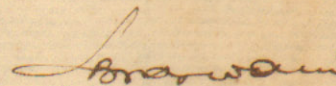
THE ENGINEER,

KARACHI MUNICIPALITY.

SIR,

I beg to report, the building work on plot No. 7 Sheet 73
Preedy Quarter owned by Mr. Bhojig Lalchand
is completed according to the plan approved by the Municipality. Orders are
requested to file the correspondence.

Yours obediently,

Building Surveyor "A" Section,
Karachi Municipality.

Copy forwarded to the A/c

for information
Barrington Brown,
M.O., A.M.I.C.E.,
Engineer,
Karachi Municipality.



(6)

No. L. S. 8594

OF 1921

No. 66

Form No. 6-300-9-4

MUNICIPAL OFFICE,

Karachi, 2 2 1921.

MEMO:

Building Surveyor Section A is informed
 that Mr. Bhaji Lalchand has been permitted
 to build a shed
 _____ his house
 on plot No. 7 F3 Bunder Street
Ready Quarter report should be made to the
 Undersigned when the house is completed.

Bhaji Lalchand
Bhaji Lalchand

M. E. A., M. I. MECH. E.,

Ag. Engineer,

Karachi Municipality.