



N.B. ■ NEW WORK
 ■ WORK TO BE DEMOLISHED
 ROUND BEAMS 1" & 9" DIA

PLAN SHOWING A^{DD} AND A^{LT} IN B^{LG} ON PLOT
 N^o 190 SHEET N^o E-1 JAIL QUARTER.
 scale 8" = 1"


N.B. AREA OF PLOT NO 190 = 109.35 SQ YARDS
 AREA OF PLOT NO 190 A = 109.35 SQ YARDS
 TOTAL 218.70 SQ YARDS
 ORIGINAL AREA 218.70 SQ YARDS

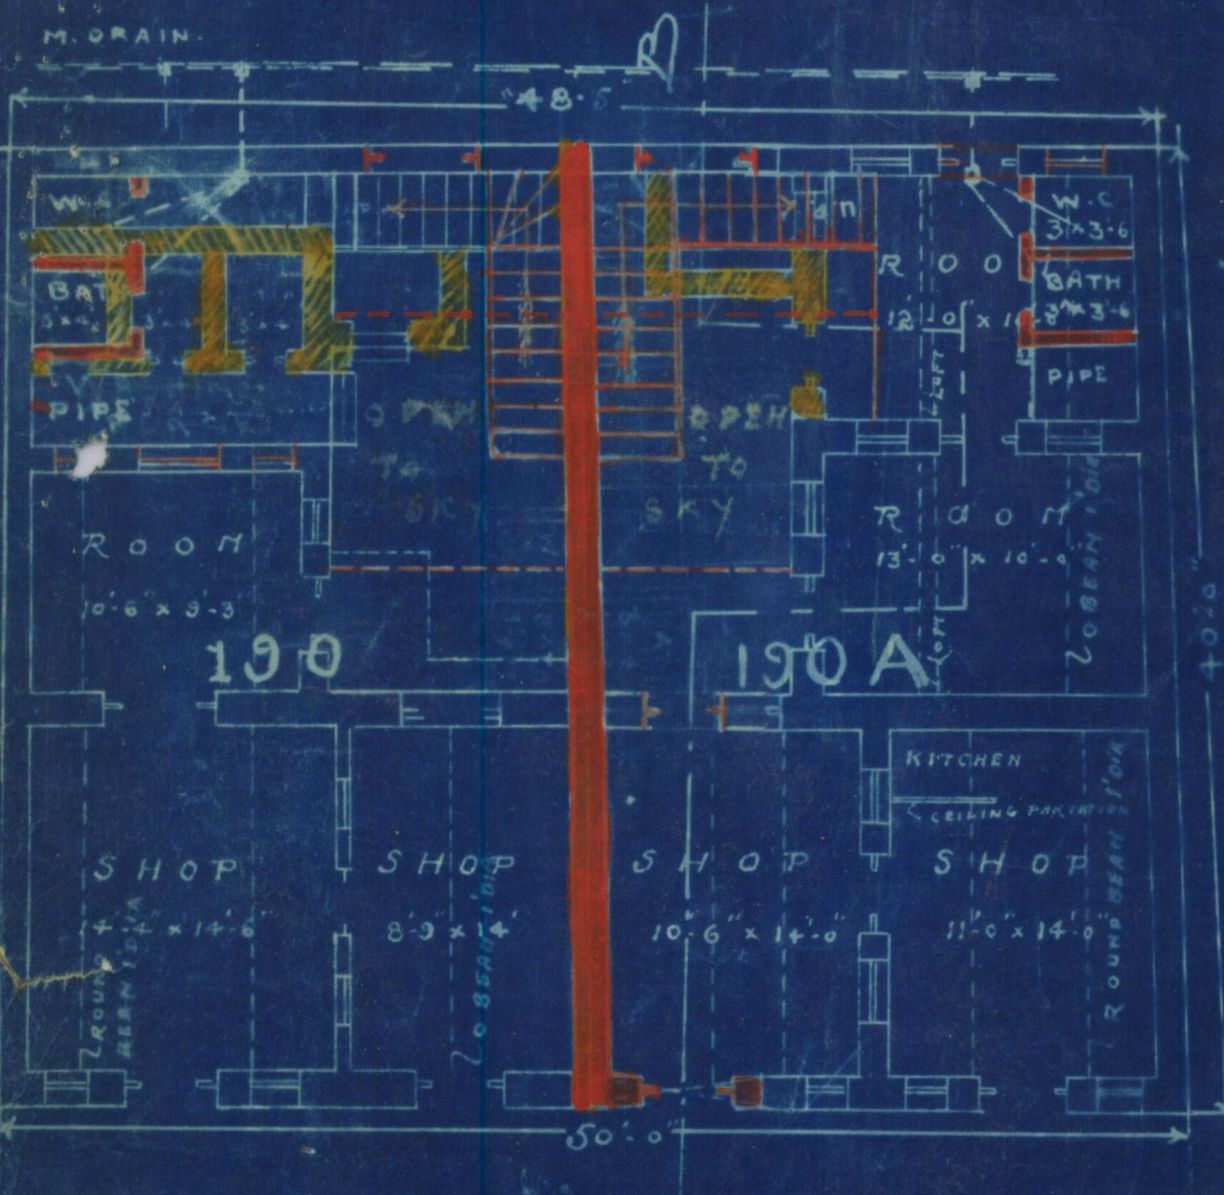

GROUND FLOOR PLAN.

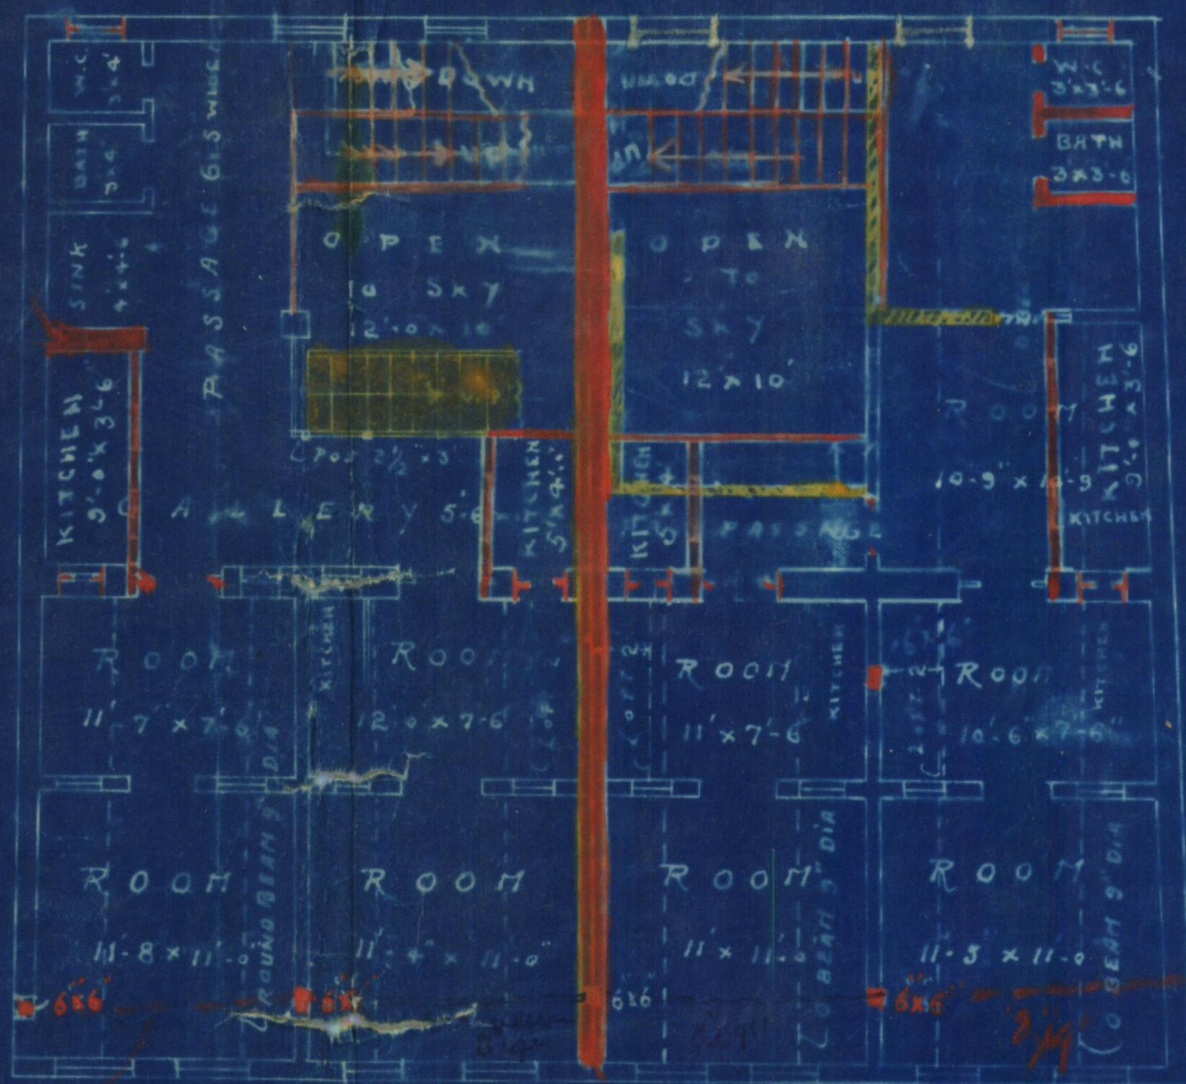

FIRST FLOOR PLAN

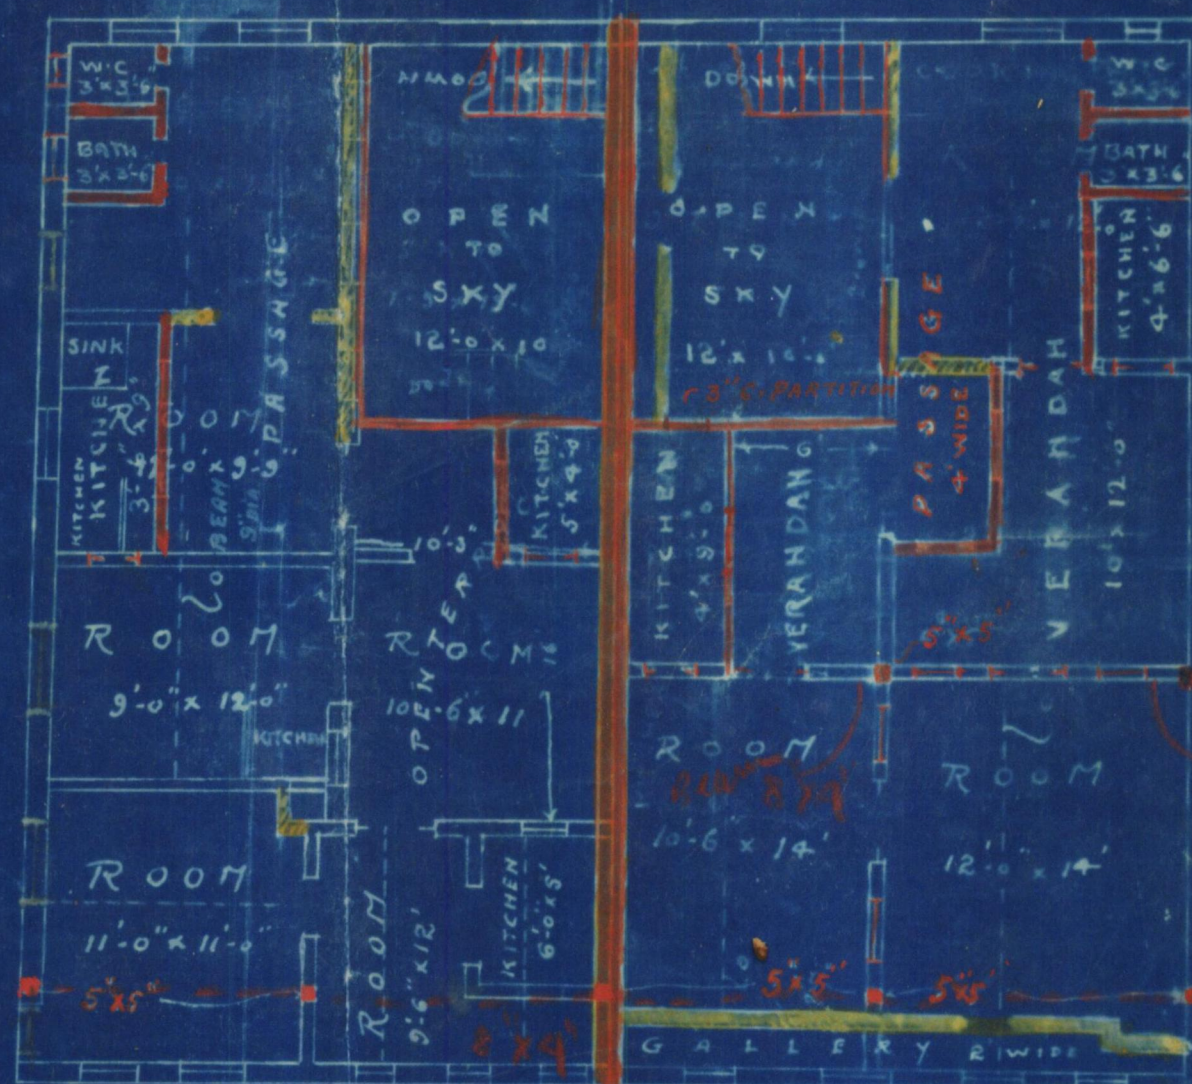


SECOND FLOOR PLAN

ELEVATION



SECTION ON A.B

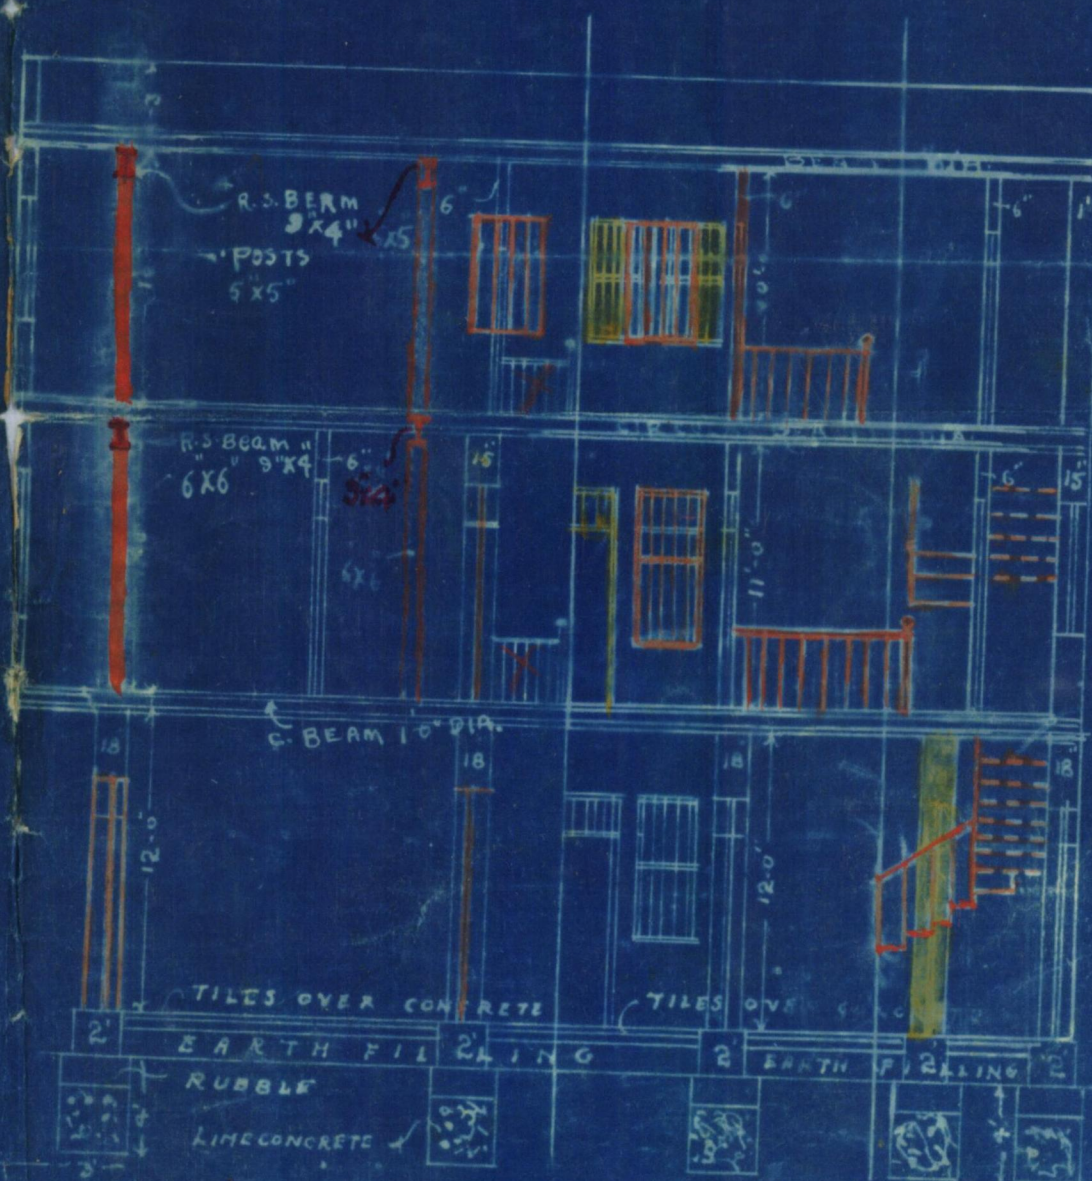

SITE PLAN

Scale 40' = 1"



Hirashan P. Pathak
 PATHAK AND CO.
 ARCHITECTS AND SURVEYORS
 KARACHI