


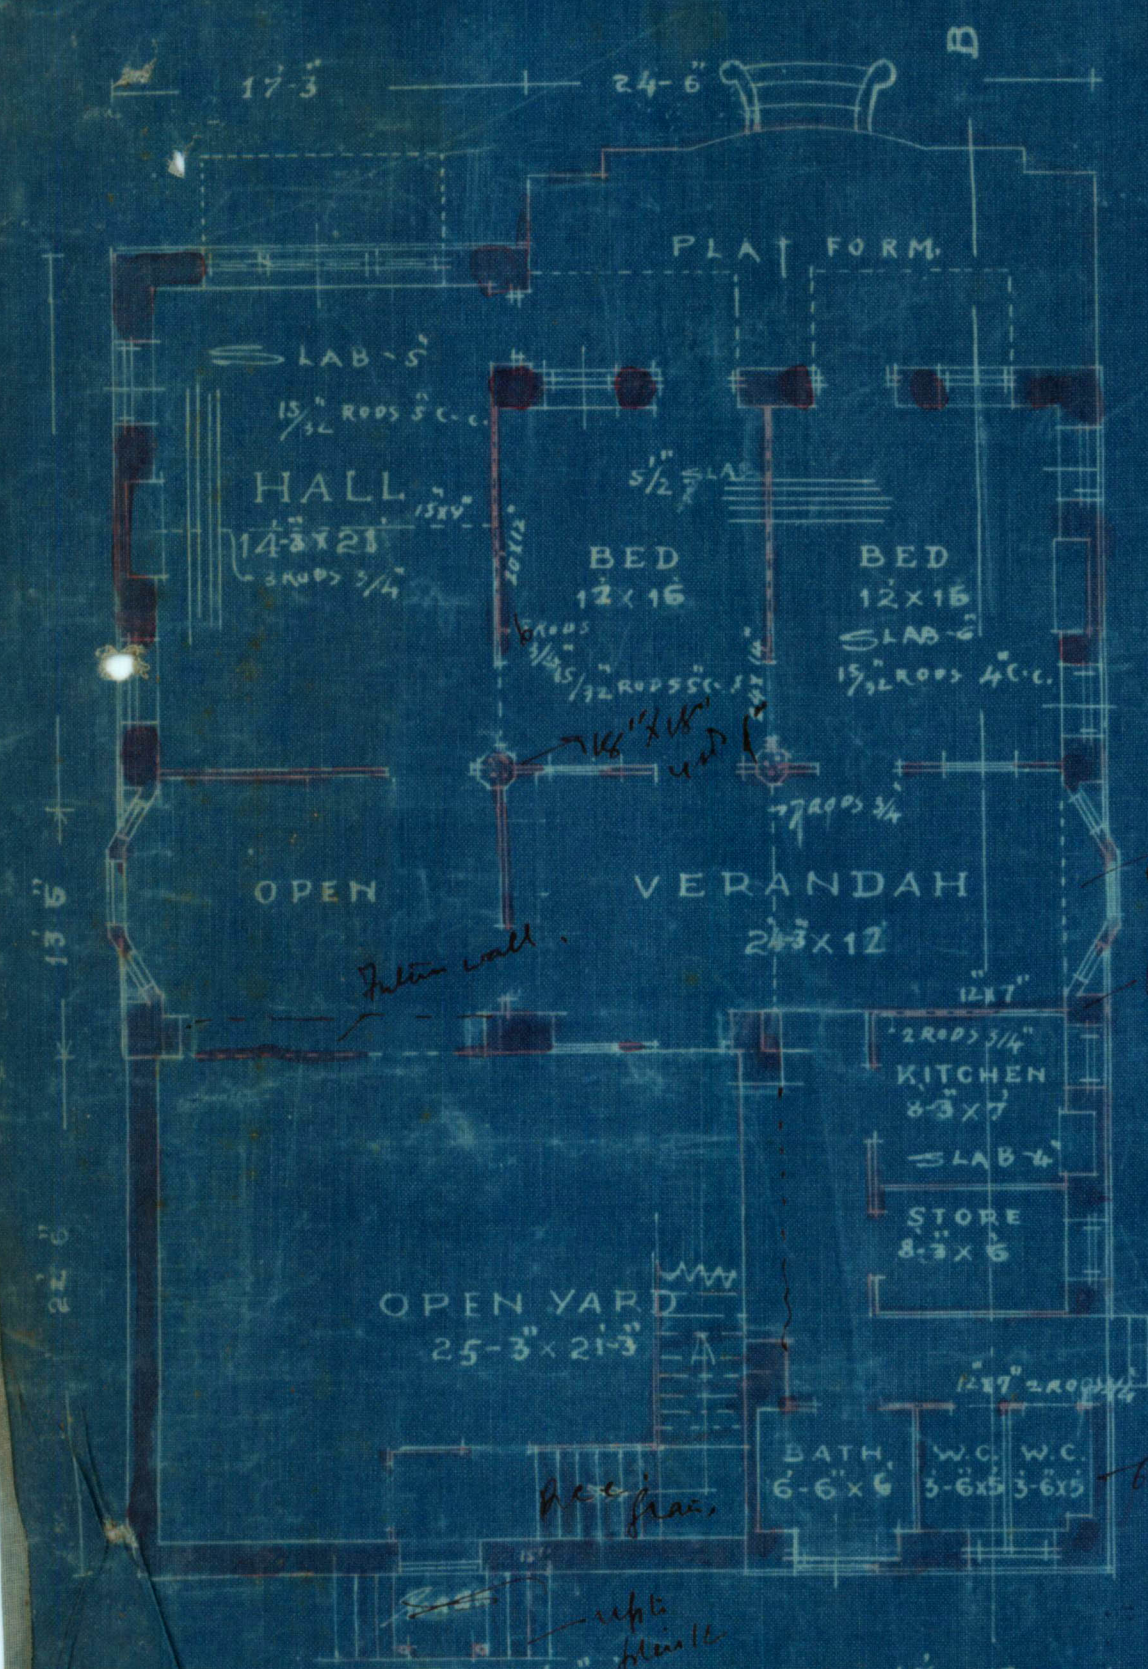

GROUND FLOOR  
ELEVATION




TOTAL AREA OF THE PLOT 1695 Sq. Yds.  
BUILT UP AREA OF THE PLOT 1695 Sq. Yds.  
1 x 48'7.5" x 31'35" = 1374.60  
1 x 22'5" x 15" = 337.50  
1 x 14' x 4' = 56.00  
1 x 17'25" x 5' = 86.25  
1734.35  
DEDUCT 1 x 12' x 15' x 15' = 225.00  
1509.35

## CEMENT LINTELS

| SPAN | 3' = 6" | TO 4' = 7' | 4' = 7' | 5' = 8" | 5' = 8" | 6' = 9" | 6' = 9" |
|---|



PLAN  
SHOWING PROPOSED BUNGALOW  
ON PLOT No 57 SHEET No JM2  
JAMSHED QUARTER  
SCALE 8"=1'


FIRST FLOOR.

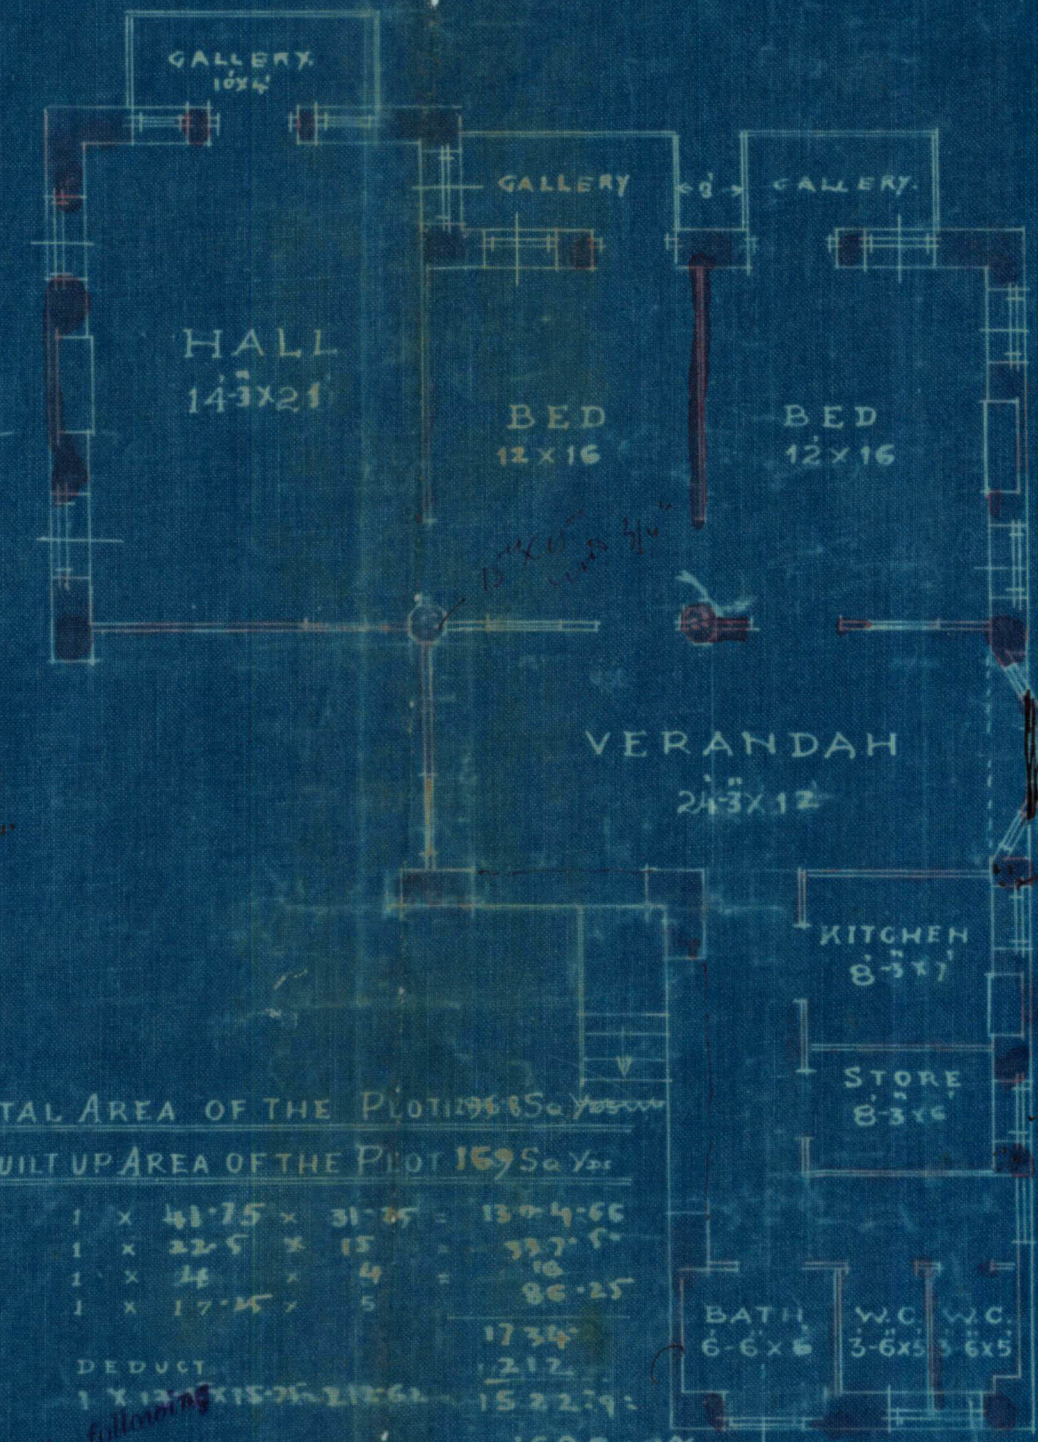

LONGITUDINAL SECTION OF T BEAM A (15' x 9')




CROSS SECTION OF  
T BEAM A (15' x 9')

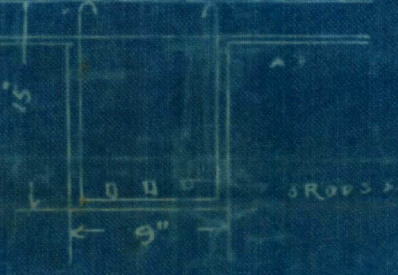

APPROVED.

DURGAS B. ADWANI  
KARACHI

COMP WALL

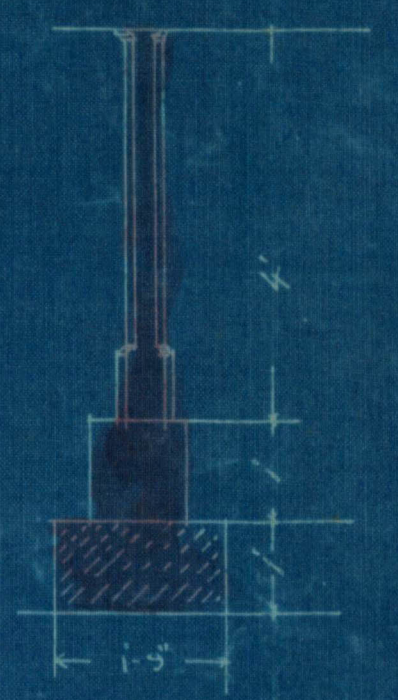

BLOCK PLAN  
SCALE 20"=1'

