

PLAN FOR PROPOSED BUNGALOW ON
===== PLOT NO. 12 J.M. JAMSHED GR. =====

SITE PLAN
SCALE 40=1

Rani Bai B. Adani




U.N. FARMAR
D & T BY

OWNER


SPAN	SIZE	REINFORCEMENT	SPAN 3-6 TO 4	7" THICK	4 NOS 3/8" DIA
8 FEET	5'x8"	3 RODS 1/2" DIA	4-6 TO 5	8"	4 " 1/2" "
10 "	5'x10"	3 RODS 1/2" "	5-6 TO 6	9"	5 " 1/2" "
12 "	5'x12"	3 " 3/8" "	6-6 TO 7	10"	4 " 3/8" "
14 "	6'x12"	3 " 5/8" "	7-6 TO 8	12"	4 " 5/8" "
16 "	7'x14"	3 " 5/8" "			

PLAN FOR PROPOSED BUNGALOW ON
PLOT NO. 12 J.M.S JAMSHED PUR
 SCALE 1"=10'

BUILT AREA	
(1) 1 X 17'-0" X 10'-0" = 170.00	(14) 1 X 17'-0" X 1'-6" = 25.50
(2) 1 X 24'-6" X 28'-6" = 698.25	(15) 2/3 X 14'-0" X 1'-6" = 14.00
(3) 1 X 17'-6" X 1'-6" = 25.50	(16) 1 X 15'-0" X 7'-6" = 112.50
(4) 1 X 14'-3" X 1'-6" = 21.37	(17) 1 X 6'-0" X 1'-6" = 7.00
(5) 2/3 X 14'-0" X 1'-6" = 14.00	2890.87
(6) 2/3 X 11'-3" X 1'-6" = 11.25	TOTAL AREA = 969 SQ. Yds
(7) 1 X 26'-0" X 29'-0" = 754.00	BUILT AREA = 321.2 " "
(8) 1 X 7'-0" X 10'-6" = 73.50	ALLOWABLE " = 323 " "
(9) 1 X 9'-5" X 10'-0" = 95.00	
(10) 1 X 17'-0" X 1'-5" = 25.50	
(11) 2/3 X 14'-0" X 1'-6" = 14.00	
(12) 1 X 26'-0" X 29'-0" = 754.00	
(13) 1 X 7'-0" X 10'-6" = 73.50	

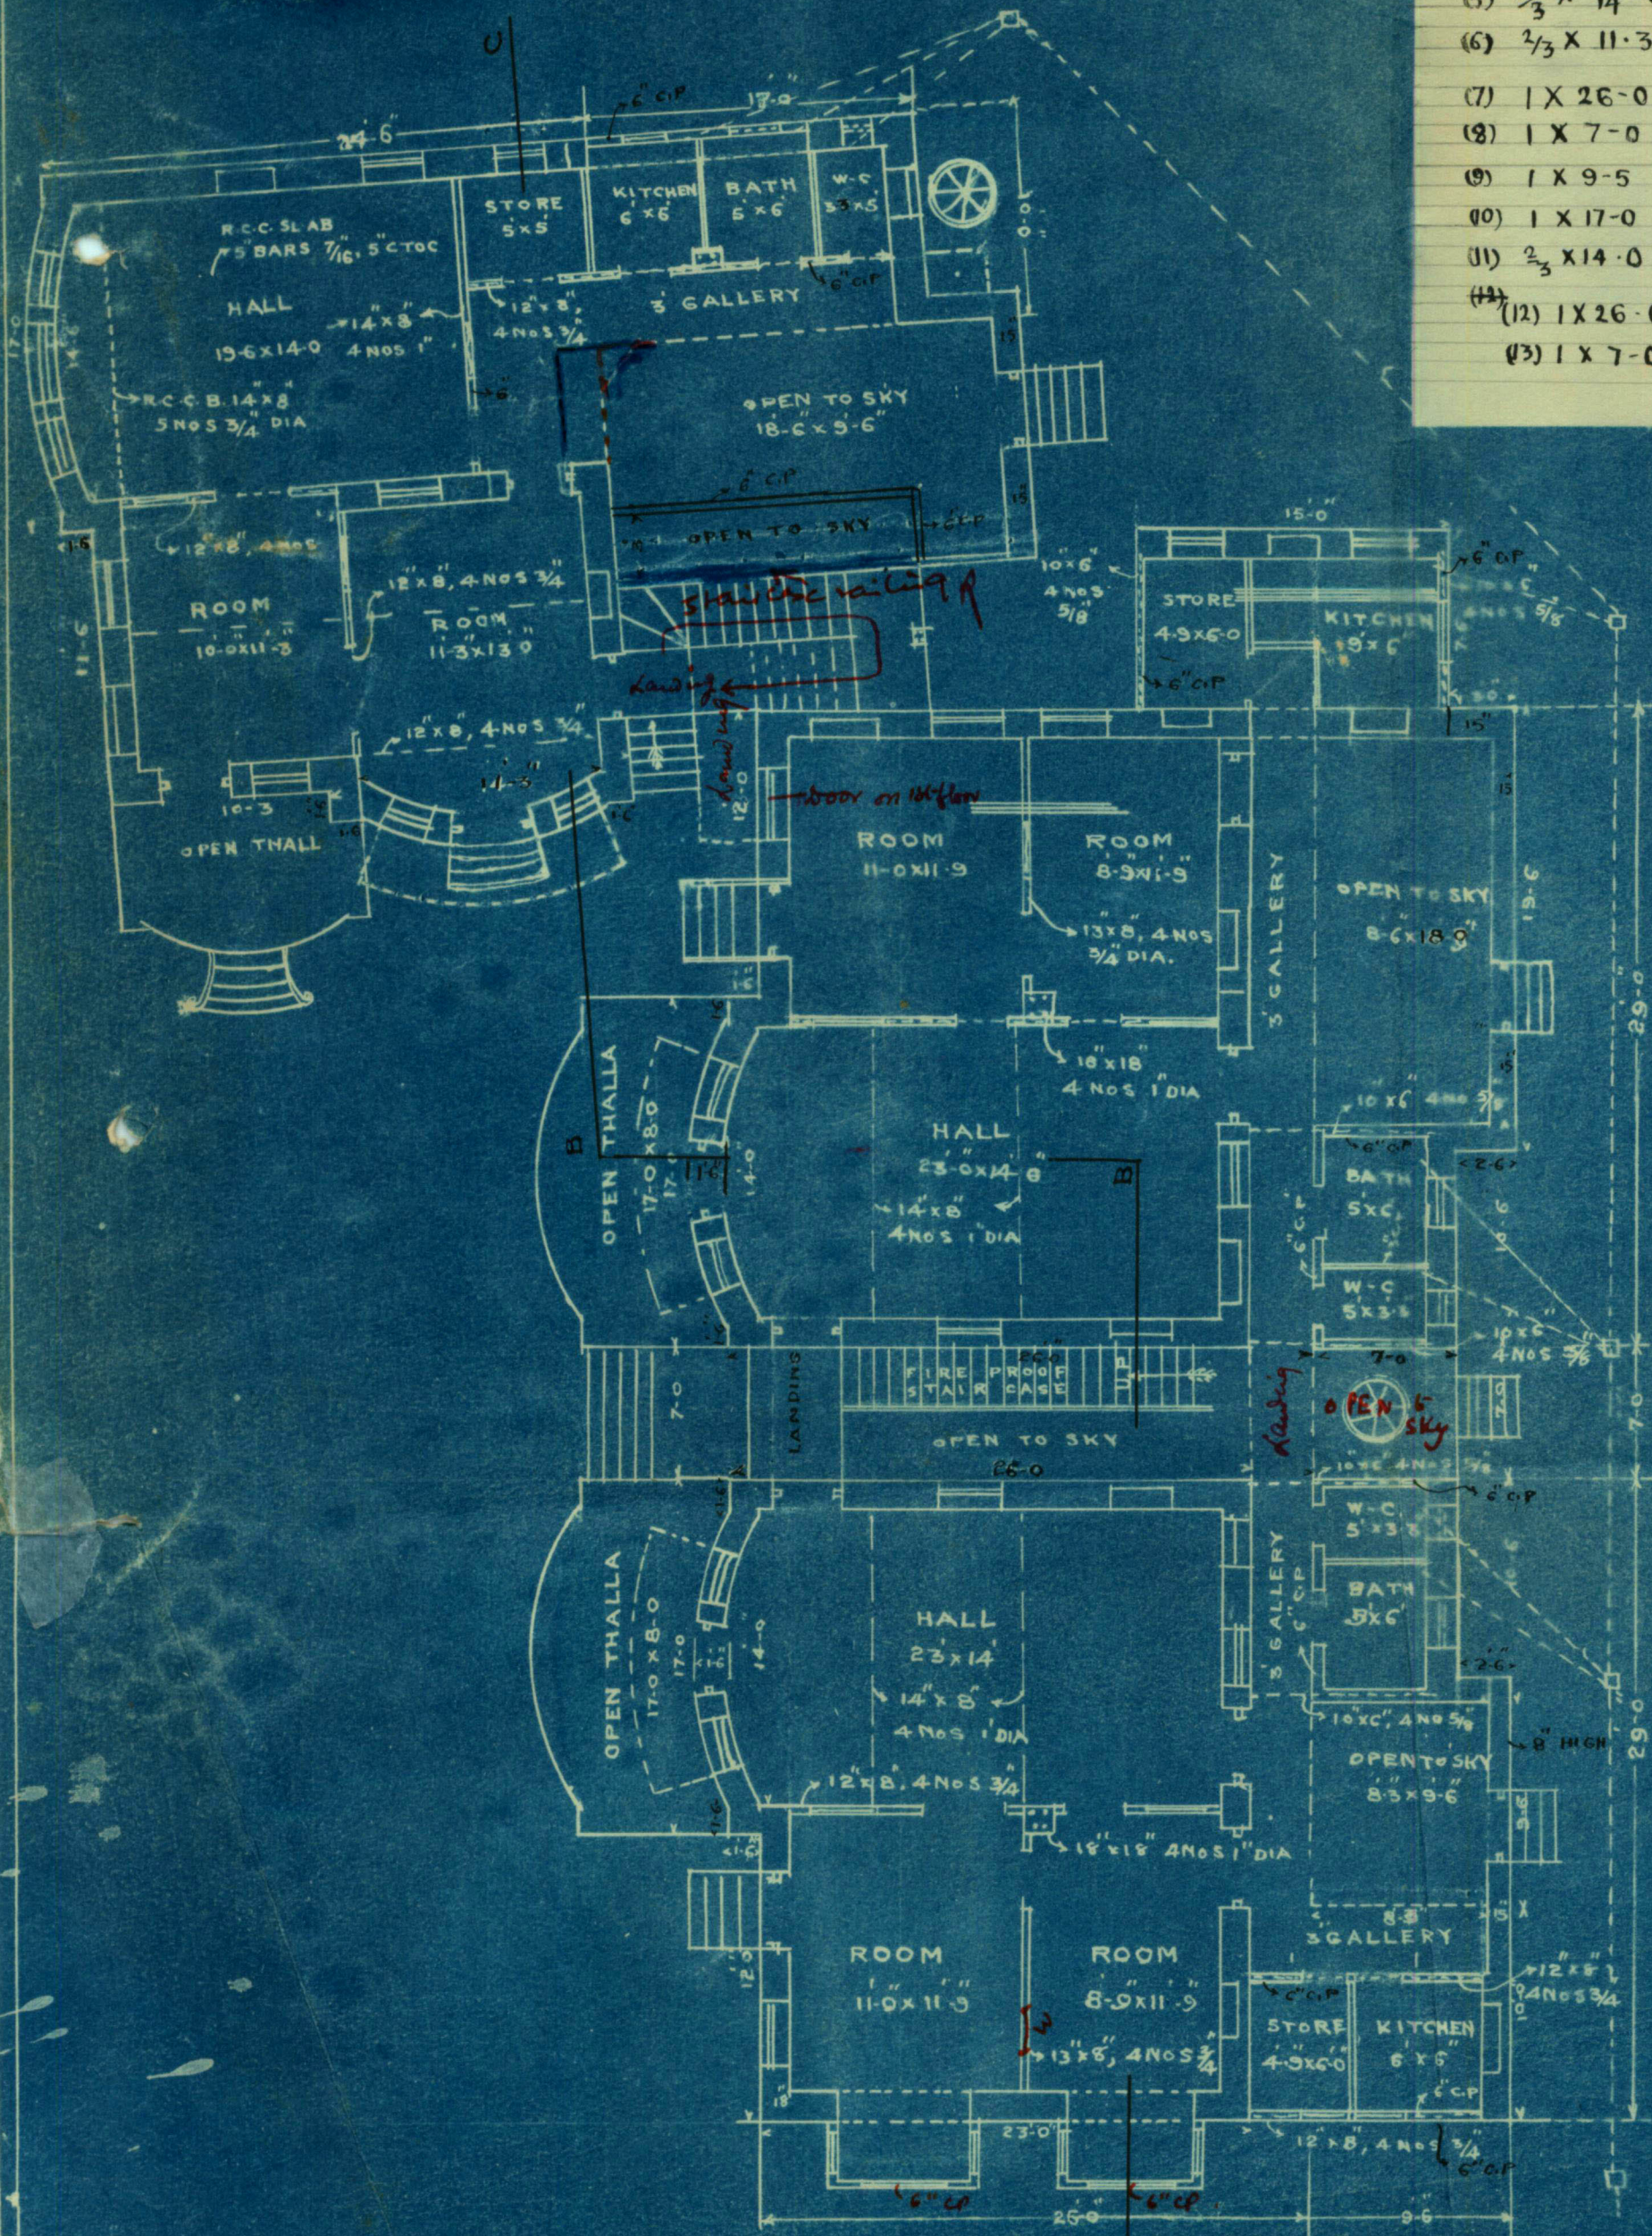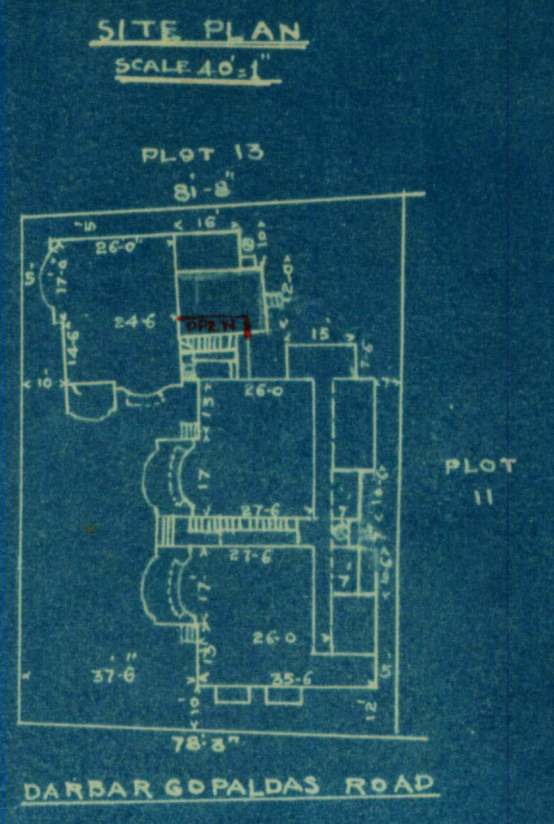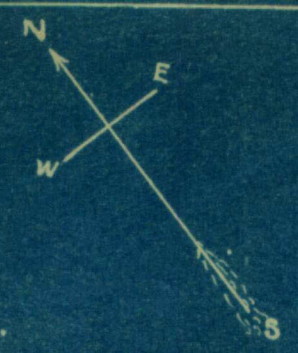

GROUND & FIRST FLOOR

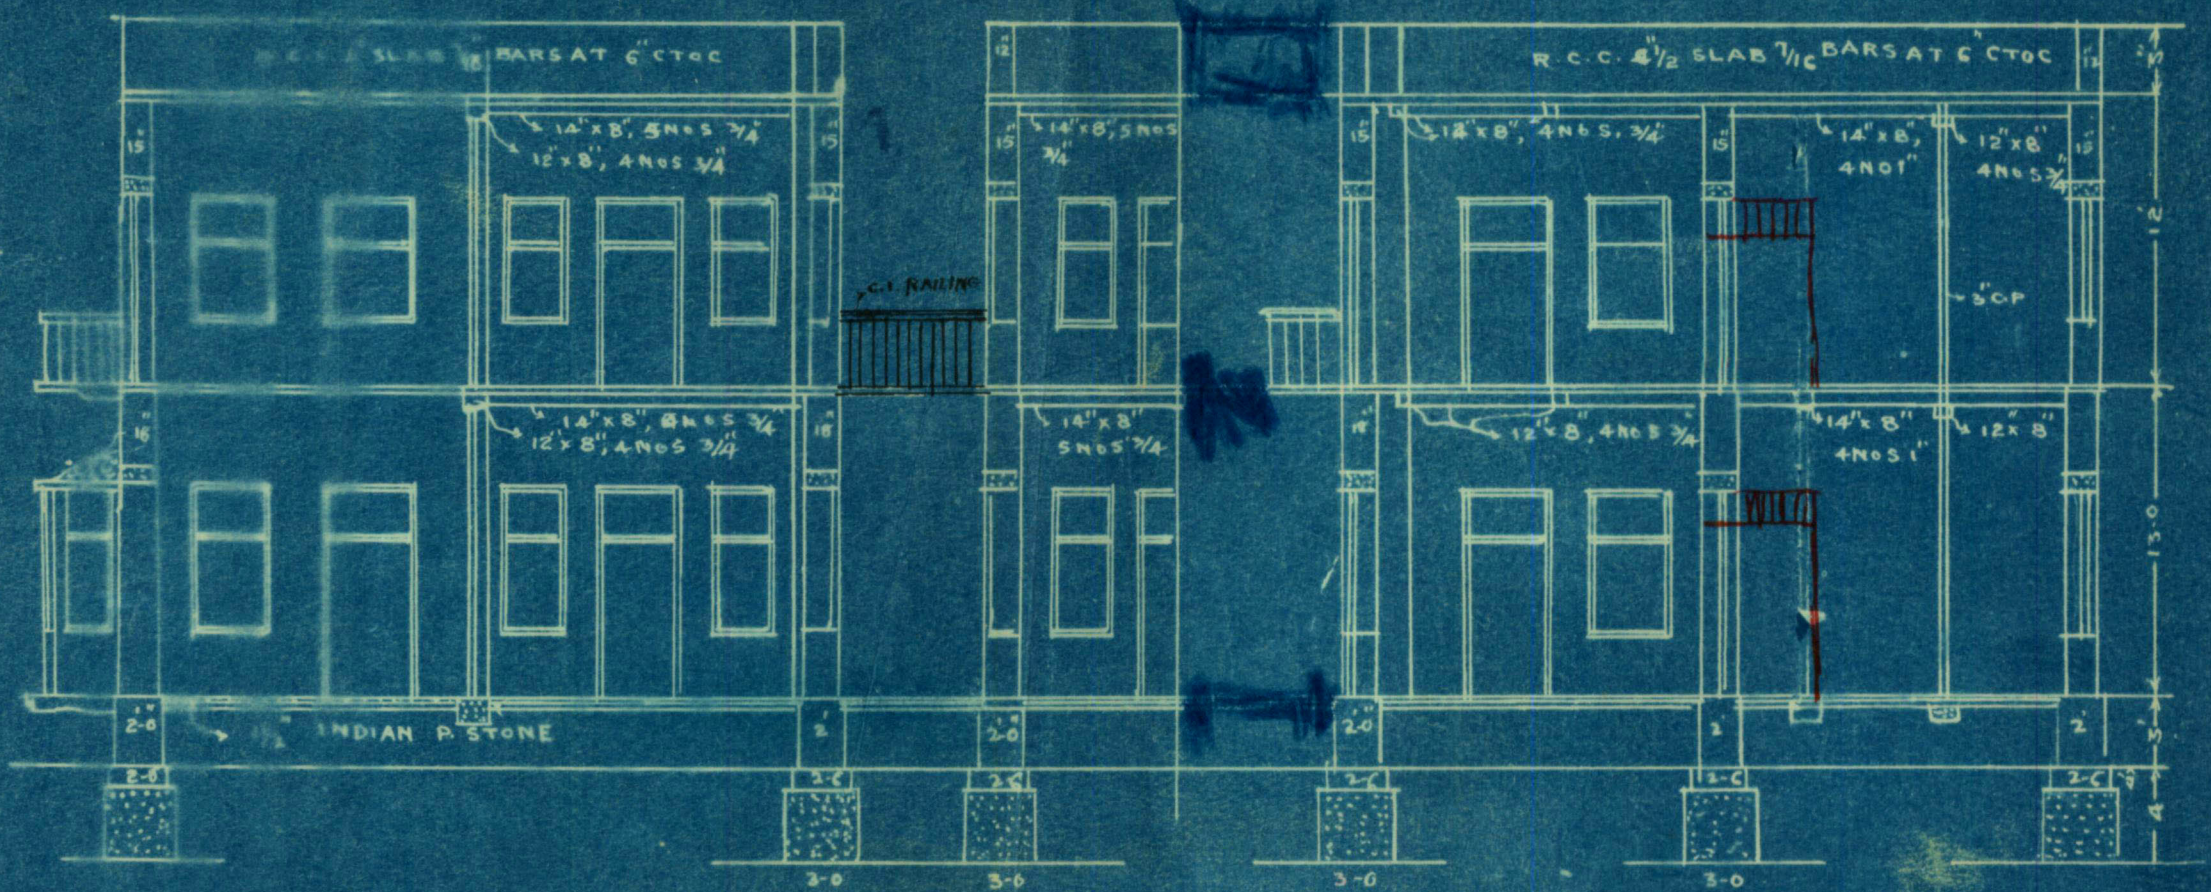

SECTION ON ABC



ELEVATION

PLAN FOR PROPOSED BUNGALOW ON


—PLOT NO. 12 SHEET NO. J.M.5—

JAMSHEDPUR

SCALE 8/101



GROUND & FIRST FLOOR

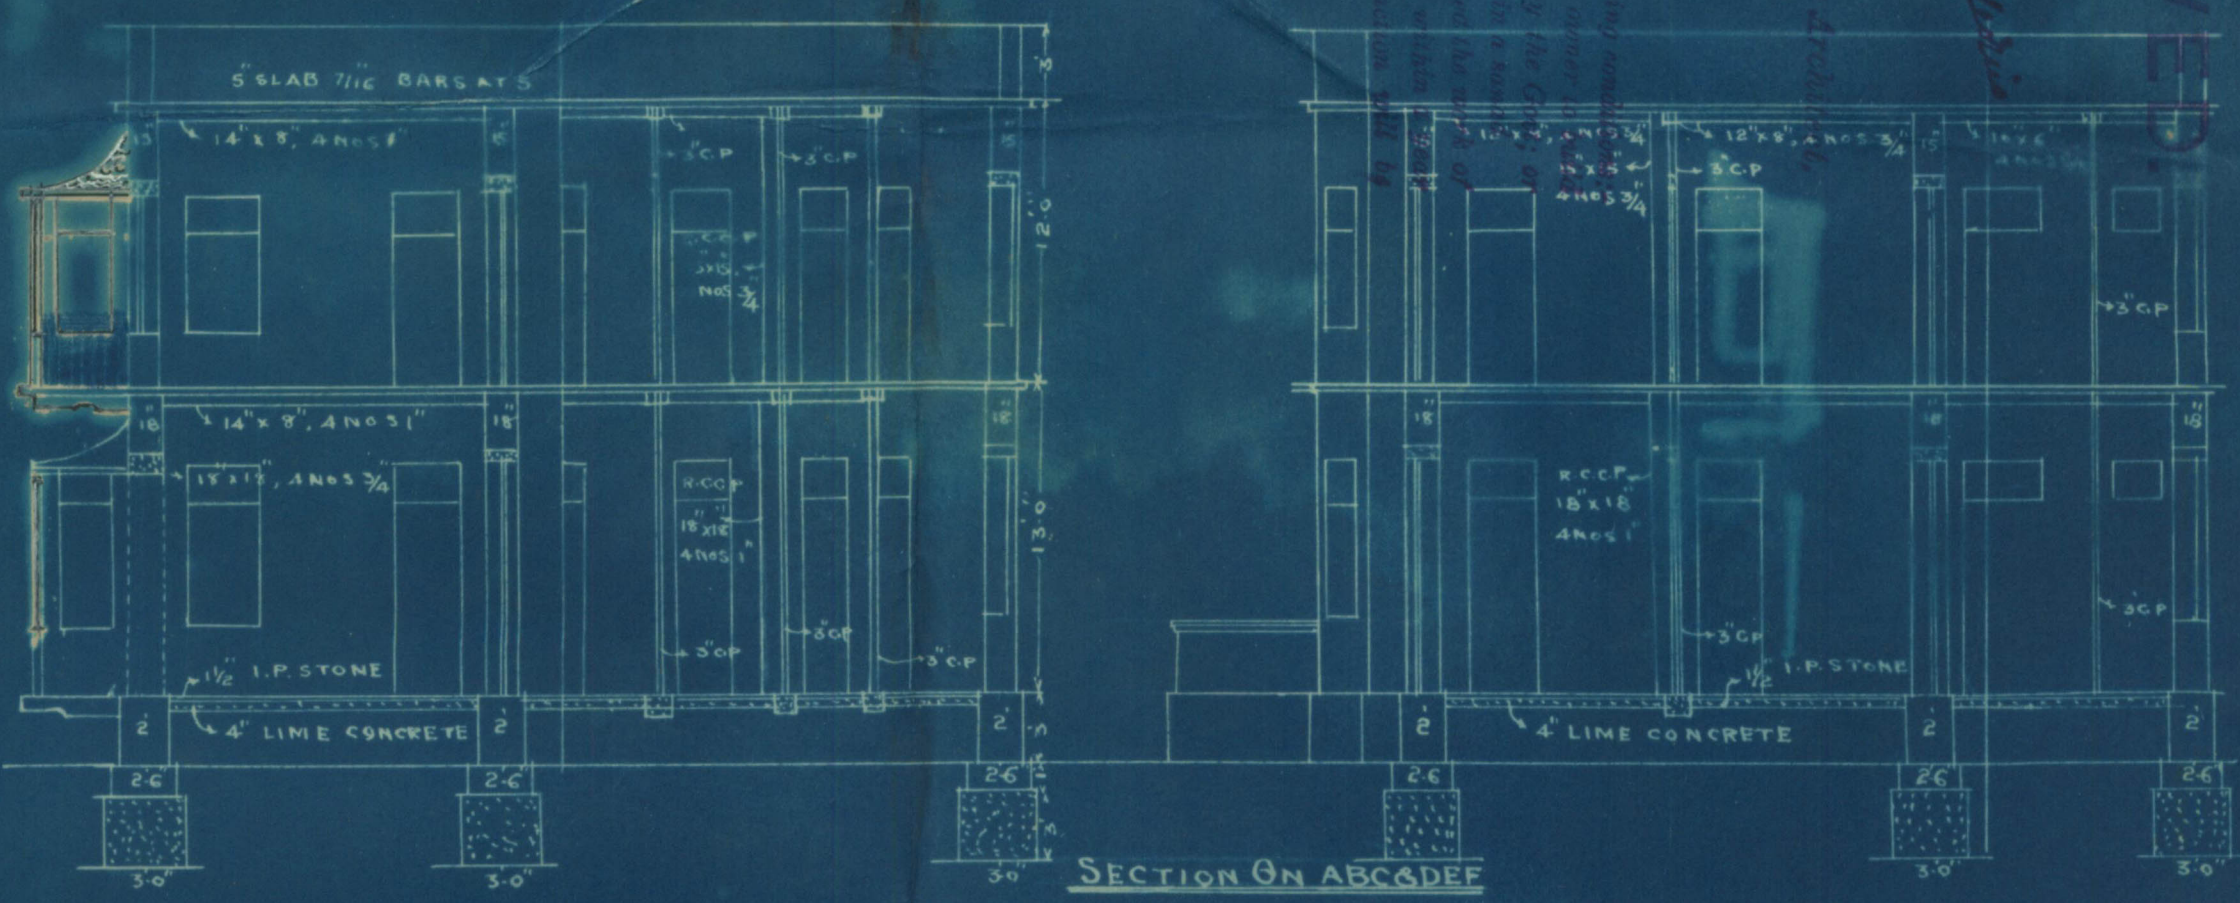


SECTION G-N A-B-C-D-E-F



ELEVATION

BUILT AREA	
BUILT AREA	322.8 SQ. YDS.
TOTAL PLOT AREA	96.3 SQ. YDS.
2 x 17'-0" x 27'-6" = 935.00 SQ. FT.	
2 x 12'-0" x 16'-0" = 324.00 "	
2 x 9'-0" x 8'-0" = 144.00 "	
2 x 30'-4'-6" x 27'-0" = 1680.00 "	
1 x 70'-3'-0" x 21'-0" = 1476.30 "	
1 x 7'-0" x 6'-0" = 42.00 "	
1 x 14'-0" x 16'-0" = 224.00 "	
1 x 19'-3'-0" x 18'-2'-8" = 354.75 "	
1 x 4'-6" x 16'-0" = 72.00 "	
1 x 3'-0" x 16'-0" = 48.00 "	
1 x 12'-0" x 3'-0" = 36.00 "	
1 x 10'-0" x 21'-0" = 210.00 "	
84 YDS. 322.88 (299.12) SQ. FT.	

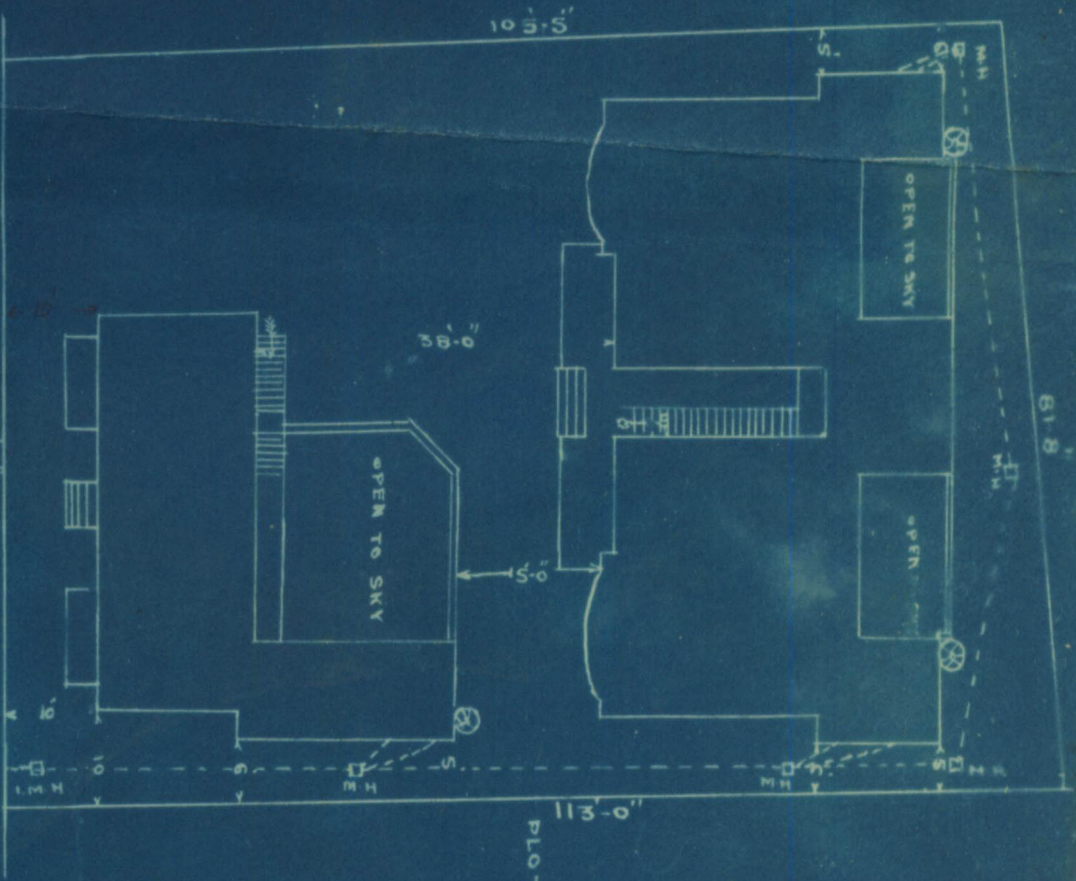

SITE PLAN

Ravi B. Adani

OWNER

P. J. BHAWANI

ARCHITECT & ENGINEER