
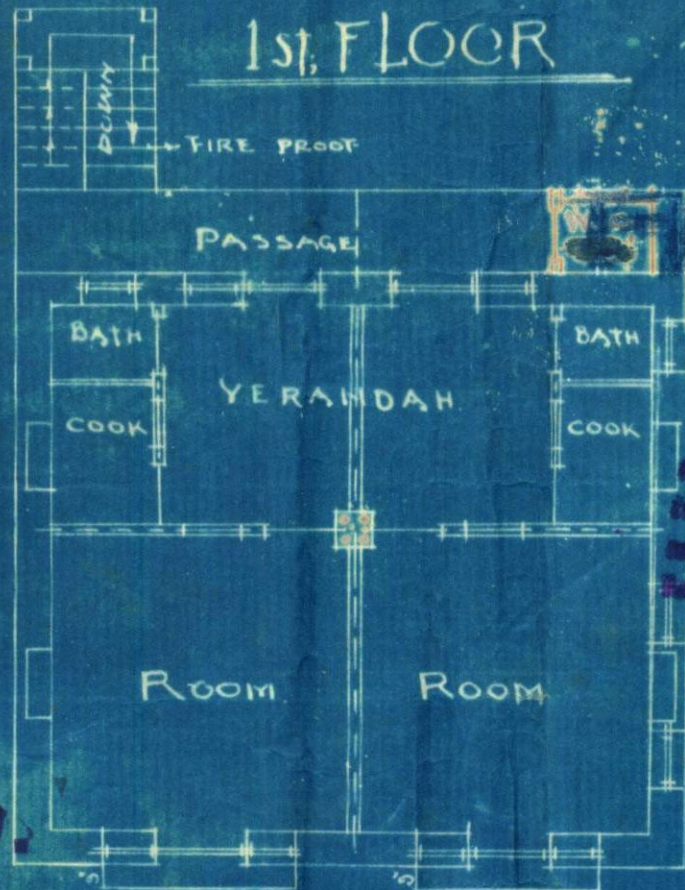


PLAN SHOWING PROPOSED BUILDING
ON THE PART OF PLOT No 24 LR 7 LAWRENCE QRT.
SCALE 8' to 1"

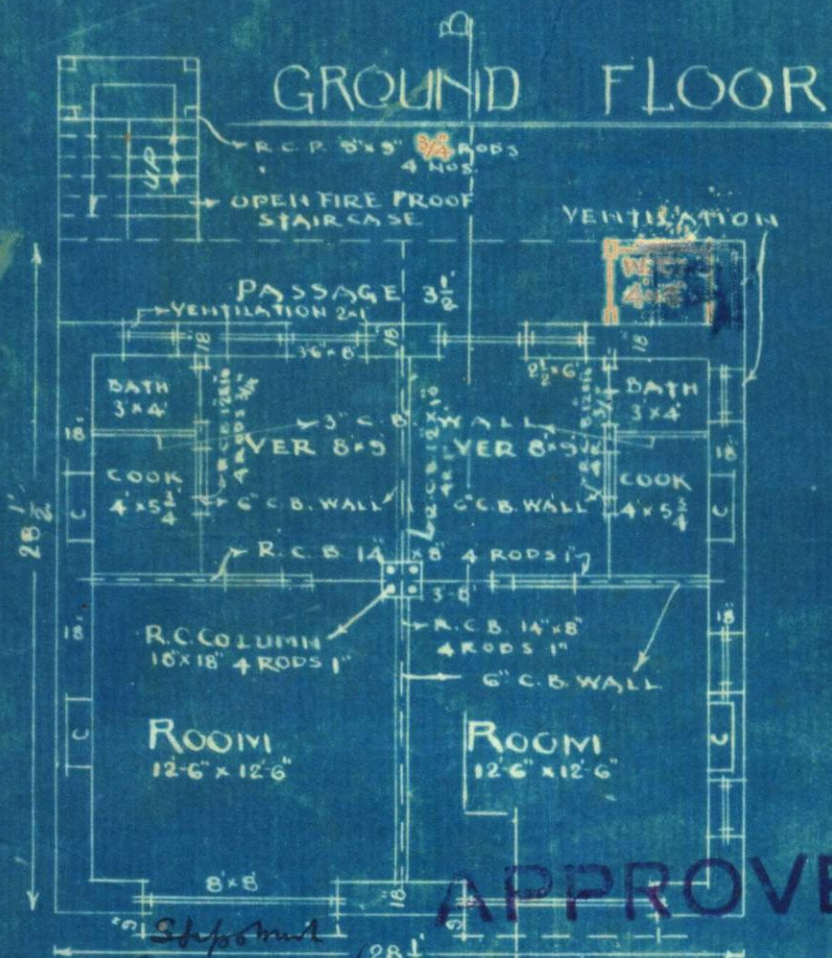


This document under 1000, provision
the work of construction is commenced
in earnest within a hour from this date,
whereafter the contractor will be bound
to have prompt.

APPROVED


R. J. Modi

SECTION ON A.B.

B. B., Jr. M. Inst. C. E.,
 Civil Engineer & Architect.

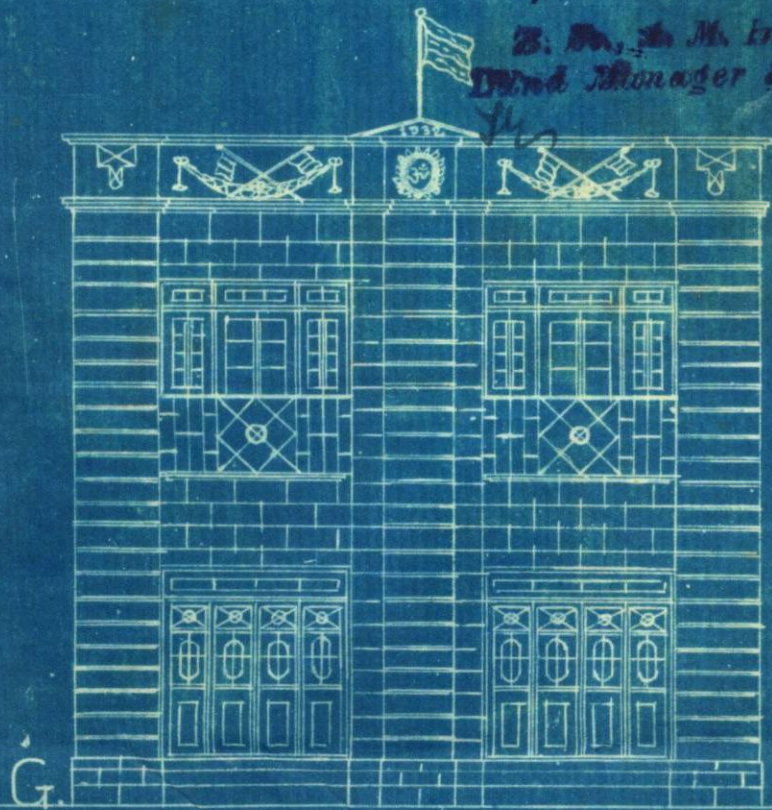

FRONT ELEVATION

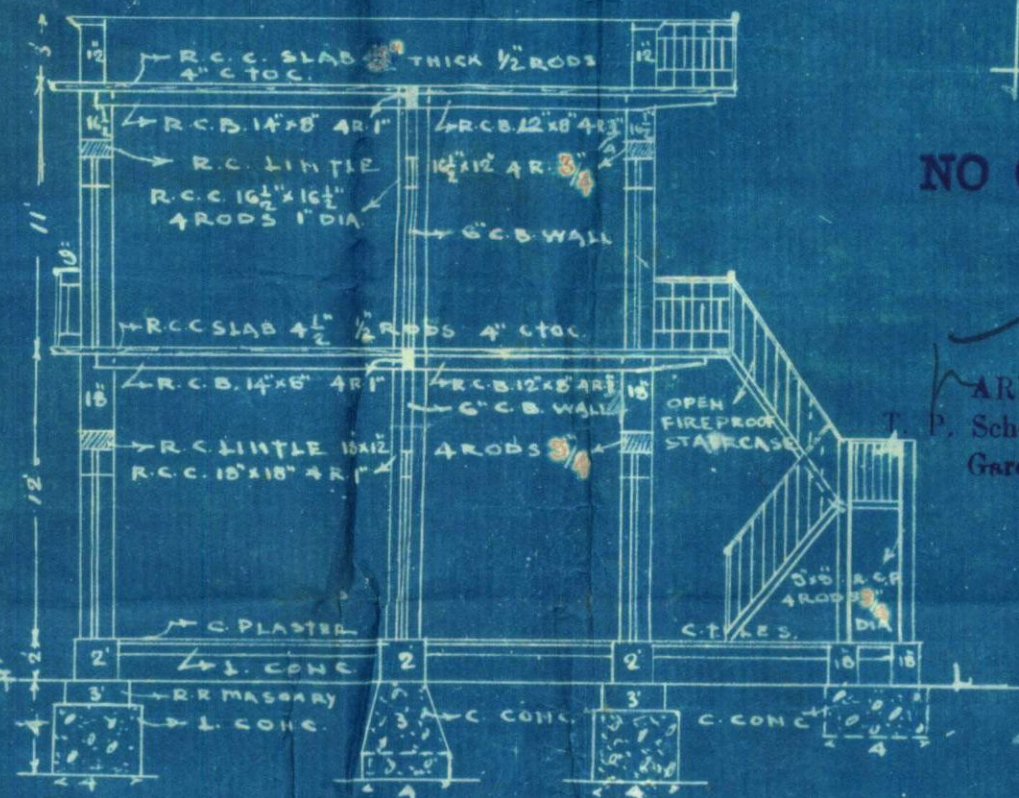

NOTE,
AREA OF THE ENTIRE PLOT $4032\frac{2}{3}$ SQ YOS.
EXISTING BUILT UPON AREA 1107 "
PROPOSED AREA 81.22 "

NO OBJECTION.

Note:
Plan is approved subject to the following conditions:-



1. This surcharge does not entitle the owner to build on land not conveyed to him either by the Govt. or the Municipality, by a grant or contract or a deed.

ARBITRATOR
P. Scheme Karachi No II
Garden Quarter, 21-7-32


TRUSTEE

ARCHITECT & SURVEYOR.
WATERCOURSE ROAD
KARACHI.



PLAN SHOWING PROPOSED BUILDING
ON THE PART OF PLOT No 24 L.R.7 LAWRENCE QRT.
SCALE 8' to 1"

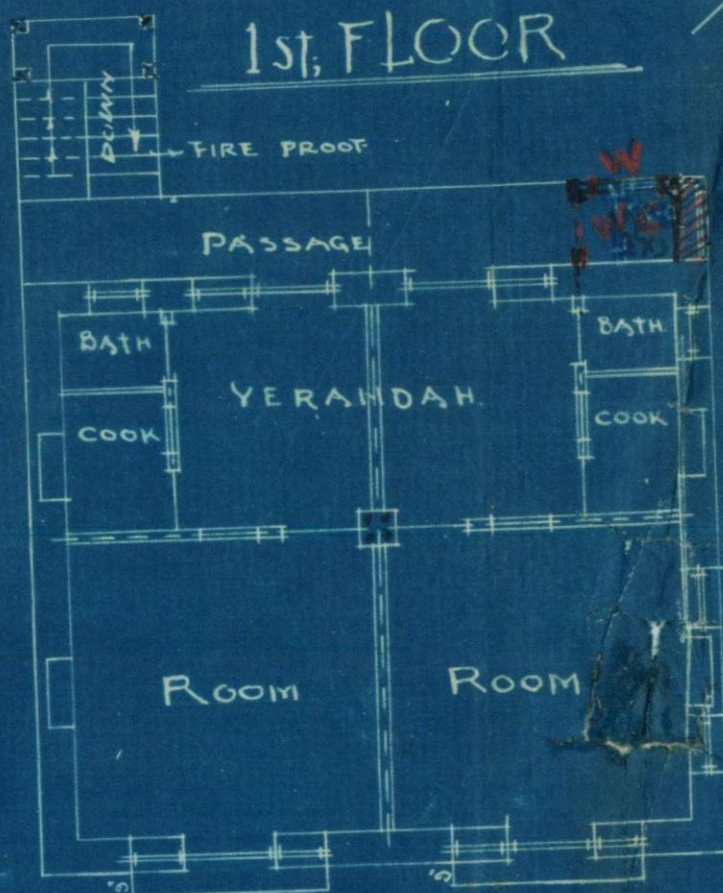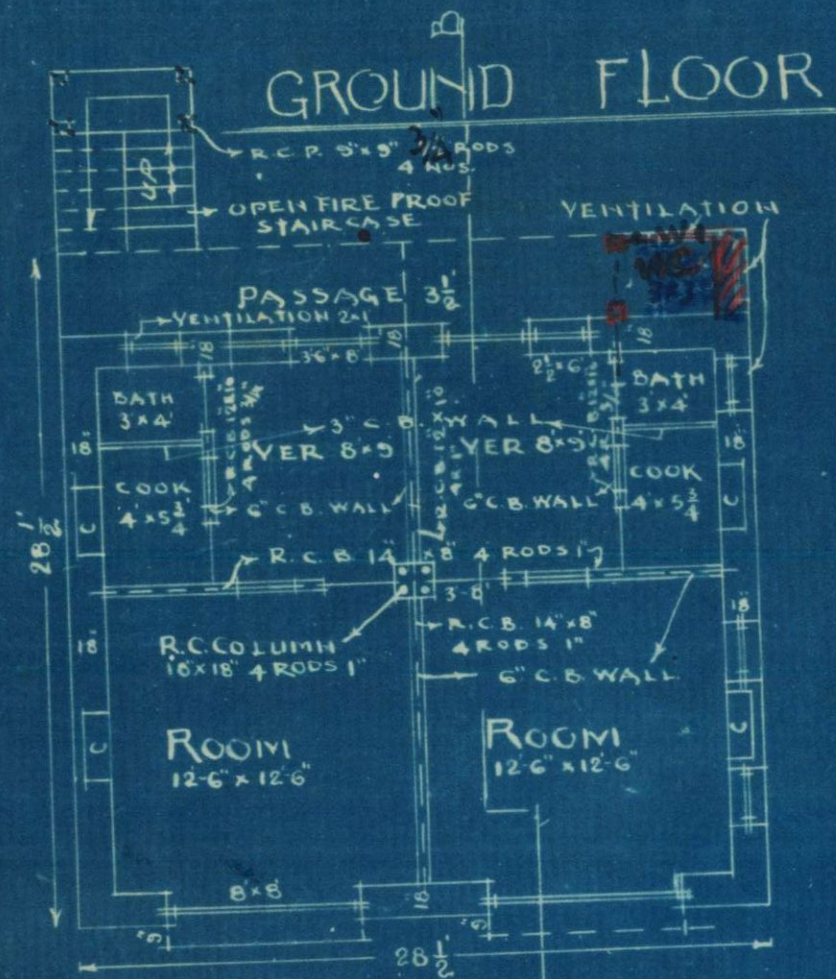

BLOCK PLAN
40' to 1

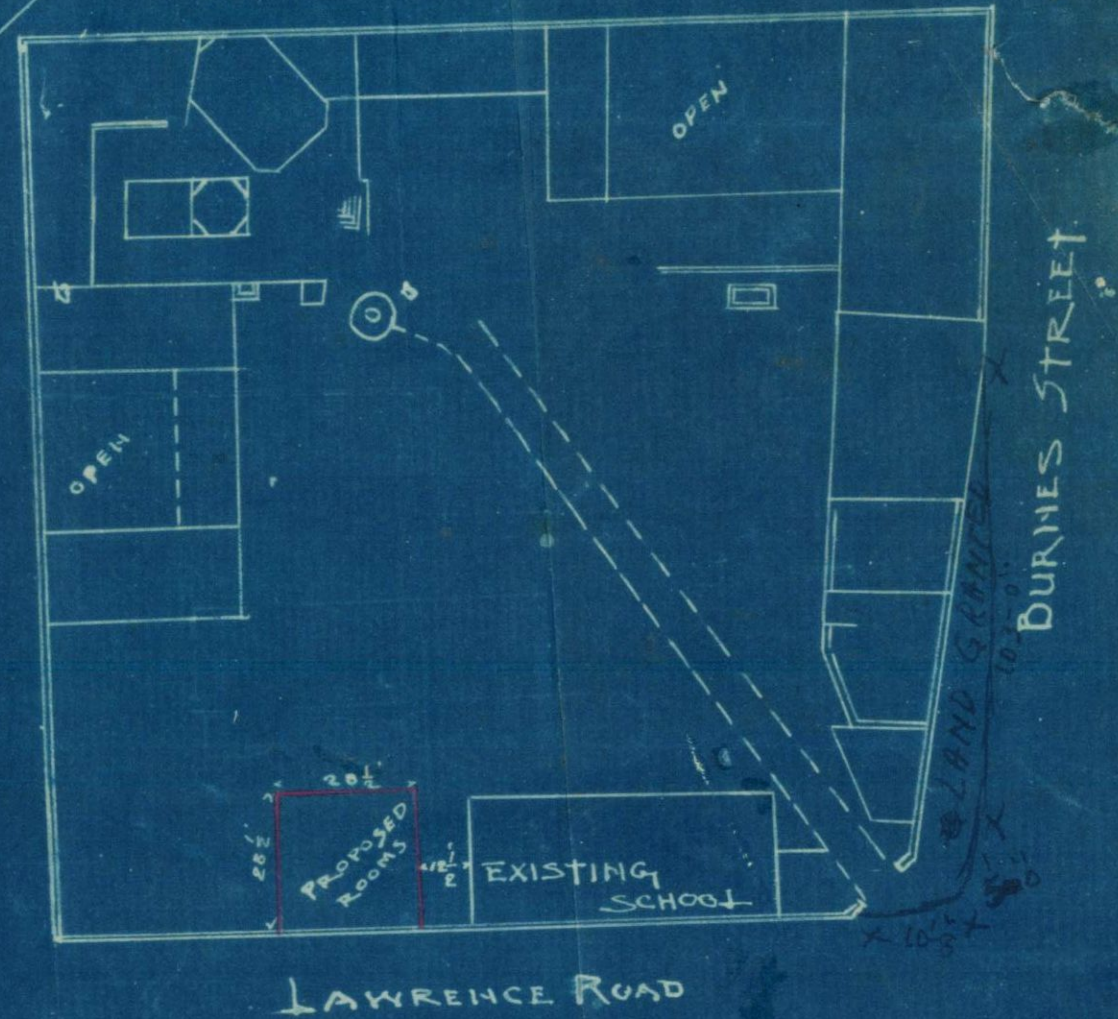

SECTION ON A.B.

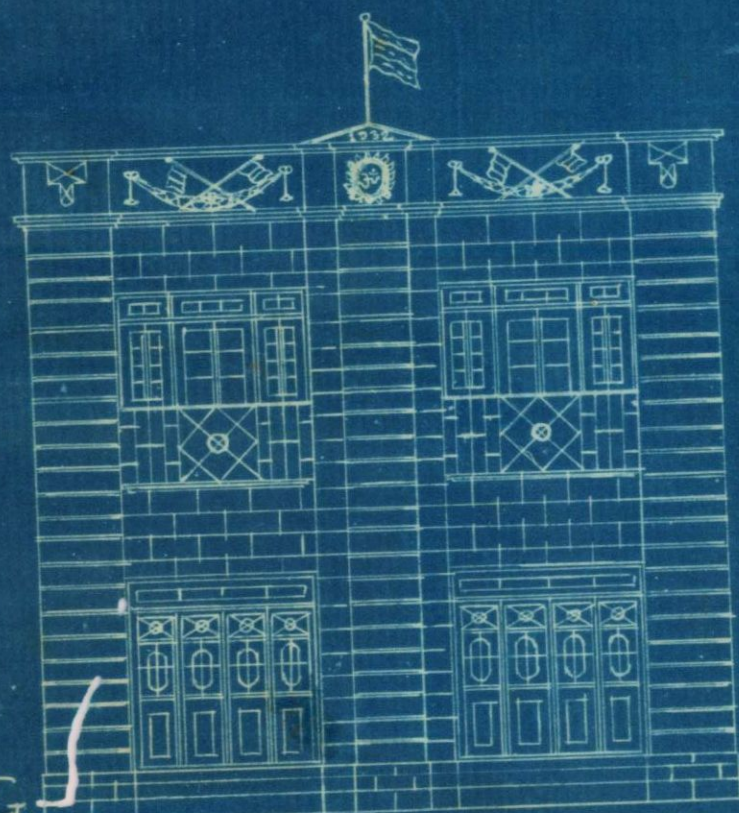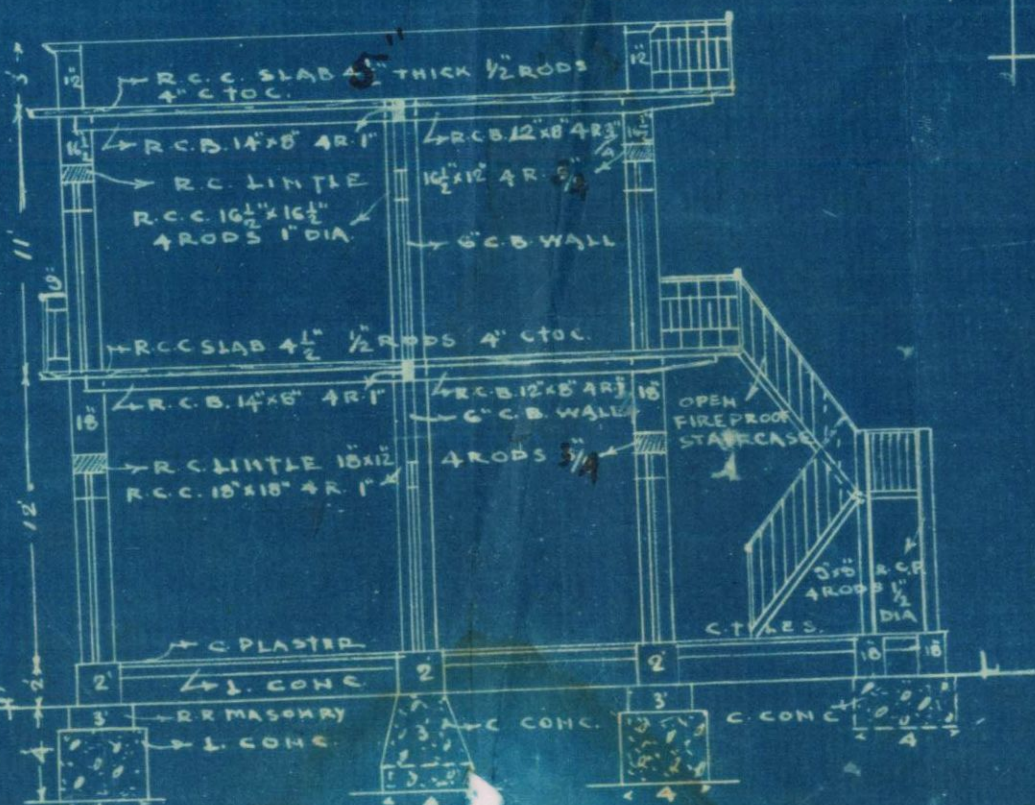

FRONT ELEVATION

NOTE,
AREA OF THE ENTIRE PLOT $4032\frac{2}{3}$ SQ YDS.
EXISTING BUILT UPON AREA 1107 "
PROPOSED AREA 81.22 "

TRUSTEE

ARCHITECT & SURVEYOR
WATERCOURSE ROAD
KARACHI.