



28 NOV 1940

P.345/40.

29-11-40
Lefter

Mr. K.T. Tinani, Architect
for owner,
Karachi.

Der Sir,

Re:- Plot No. 551/G.E. Garden Qr.

-:0:-

With reference to your letter dated 8th October 1940,
I have to inform you that the deviations are not minor and
the amended plans will have to be submitted immediately.

If you fail to get the "them" passed within 10 days,
I regret, prosecution will be filed against your client.

Yours faithfully,

Y. M. 27/11

Copy forwarded to Mr. Pridhandas Manghumal for information
Land Manager & Architect.

29/11



ALAL T. TINANI,

Engineer & Surveyor.

B. E.

MANAGER &
S. DEPTT.KOTHARI BUILDING,
BUNDER ROAD,

Karachi, 8th Oct. 40 193

Lan Manager & Architect.

No.
Karachi Municipal Corporation,

Karachi.

Dear Sir,

Re:- Plot No 551 G.E. Garden Qr.

With reference to your No LCC345/40 dated 3rd, 40. I have to inform you that the alterations are very minor ones and I shall therefore thank you to kindly instruct the Building Surveyor to allow me to make the necessary corrections in the already approved plans.

Thanking you in anticipation.

Yours faithfully,

BS
8/2
9/2

Kamru



Heritage

KMR.CDD.GaQ.1940.01

Nos. 2805, 2806 & 2807.

2000-5-40

I. I. KURESHI.
B.Sc. Engineering (Edin.)
LAND MANAGER & ARCHITECT



MUNICIPAL CORPORATION
KARACHI.

26 SEP 1940

Reference No. B. S. P. 345/40.

MEMO:

Re: Plan No. 551/G.B.

Sheet Garden

Qr.

Plan for proposed Bungalow

on the above plot submitted by Mr. Gordhandas Manghumal
has been approved by the Karachi Municipal Corporation.

Pridhanda
Khajur Bager

SEP 25 1940

I. I. Kureshi
Land Manager & Architect.

Copy forwarded to—

1. Health Officer,
 2. Supdt. of Machinery,
 3. Assessor,
 4. Building Surveyor, with plan,
 5. Land Surveyor,
 6. Enquiry Officer,
- for information and necessary action.

Seen. There are
deviations. work
has reached fr: floor
lin til level.

for
30/8

Pl. issue notice of
deviation to Mr Pridhanda
Manghumal - first merchant
Khajur Bager
Copy to architect.

30/8



REINFORCEMENT DETAILS PLAN 551 G.E.

8 TO AN INCH


R.C.C. PILLARS. 18x18 AR. 3/4" DIA. G.F.
" " 15x15 AR. 5/8" " F.F.
SIZES OF PILLARS 21x9" IN G.F. WILL REMAIN
SAME ON F.FLOOR AR. 5/8" DIA.

APPROVED

SEP 25 1940

Land Manager and Architect

Signature

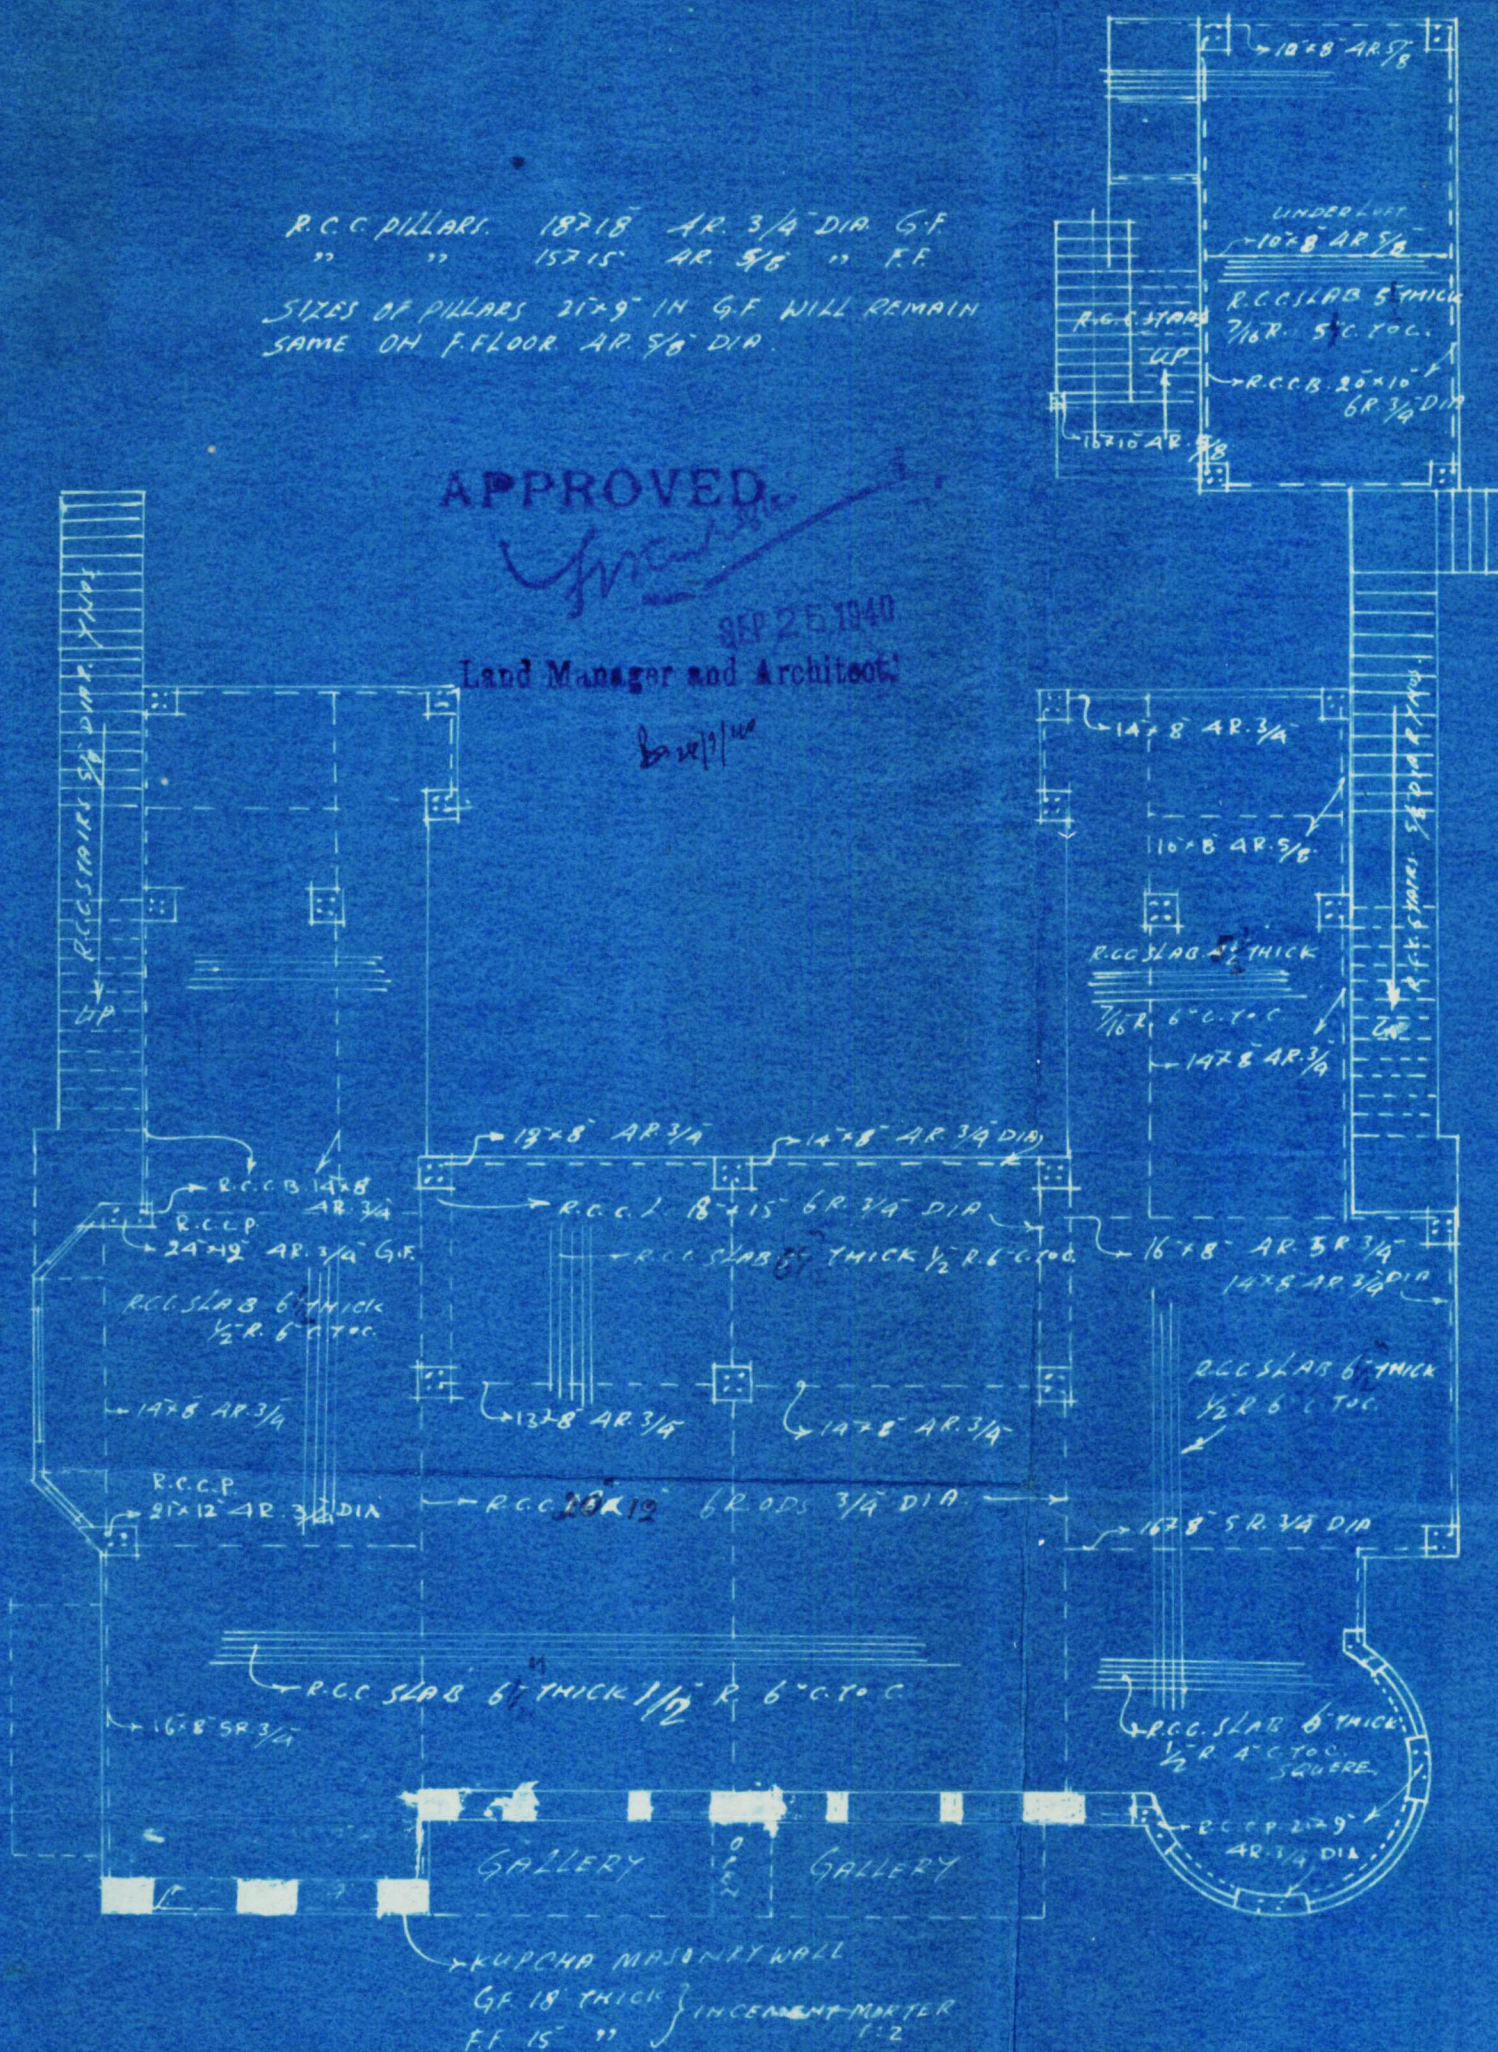

KANAYALAL T. TIWANI, B.E.
ARCHITECT & ENGINEER
KARACHI

①

KMR.CDD-GaQ.1940.01

5



Heritage
FOUNDATION

KMR.CDD.GaQ.1940.01

No 78

S-1 Front Side
S-2 Back Side

Sanctum

Qebisey

ely S. P. S. Collection

~~Sanctum~~

caract.

not relayed



Santhosha
City Deputy Collector,
Korachi.