



ORDERS UNDER SECTION 96 (2) OF ACT III OF 1910.

No. E/

1567

OF 1913.

MUNICIPAL ENGINEER'S OFFICE,

Karachi,

22nd March 1913.
26th

MEMO:

With reference to his application dated 7th March 1913.
 Mr. Khairat Ali is informed
 that the plan submitted by him for building a second floor
 on plot No. 112 Survey Sheet E-4
 situate in Bohara Street Tundore
 Quarter, is approved, and permission to build in accordance therewith is
 granted. The building to be erected subject to the Byelaws and Rules of the
 Municipality.

A. M. INST., C. E.,

Engineer,

Karachi Municipality.

NOTE 1.—This pass does not give permission to occupy Municipal land with building materials. This can only be allowed when the street is wide enough to permit building materials being deposited on it without it being a source of danger to the public, and only then on a hoarding being placed round the land to be occupied, and on payment in advance of fees for occupation of Municipal land, at the following rates:—

	Rs.	A.	P.
(1) For the first three months, per square yard, per diem	0	0	$\frac{1}{2}$
(2) For the next three months „ „ „	0	0	1
(3) For any subsequent time „ „ „	0	0	2

NOTICE 2:—Windows and doors of the building will not be permitted to project on or overhang any public street or Municipal land.

(200-14-2-13.

Form No. 5.

No. E. 1568 of 1913.

MUNICIPAL ENGINEER'S OFFICE,

Karachi, 25th March 1913.

MEMO.

Inspector Quarantine Quarter is informedthat Mr. Khairat Ali has been permittedto build 2 storey house his houseon plot No. 116 & 117 Street Quarantine

Quarter. Report should be made to the undersigned when the house is completed.

M. M. M.
A. M. INST. C. E.,

Engineer,

Karachi Municipality.

Through the Health Officer, Karachi Municipality.

500-27-7-1912.

Form No. 1.

Karachi, 4th march 1913.

NOTICE UNDER SECTION 96 OF ACT III OF 1901.

To

THE CHIEF OFFICER AND CHIEF ENGINEER,

KARACHI MUNICIPALITY.

SIR,

I beg to inform you that I intend building a secondfloor on plot No. 115Survey Sheet No. 84 Situate in Bhawan + KulkarniStreet Ranchore Quarter.

As required by the rules of the Municipality, I beg to submit herewith
a plan of the same for your approval.

I beg to remain,

Sir,

Your most obedient Servant,

[Signature]
Signature of the applicant.

No. G. of 2157 1913.

MUNICIPAL CHIEF OFFICER AND

CHIEF ENGINEER'S OFFICE.

Karachi, 7th march 1913.

Forwarded to the Municipal Engineer for favour of disposal.

[Signature]
A. M. INST. C. E.,
Chief Officer and Chief Engineer,
Karachi Municipality.

[Signature]
shew 6/4/13
11-3-13
SOS

3-2

2

No. E. 1194 of 1913.


MUNICIPAL ENGINEER'S OFFICE.

Karachi, 8th March 1913.

MEMO.

The above application is forwarded to the Municipal Health Officer for
favour of report.

Through Land Surveyor

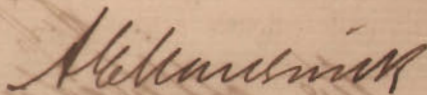

A. M. I. E.,

Engineer,


Karachi Municipality.

No 3206
11-3-13

MUNICIPAL HEALTH OFFICER'S REPORT.

Returned to the Engineer, Karachi Municipality, with the following
remarks—

No objection

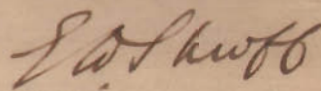

D. P. H. (London)

Health Officer,

Karachi Municipality.


Date 14-3-1913.

No. E. 1456 of 1913.

MUNICIPAL ENGINEER'S OFFICE.

Date 18th March 1913.

Forwarded to the Enquiry Officer for report.

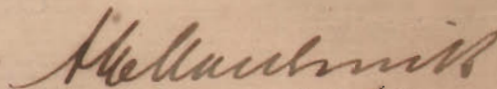

A. M. I. E.,

Engineer,

Karachi Municipality.

Through

The Land Surveyor,

Karachi Municipality.

ENQUIRY OFFICER'S REPORT.

Applicant's name

Mr. Khader Khan

Whether he is the owner of the plot on which it is proposed to build

The work proposed

to build second floor

Enquiry Officer's report

*By a report that the applicant wants to build on above plot there is no objection to building if the height of the building does not exceed 10 feet.*Date *18 March* 191*3*.

Enquiry Officer.

Submitted through the Land Surveyor.

LAND SURVEYOR'S REPORT.

Does the plot come under Alignment

no

Area of plot

Area under Alignment

Remarks

Sir, With reference to this I beg to report that there seems no objection to permission to build the same.

Date

18-3- 191*3*.*Cons. Secy
Nathan*

Land Surveyor.

ORDERS OF THE ENGINEERS.

*Issued pass**M. H. H. H. H.*

A. M. I. C. E.,

Engineer,

Karachi Municipality.

No. E. 1610 of 1913.

MUNICIPAL ENGINEER'S OFFICE.

Karachi, 27th March 1913.

Submitted to the Managing Committee with a recommendation that the plan be approved.

Forwarded

Spearsham plan

A. M. I. & E.

A. M. I. & E.,

Engineer,

Karachi Municipality.

Chief Officer, Karachi Municipality


Through

THE CHIEF OFFICER AND CHIEF ENGINEER,

KARACHI MUNICIPALITY.


RESOLUTION OF THE MANAGING COMMITTEE.

Resolution No. _____ Date _____

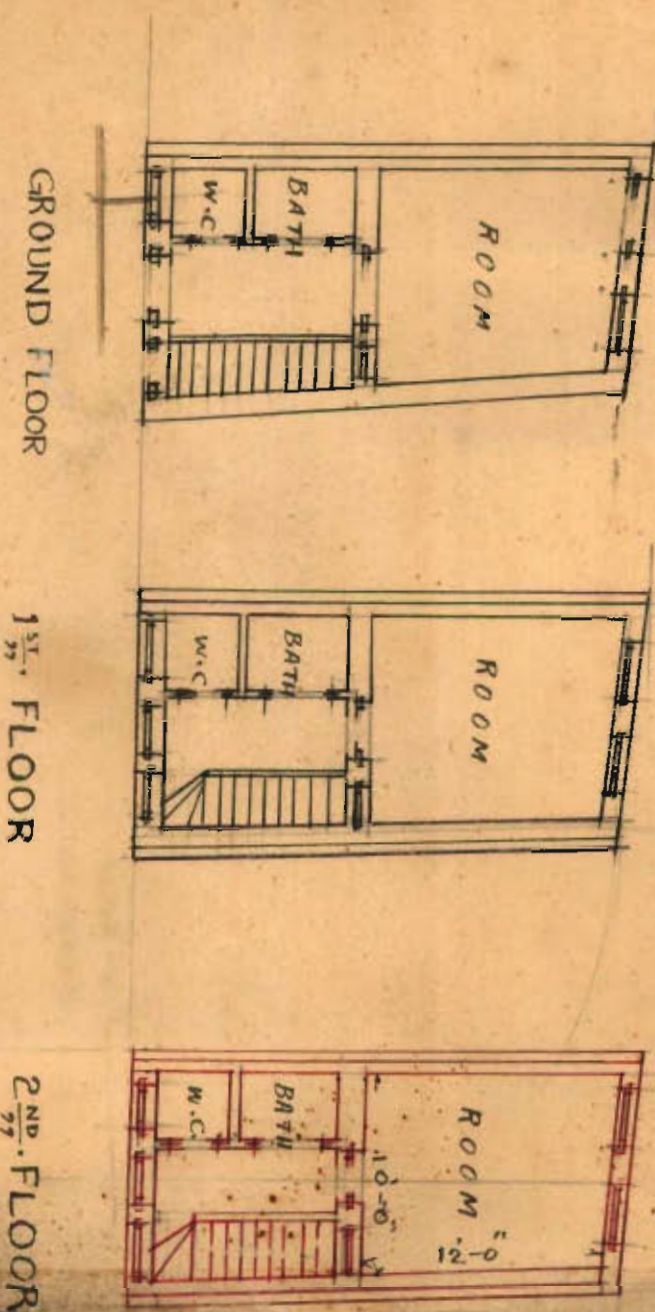

GROUND FLOOR


1ST FLOOR

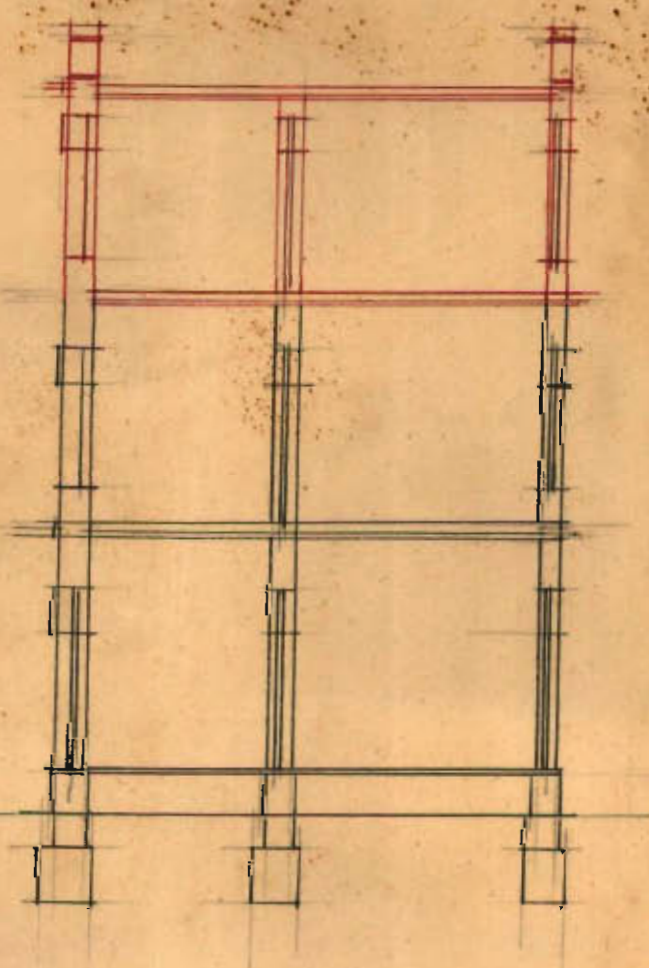2ND FLOOR


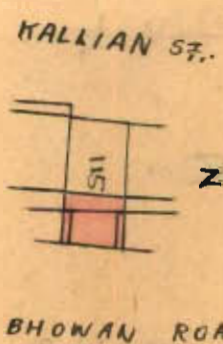
CROSS SECTION

Plan showing the second floor to be built
on plot No. 115-E.4. Runchore 8th.
Scale 10 feet to 1 inch.

McMurry
McMurry
25/12/19

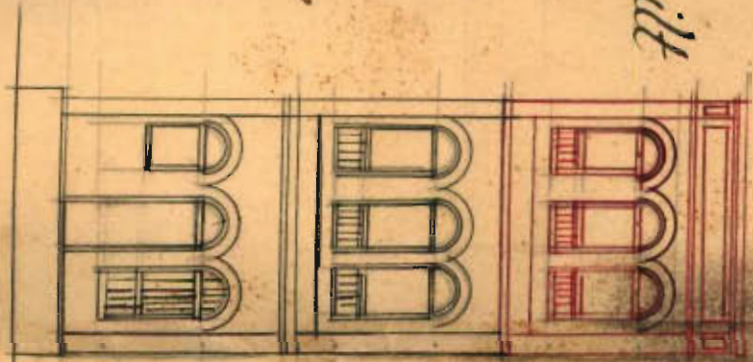

ELEVATION


BLOCK PLAN
SCALE 40' = 1"