




2645 T. O. 2162

Completed
in 1918

SCALE 8' = 1"

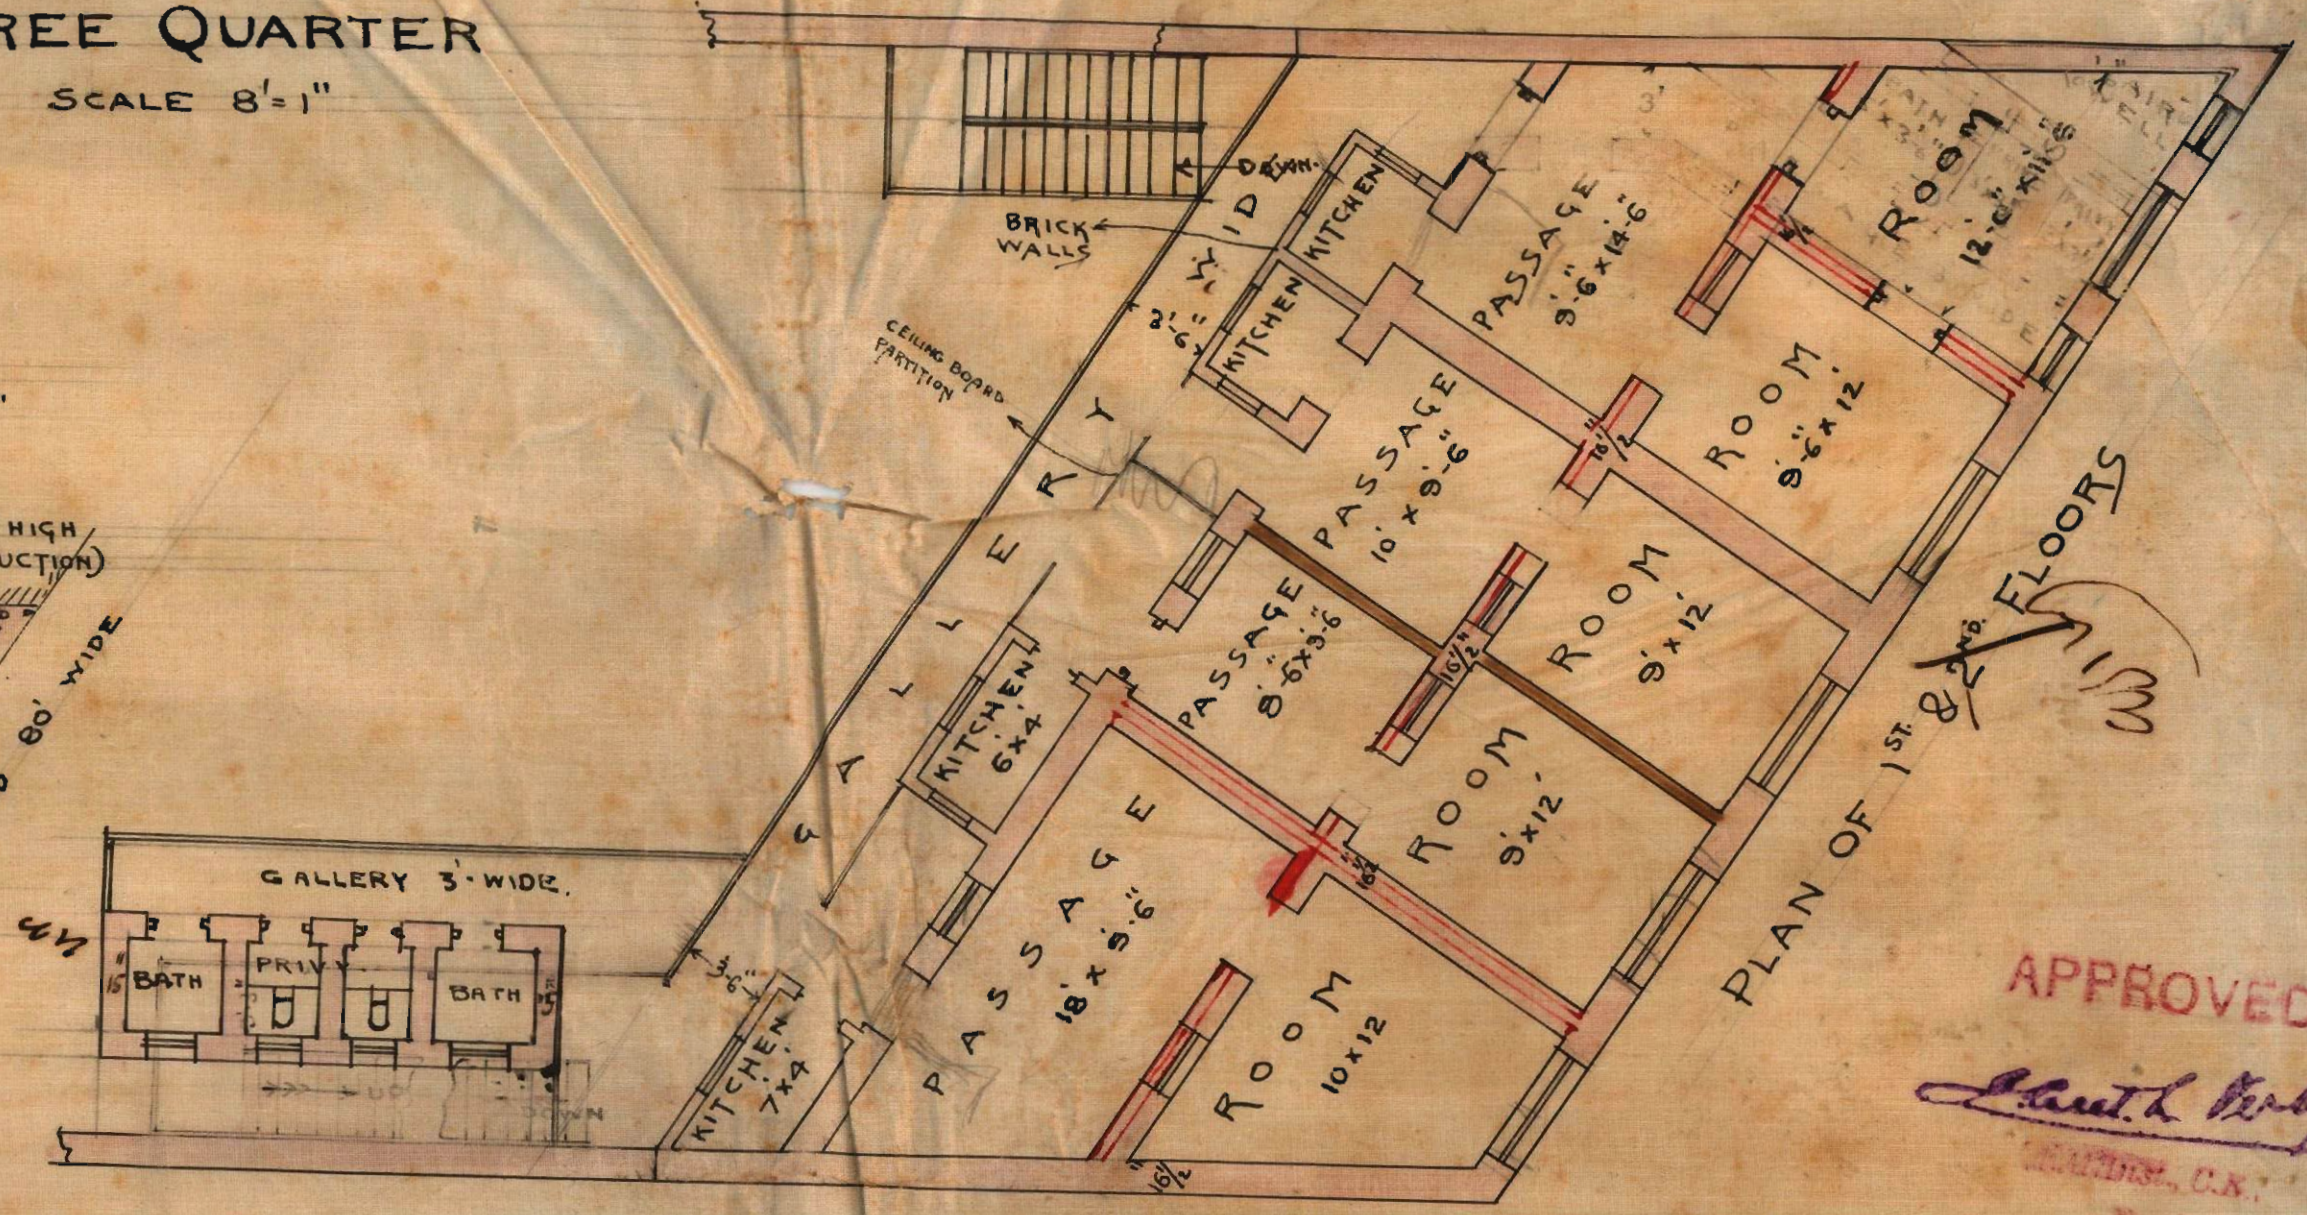

Member, C.E.
Engineer
Karachi Municipality.

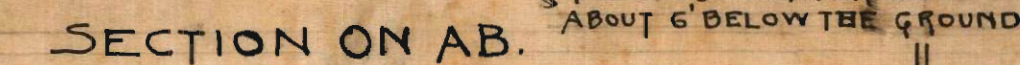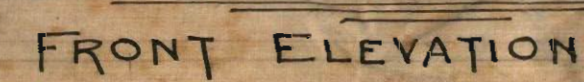

Mikazareth
4th Feb. 1918

Inform owner that not more than $\frac{1}{2}$
 of the area of the plot will be allowed
 to be built on.

only one building will be allowed
 on a plot of less than 2000 sq. ft.
 in this gr.

All buildings must be set back
 at least 10'-0" from the
 compound walls.

~~at least 10 feet~~

It must be shown on the plan
 how he proposes to connect
 w.c. with the drainage system.

✓
 28/11/77

India.

informers

that they are deviating from
Plan as regards arrangement of
rooms, stairs, doors & windows.

They are ~~therefore~~ requested to
submit an amended plan within 7 days, showing
the alterations failing which steps will be taken under
~~accordance~~ with the Act: -

M.M.

M.M. F

Engineer Karachi Municipality

A-4
No: L.S.

Heritage KMR.CDD.MIQ.1916-1918.01(A)
2004 of 1918.


Municipal Office

Karachi; 12th Oct: 1918.
15th

M E M O / -

With reference to the Bank at
Karachi India under construction, Messrs: Cox & Co: are informed it is observed that they are deviating from the approved plan as regards arrangement of some of the rooms, stairs, doors and windows.

24/10/18
They are therefore requested to submit an amended plan within 7 days, showing the alterations.

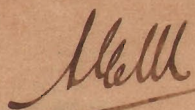
M. I. M. E.

(AG) ENGINEER

 Karachi Municipality.

86-

~~2A72~~ B.17
B.1 serial

A-5

NOR L.S. 2561 of 1918.
Heritage KMR.CDD.MIQ.1916-1918.01(A)
Municipal Office

Karachi; 19th November 1918

20th

M E M O / -

With reference to their applica-
tion with amended plan received on 28th October 1918 for
the building of a new Bank at Karachi Messrs: Cox & Co:
are informed that the same are approved by this Office
and permission to build accordingly can only be granted
after the two copies of plans herewith sent duly signed
and approved by this Office are approved by the City
Deputy Collector. They are therefore requested to apply
for permission to the City Deputy Collector with the plans
returned herewith. *one more copy of the plan is required
which must be submitted at once.*

J. A. M. I. C. E.

A. M. Inst., C. E.

ENGINEER

Karachi Municipality.

*Copy to the City Deputy Collector
for information*

30/11 *J. A. M. I. C. E.*

A. M. I. C. E.

Karachi Municipality.



A-6

No: L.S. 2561 of 1918.

Municipal Office

Karachi; 20th November 1918

MEMO / -

With reference to their application with amended plan received on 28th October 1918 for the building of a new Bank at Karachi, Messrs: Cox & Co: are informed that the same are approved by this Office and permission to build accordingly can only be granted after the two copies of plans herewith sent duly signed and approved by this Office are approved by the City Deputy Collector. They are therefore requested to apply for permission to the City Deputy Collector with the plans returned herewith. One more copy of the plan is required which must be submitted ^t at once.

A. M. Inst., C.

ENGINEER

Karachi Municipality

No: L.S. 2690 of 1918

Municipal Office

Karachi; 30th November 1918

Copy forwarded to the City Deputy Collector for information.

A. M. Inst., C. E.

ENGINEER

Karachi Municipality.

502

with reference to their application with ^{and} plan
 received on 28th Oct 1918 for bldg on
 the bldg of New Bank at Karae
 Messrs Cox & Co are requested to app
 to C. D. C. with two copies of plans
~~sent herewith duly signed & approved.~~ upon
 that the same are approved by this office
 and permission to build ^{accordingly} can only be
 granted after the two copies of plans
 herewith sent duly signed & approved
 by this office are approved by the C. D. C.
 They are therefore requested to ask ^{appl} for
 permission to C. D. C. with the plans
 return herewith.

A. M. I. C. B

Kanching

A-8 (1)



KMR.CDD.MiQ.1916-1918.01(A)

To the Assistant Engineer.

9288.

COX & CO

KARACHI.

Oct 28. 1918

Dear Sir,

Re Cox's new building

Referring to the memorandum dated Oct 12. 1918
which we received on Oct 15. 1918. We have
been the pleasure to send you 1 tracing
+ two duplicates of each tracing of
the ground floor, first floor and second
floor of the above showing the deviations
from the original contract. The receipt
of which kindly acknowledge.
Yours sincerely,

John G. G. G.

For the Assistant Engineer

Land Surveyor for report

Attest ²⁸ 18



COX & CO

KARACHI

P889

Mr Vaswani

Please attach F.C and

Report.

30/10/18. *FC*

FC is herewith attached

~~Report~~and report that there is no
objection in passing the plans.

No objection

11/11/18 *Mr Vaswani*

Be 93

Submits to the Engr.
for order there seems
no objection for the
deviation. but the 4
plans to be submitted.Where are the plans
said to be submitted?
been sent.

1. 7/11/18

11/18
Sub plans are herewith
submitted for
approvalNathal
7/11/18